






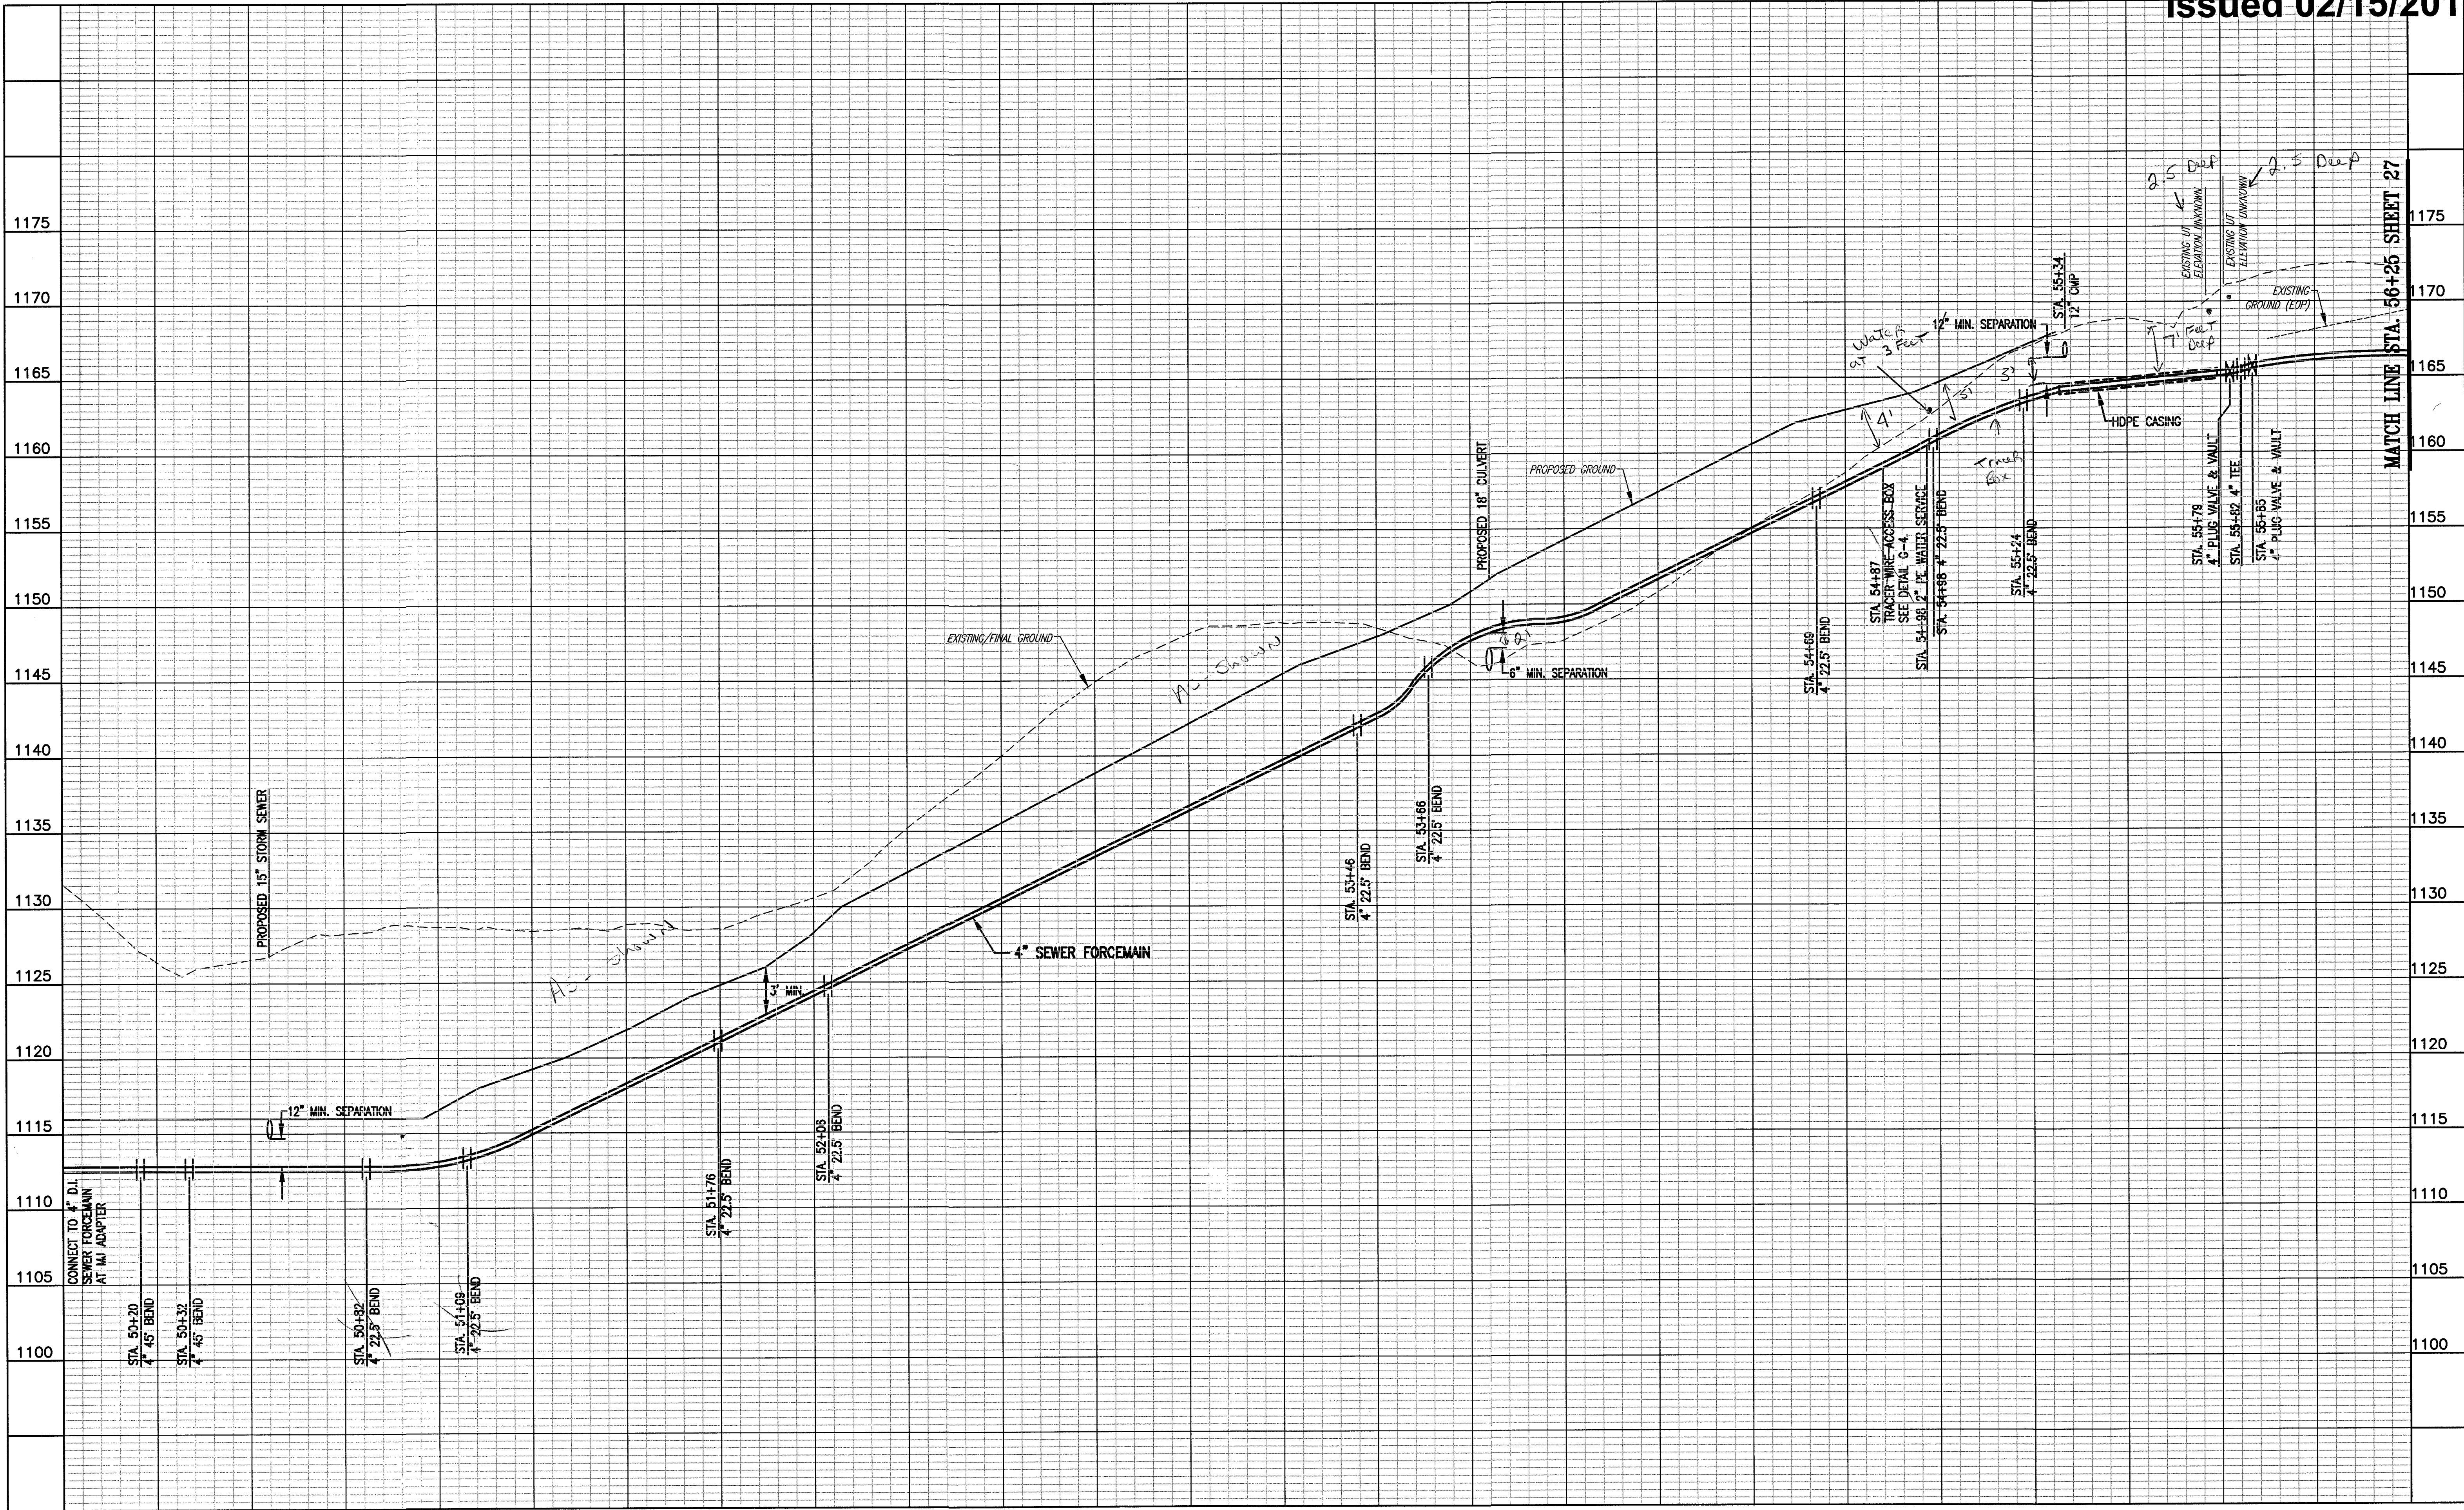

Whitman, Requardt & Associates, LLP
1700 Kraft Dr. Suite 1200, Blacksburg, VA 24060

NOTES:

1. FOR PLAN SEE DRAWING C4.09.

WESTERN VIRGINIA WATER AUTHORITY
601 South Jefferson Street, Suite 300
Roanoke, Virginia 24011

DES: PJM	SCALE: AS SHOWN
DRAWN: JES	HORIZ: 1" = 20'
CHECK: GWF	VERT: 1" = 5'
DATE: 05/24/18	

SUMMIT VIEW BUSINESS PARK UTILITY IMPROVEMENTS,
PHASE 1

4" SEWER FORCEMAIN PROFILE
STA. 50+00 TO STA. 56+25

REV	DATE	DESCRIPTION

As-Built

DRAWING	SHEET
C4.10	26