
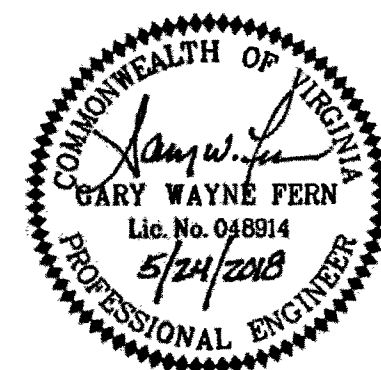
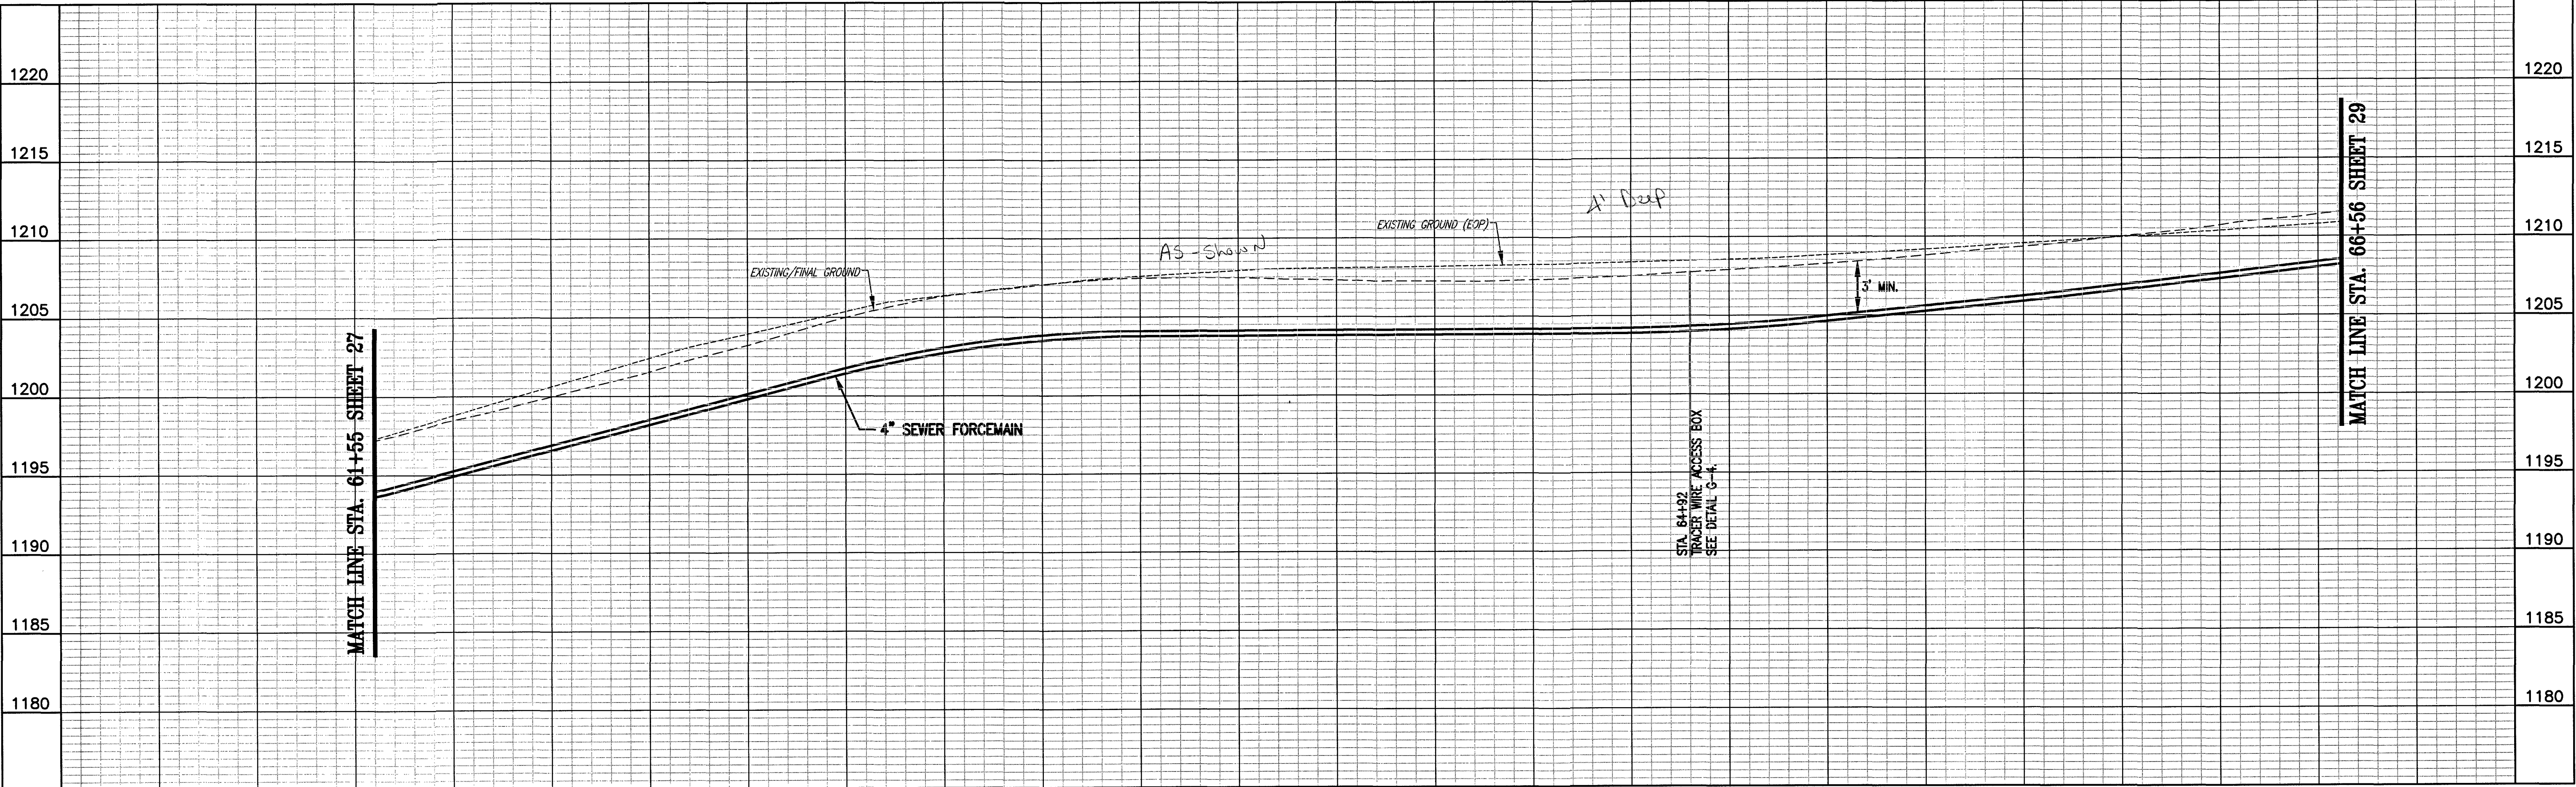


- NOTE:
- 1. ALL PIPE MATERIALS SHALL BE AS SPECIFIED ON THE PIPE SCHEDULE SHOWN ON DRAWING C4.02.
 - 2. CONTRACTOR SHALL MAINTAIN ACCESS TO AT LEAST ONE ENTRANCE TO THE CHURCH AT ALL TIMES.
 - 3. IN THE EVENT OF A FUNERAL TO BE HELD AT THE CHURCH OR CEMETERY, CONTRACTOR WILL RECEIVE 24 HOURS NOTICE AND SHALL SHUT DOWN ALL WORK ON SITE THE DAY OF THE FUNERAL. NO PERSONNEL SHALL BE ON SITE.

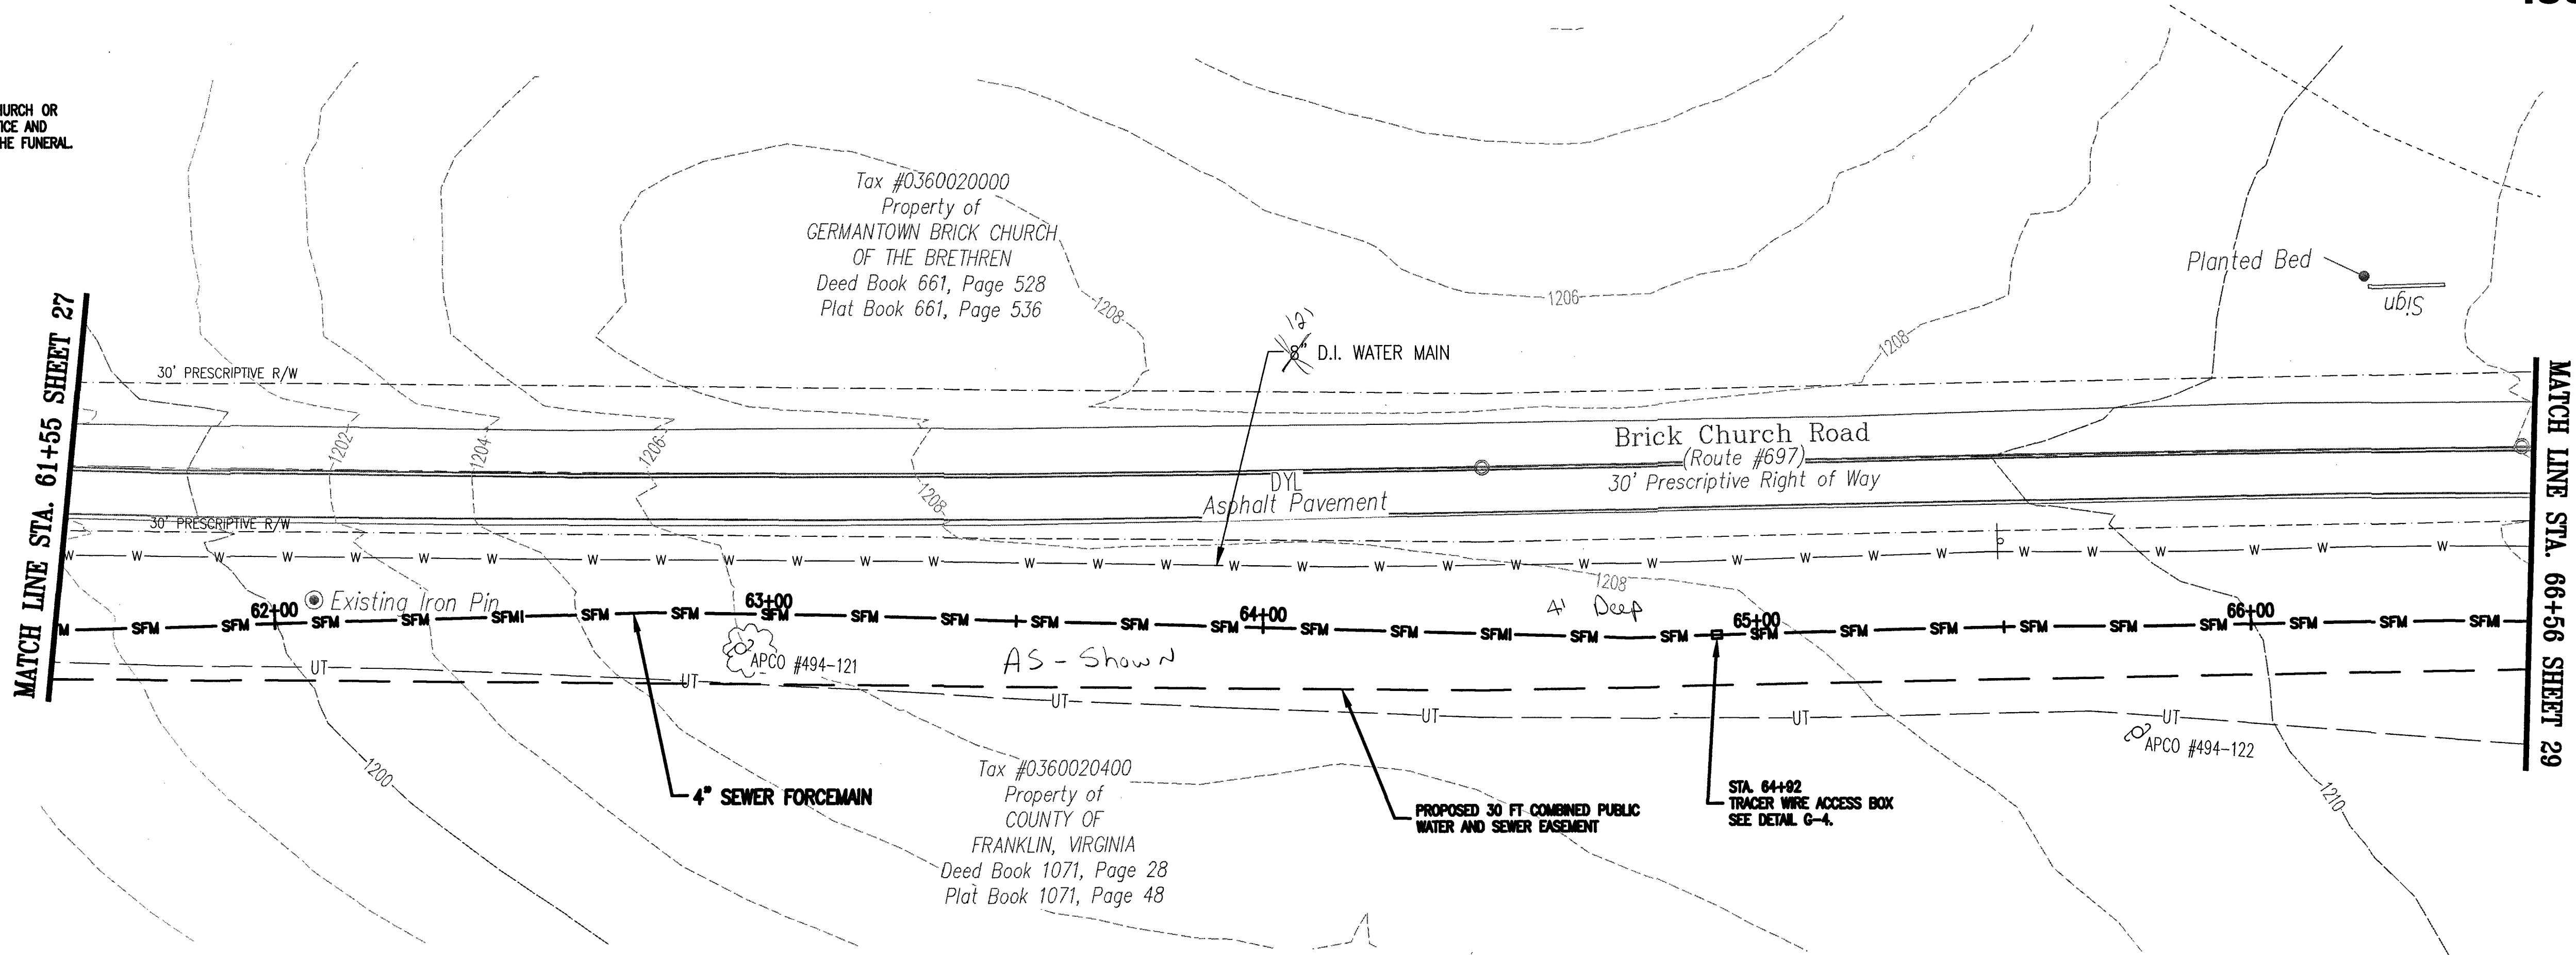

WESTERN VIRGINIA WATER AUTHORITY
601 South Jefferson Street, Suite 300
Roanoke, Virginia 24011

DES: PJM
DRAWN: JES
CHECK: GWF
DATE: 05/24/18

SCALE: AS SHOWN
HORIZ: 1" = 20'
VERT: 1" = 5'

SUMMIT VIEW BUSINESS PARK UTILITY IMPROVEMENTS
PHASE 1

4" SEWER FORCEMAIN PLAN - PROFILE
STA. 61+55 TO STA. 66+56

DRAWING
C4.12

SHEET
28