
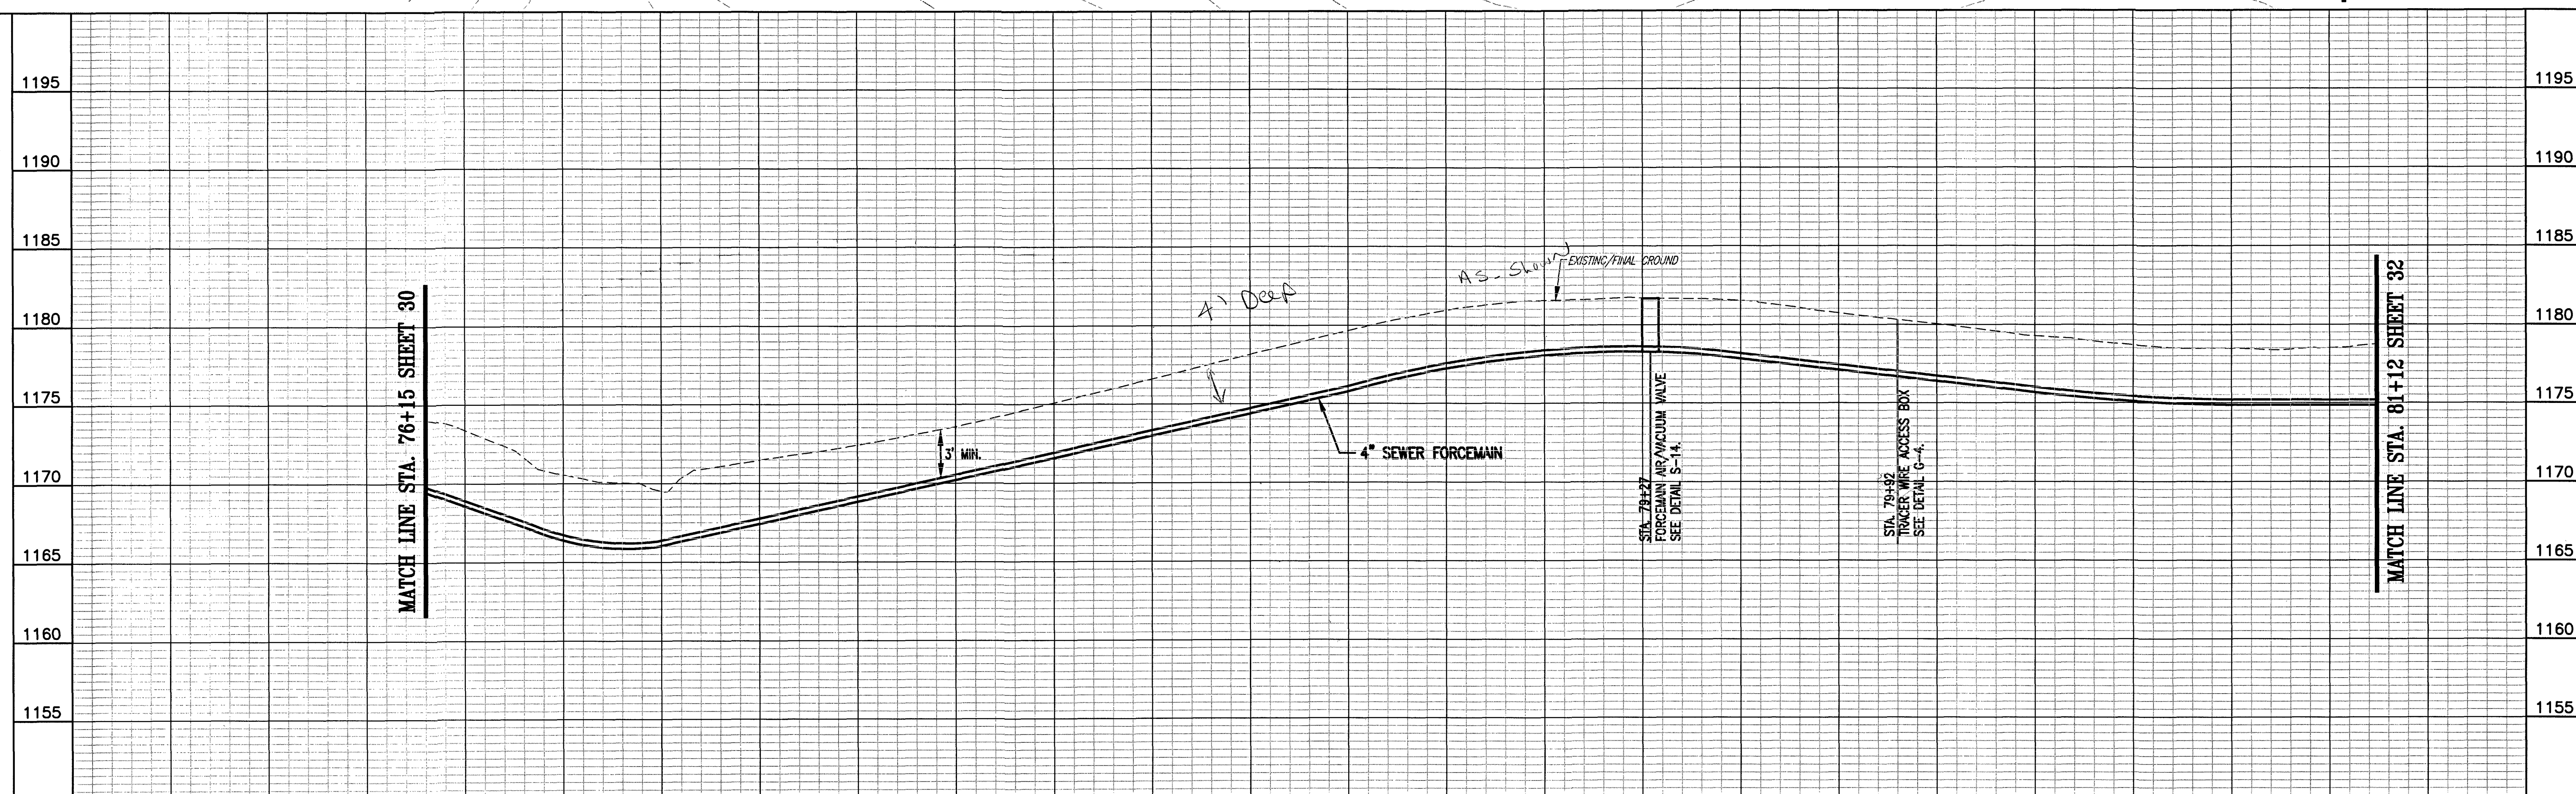


NOTE:

1. ALL PIPE MATERIALS SHALL BE AS SPECIFIED ON THE PIPE SCHEDULE SHOWN ON DRAWING C4.02.

Issued 02/15/2019

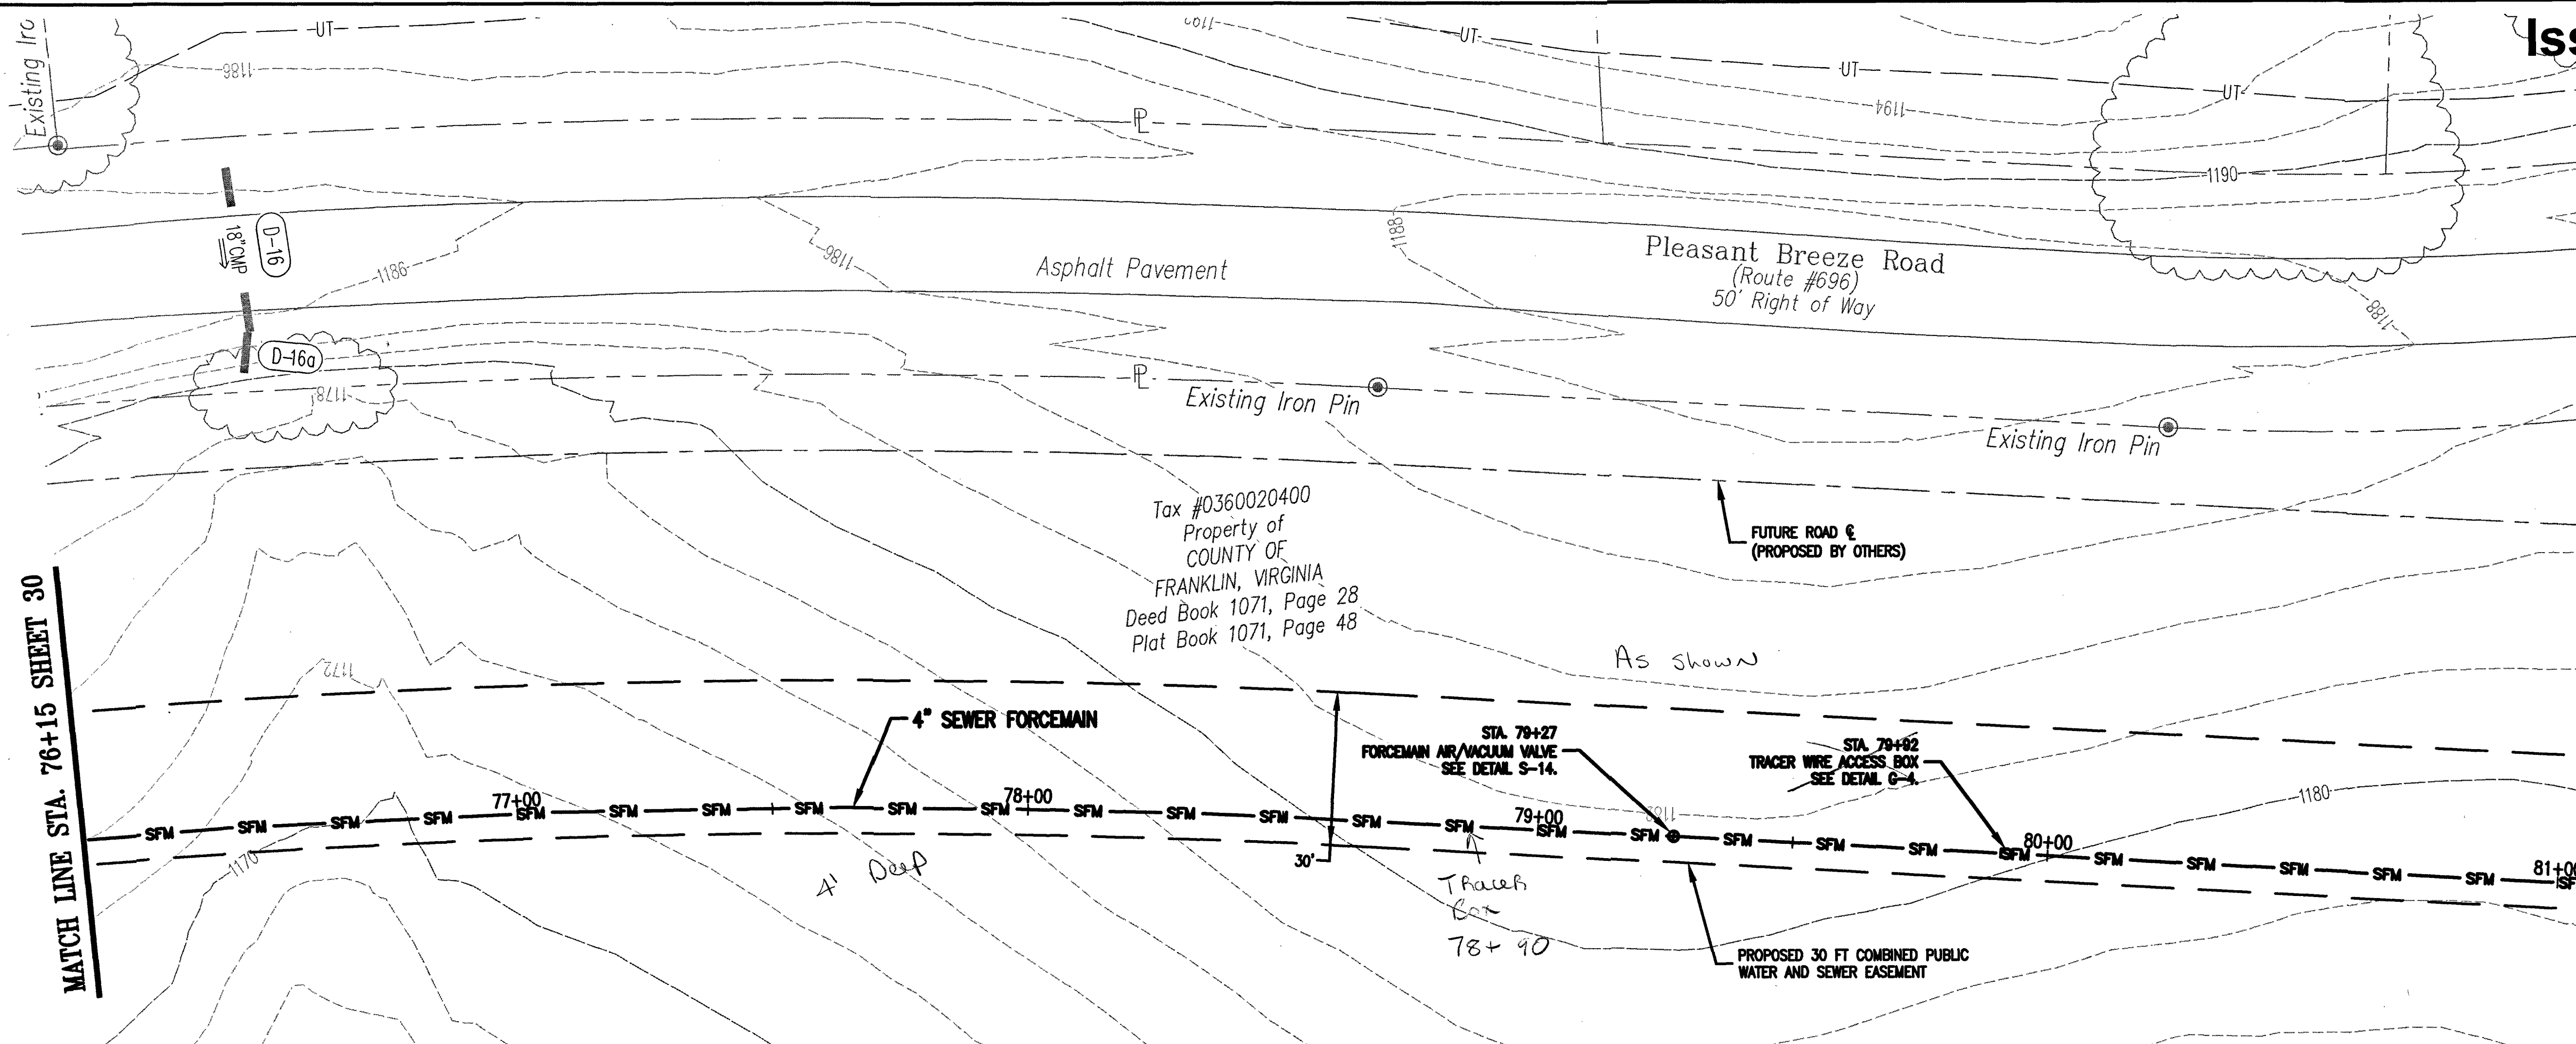

76+00


77+00

78+00

79+00

80+00

81+00

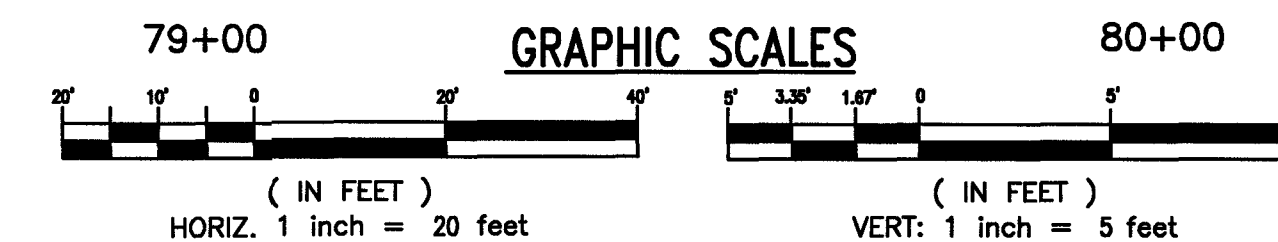

AS-BUILT

REV DATE DESCRIPTION

DRAWING SHEET

C4.15 31



WESTERN VIRGINIA WATER AUTHORITY
601 South Jefferson Street, Suite 300
Roanoke, Virginia 24011

DES: PJM
DRAWN: JES
CHECK: GWF
DATE: 05/24/18
SCALE: AS SHOWN
HORIZ: 1" = 20'
VERT: 1" = 5'

SUMMIT VIEW BUSINESS PARK UTILITY IMPROVEMENTS
PHASE 1

4" SEWER FORCEMAIN PLAN - PROFILE
STA. 76+15 TO STA. 81+12