
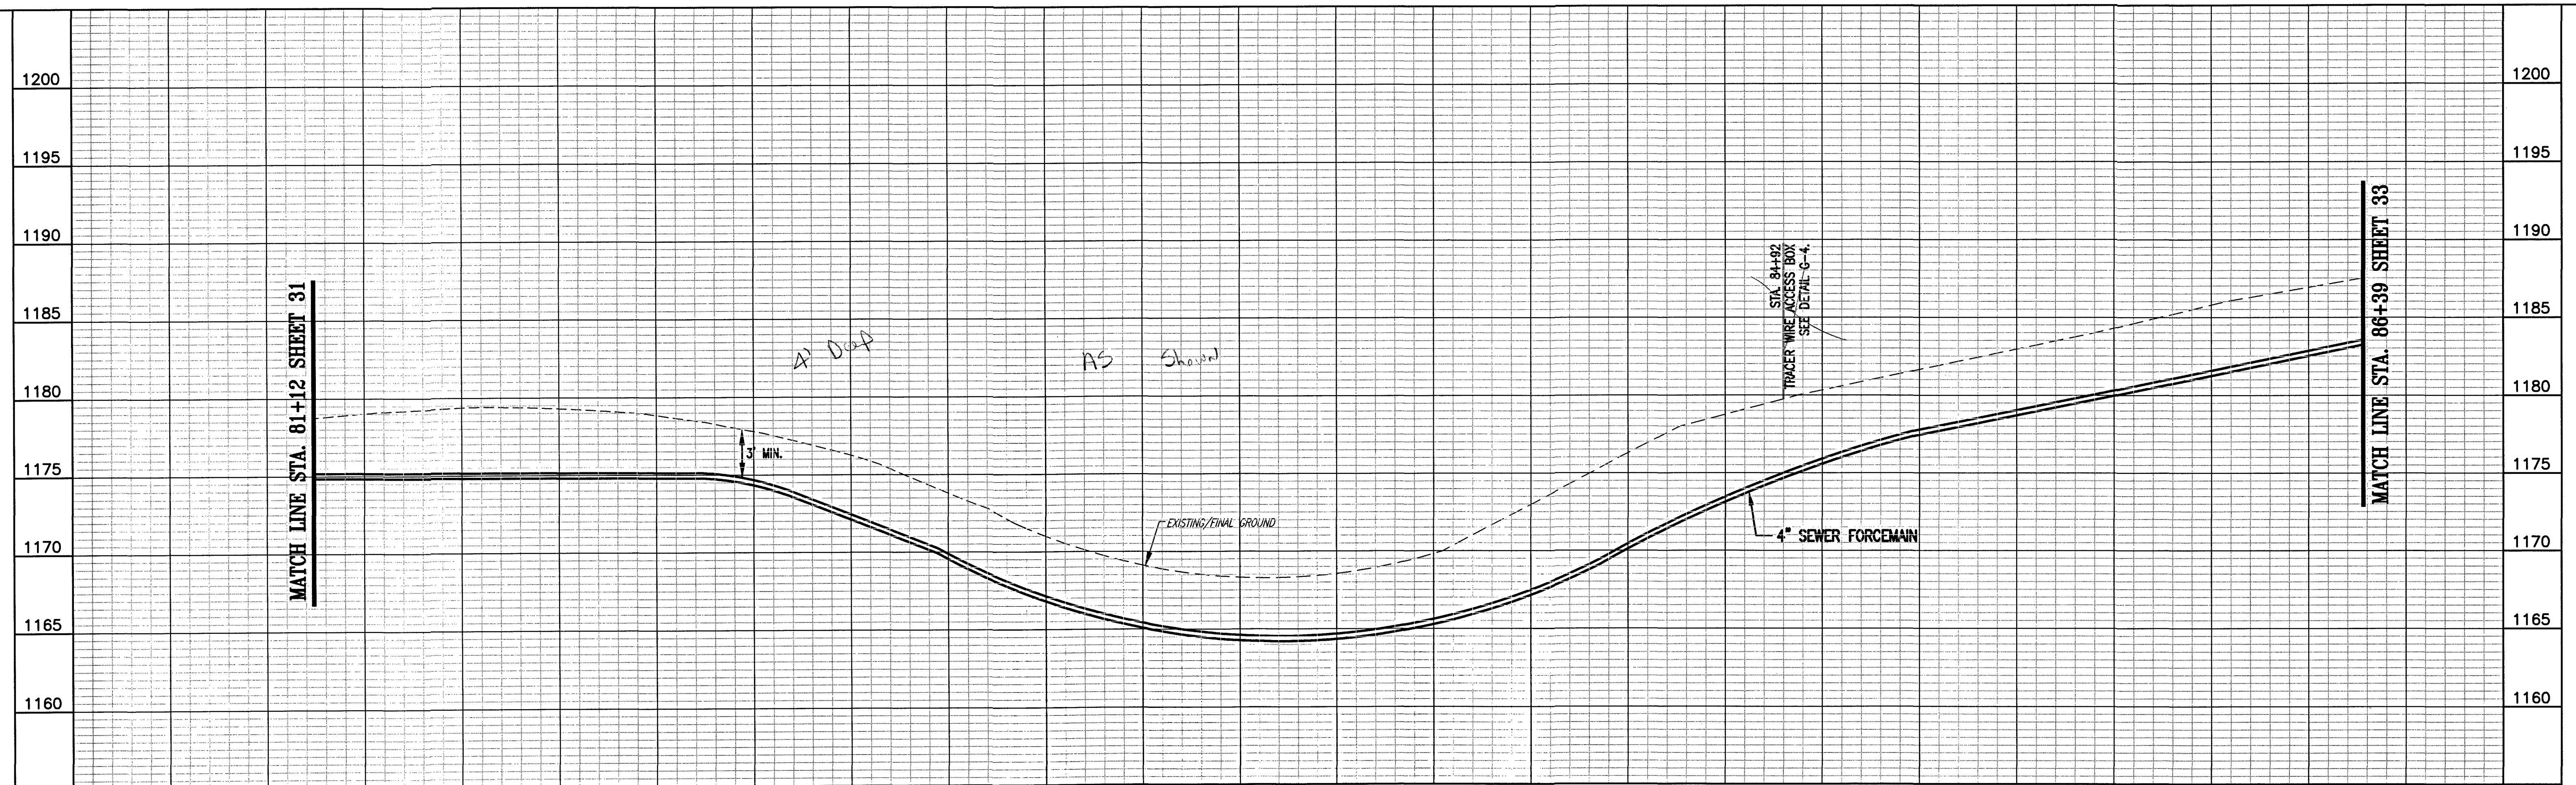


NOTE:

1. ALL PIPE MATERIALS SHALL BE AS SPECIFIED ON THE PIPE SCHEDULE SHOWN ON DRAWING C4.02.

Issued 02/15/2019

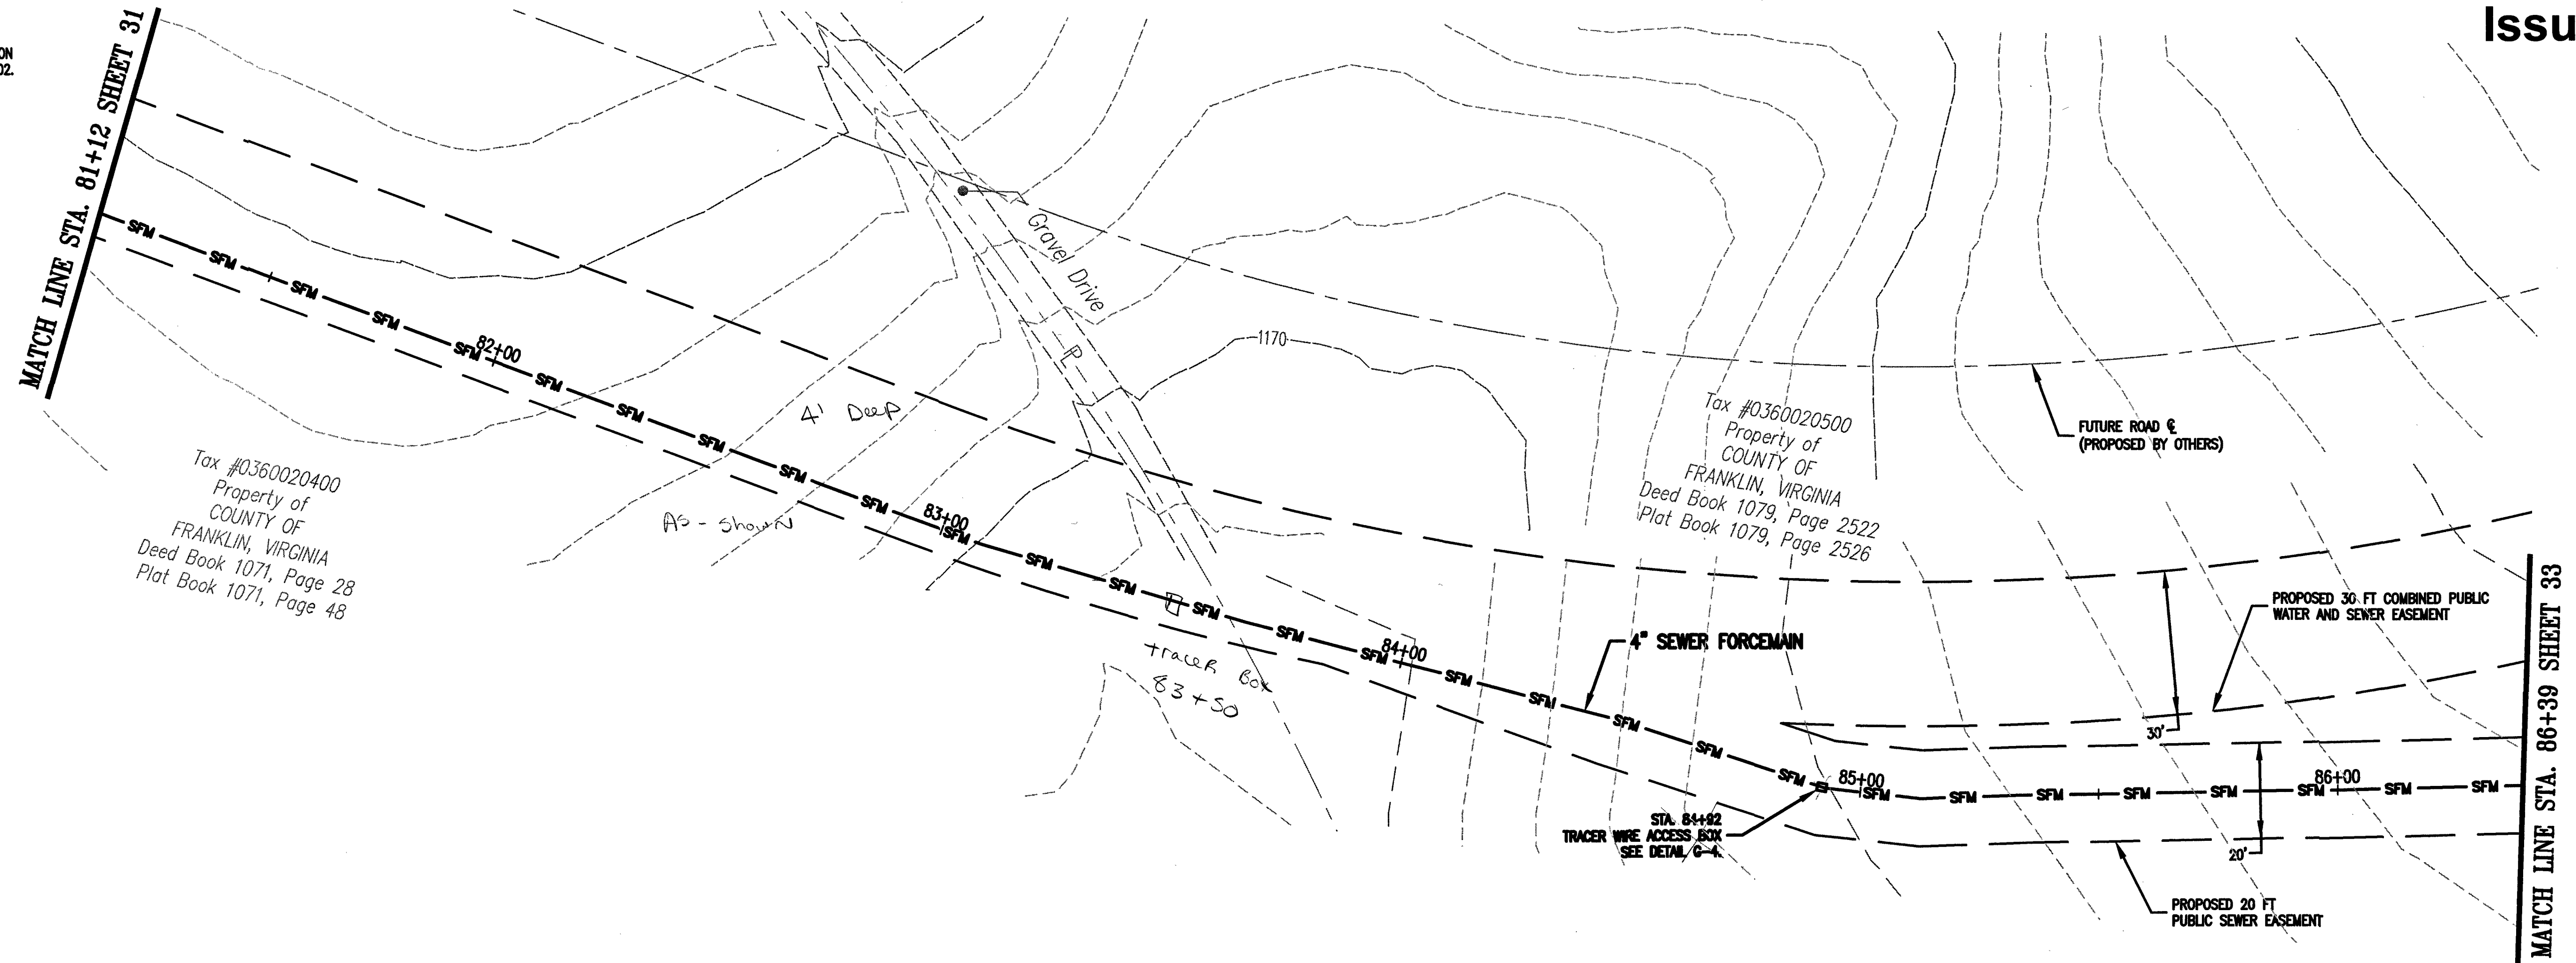

81+00



82+00

83+00

84+00

85+00

86+00

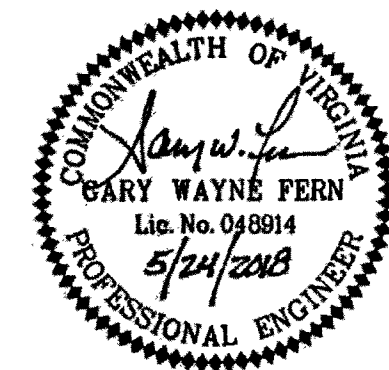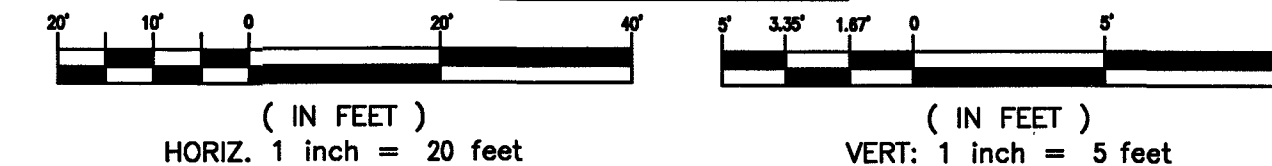

WESTERN VIRGINIA WATER AUTHORITY
601 South Jefferson Street, Suite 300
Roanoke, Virginia 24011

DES: PJM
DRAWN: JES
CHECK: GWF
DATE: 05/24/18

SCALE: AS SHOWN
HORIZ: 1" = 20'
VERT: 1" = 5'

SUMMIT VIEW BUSINESS PARK UTILITY IMPROVEMENTS
PHASE 1

4" SEWER FORCEMAIN PLAN - PROFILE
STA. 81+12 TO STA. 86+39

DRAWING
C4.16

SHEET
32

REV	DATE	DESCRIPTION