

NOTE:

1. ALL PIPE MATERIALS SHALL BE AS SPECIFIED ON THE PIPE SCHEDULE SHOWN ON DRAWING C4.02.

Issued 02/15/2019

MATCH LINE STA. 86+39 SHEET 32

MATCH LINE STA. 92+38 SHEET 34

FUTURE ROAD E
(PROPOSED BY OTHERS)

Tax #0360020500
Property of
COUNTY OF
FRANKLIN, VIRGINIA
Deed Book 1079, Page 2522
Plat Book 1079, Page 2526

AS - SHOWN

STA. 90+02
FORCEMAIN AIR/VACUUM VALVE
SEE DETAIL S-14.

4" SEWER FORCEMAIN


90+10
SF

STA. 89+99
TRACER WIRE ACCESS BOX
SEE DETAIL C-4.

4' Deep

PROPOSED 30 FT COMBINED PUBLIC
WATER AND SEWER EASEMENT

PROPOSED 20 FT
PUBLIC SEWER EASEMENT

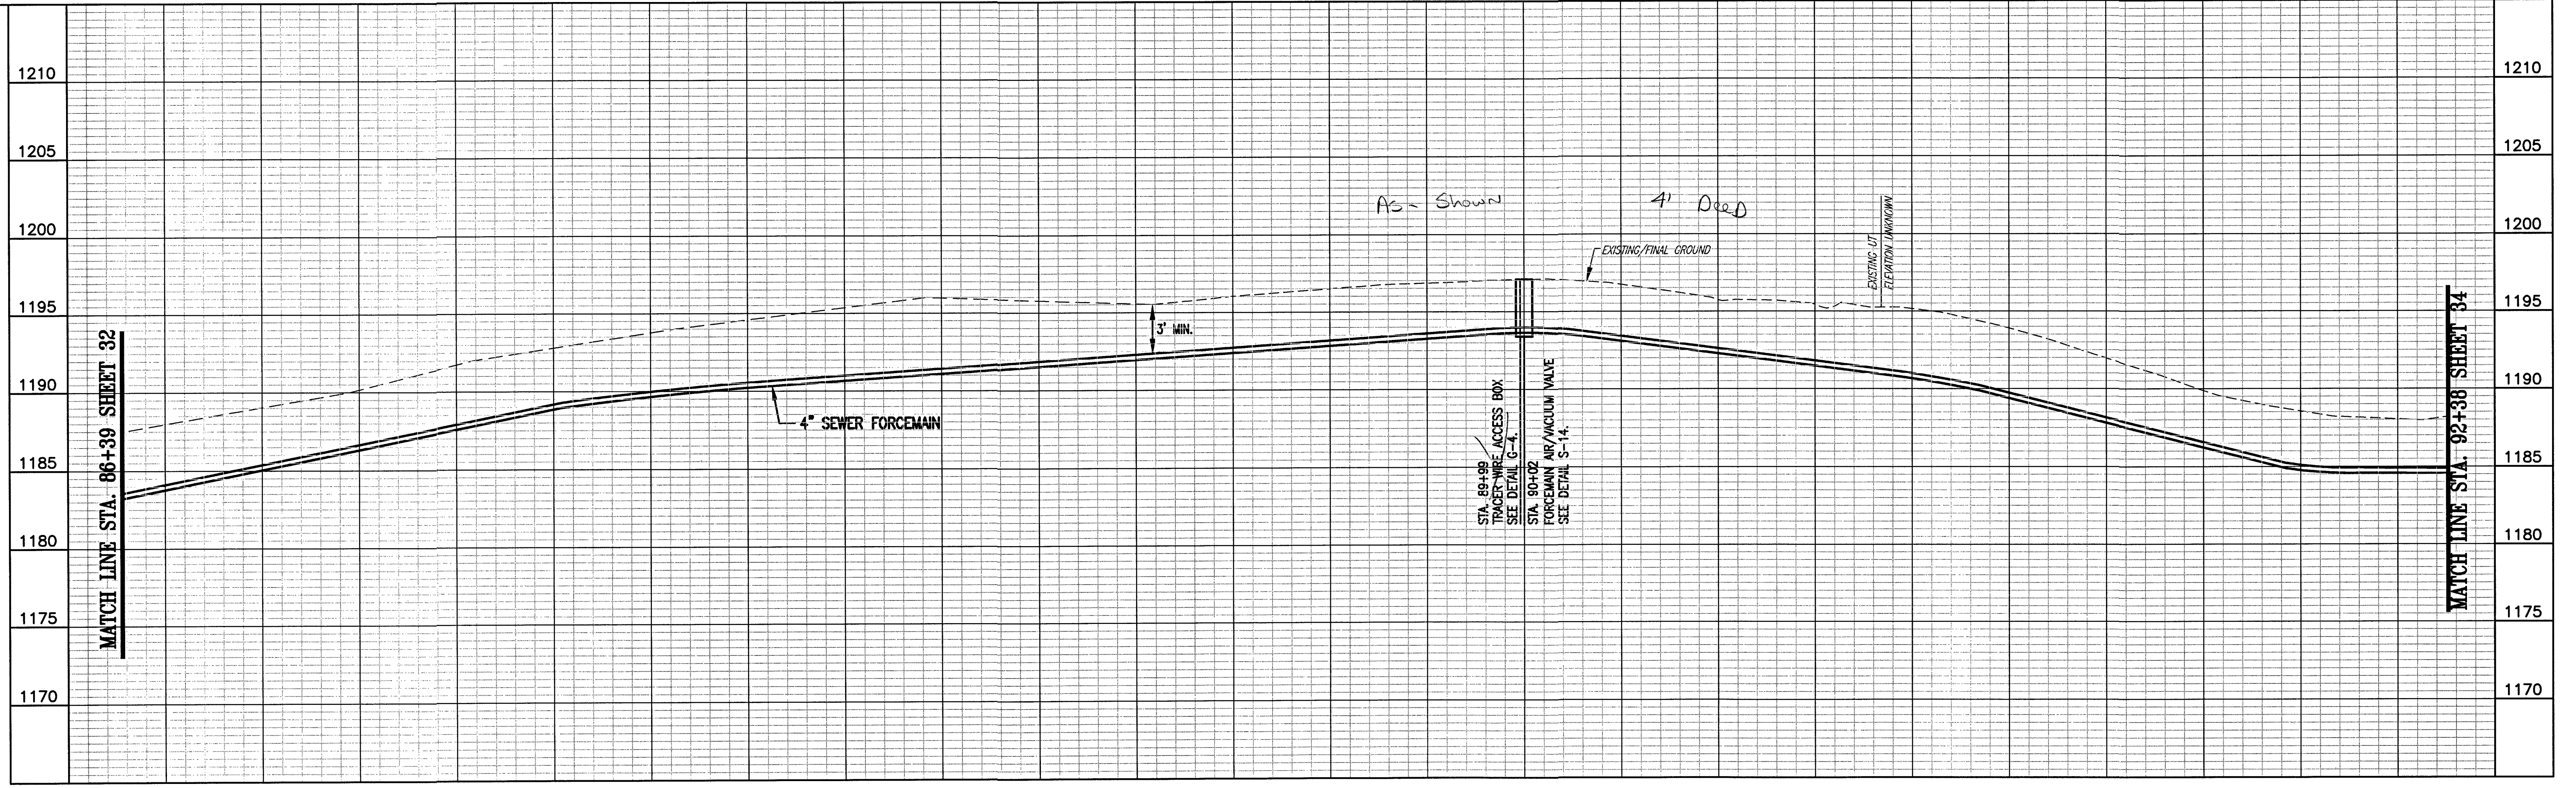


MATCH LINE STA. 86+39 SHEET 32

MATCH LINE STA. 92+38 SHEET 34

86+25 87+00 88+00 89+00 90+00 91+00 92+00

GRAPHIC SCALES

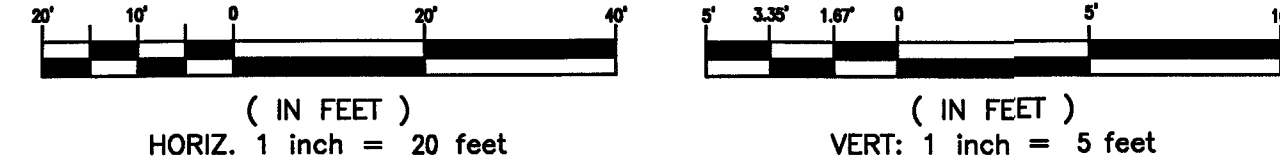

Whitman, Requardt & Associates, LLP
1700 Kraft Dr, Suite 1200, Blacksburg, VA 24060

WESTERN VIRGINIA WATER AUTHORITY
601 South Jefferson Street, Suite 300
Roanoke, Virginia 24011

DES: PJM
DRAWN: JES
CHECK: GWF
DATE: 05/24/18

SCALE: AS SHOWN
HORIZ: 1" = 20'
VERT: 1" = 5'

SUMMIT VIEW BUSINESS PARK UTILITY IMPROVEMENTS
PHASE 1

4" SEWER FORCEMAIN PLAN - PROFILE
STA. 86+39 TO STA. 92+38

As-Built		
REV	DATE	DESCRIPTION

DRAWING
C4.17
SHEET
33