

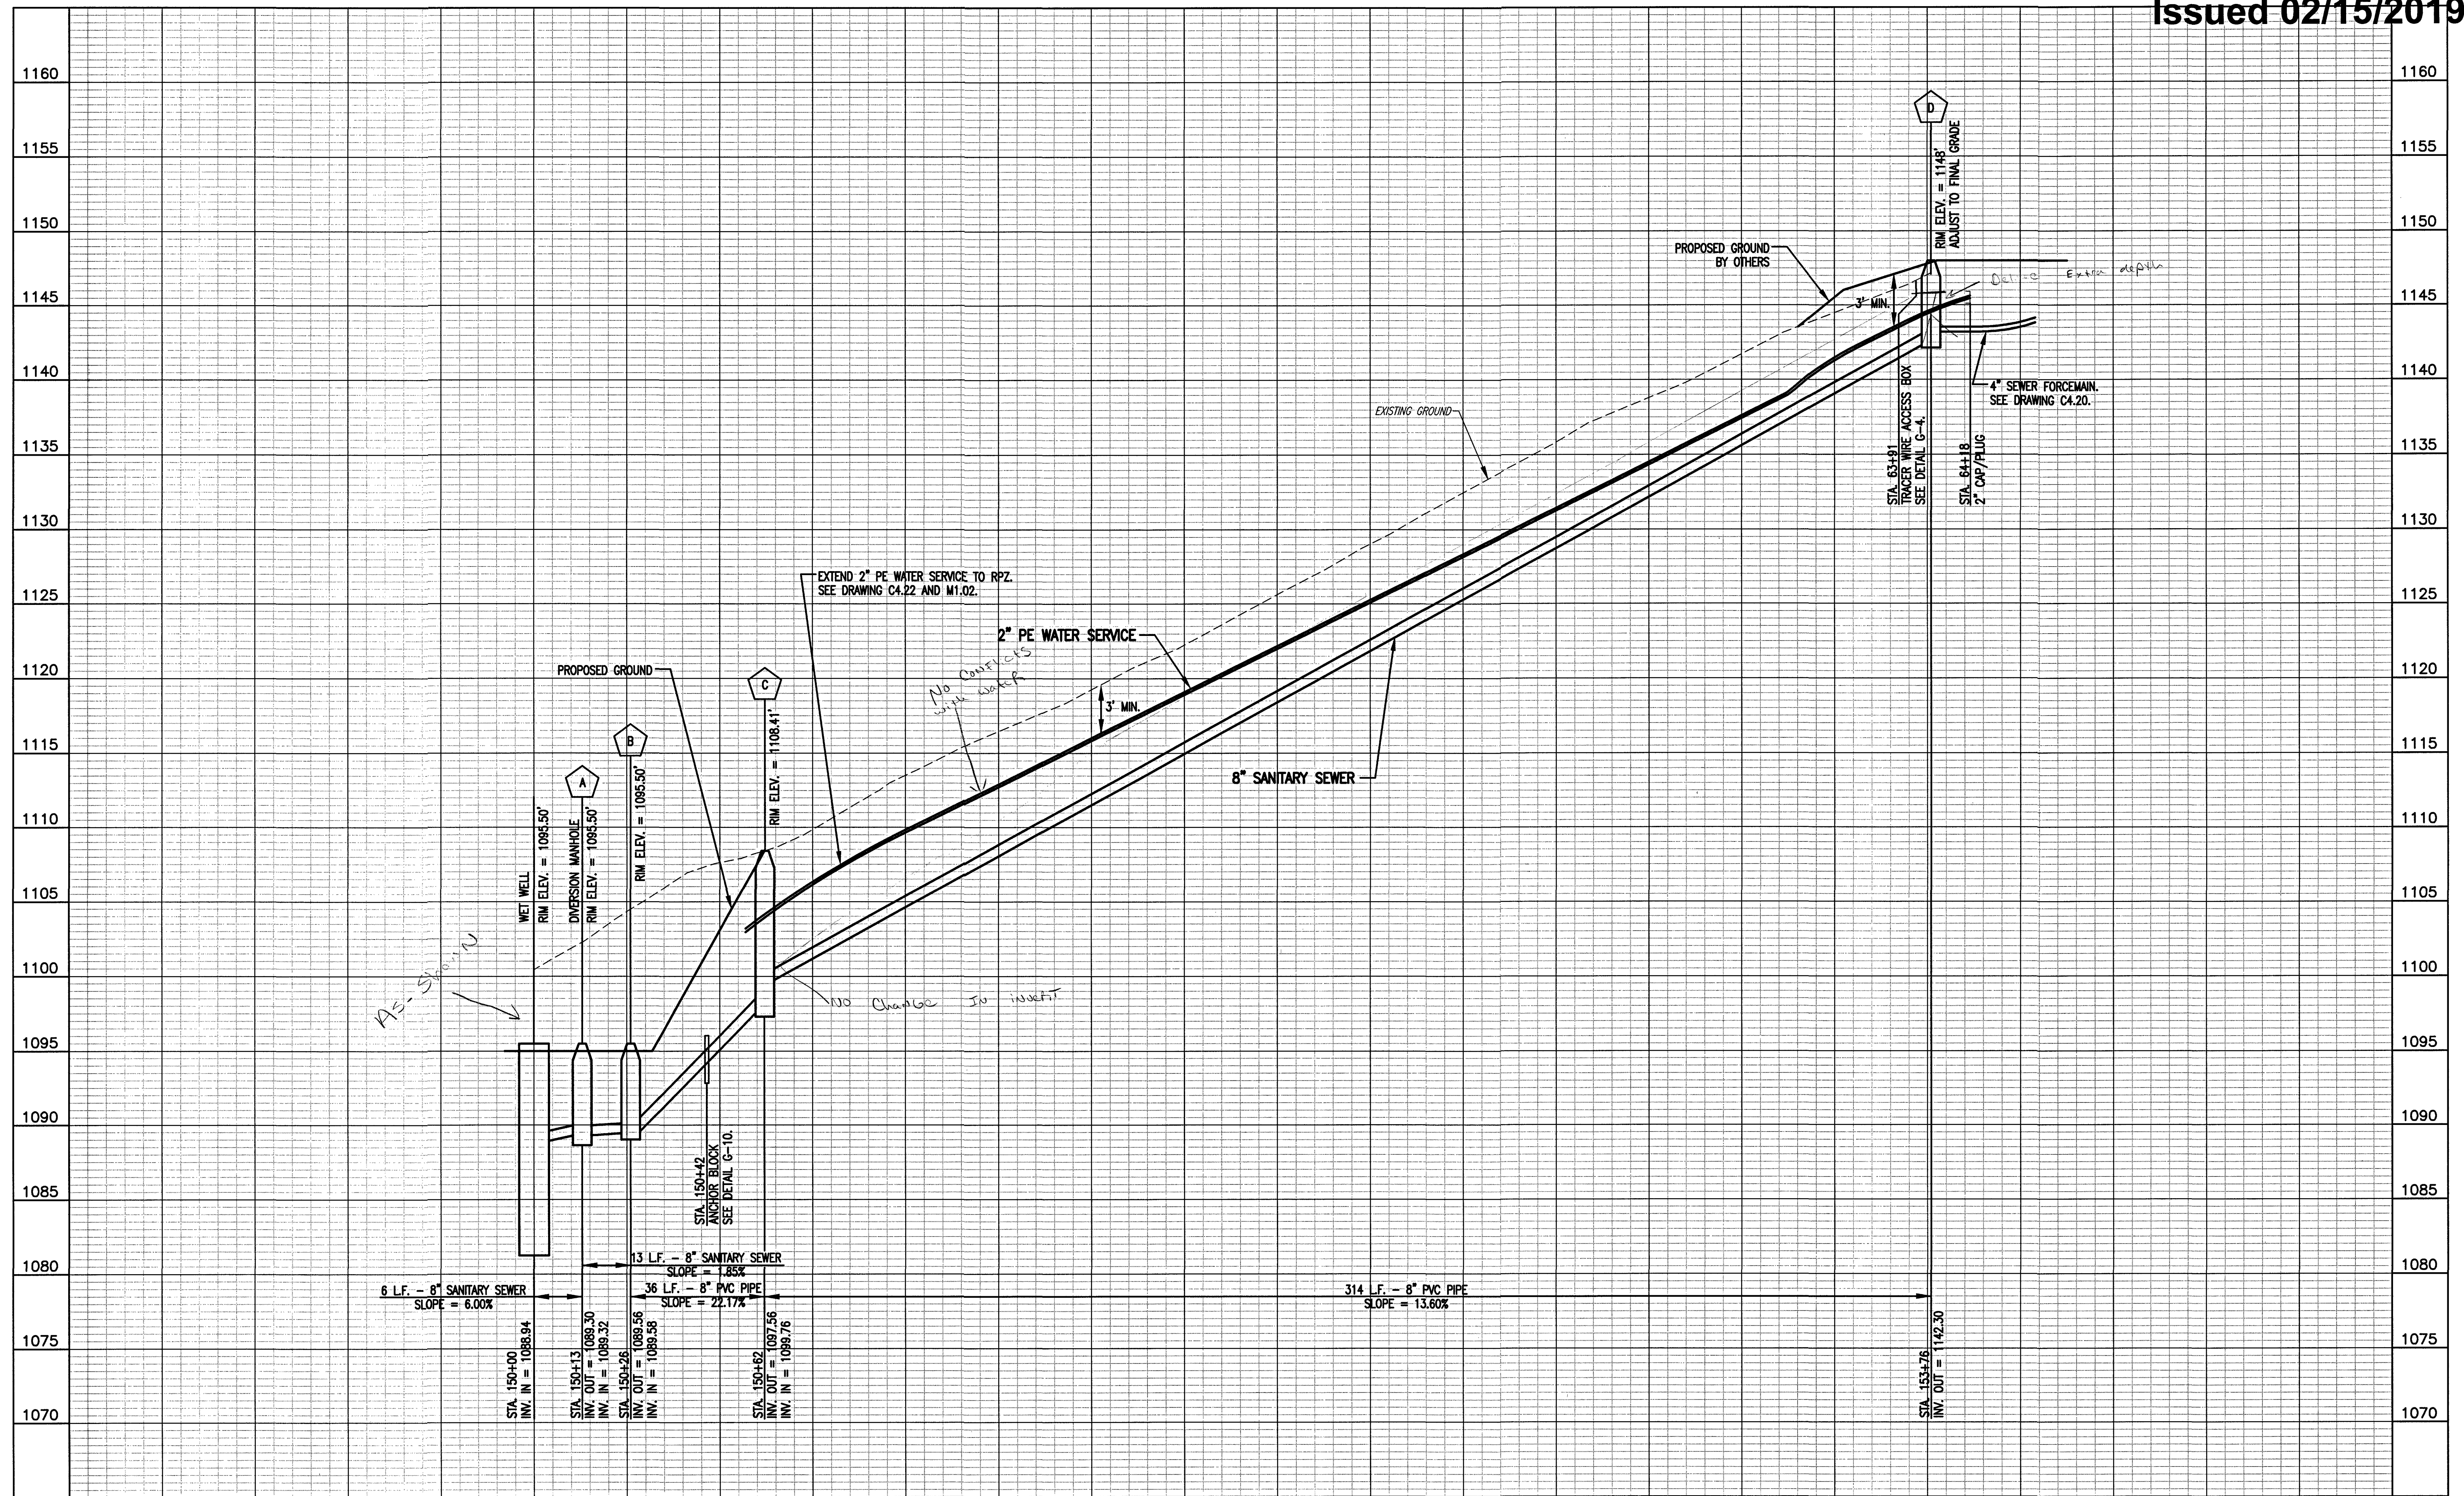


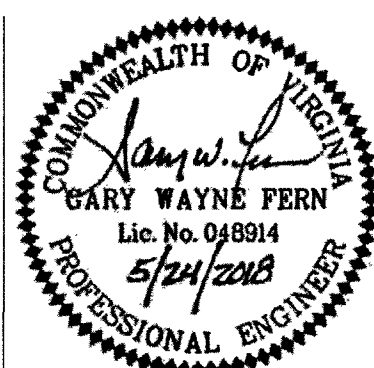

150+00 151+00 152+00 153+00 154+00

NOTE:

1. FOR PLAN SEE DRAWING C4.20 AND C4.22.

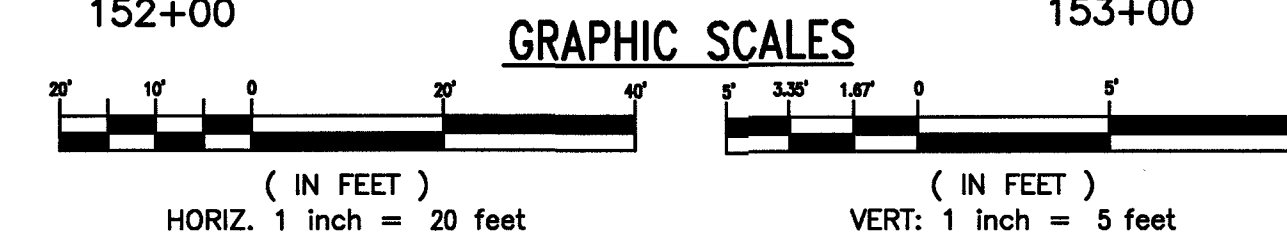

WESTERN VIRGINIA WATER AUTHORITY
601 South Jefferson Street, Suite 300
Roanoke, Virginia 24011

DES: KN
DRAWN: JES
CHECK: GWF
DATE: 05/24/18

SCALE: AS SHOWN
HORIZ: 1" = 20'
VERT: 1" = 5'

SUMMIT VIEW BUSINESS PARK UTILITY IMPROVEMENTS,
PHASE 1

8" SANITARY SEWER PROFILE
2" PE WATER SERVICE
STA. 150+00 TO STA. 153+76

DRAWING
C4.21

SHEET
37

As-Built

REV	DATE	DESCRIPTION
-----	------	-------------