


8" SEWER FORCEMAIN PLAN - PROFILE
STA. 100+00 TO STA. 104+84

AS-BUIT

REV	DATE	DESCRIPTION
OFFICE	DRAWING C4.23	SHEET 39

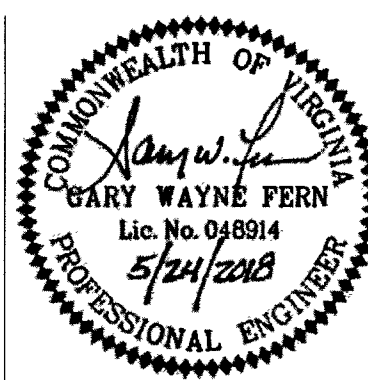

Whitman, Requardt & Associates, LLP
1700 Kraft Dr, Suite 1200, Blacksburg, VA 24060

WESTERN VIRGINIA WATER AUTHORITY
601 South Jefferson Street, Suite 300
Roanoke, Virginia 24011

DES:	KN
DRAWN:	JES
CHECK:	GWF
DATE:	08/01/18

SCALE:	AS SHOWN
HORIZ:	1" = 20'
VERT:	1" = 5'