
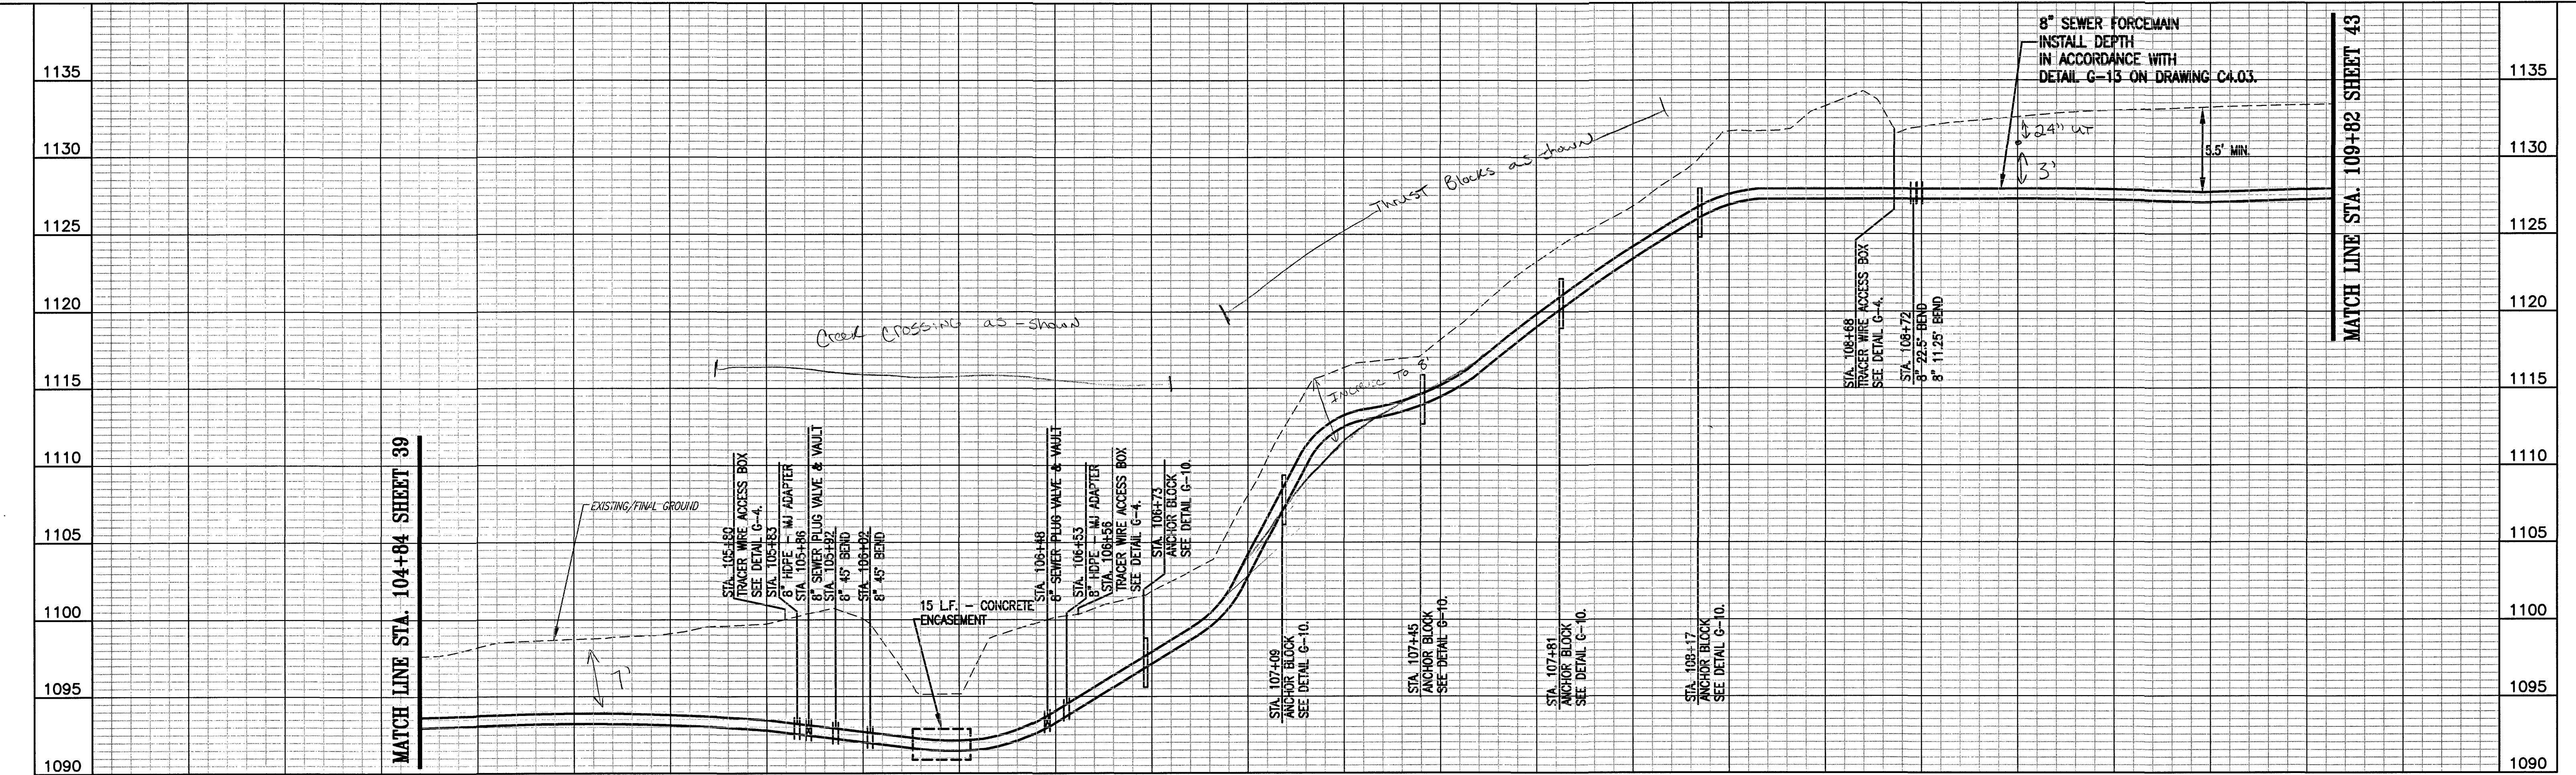


NOTE:
1. ALL PIPE MATERIALS SHALL BE AS SPECIFIED ON THE PIPE SCHEDULE SHOWN ON DRAWING C4.02.

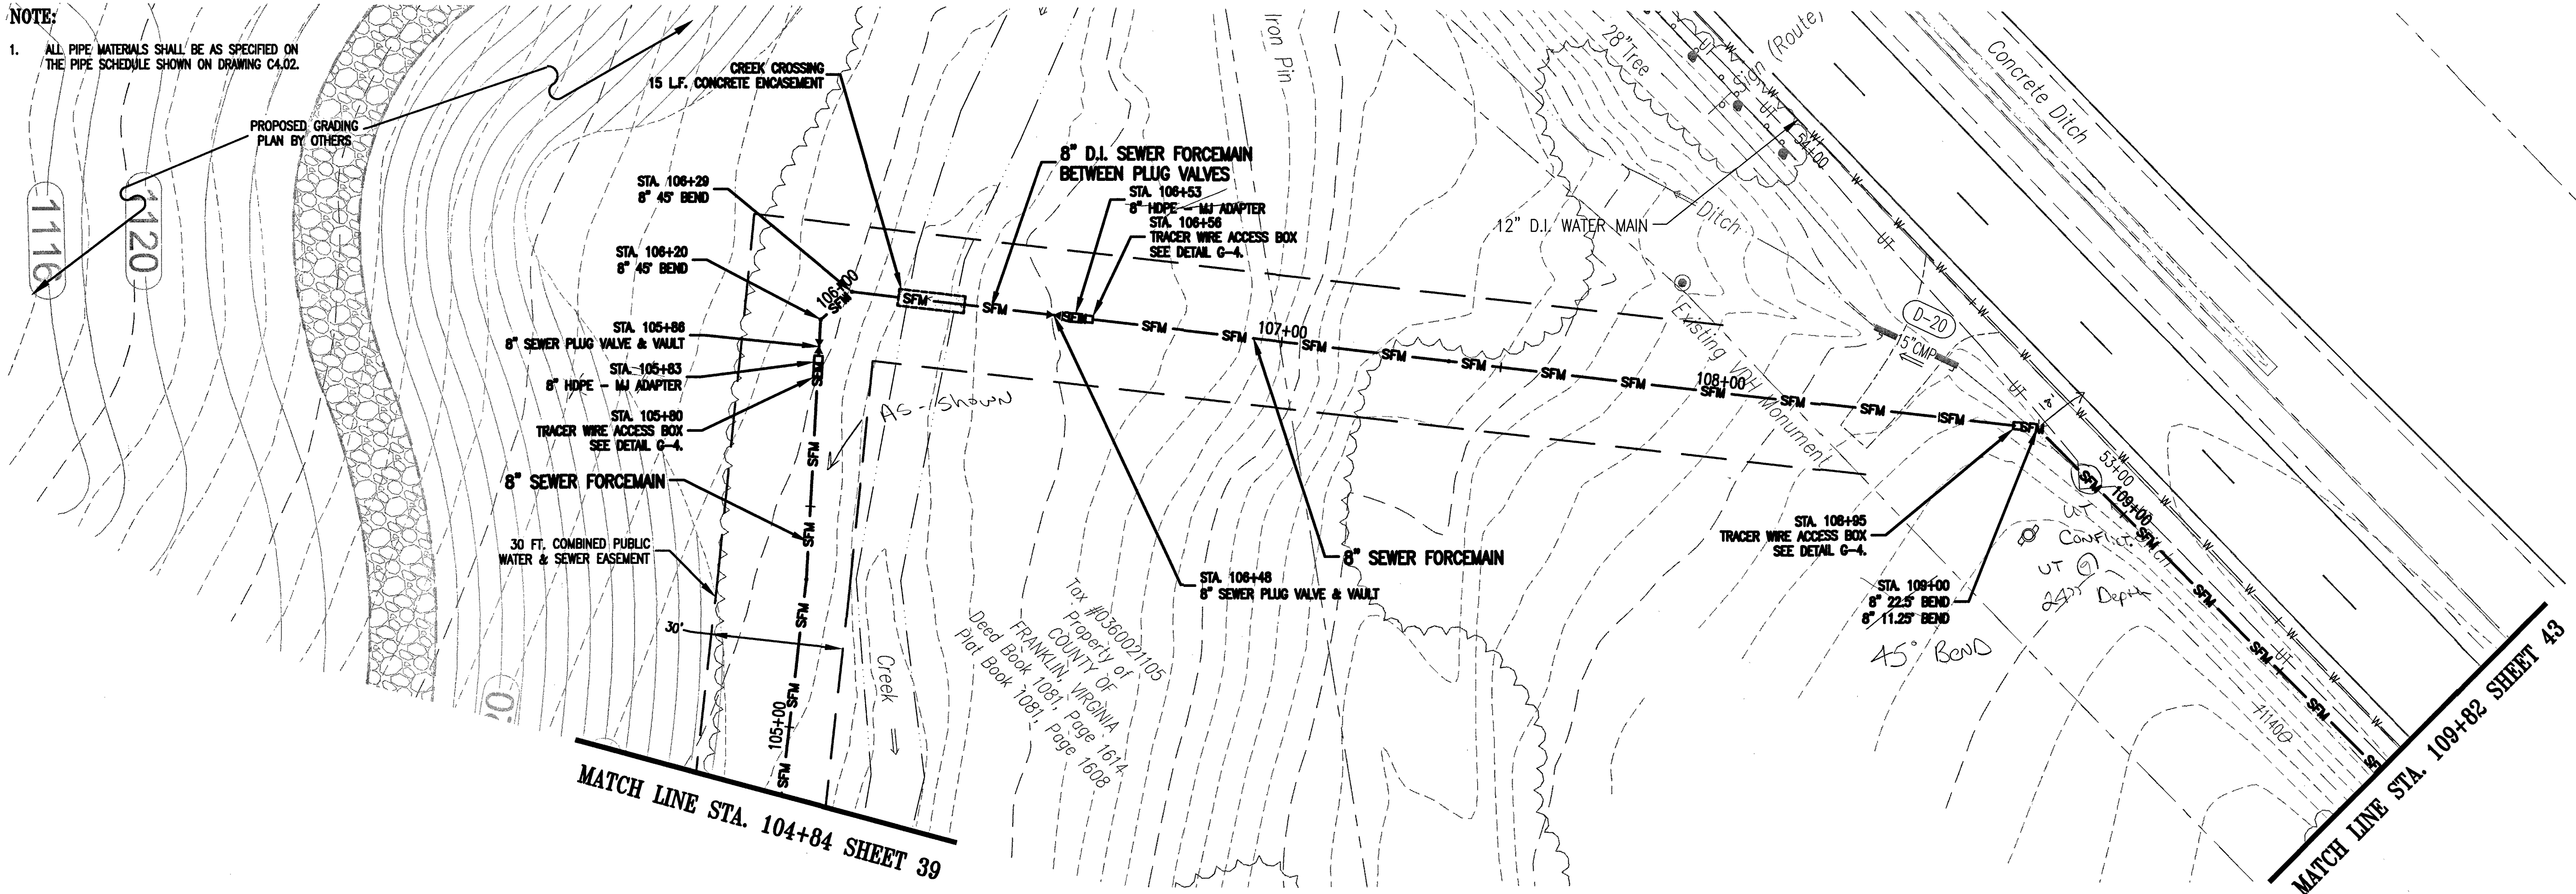

WESTERN VIRGINIA WATER AUTHORITY
601 South Jefferson Street, Suite 300
Roanoke, Virginia 24011

DES: KN
DRAWN: JES
CHECK: GWF
DATE: 08/01/18

SCALE: AS SHOWN
HORIZ: 1" = 20'
VERT: 1" = 5'

SUMMIT VIEW BUSINESS PARK UTILITY IMPROVEMENTS
PHASE 1

8" SEWER FORCEMAIN PLAN - PROFILE
STA. 104+84 TO STA. 109+82

As-Built

REV	DATE	DESCRIPTION

DRAWING: C4.24
SHEET: 40