

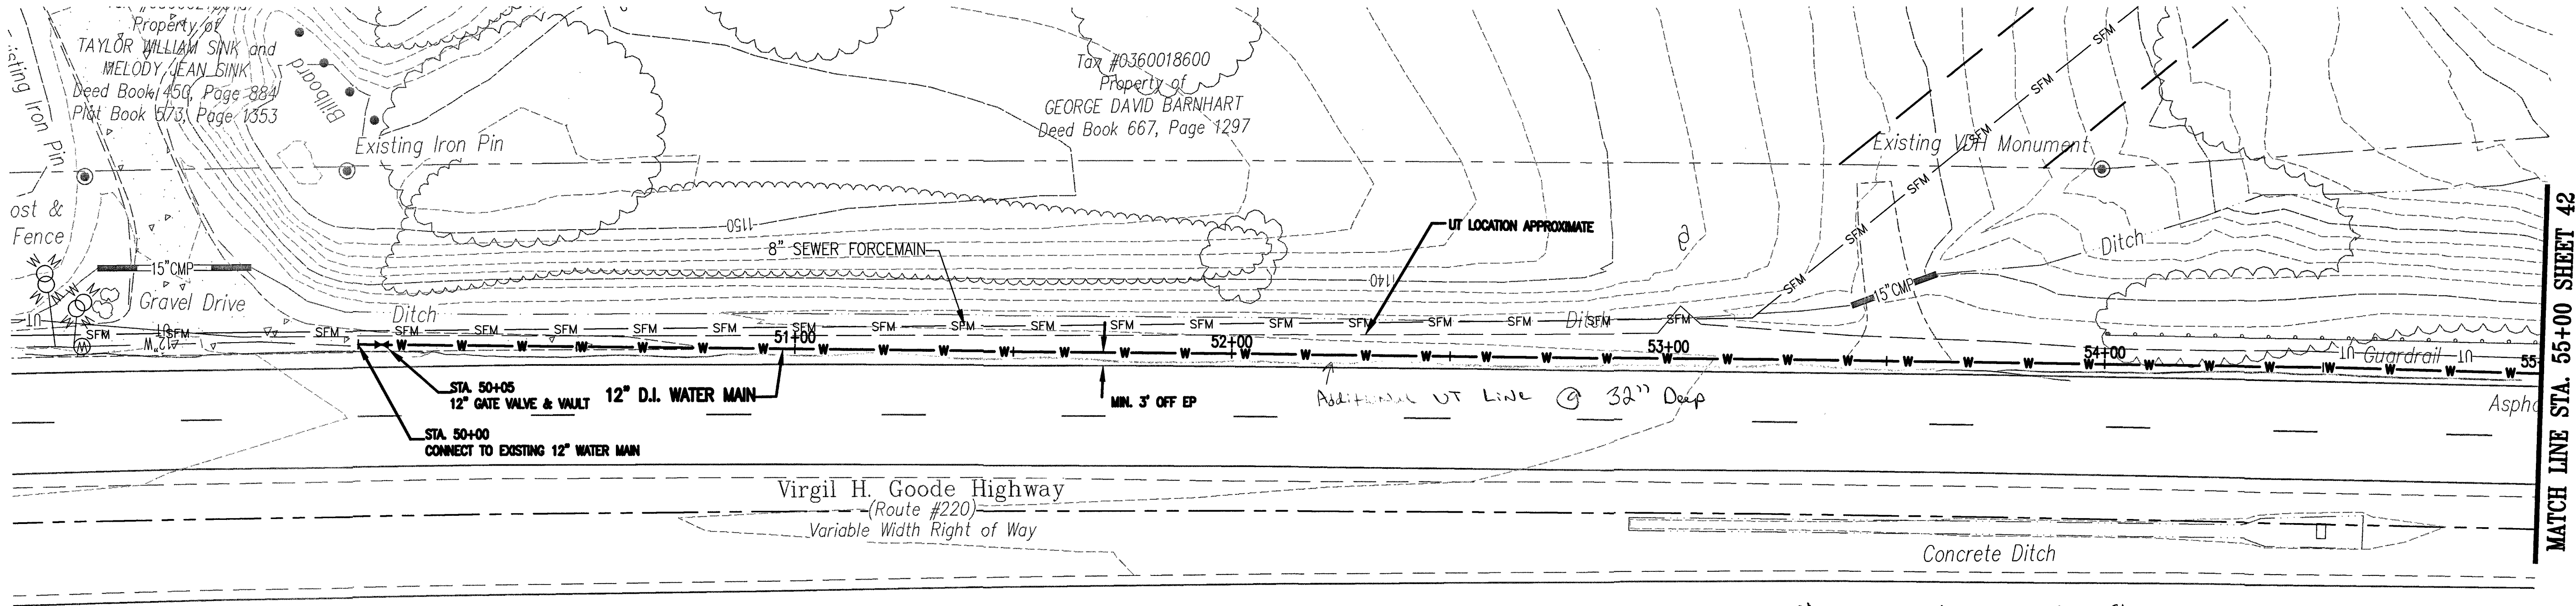


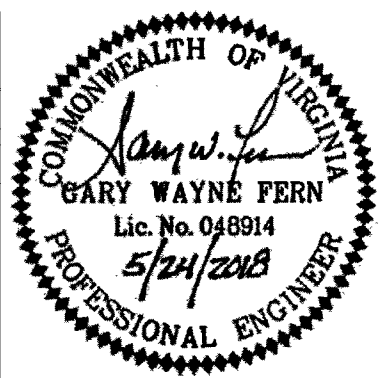

* water line, as shown.
Additional UT beside water line
NOT shown on plans.

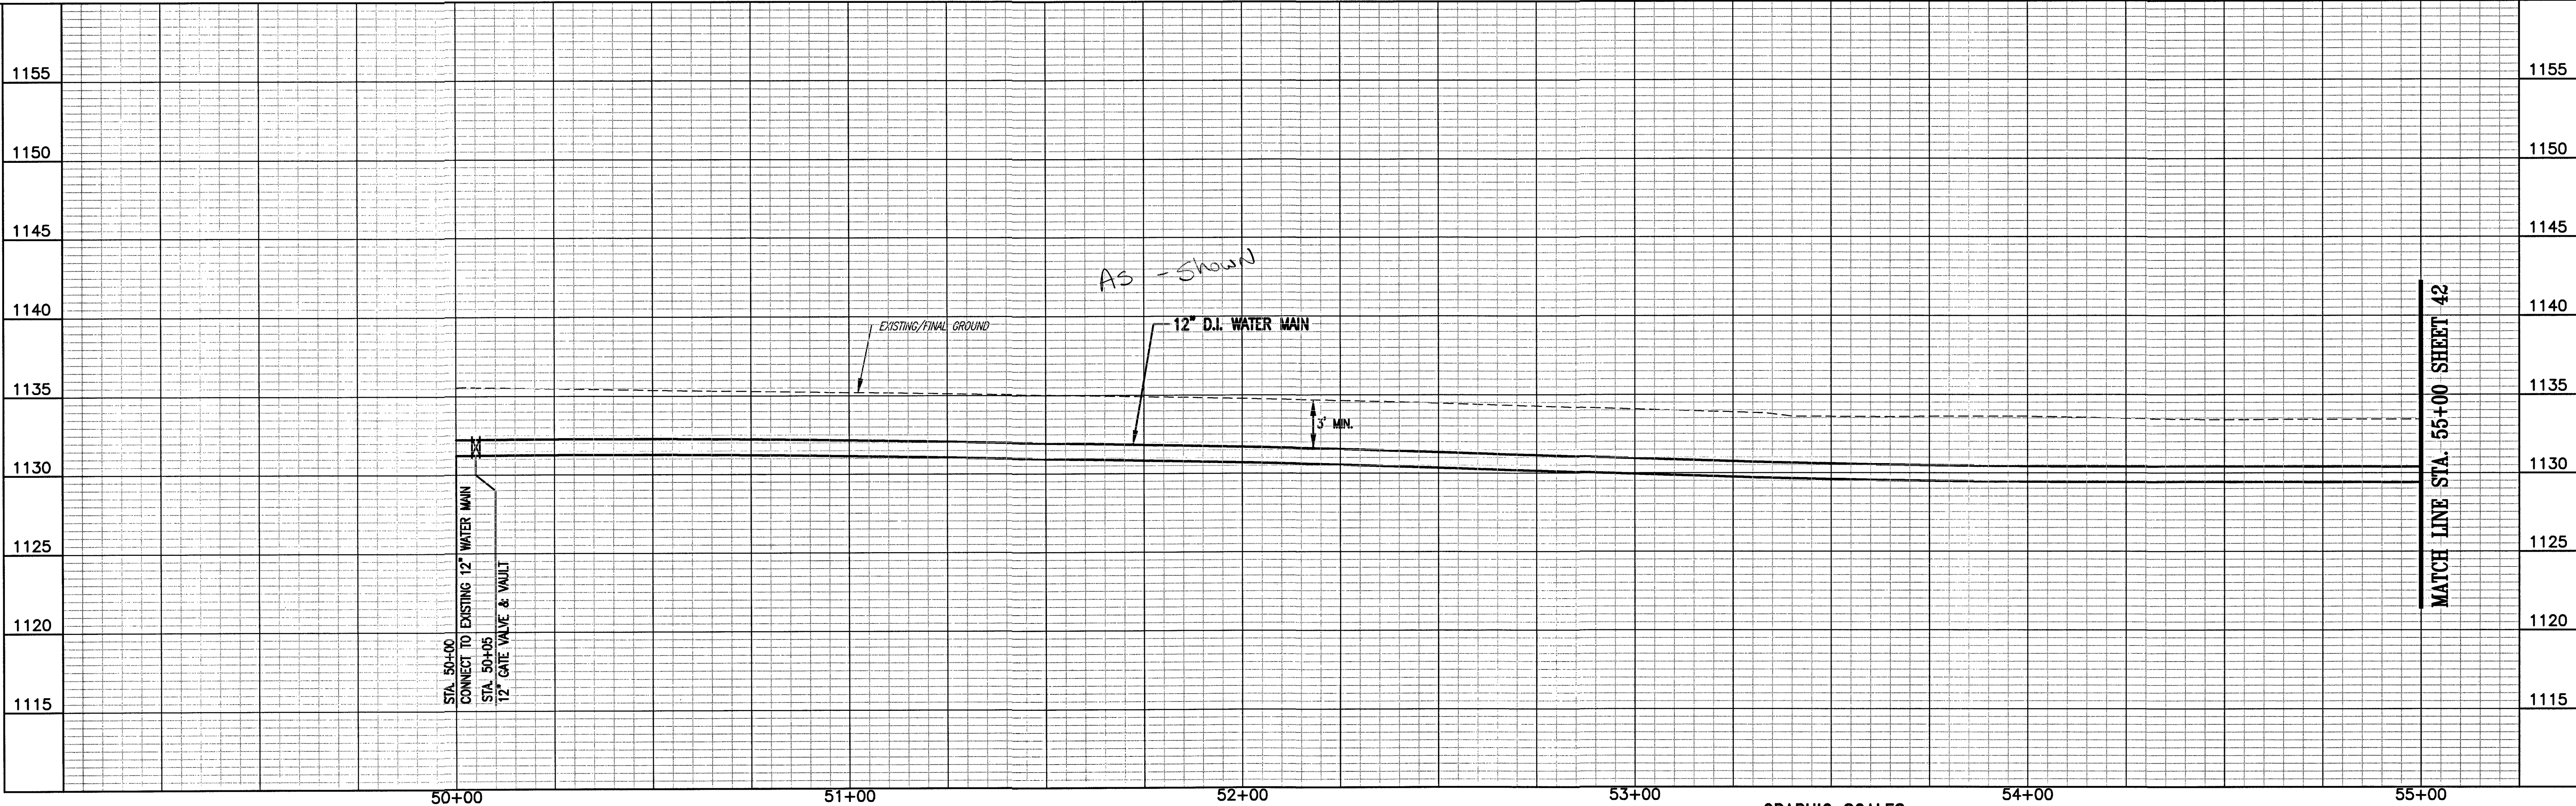

WESTERN VIRGINIA WATER AUTHORITY 601 South Jefferson Street, Suite 300 Roanoke, Virginia 24011		DES: KN DRAWN: JES CHECK: GWF DATE: 08/01/18	SCALE: AS SHOWN HORIZ: 1" = 20' VERT: 1" = 5'	SUMMIT VIEW BUSINESS PARK UTILITY IMPROVEMENTS PHASE 1	12" D.I. WATER MAIN PLAN - PROFILE STA. 50+00 TO STA. 55+00	AS-BUILT REV: DATE: DESCRIPTION: DRAWING C4.25	SHEET 41
--	--	---	---	---	--	---	-------------