
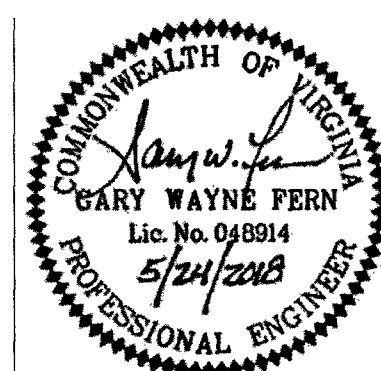
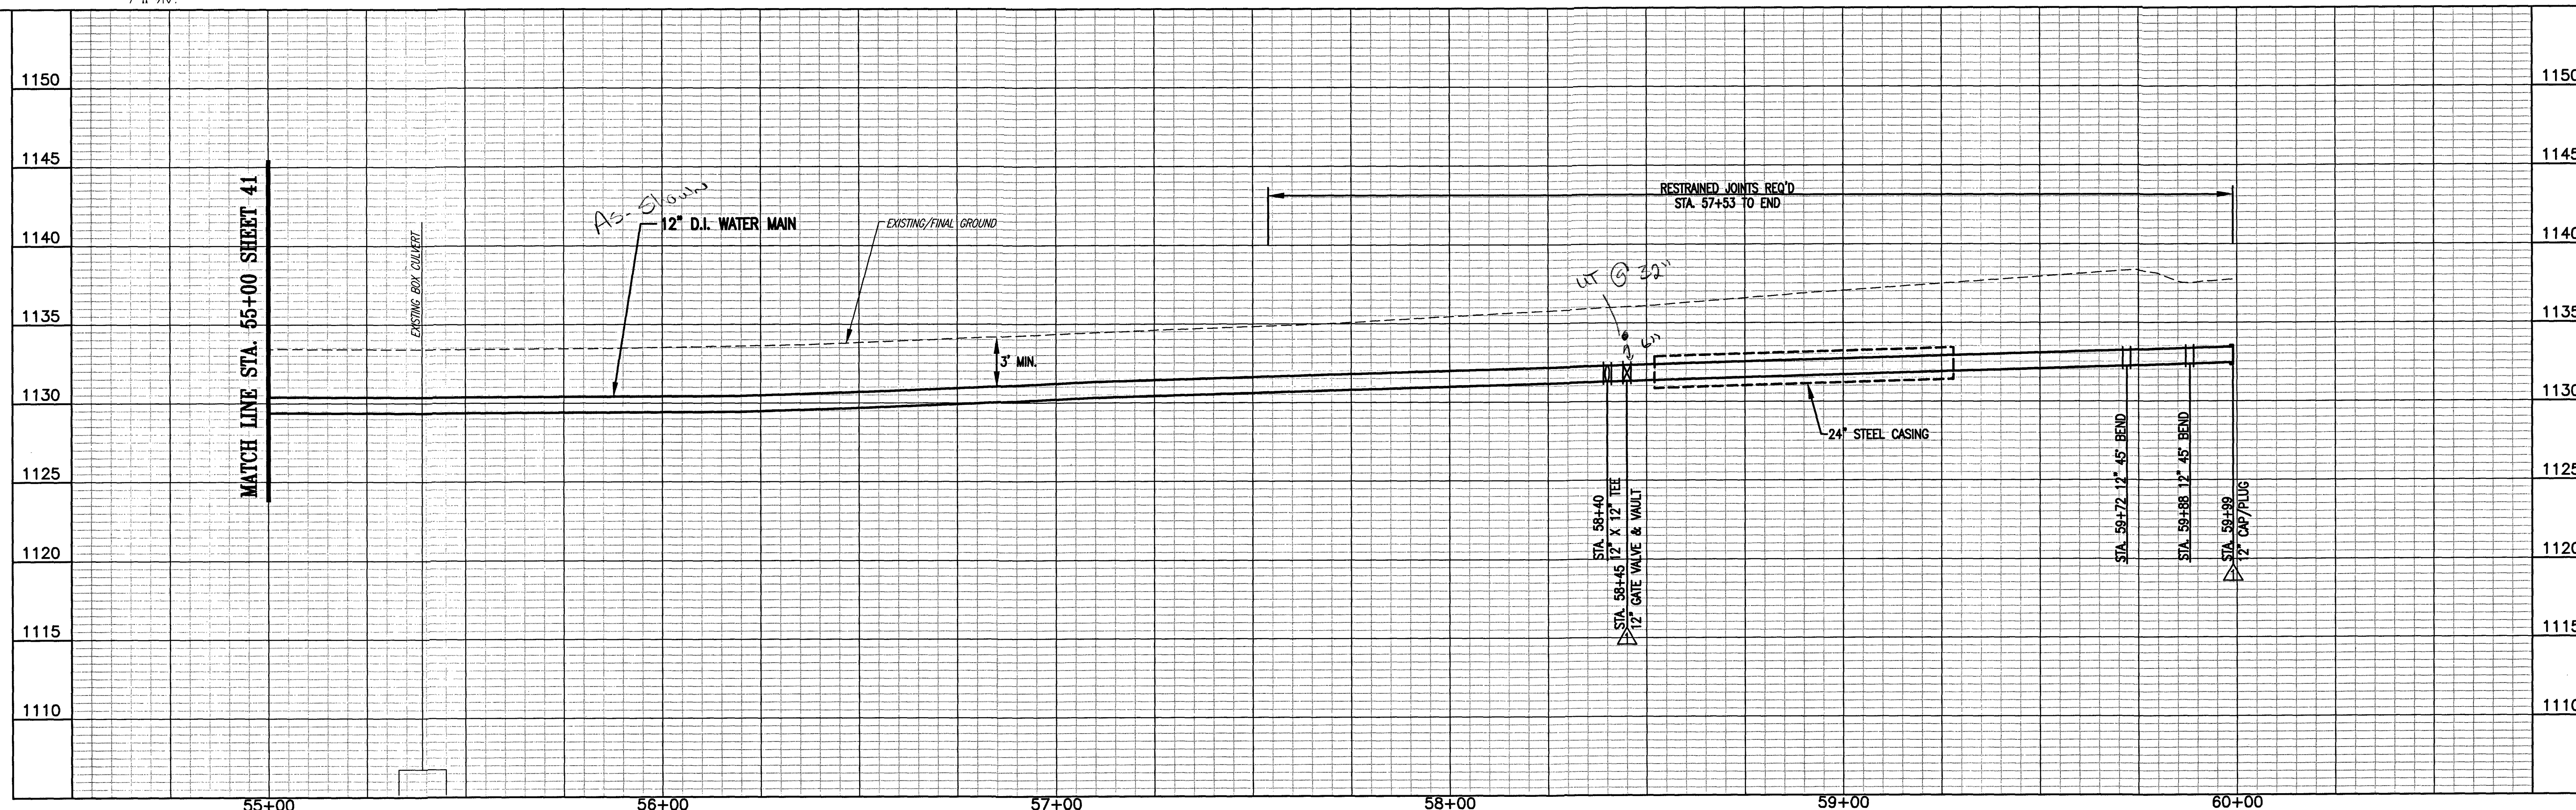


NOTE:

1. ALL PIPE MATERIALS SHALL BE AS SPECIFIED ON THE PIPE SCHEDULE SHOWN ON DRAWING C4.02.

Issued 02/15/2019

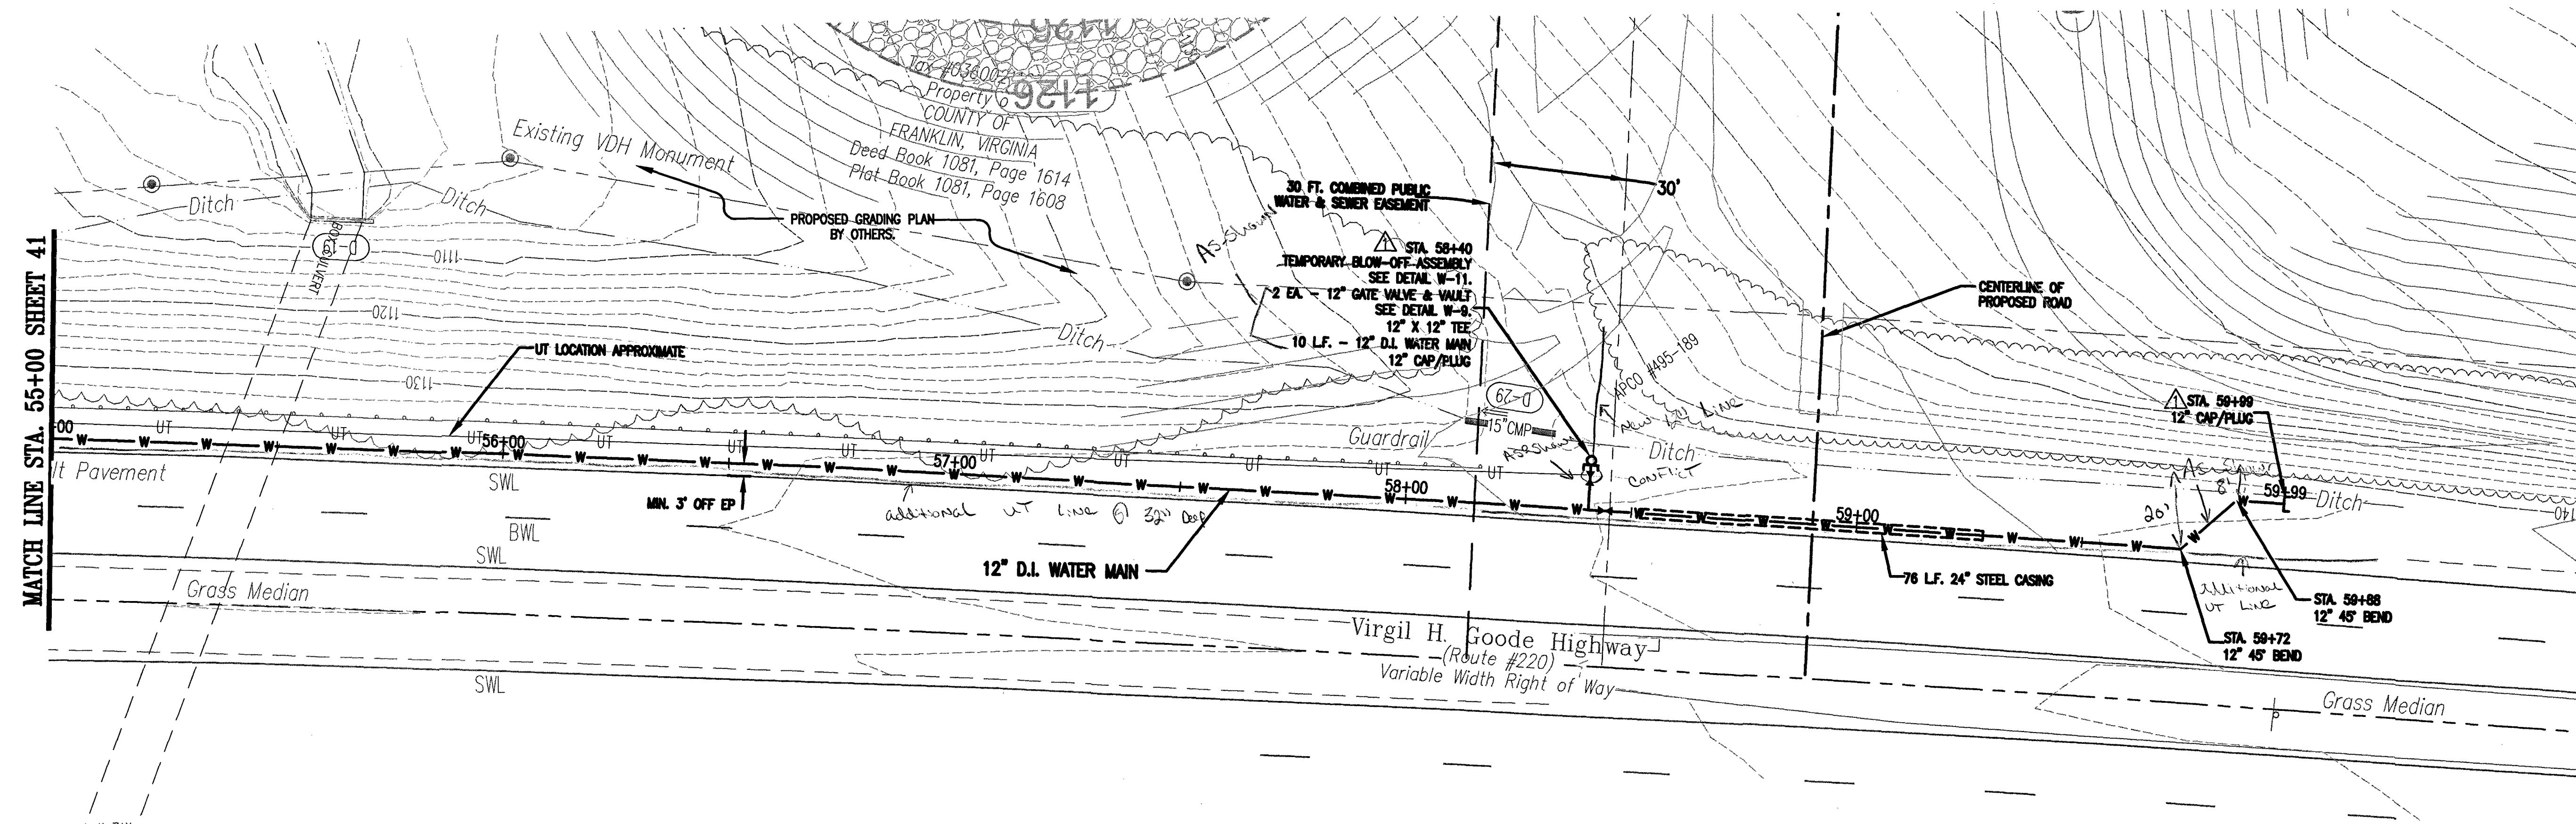

WESTERN VIRGINIA WATER AUTHORITY 601 South Jefferson Street, Suite 300 Roanoke, Virginia 24011		DES: KN DRAWN: JES CHECK: GWF DATE: 08/17/18	SCALE: AS SHOWN HORIZ: 1" = 20' VERT: 1" = 5'	SUMMIT VIEW BUSINESS PARK UTILITY IMPROVEMENTS PHASE 2 OF PHASE 1	12" D.I. WATER MAIN PLAN - PROFILE STA. 55+00 TO STA. 59+99	DRAWING C4.26	SHEET 42
--	--	---	---	--	--	------------------	-------------

As-Built		
REV	DATE	DESCRIPTION
1	10/05/2018	REVISED DRAWING PER ADDENDUM 1