
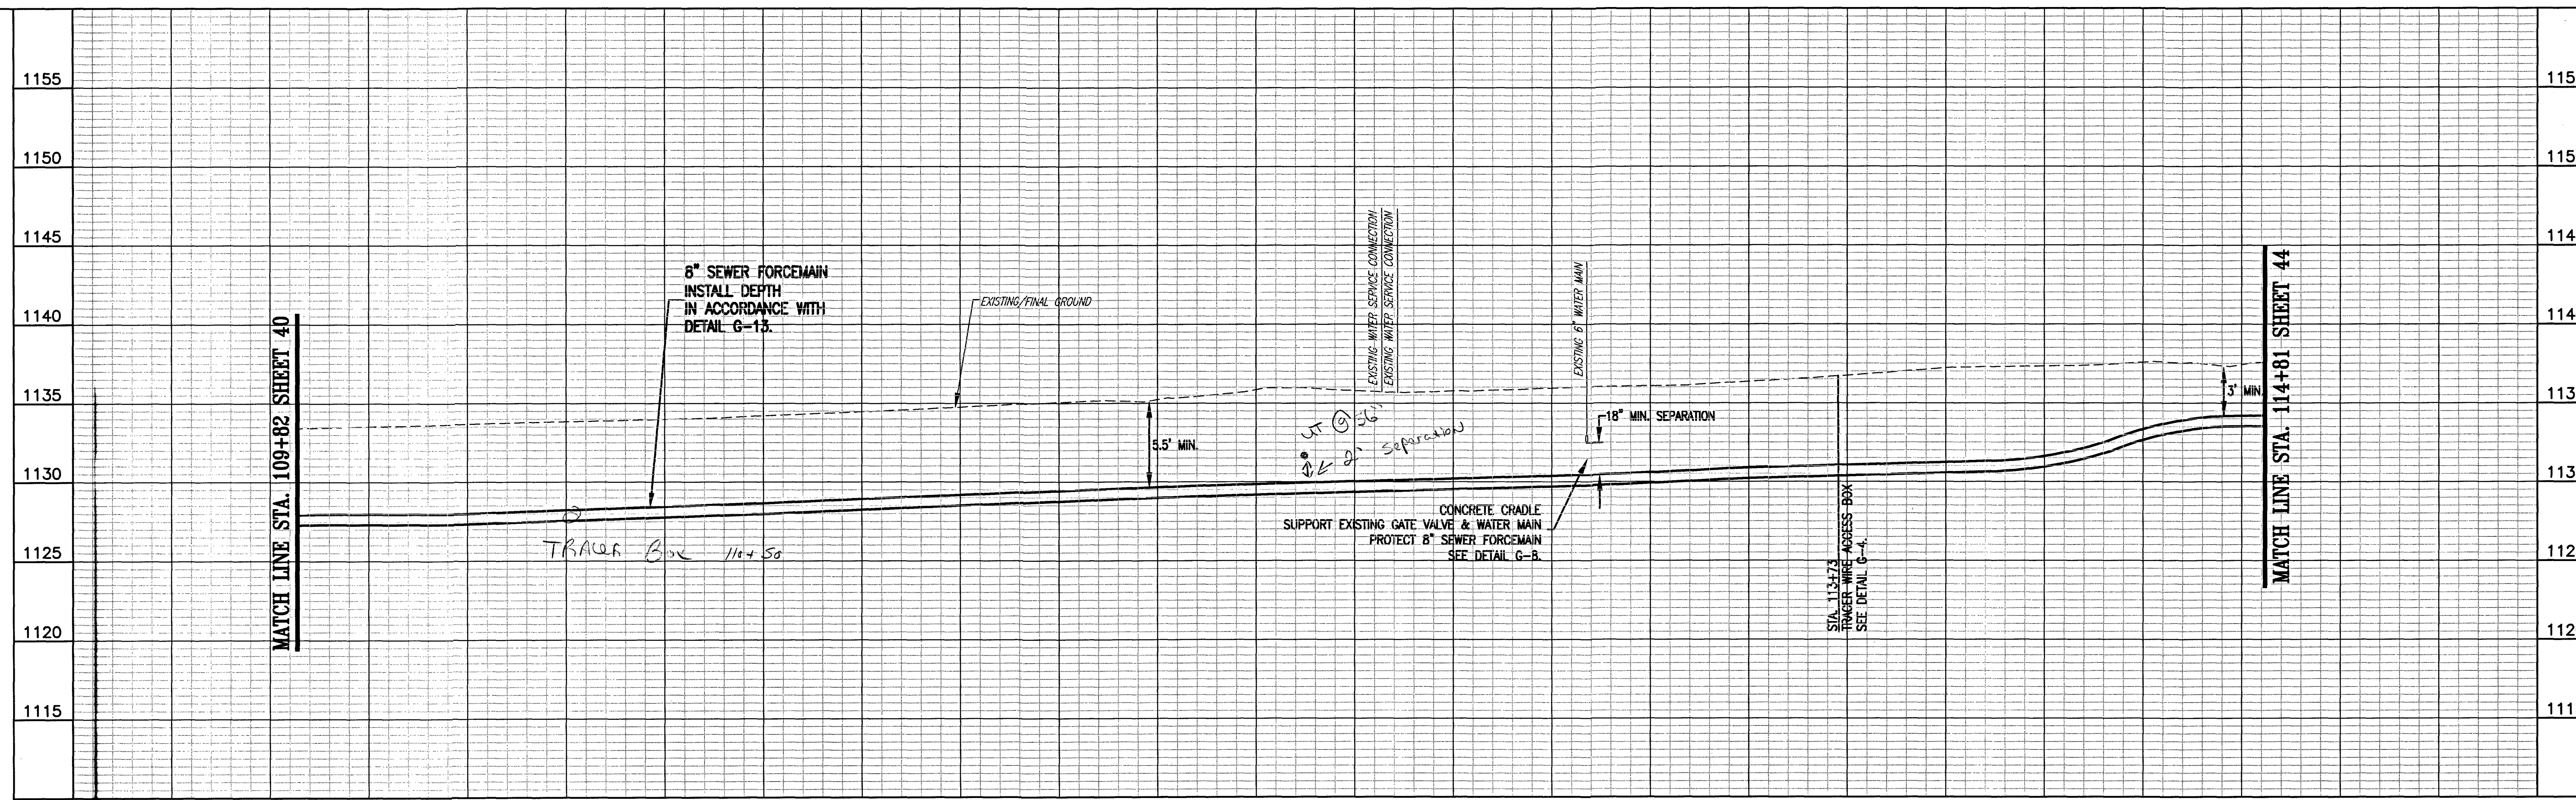


NOTE:

1. ALL PIPE MATERIALS SHALL BE AS SPECIFIED ON THE PIPE SCHEDULE SHOWN ON DRAWING C4.02.

Issued 02/15/2019

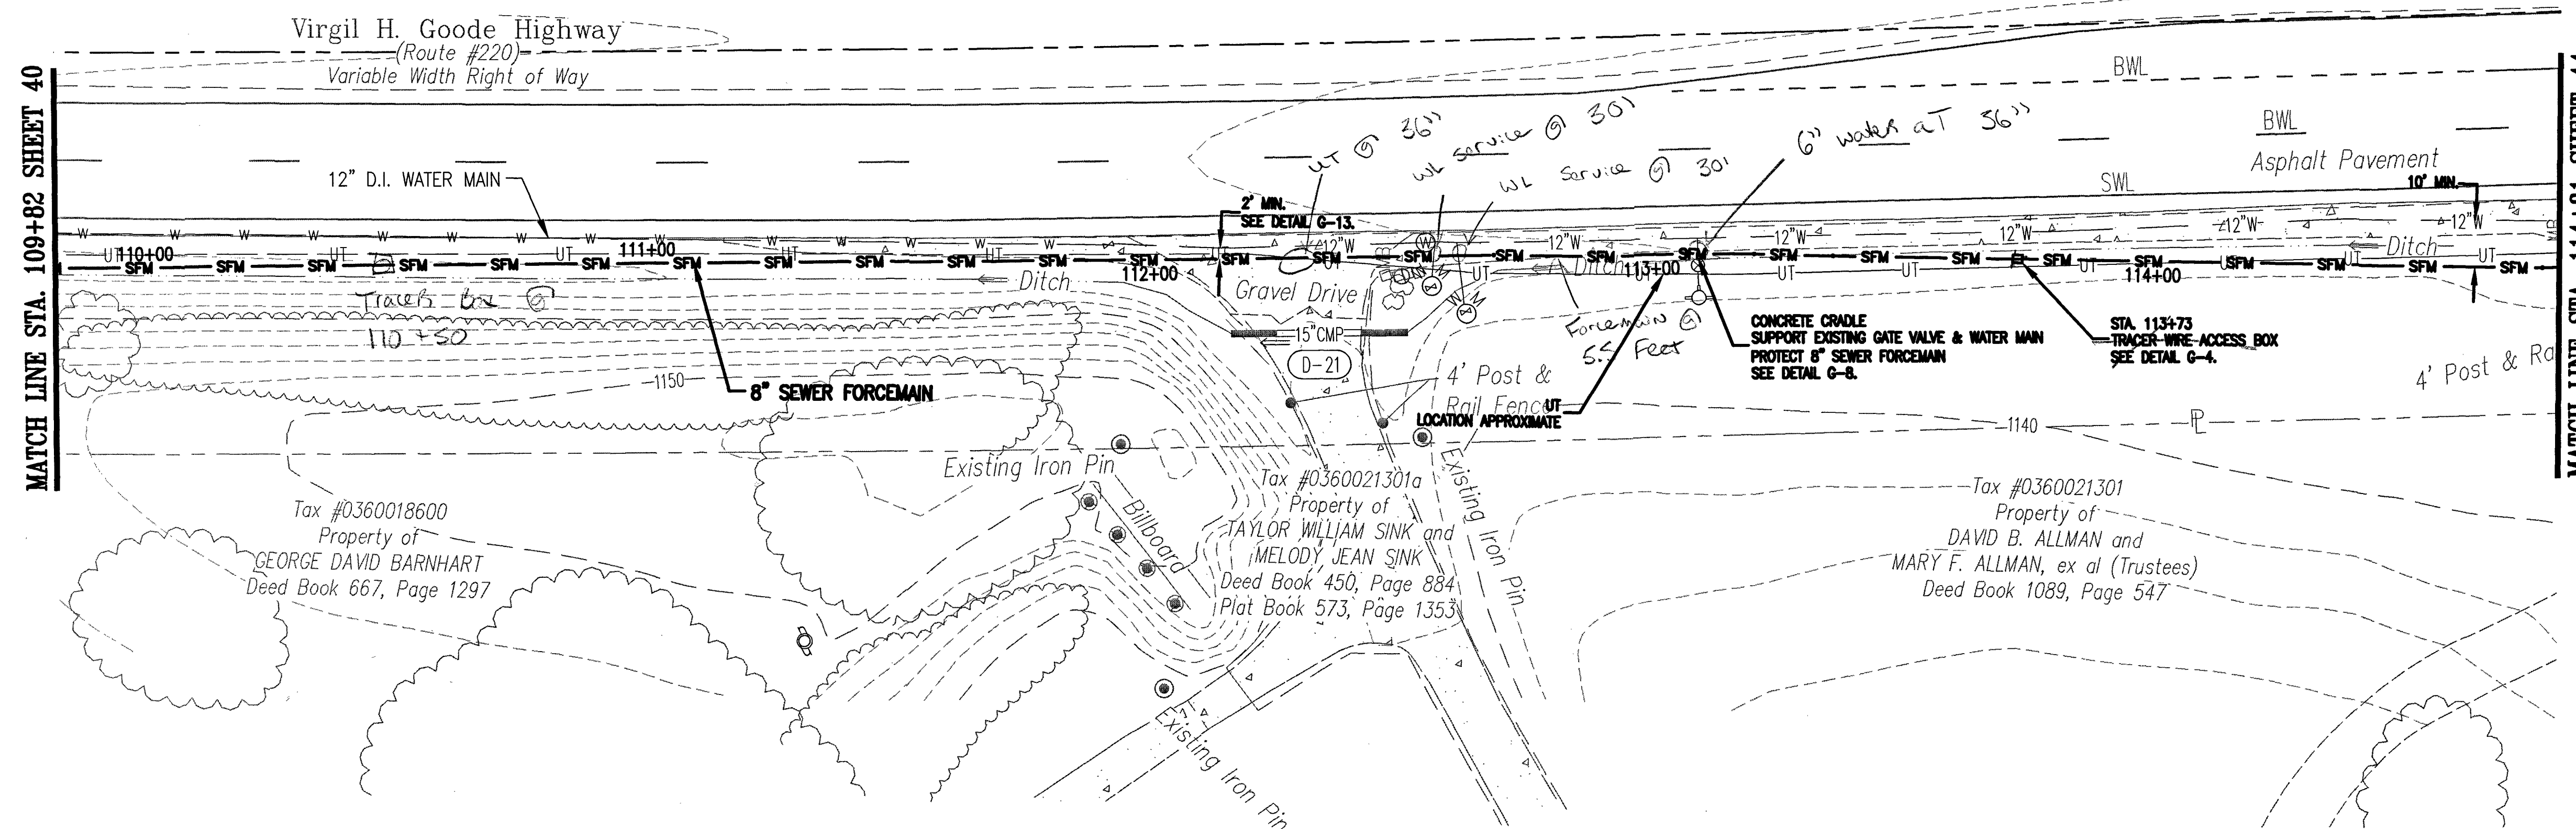

110+00

111+00


112+00

113+00

114+00


115+00

GRAPHIC SCALES

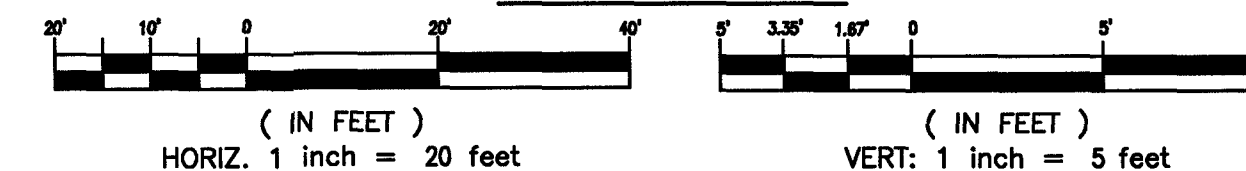

AS-BUILT

REV DATE DESCRIPTION

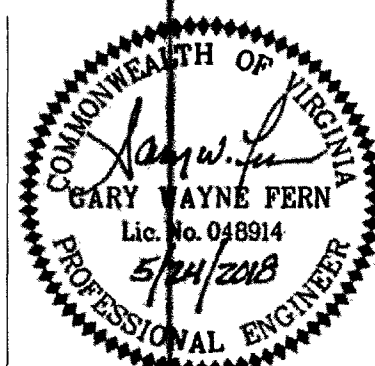

WESTERN VIRGINIA WATER AUTHORITY
601 South Jefferson Street, Suite 300
Roanoke, Virginia 24011

DES: KN
DRAWN: JES
CHECK: GWF
DATE: 08/01/18
SCALE: AS SHOWN
HORIZ: 1" = 20'
VERT: 1" = 5'

SUMMIT VIEW BUSINESS PARK UTILITY IMPROVEMENTS
PHASE 1

8" SEWER FORCEMAIN PLAN - PROFILE
STA. 109+82 TO STA. 114+81

DRAWING
C4.27

SHEET
43