
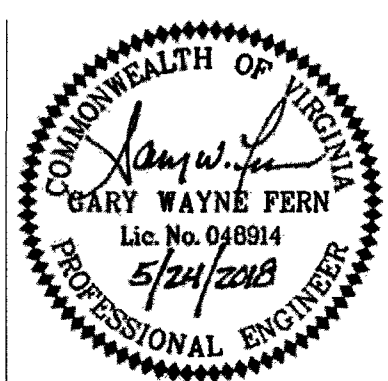
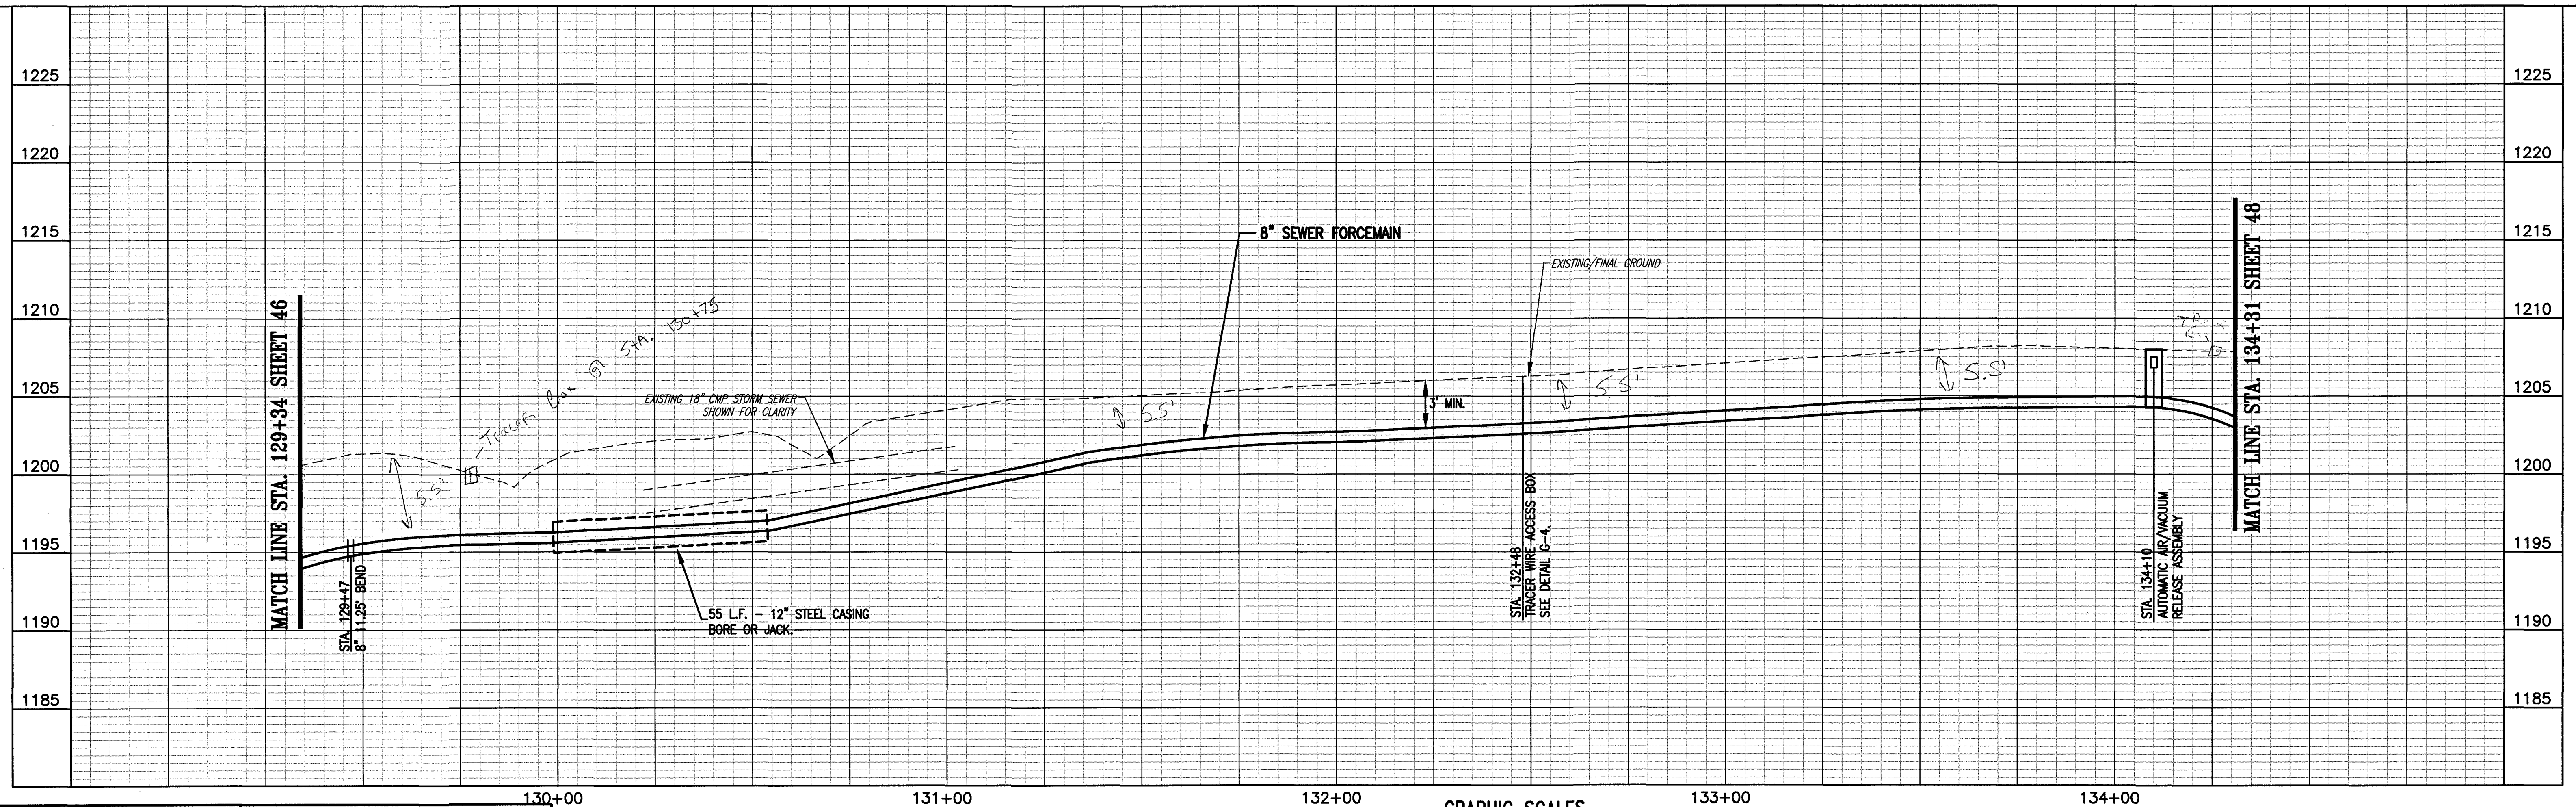


NOTE:

1. ALL PIPE MATERIALS SHALL BE AS SPECIFIED ON THE PIPE SCHEDULE SHOWN ON DRAWING C4.02.

Issued 02/15/2019

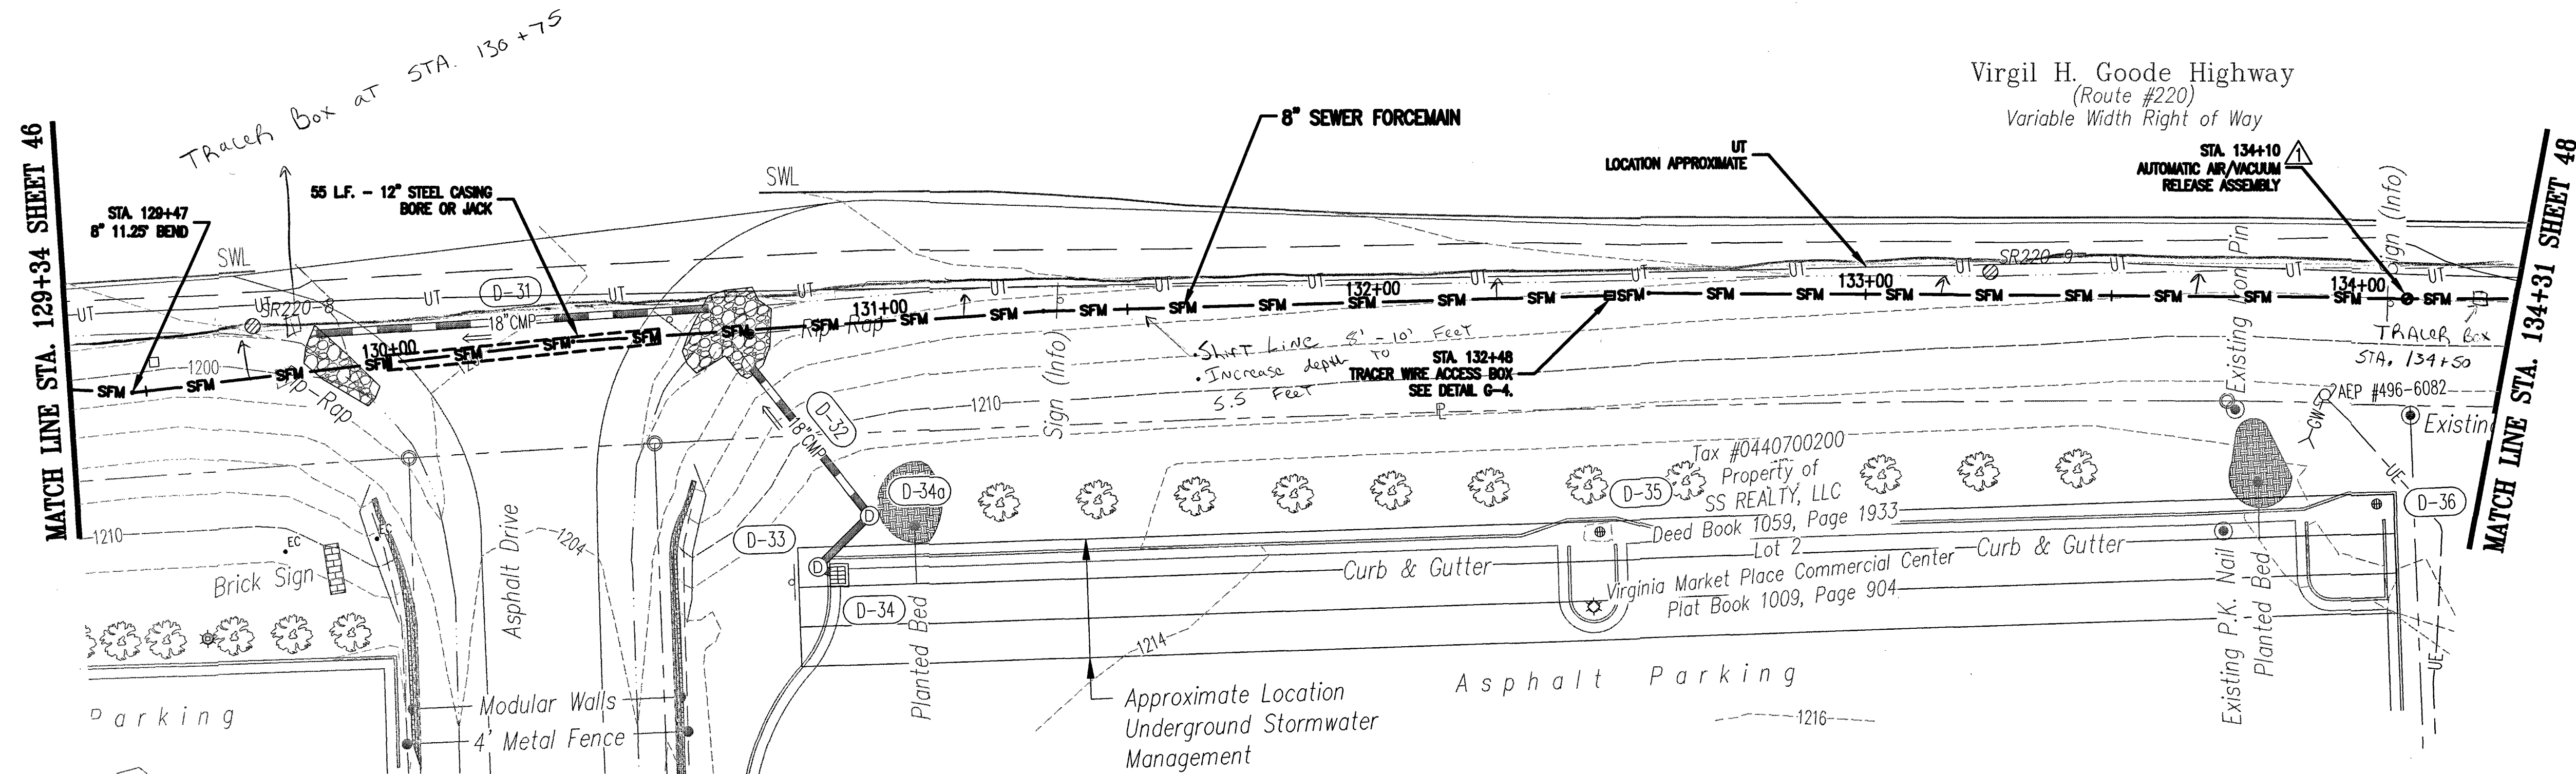

WESTERN VIRGINIA WATER AUTHORITY
601 South Jefferson Street, Suite 300
Roanoke, Virginia 24011

DES: KN
DRAWN: JES
CHECK: GWF
DATE: 08/17/18

SCALE: AS SHOWN
HORIZ: 1" = 20'
VERT: 1" = 5'

SUMMIT VIEW BUSINESS PARK UTILITY IMPROVEMENTS
PHASE 2 OF PHASE 1

8" SEWER FORCEMAIN PLAN - PROFILE
STA. 129+34 TO STA. 134+31

DRAWING
C4.31

SHEET
47

As-Built		
REV	DATE	DESCRIPTION
1	10/24/18	REVISION TO SEWER FORCEMAIN ALIGNMENT