
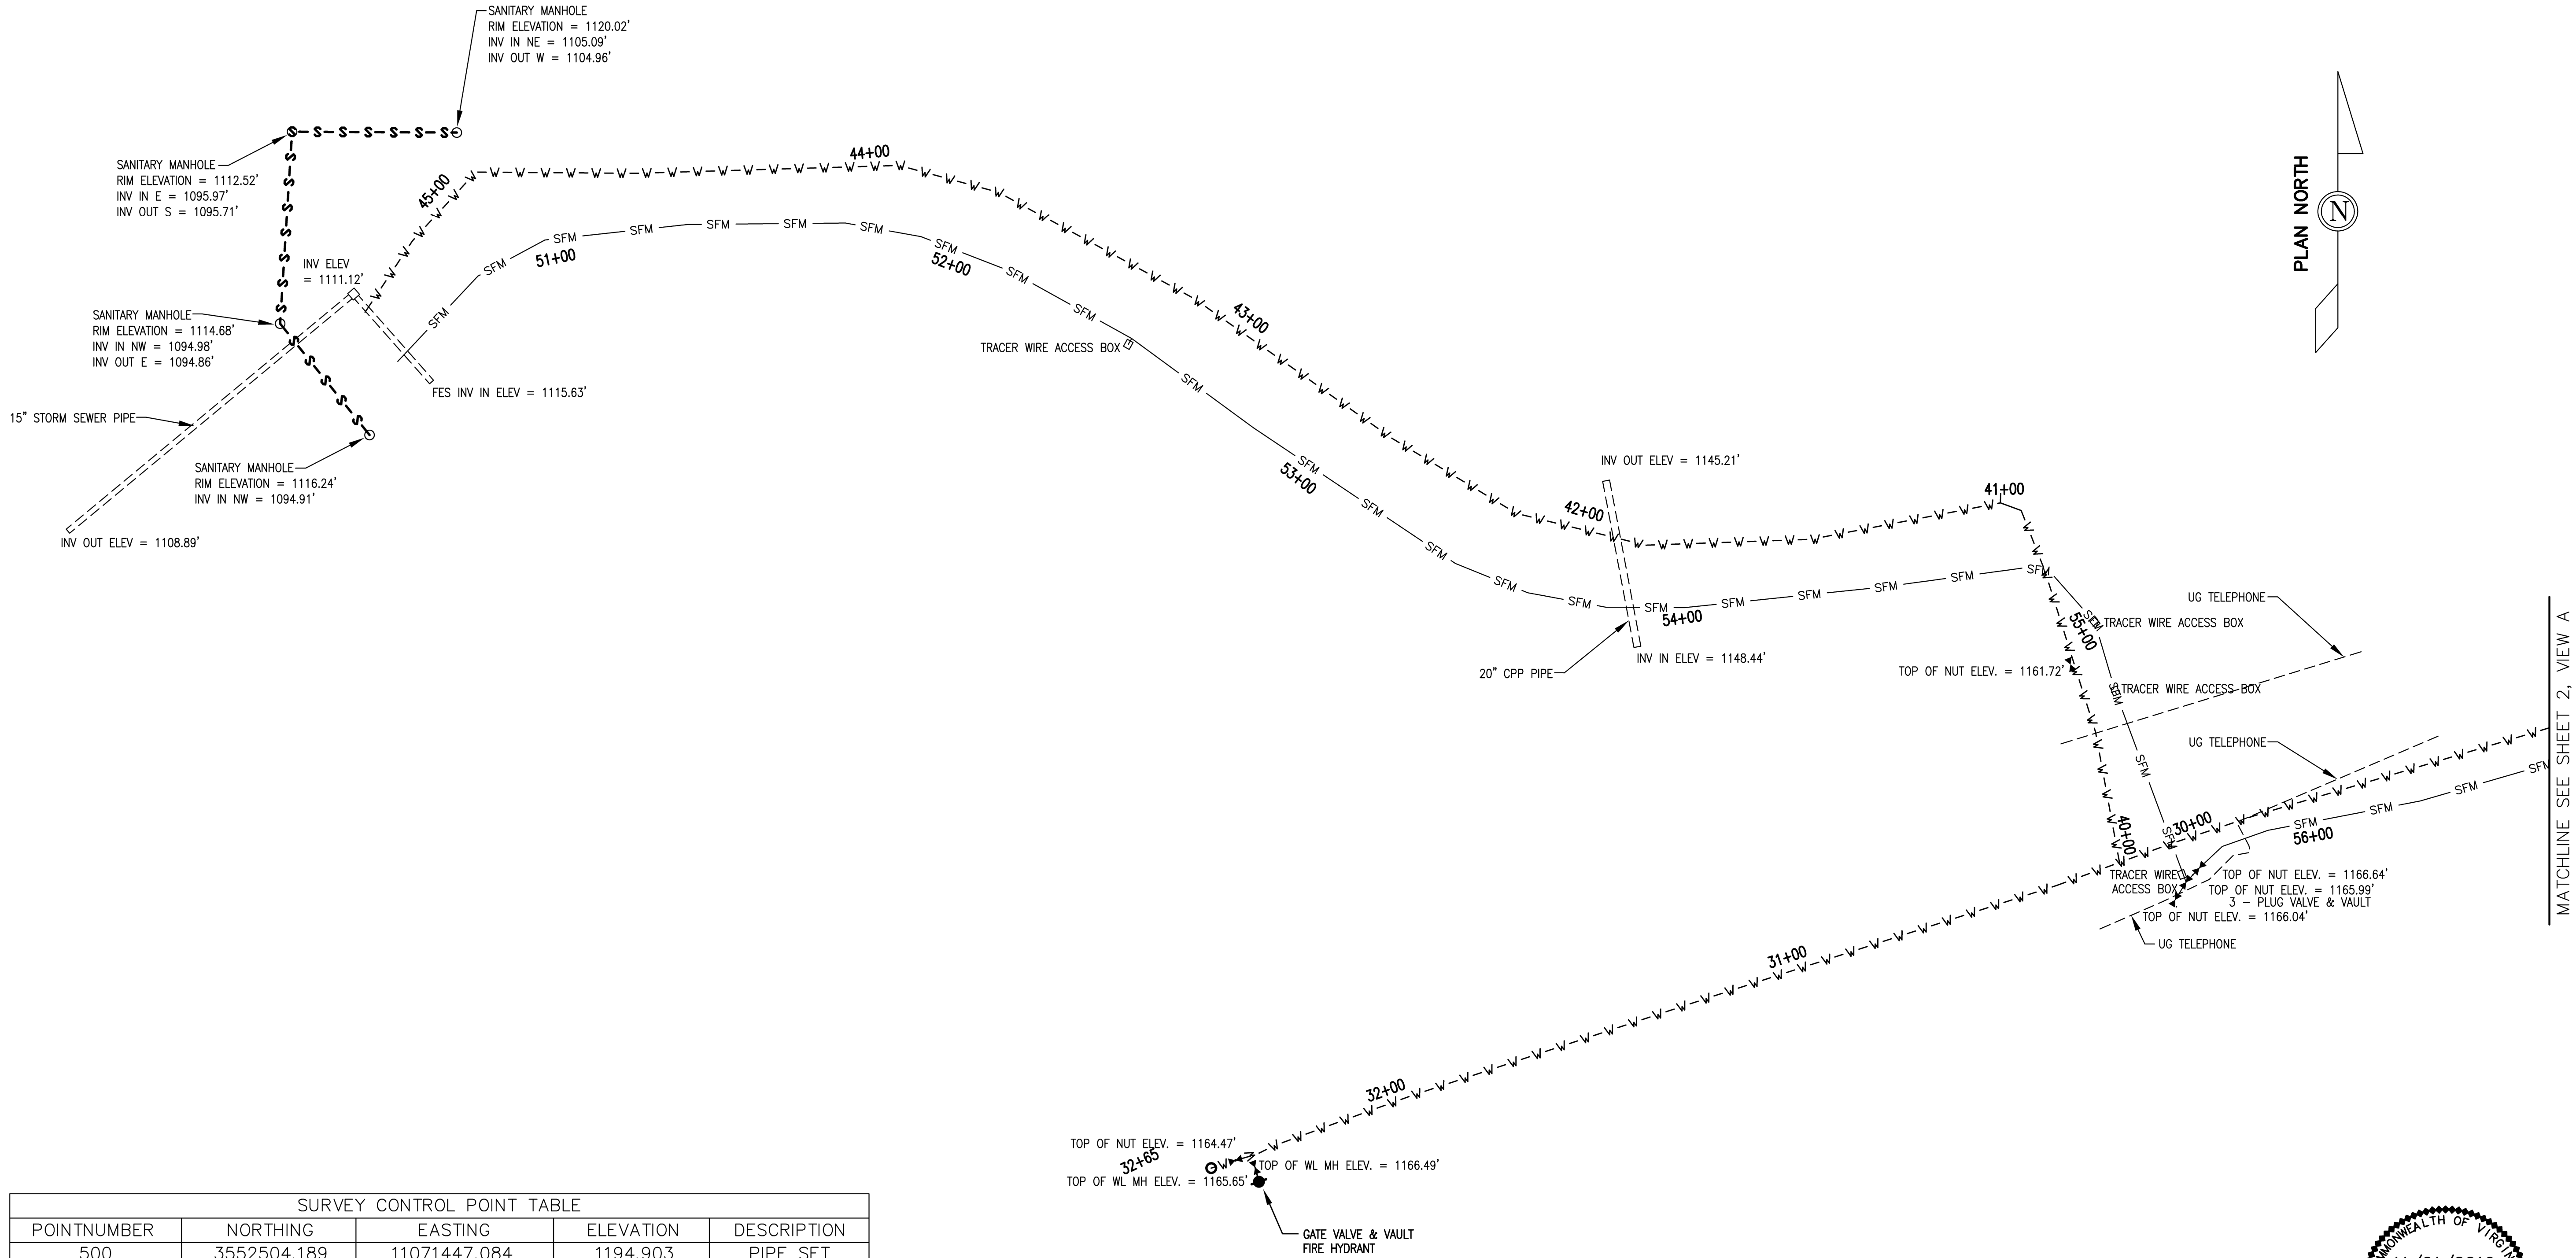
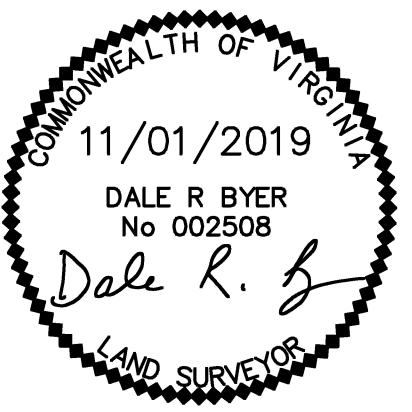


SURVEY CONTROL POINT TABLE				
POINTNUMBER	NORTHING	EASTING	ELEVATION	DESCRIPTION
500	3552504.189	11071447.084	1194.903	PIPE SET
501	3552962.815	11068408.989	1169.396	MAGNAIL FND
502	3553789.046	11068540.748	1125.953	MAGNAIL FND
503	3554215.338	11072069.829	1153.908	MAGNAIL FND
504	3550905.830	11078173.943	1232.177	MAGNAIL FND

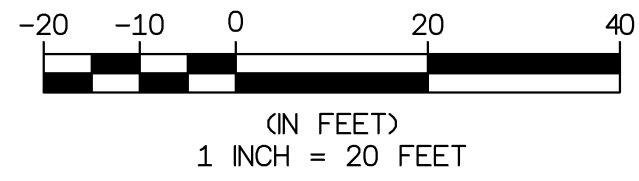

AS-BUILT

BYER, BENNETT AND ASSOCIATES, P.L.C.
4008 RINER RD, UNIT A
RINER, VA 24149
(540) 381-7004

Byer, Bennett & Associates P.L.C.

SUMMIT VIEW BUSINESS PARK UTILITY IMPROVEMENTS
PHASE 1
AS-BUILT SURVEY


DATE 10/28/2019
SCALE 1" = 20'
CHECKED BY: DRB
DRAFTED BY: SRB

REV. NO.	DATE	BY	DESCRIPTION


JOB NO.
19-01

Sheet
1
of
10

VIEW A

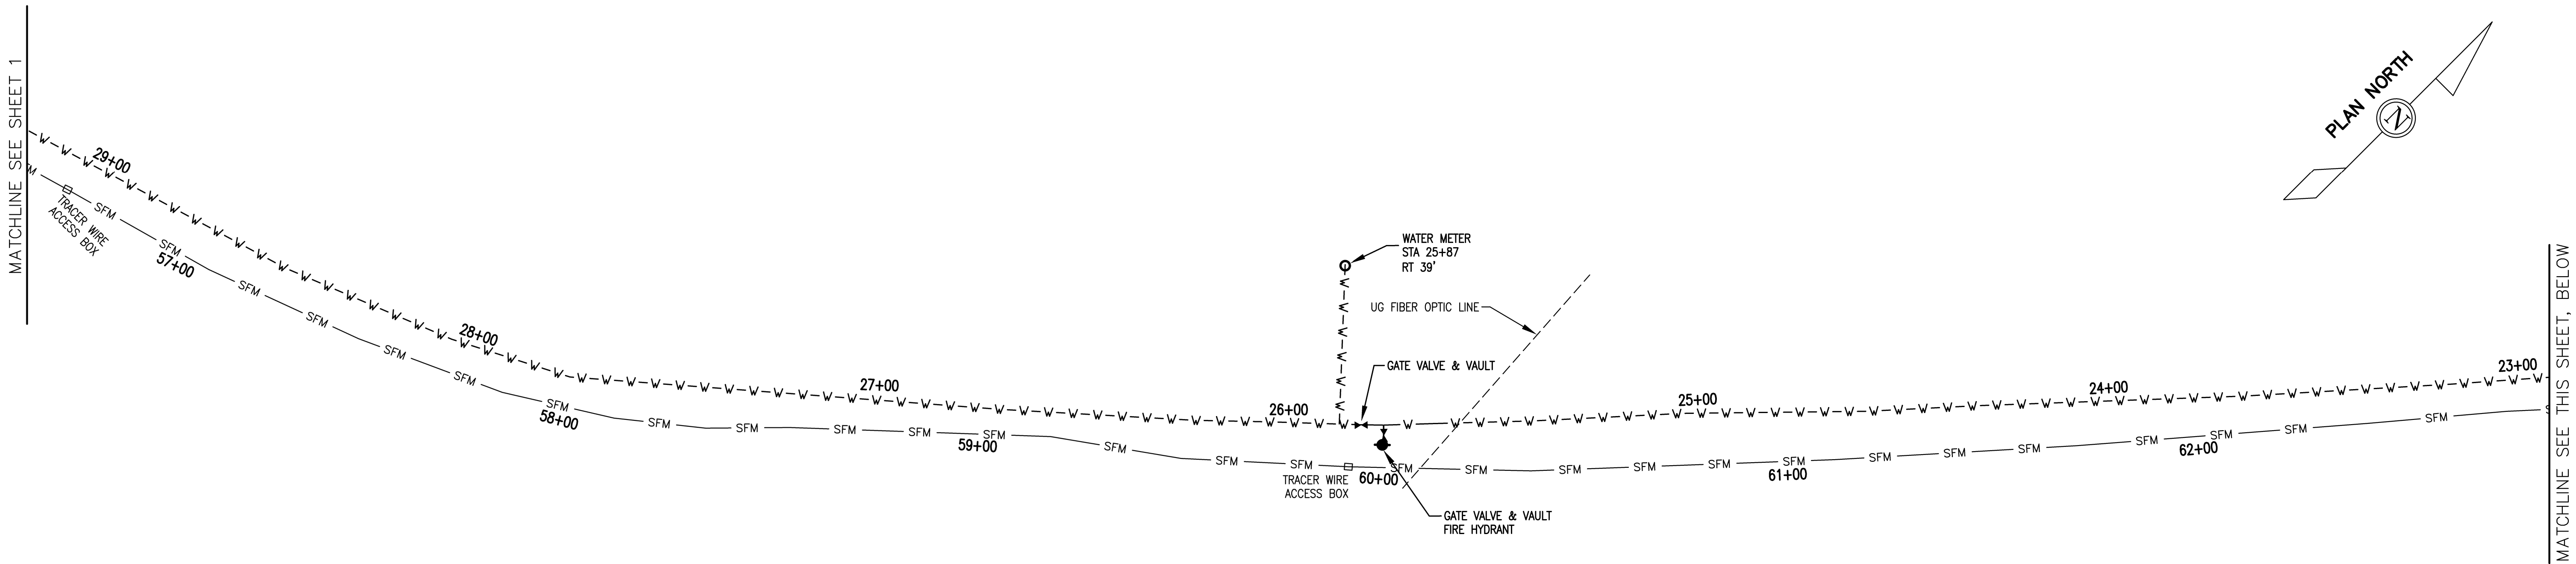

VIEW B

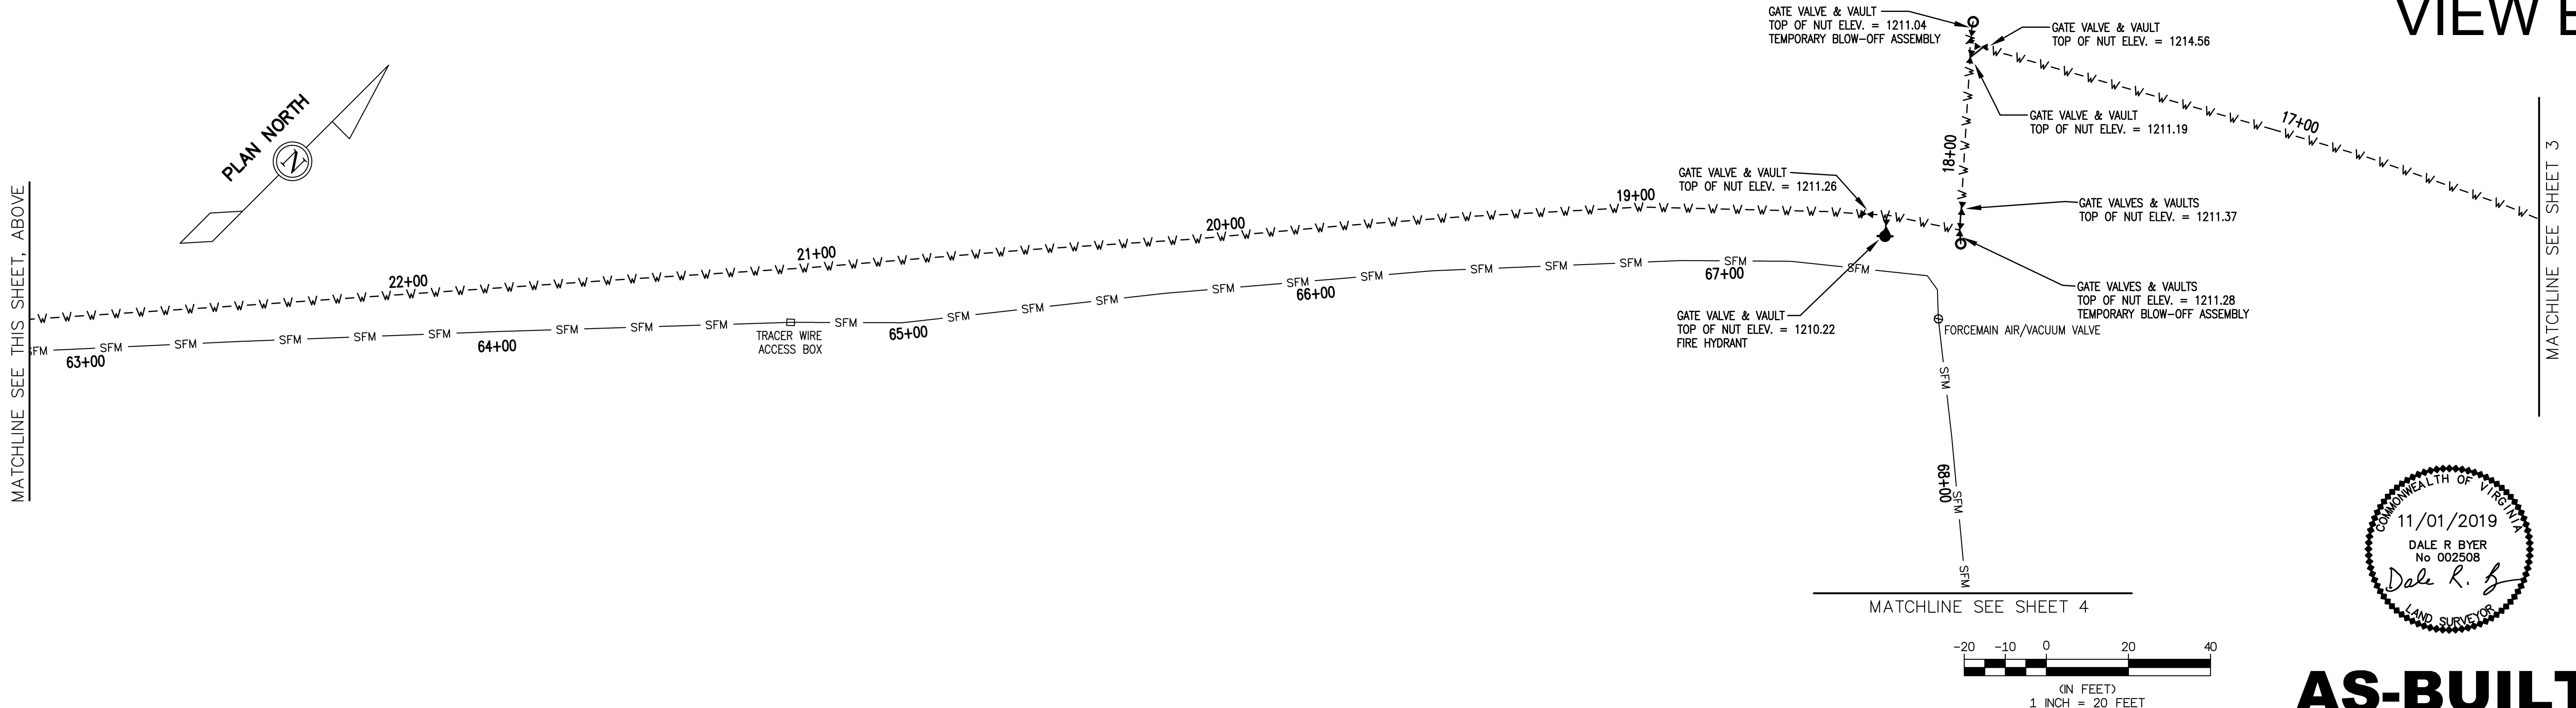

AS-BUILT



BYER, BENNETT AND ASSOCIATES, P.L.C.
4008 RINER RD, UNIT A
RINER, VA 24149
(540) 381-7004


SUMMIT VIEW BUSINESS PARK UTILITY IMPROVEMENTS
PHASE 1
AS-BUILT SURVEY

DATE 10/28/2019
SCALE 1" = 20'
CHECKED BY: DRB
DRAFTED BY: SRB




REV. NO.	DATE	BY	DESCRIPTION

JOB NO.
19-01

Sheet
2
of
10

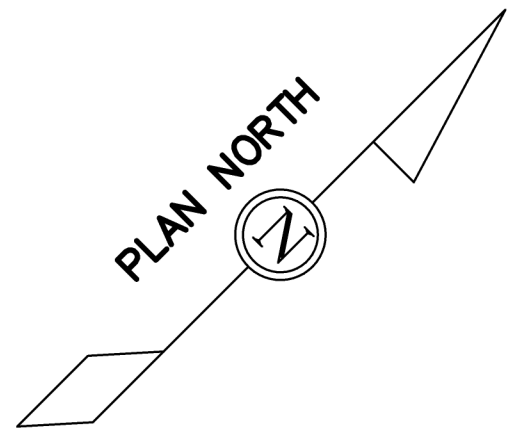

MATCHLINE SEE SHEET 2

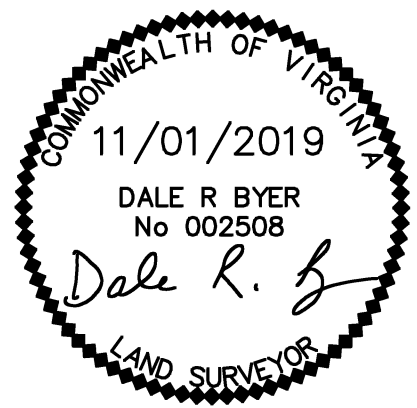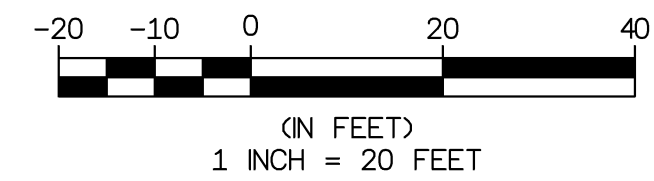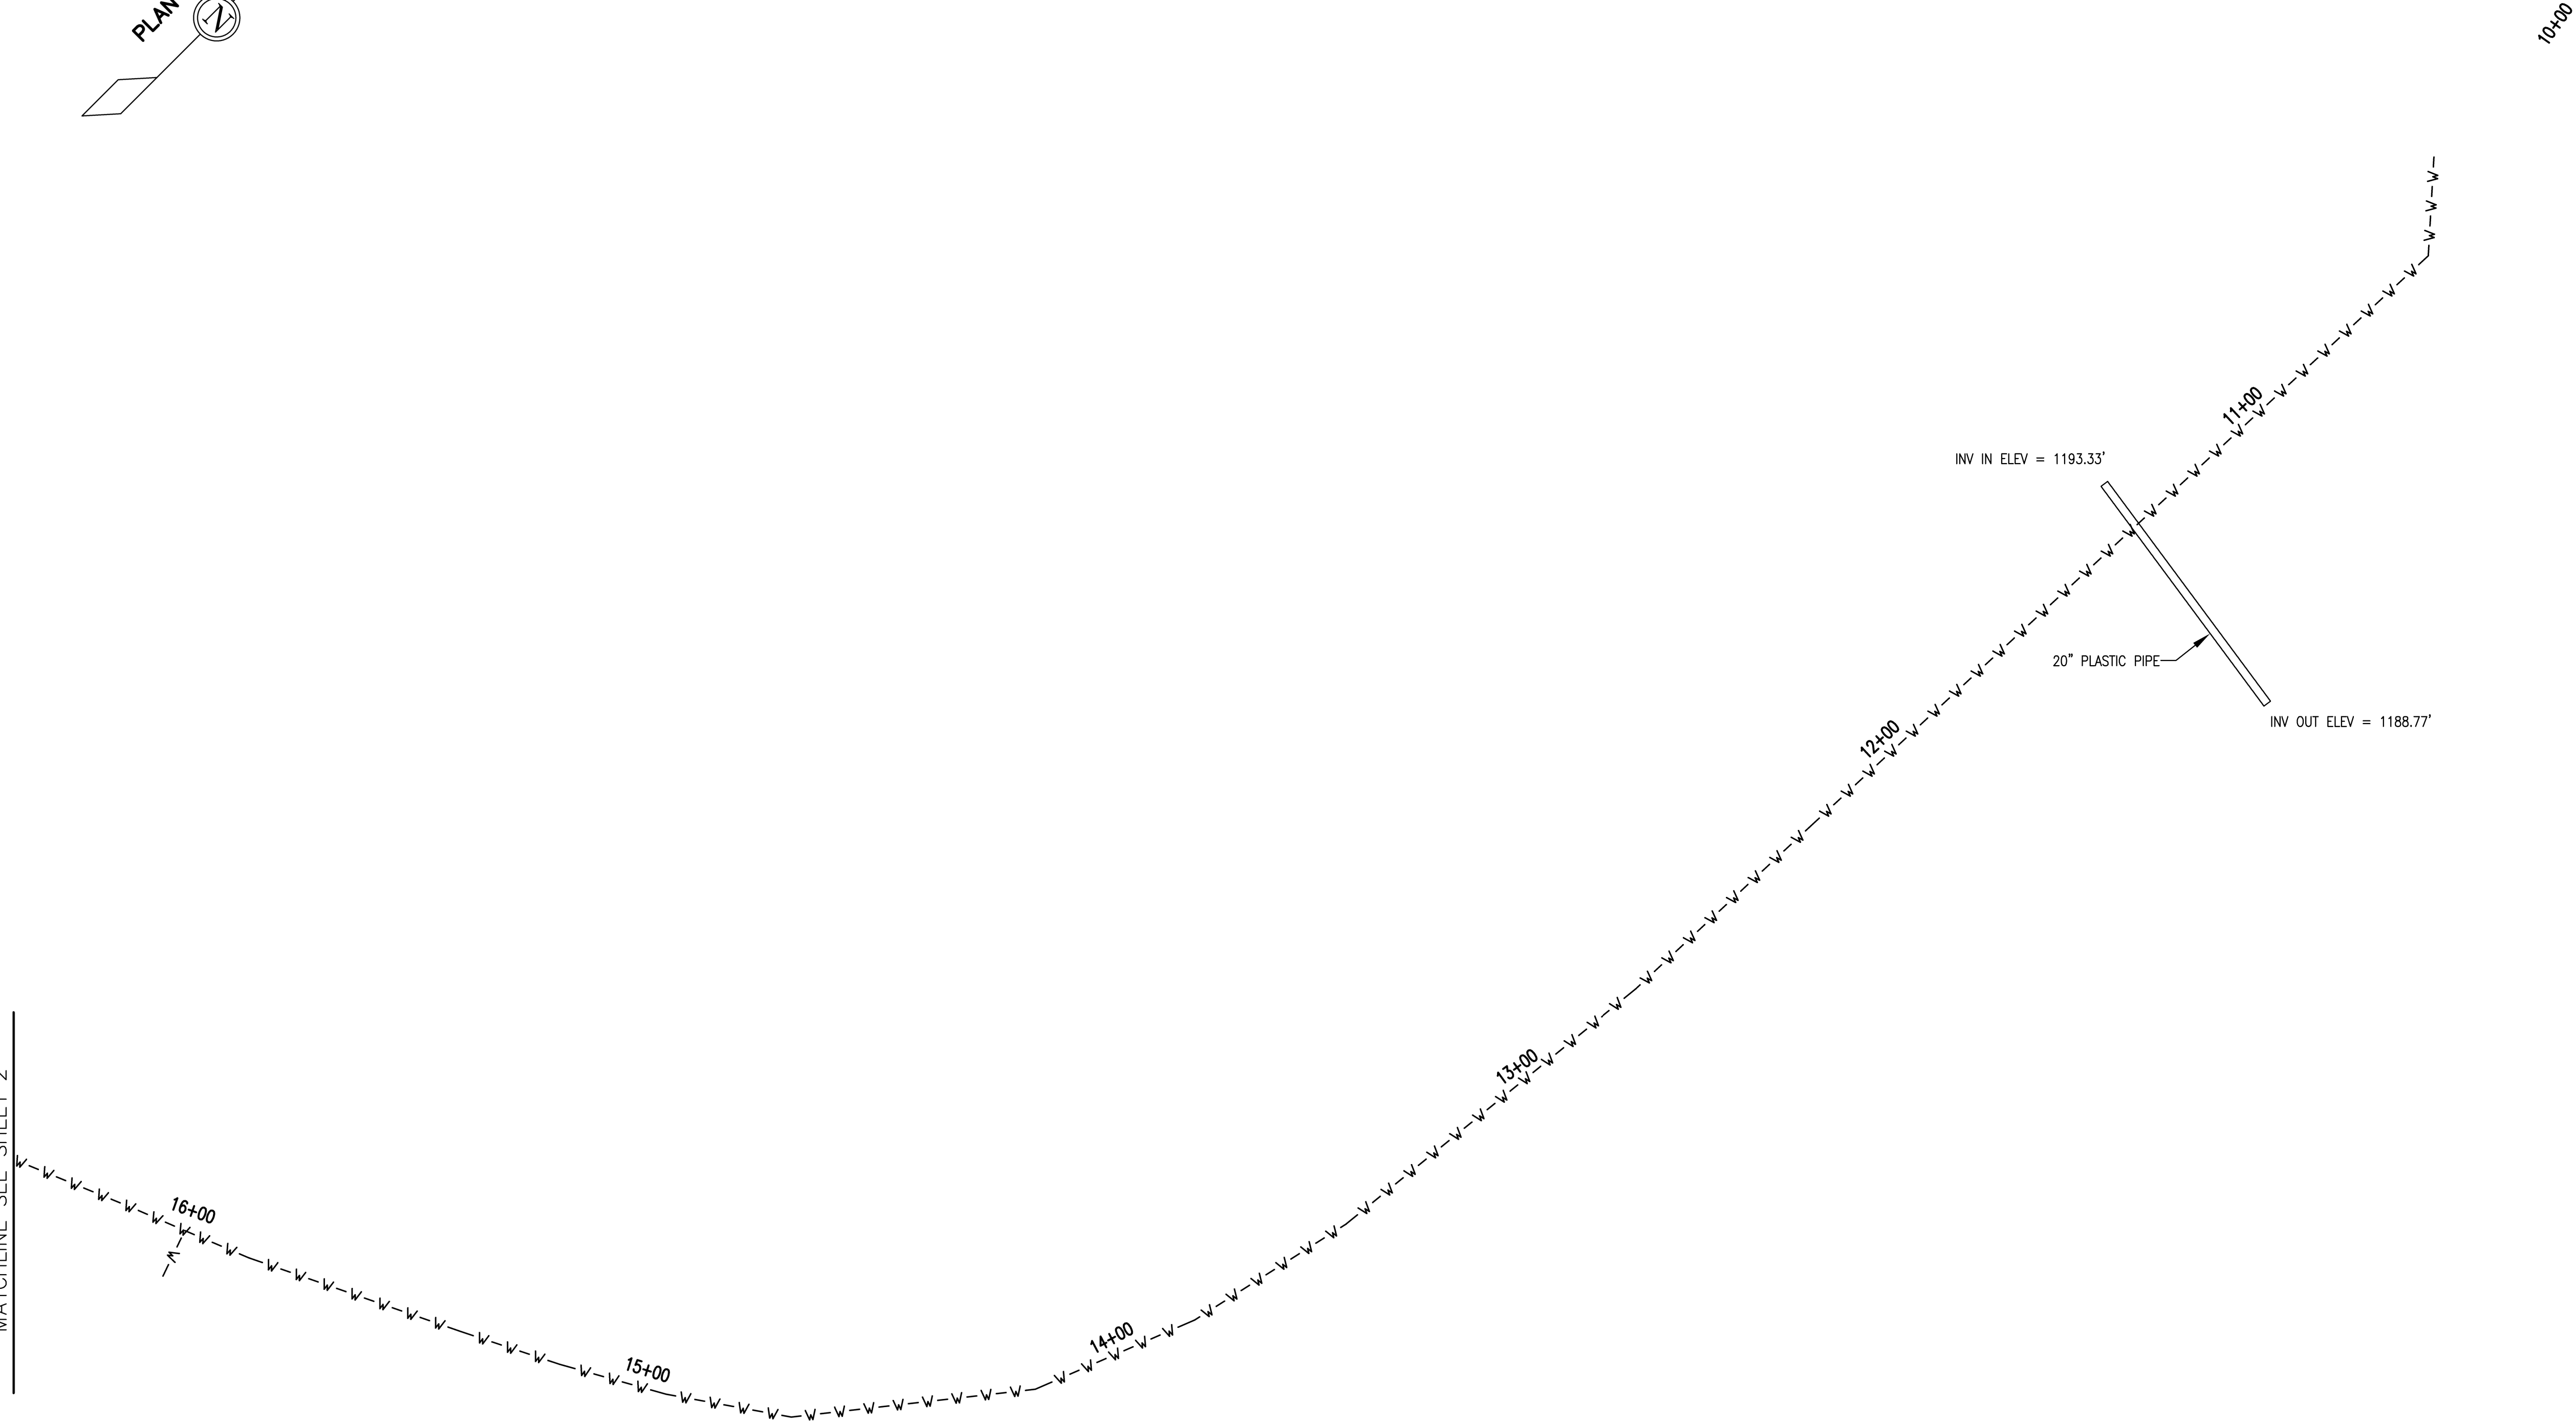

AS-BUILT



BYER, BENNETT AND ASSOCIATES, P.L.C.
4008 RINER RD, UNIT A
RINER, VA 24149
(540) 381-7004

SUMMIT VIEW BUSINESS PARK UTILITY IMPROVEMENTS
PHASE 1
AS-BUILT SURVEY

DATE 10/28/2019
SCALE 1" = 20'
CHECKED BY: DRB
DRAFTED BY: SRB

REV. NO.	DATE	BY	DESCRIPTION


JOB NO.
19-01

Sheet
3
of
10

VIEW A

MATCHLINE SEE SHEET 2, VIEW B




MATCHLINE SEE THIS SHEET, BELOW

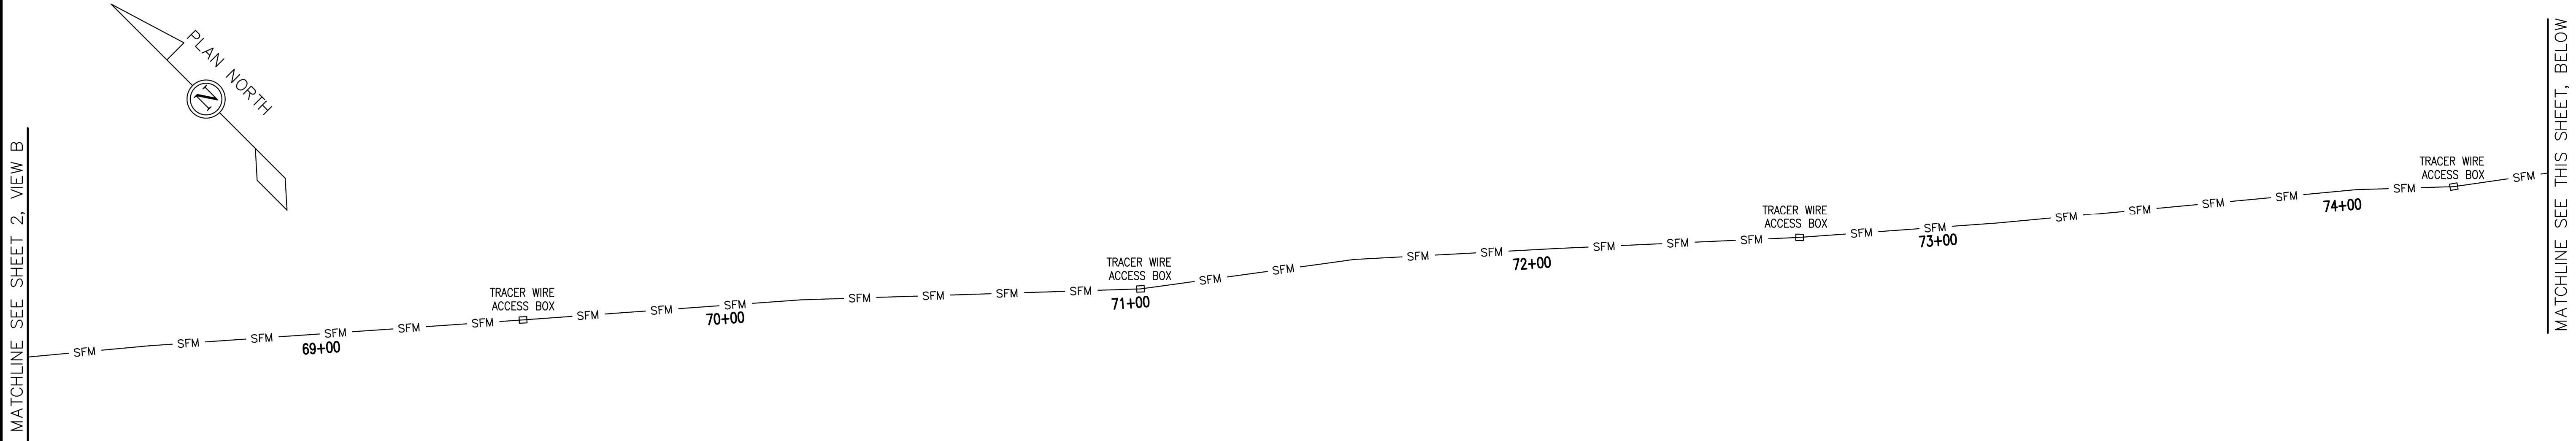

VIEW B

MATCHLINE SEE THIS SHEET, ABOVE

MATCHLINE SEE SHEET 5, VIEW A

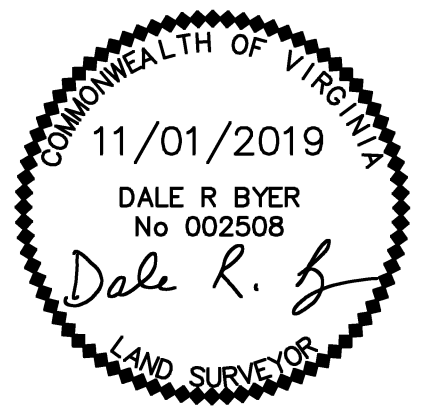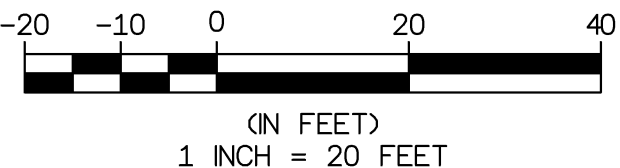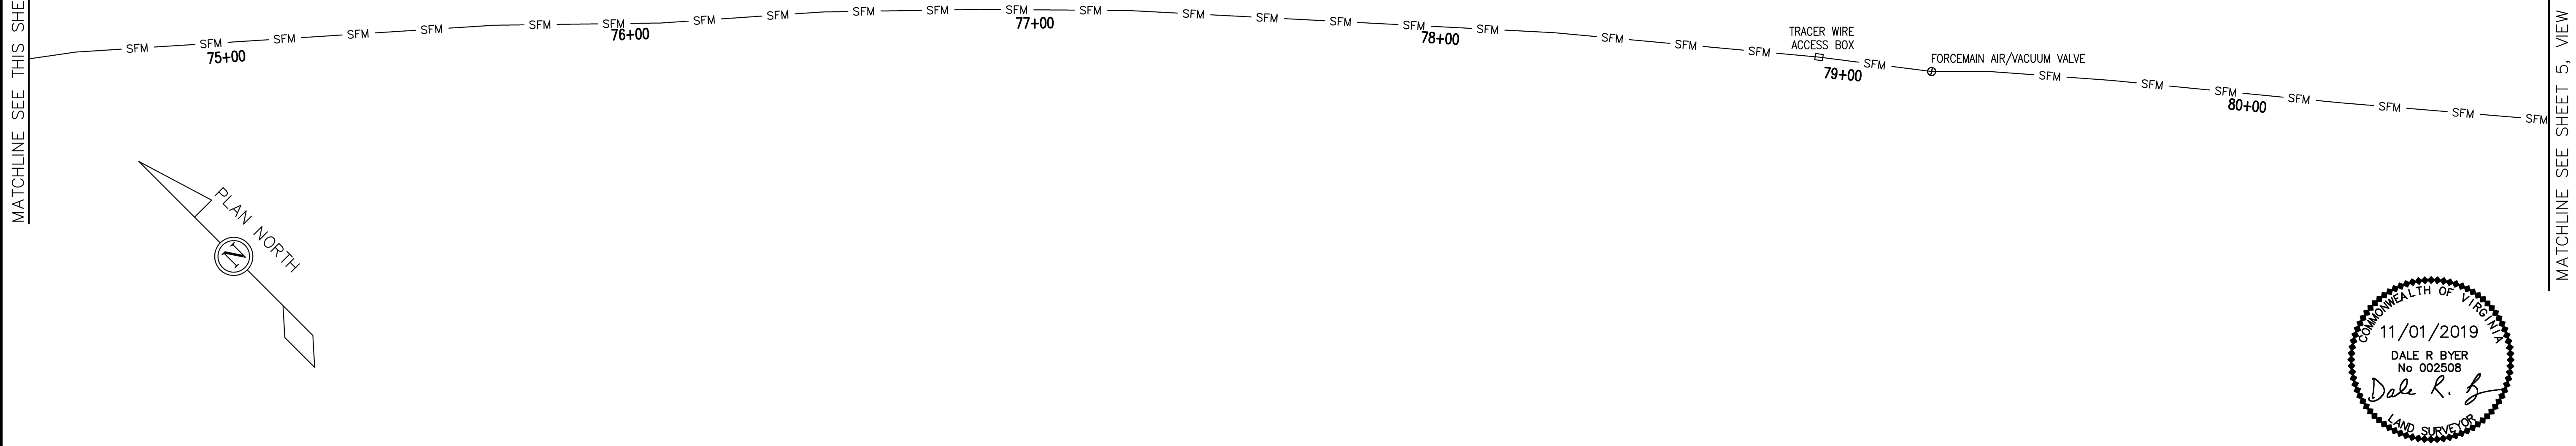

AS-BUILT



BYER, BENNETT AND ASSOCIATES, P.L.C.
4008 RINER RD, UNIT A
RINER, VA 24149
(540) 381-7004

SUMMIT VIEW BUSINESS PARK UTILITY IMPROVEMENTS
PHASE 1
AS-BUILT SURVEY


DATE 10/28/2019
SCALE 1" = 20'
CHECKED BY: DRB
DRAFTED BY: SRB

REV. NO.	DATE	BY	DESCRIPTION


JOB NO.
19-01

Sheet
4
of
10



VIEW A

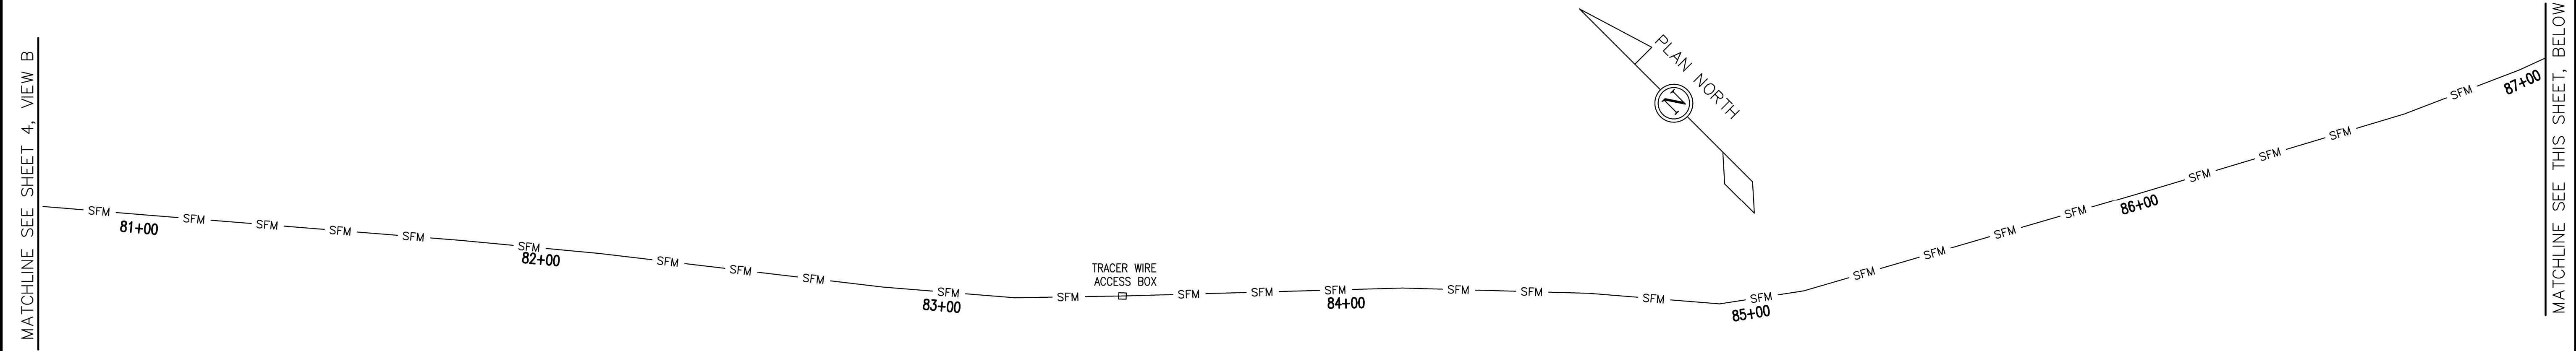

VIEW B

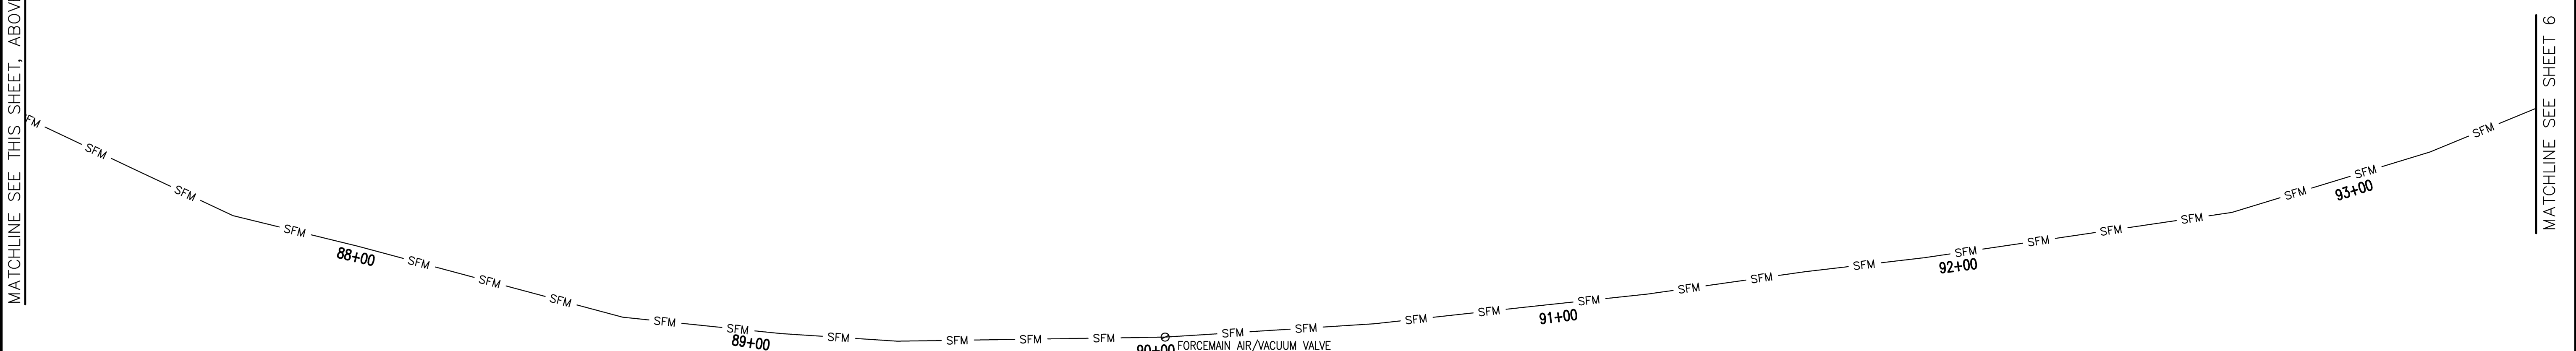

BENCHMARK
PIPE SET
N 3552504.189
E 11071447.084
ELEV = 1194.903

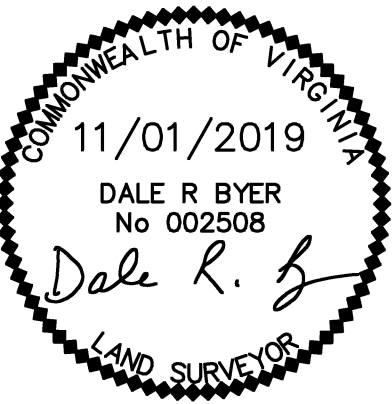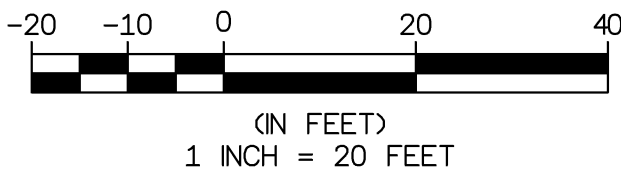

AS-BUILT



BYER, BENNETT AND ASSOCIATES, P.L.C.
4008 RINER RD, UNIT A
RINER, VA 24149
(540) 381-7004

SUMMIT VIEW BUSINESS PARK UTILITY IMPROVEMENTS
PHASE 1
AS-BUILT SURVEY



DATE 10/28/2019
SCALE 1" = 20'
CHECKED BY: DRB
DRAFTED BY: SRB

REV. NO.	DATE	BY	DESCRIPTION



JOB NO.
19-01

Sheet
5
of
10

MATCHLINE SEE SHEET 5, VIEW B

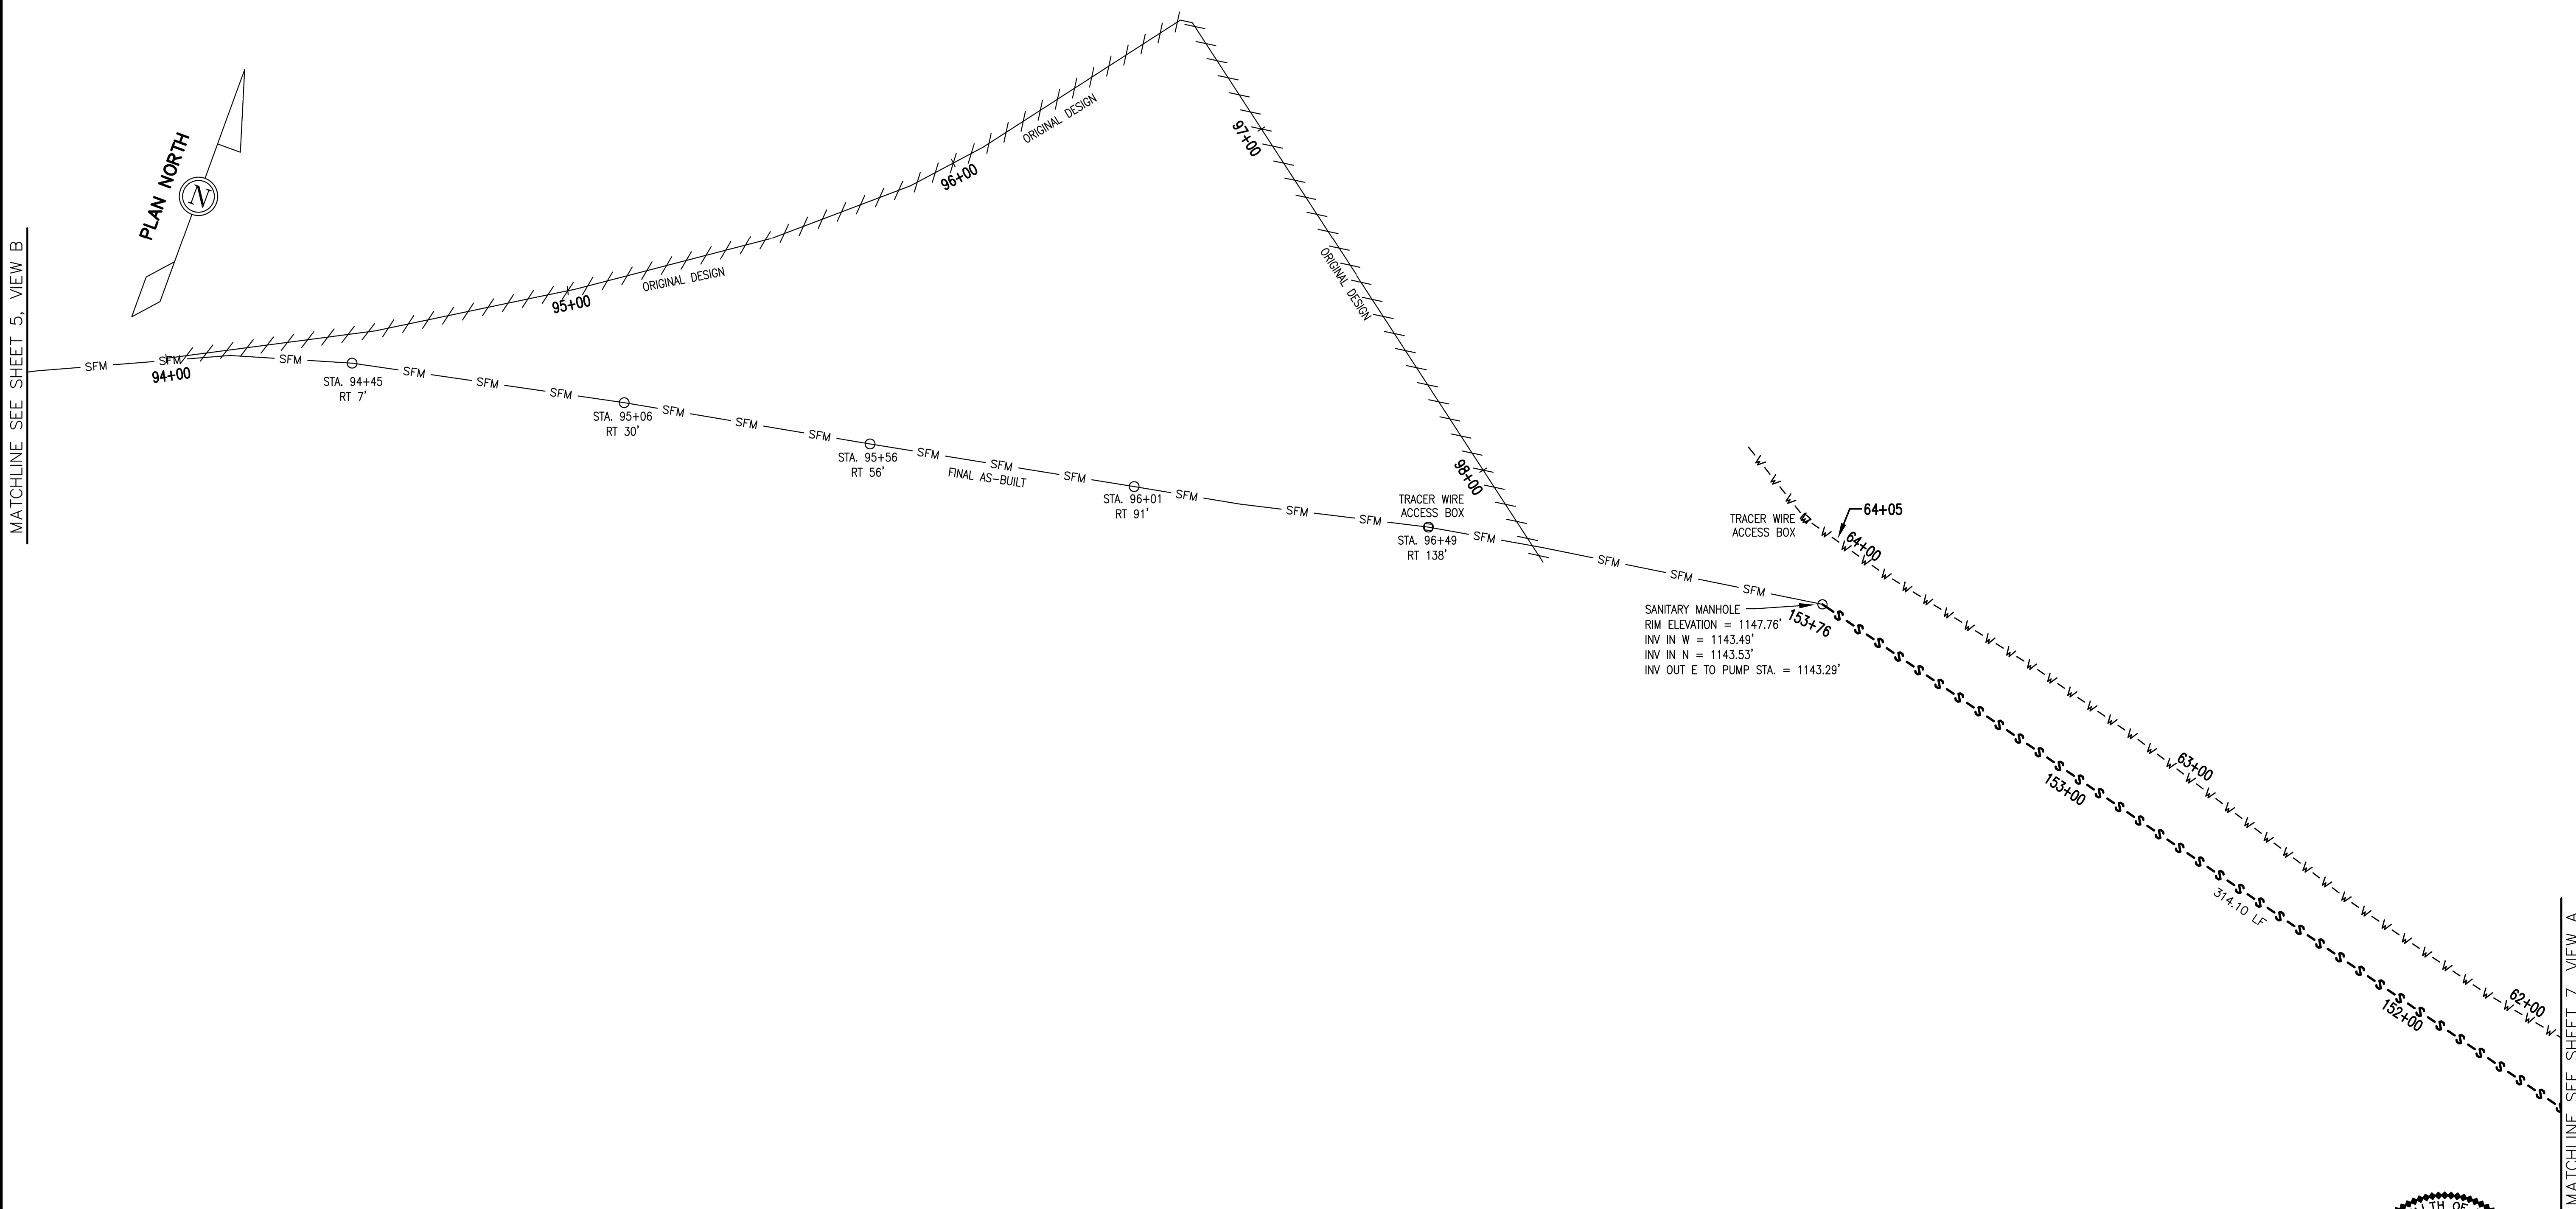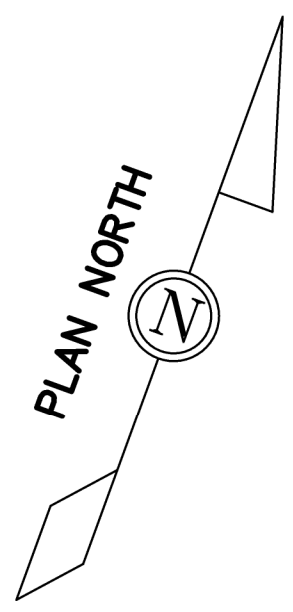

MATCHLINE SEE SHEET 7, VIEW A

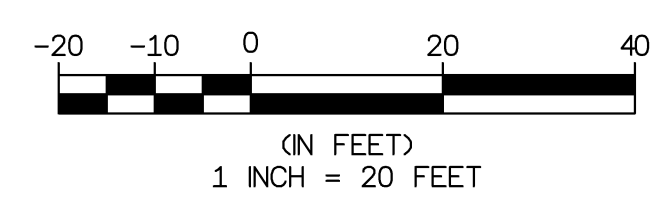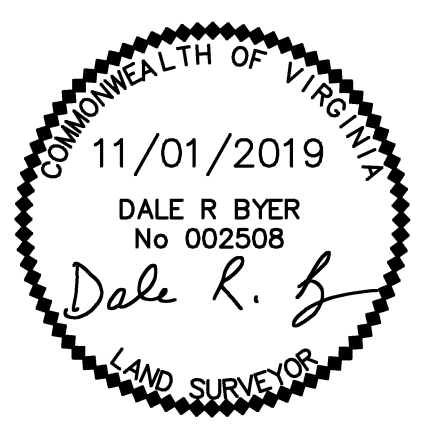

AS-BUILT



BYER, BENNETT AND ASSOCIATES, P.L.C.
4008 RINER RD, UNIT A
RINER, VA 24149
(540) 381-7004

SUMMIT VIEW BUSINESS PARK UTILITY IMPROVEMENTS
PHASE 1
AS-BUILT SURVEY


DATE 10/28/2019
SCALE 1" = 20'
CHECKED BY: DRB
DRAFTED BY: SRB

REV. NO.	DATE	BY	DESCRIPTION




JOB NO.
19-01

Sheet
6
of
10

VIEW A

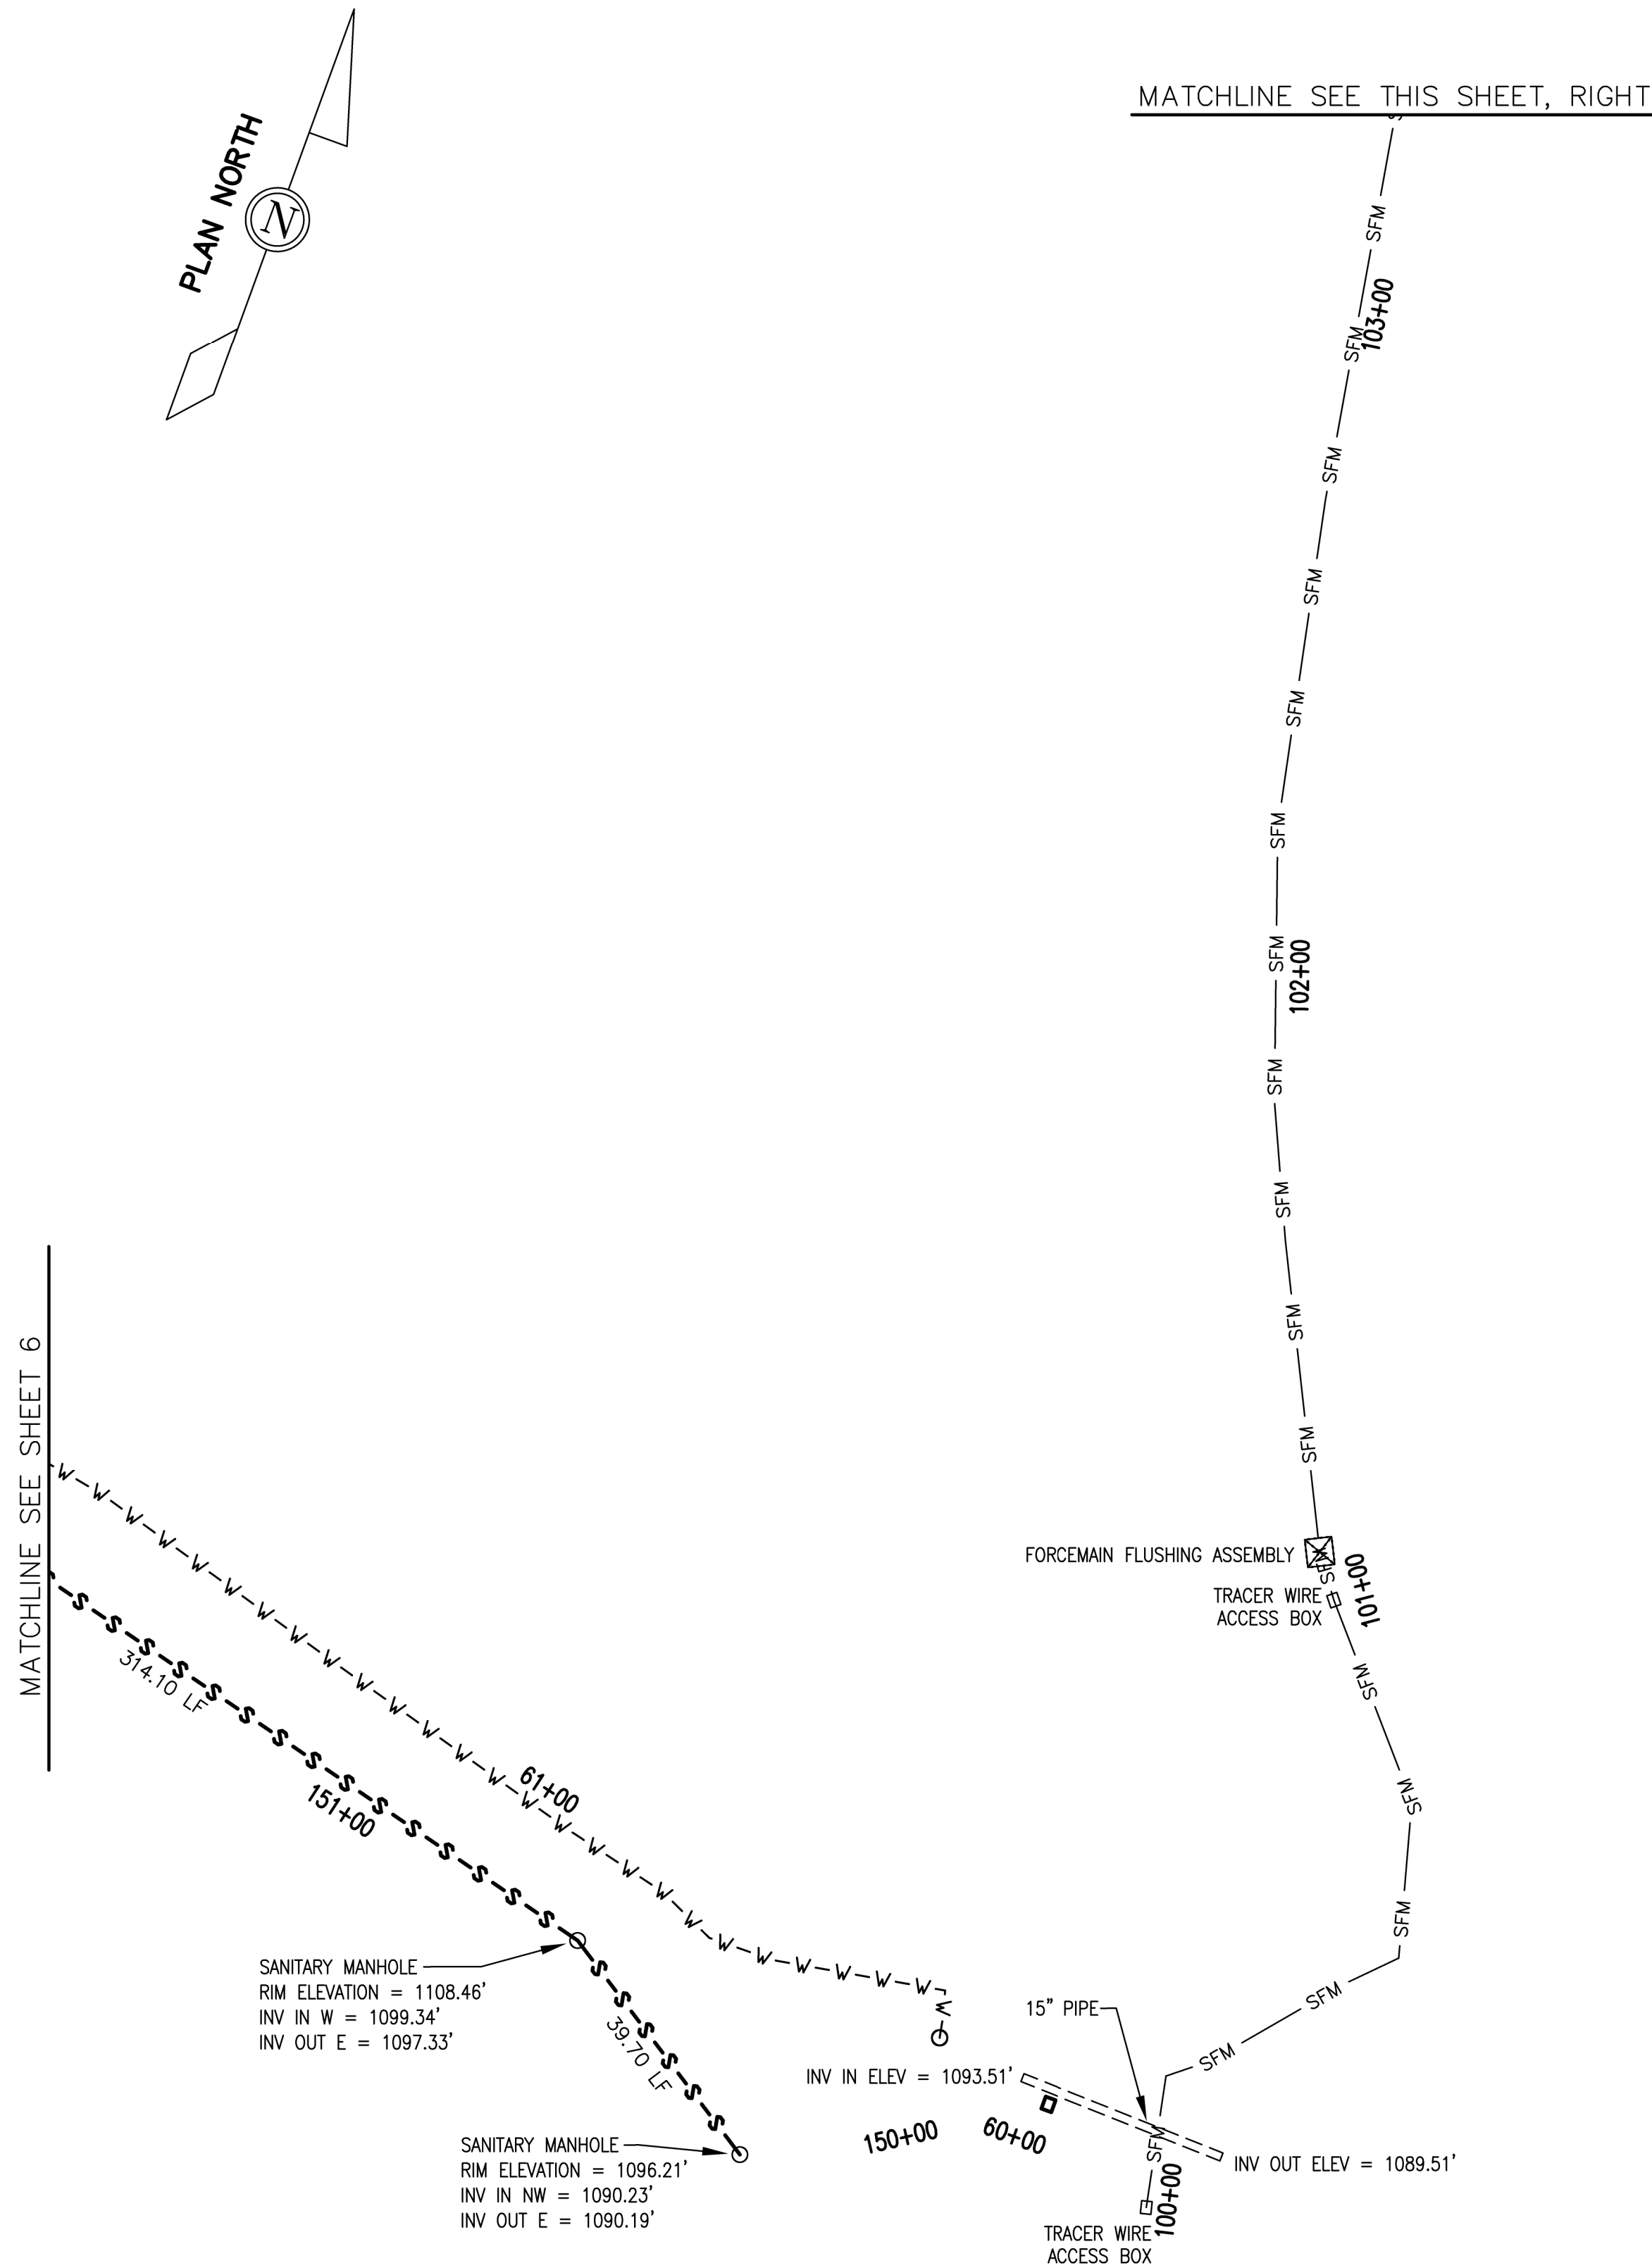

VIEW B

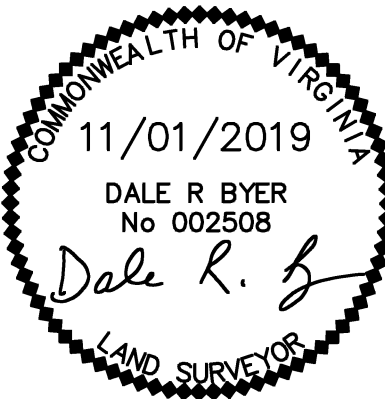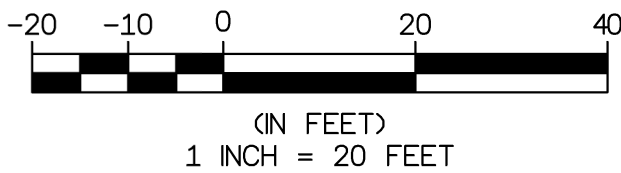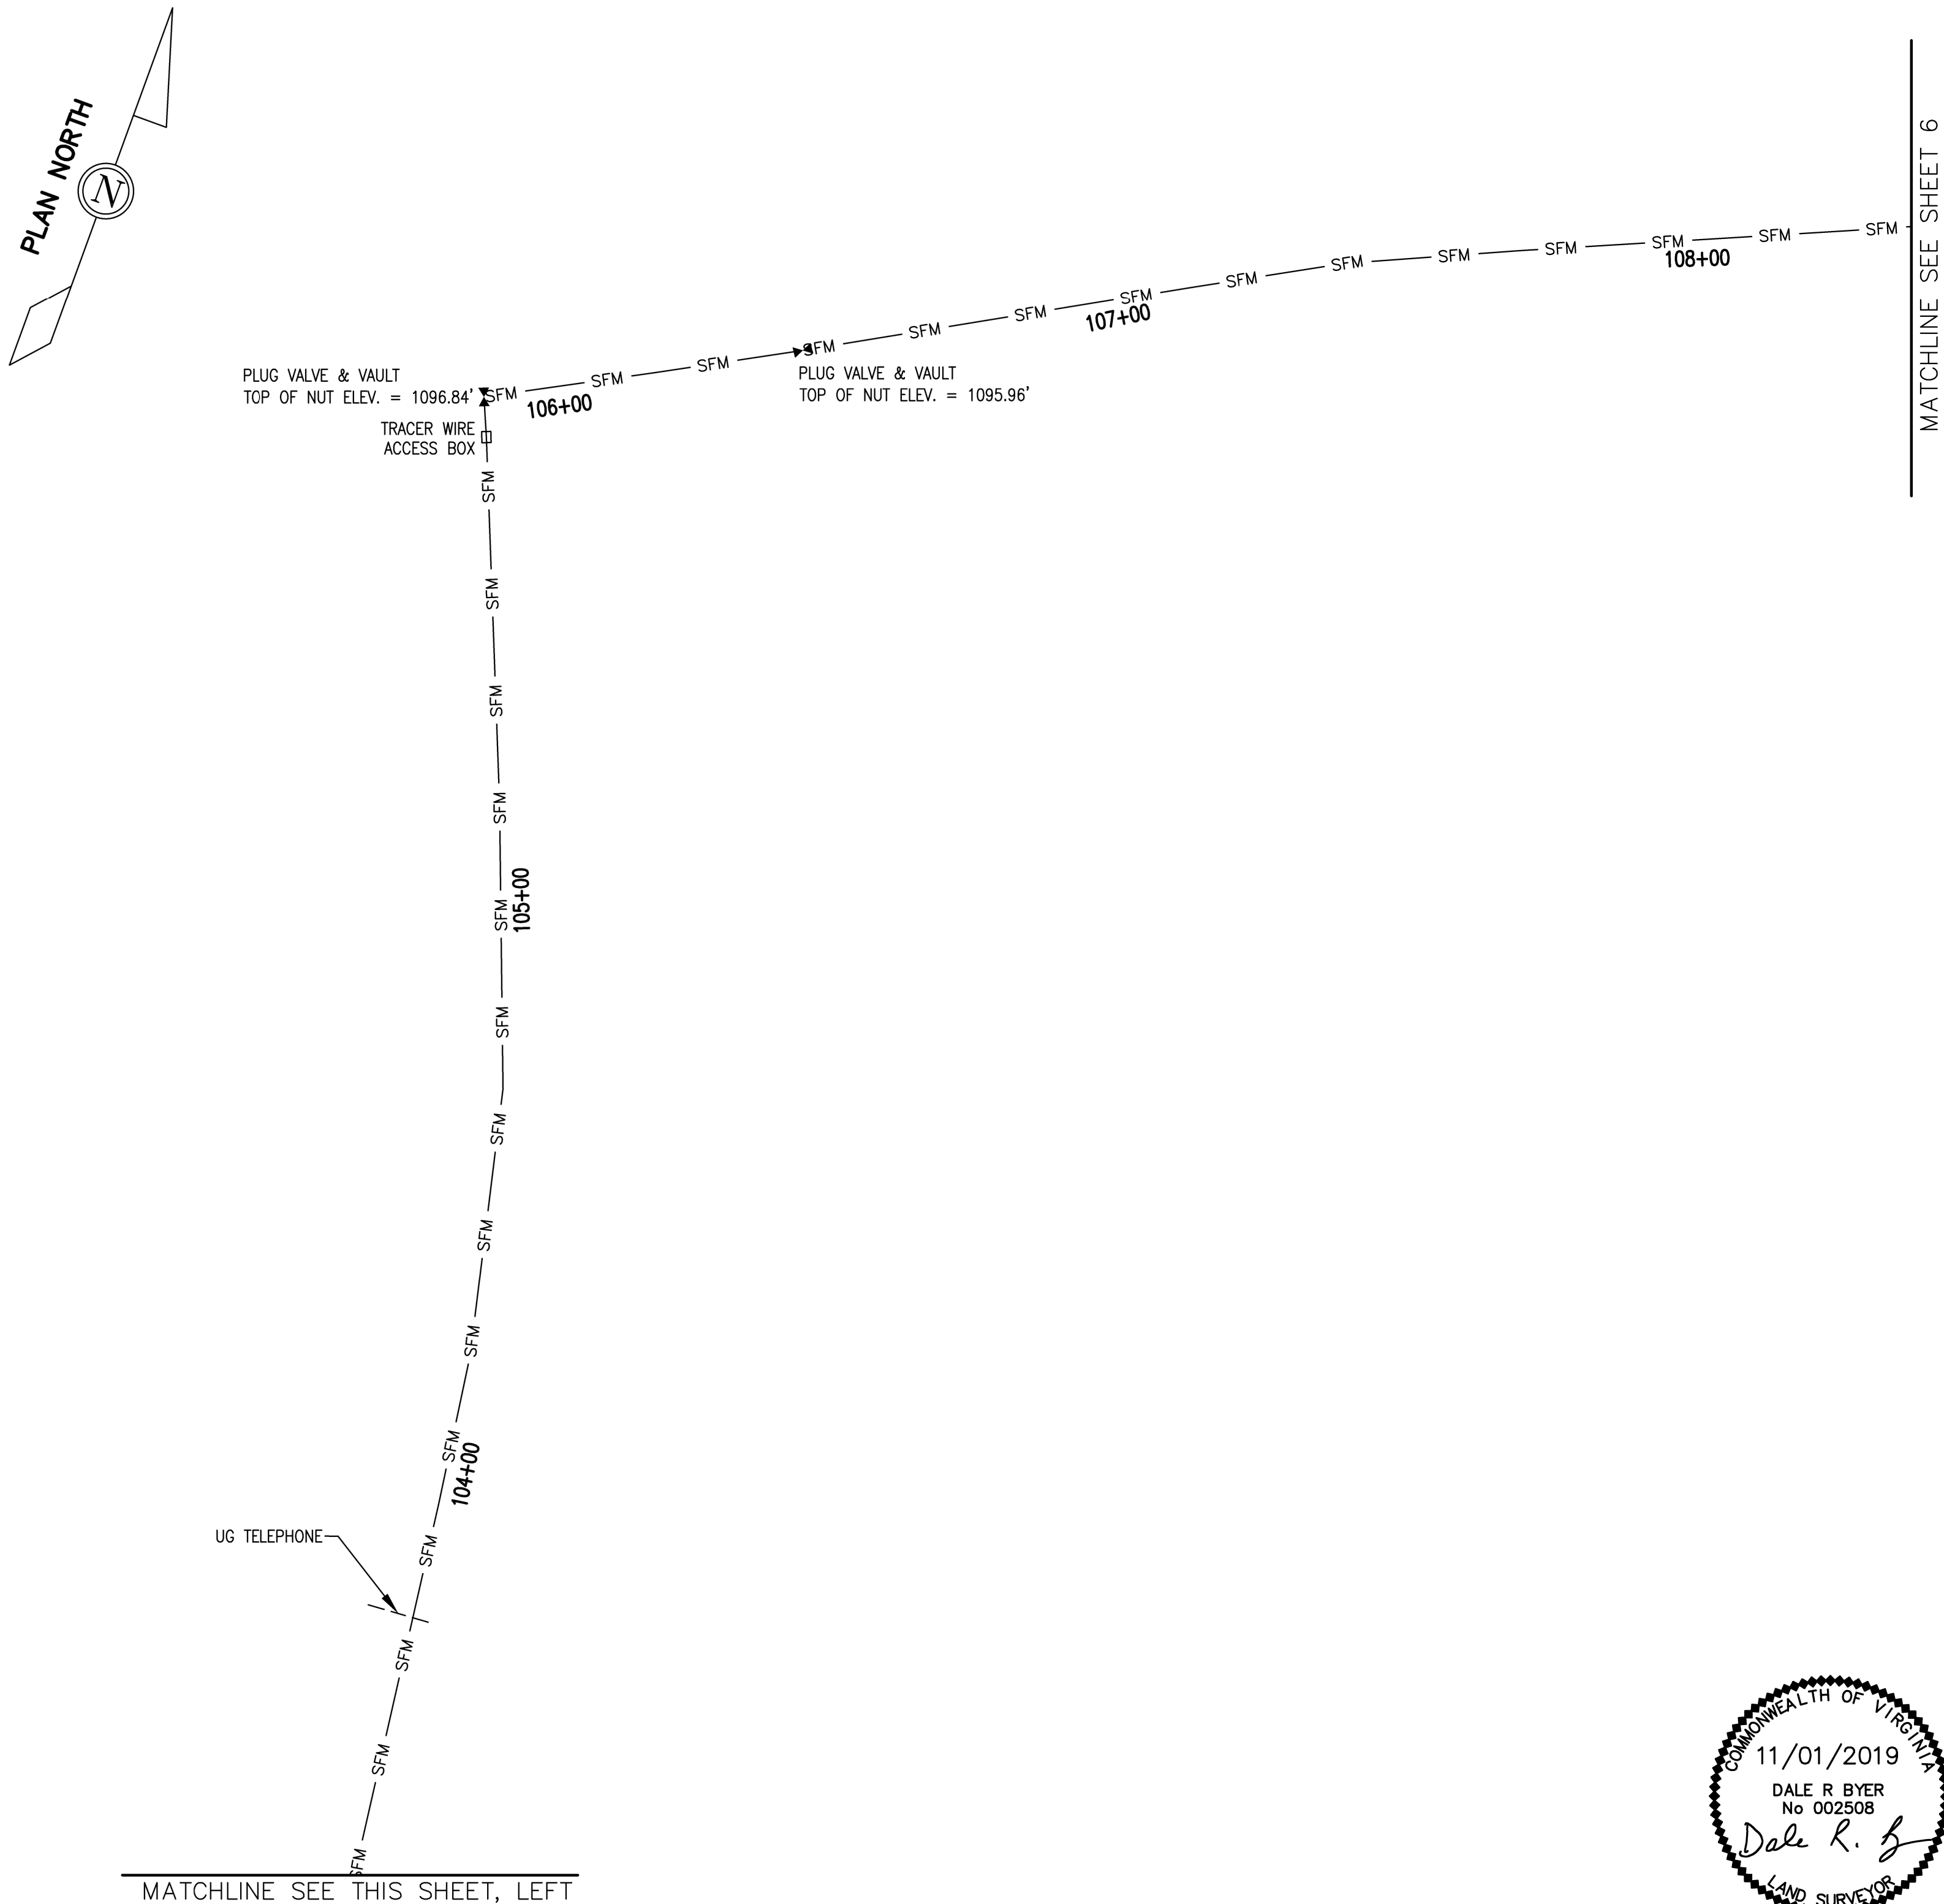

AS-BUILT



BYER, BENNETT AND ASSOCIATES, P.L.C.
4008 RINER RD, UNIT A
RINER, VA 24149
(540) 381-7004

SUMMIT VIEW BUSINESS PARK UTILITY IMPROVEMENTS
PHASE 1
AS-BUILT SURVEY


DATE 10/28/2019
SCALE 1" = 20'
CHECKED BY: DRB
DRAFTED BY: SRB

REV. NO.	DATE	BY	DESCRIPTION

JOB NO.
19-01


Sheet
7
of
10

VIEW A

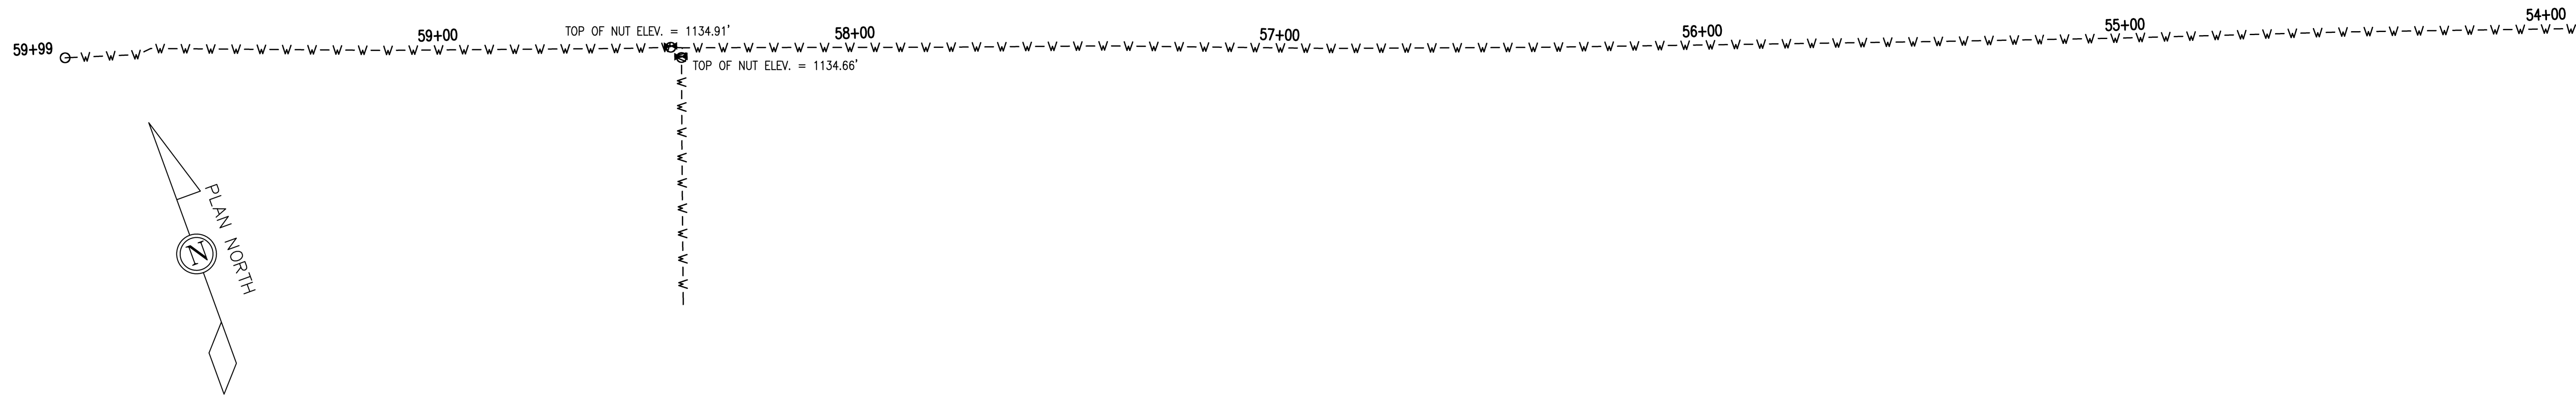

MATCHLINE SEE THIS SHEET, BELOW

VIEW B

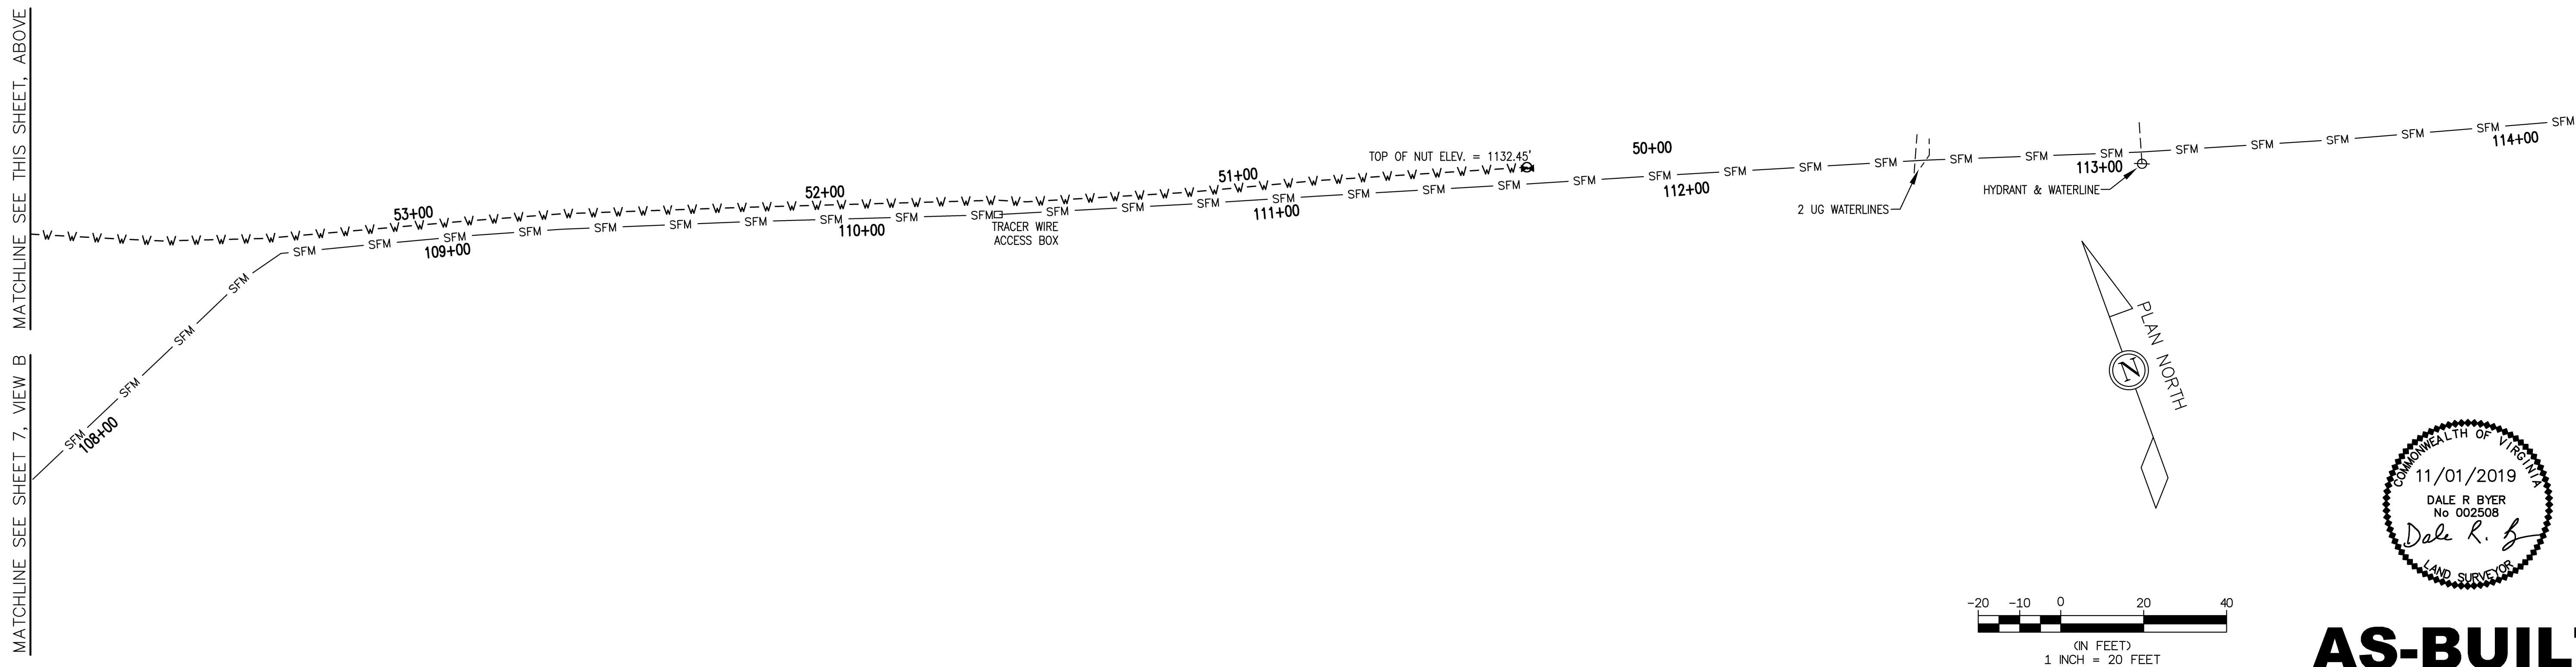

MATCHLINE SEE SHEET 9, VIEW A



AS-BUILT



BYER, BENNETT AND ASSOCIATES, P.L.C.
4008 RINER RD, UNIT A
RINER, VA 24149
(540) 381-7004

SUMMIT VIEW BUSINESS PARK UTILITY IMPROVEMENTS
PHASE 1
AS-BUILT SURVEY


DATE 10/28/2019
SCALE 1" = 20'
CHECKED BY: DRB
DRAFTED BY: SRB

REV. NO.	DATE	BY	DESCRIPTION




JOB NO.
19-01

Sheet
8
of
10

VIEW A

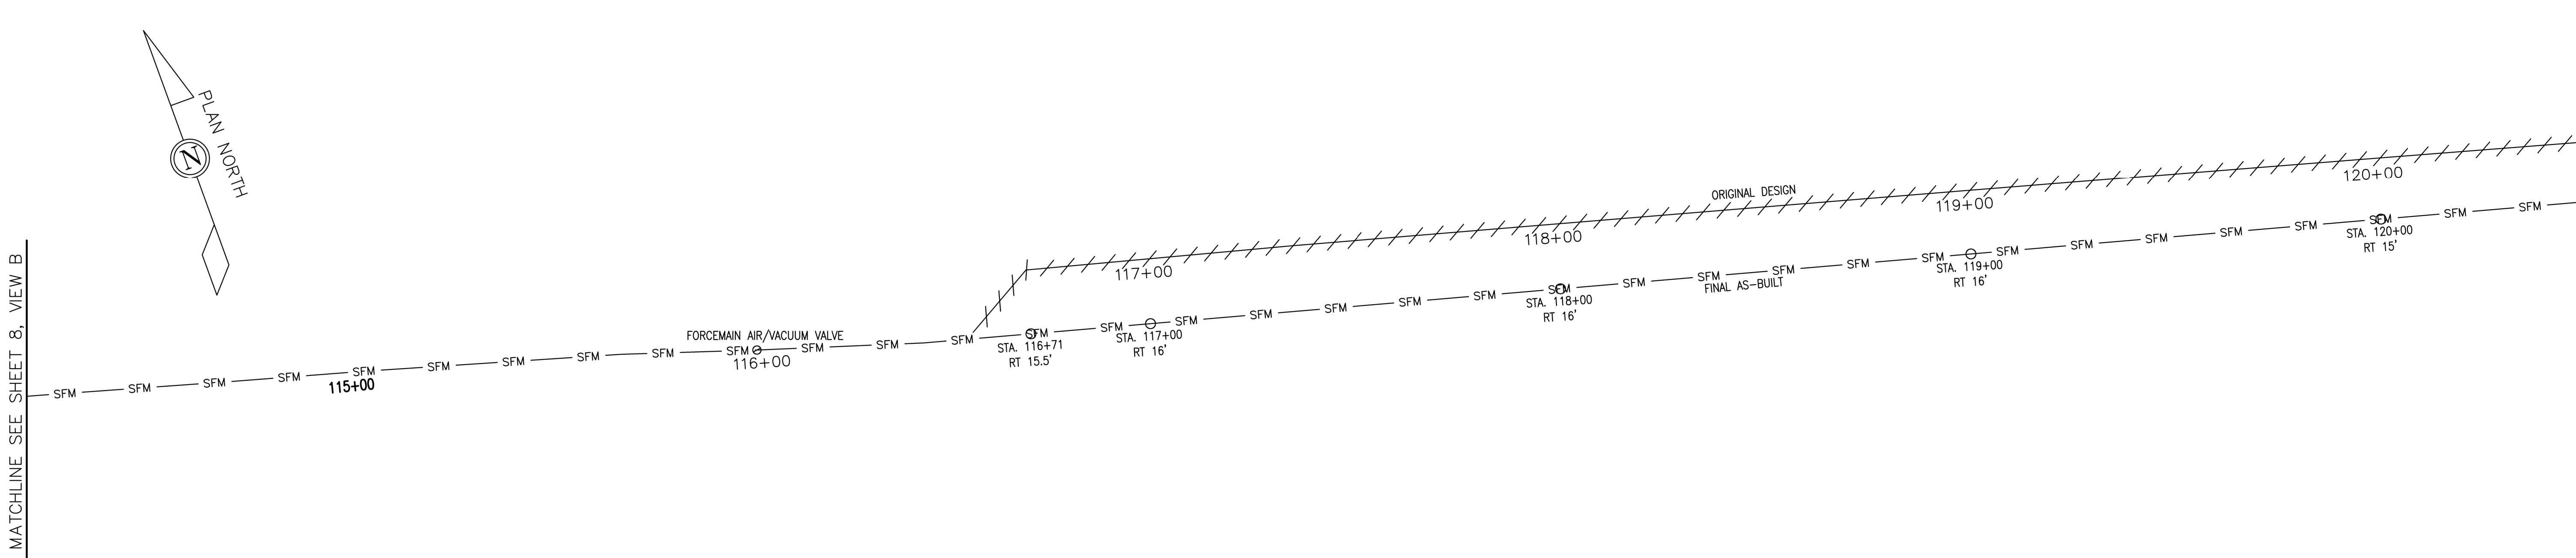

VIEW B

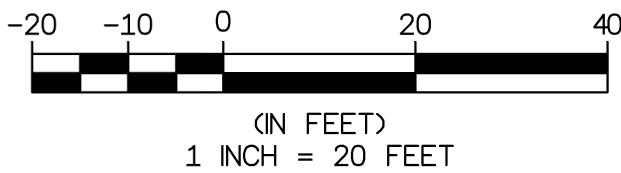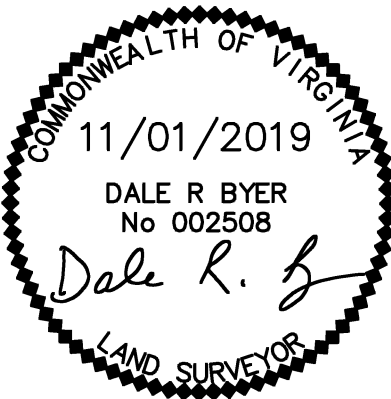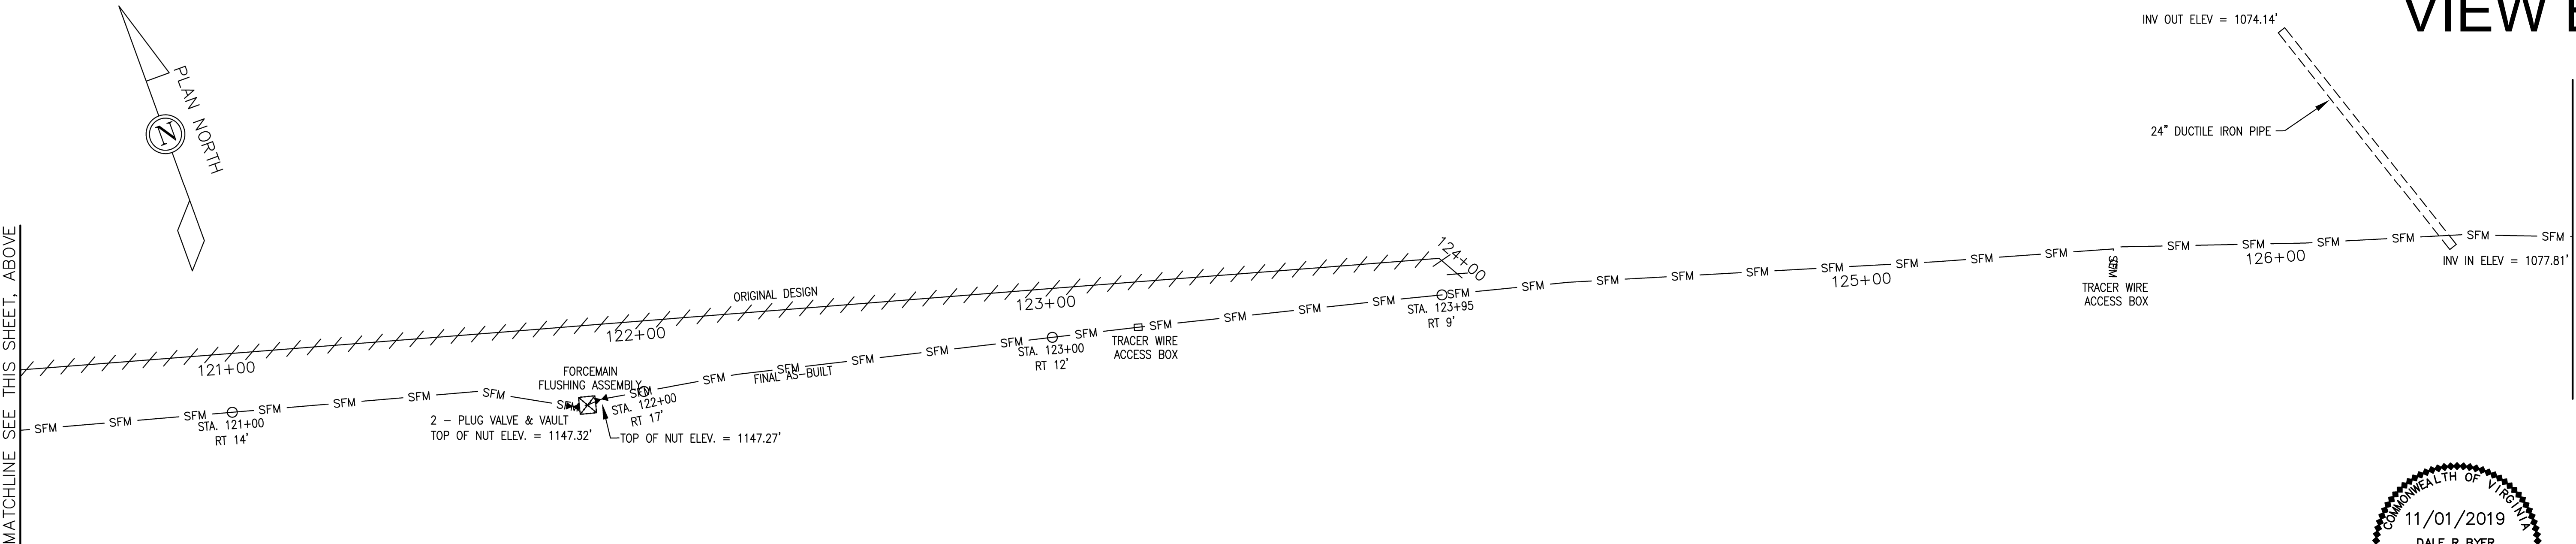

AS-BUILT




BYER, BENNETT AND ASSOCIATES, P.L.C.
4008 RINER RD, UNIT A
RINER, VA 24149
(540) 381-7004

SUMMIT VIEW BUSINESS PARK UTILITY IMPROVEMENTS
PHASE 1
AS-BUILT SURVEY

DATE	10/28/2019	REV. NO.	DATE	BY	DESCRIPTION	JOB NO.	Sheet
SCALE	1" = 20'					19-01	9 of 10
CHECKED BY:	DRB						
DRAFTED BY:	SRB						

VIEW A




MATCHLINE SEE SHEET 10, VIEW B

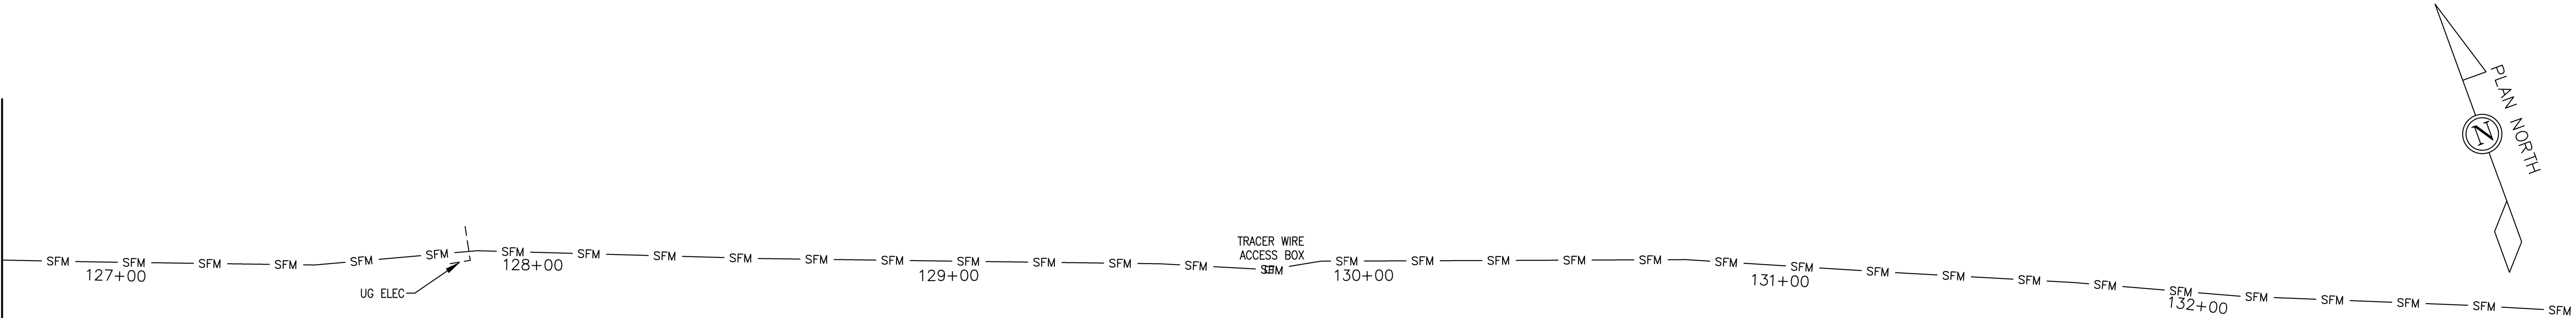

MATCHLINE SEE THIS SHEET, BELOW

VIEW B

MATCHLINE SEE THIS SHEET, ABOVE

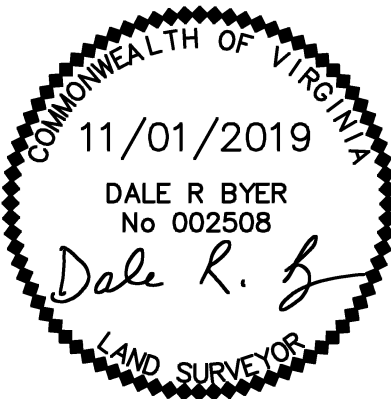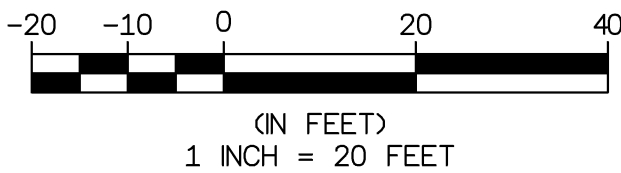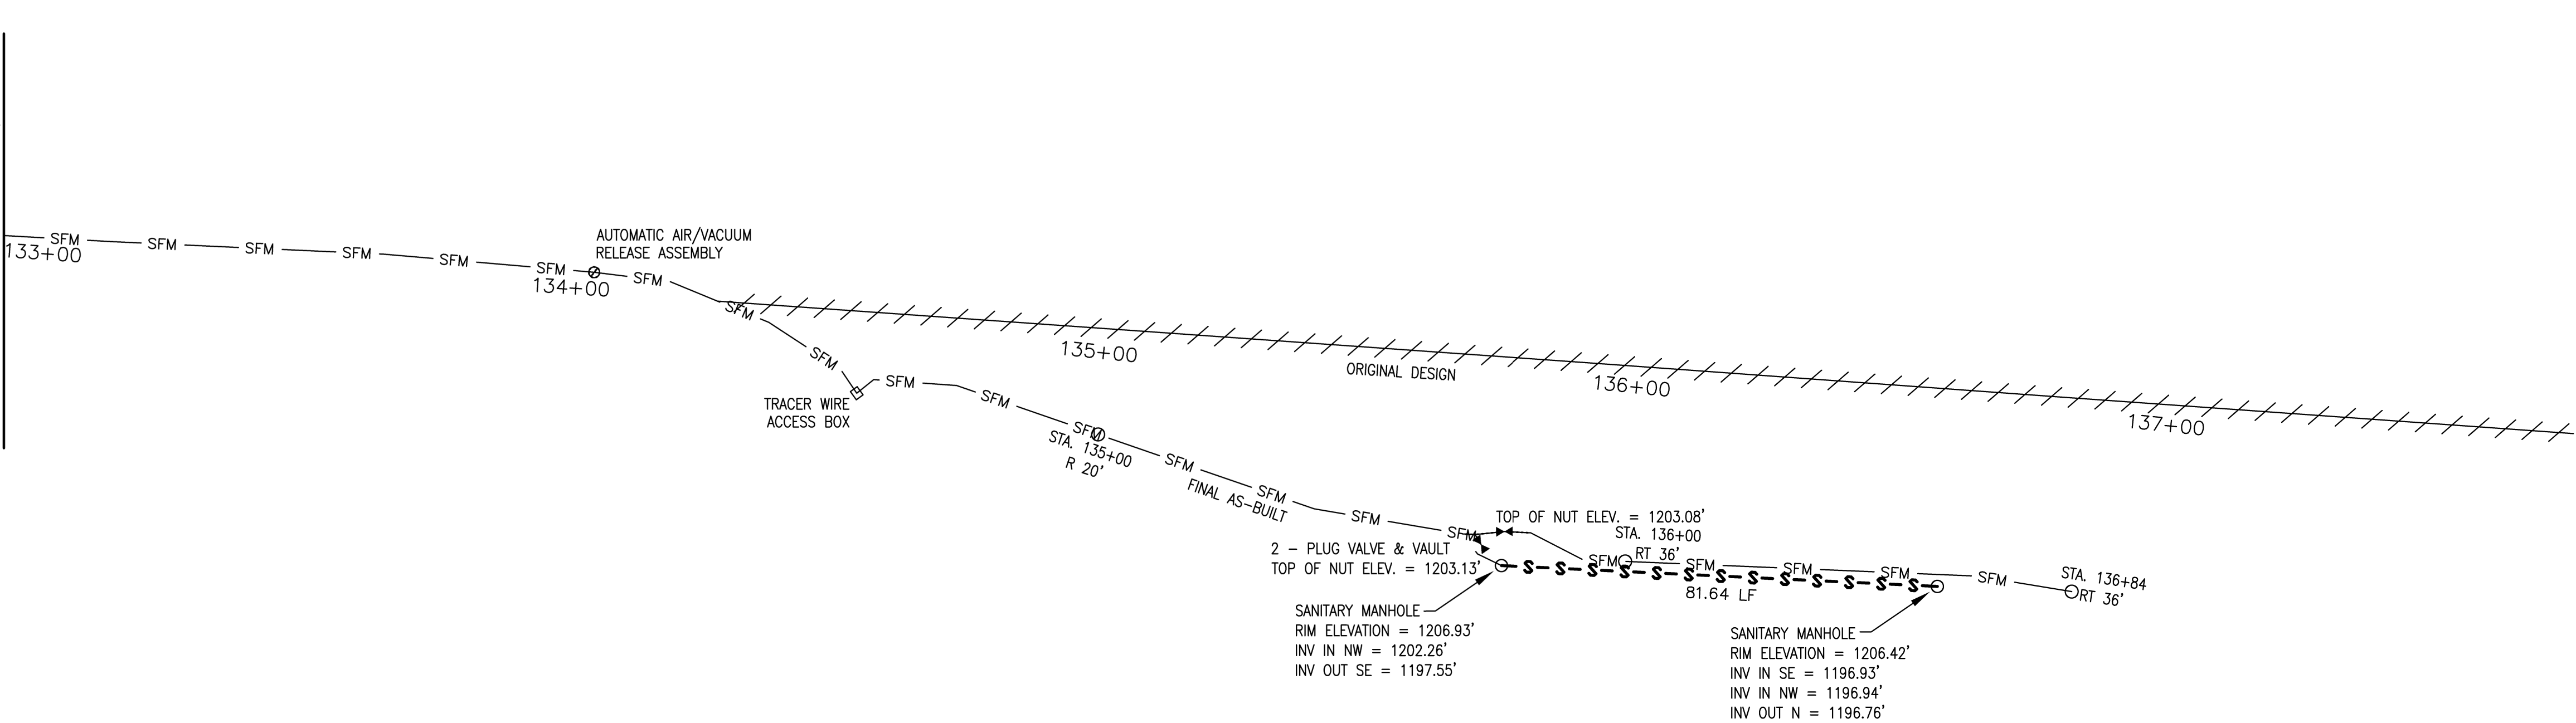

AS-BUILT



BYER, BENNETT AND ASSOCIATES, P.L.C.
4008 RINER RD, UNIT A
RINER, VA 24149
(540) 381-7004

SUMMIT VIEW BUSINESS PARK UTILITY IMPROVEMENTS
PHASE 1
AS-BUILT SURVEY

DATE 10/28/2019
SCALE 1" = 20'
CHECKED BY: DRB
DRAFTED BY: SRB

REV. NO.	DATE	BY	DESCRIPTION

JOB NO.
19-01

Sheet
10
of
10