
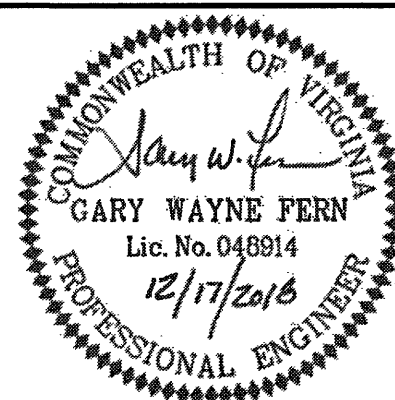
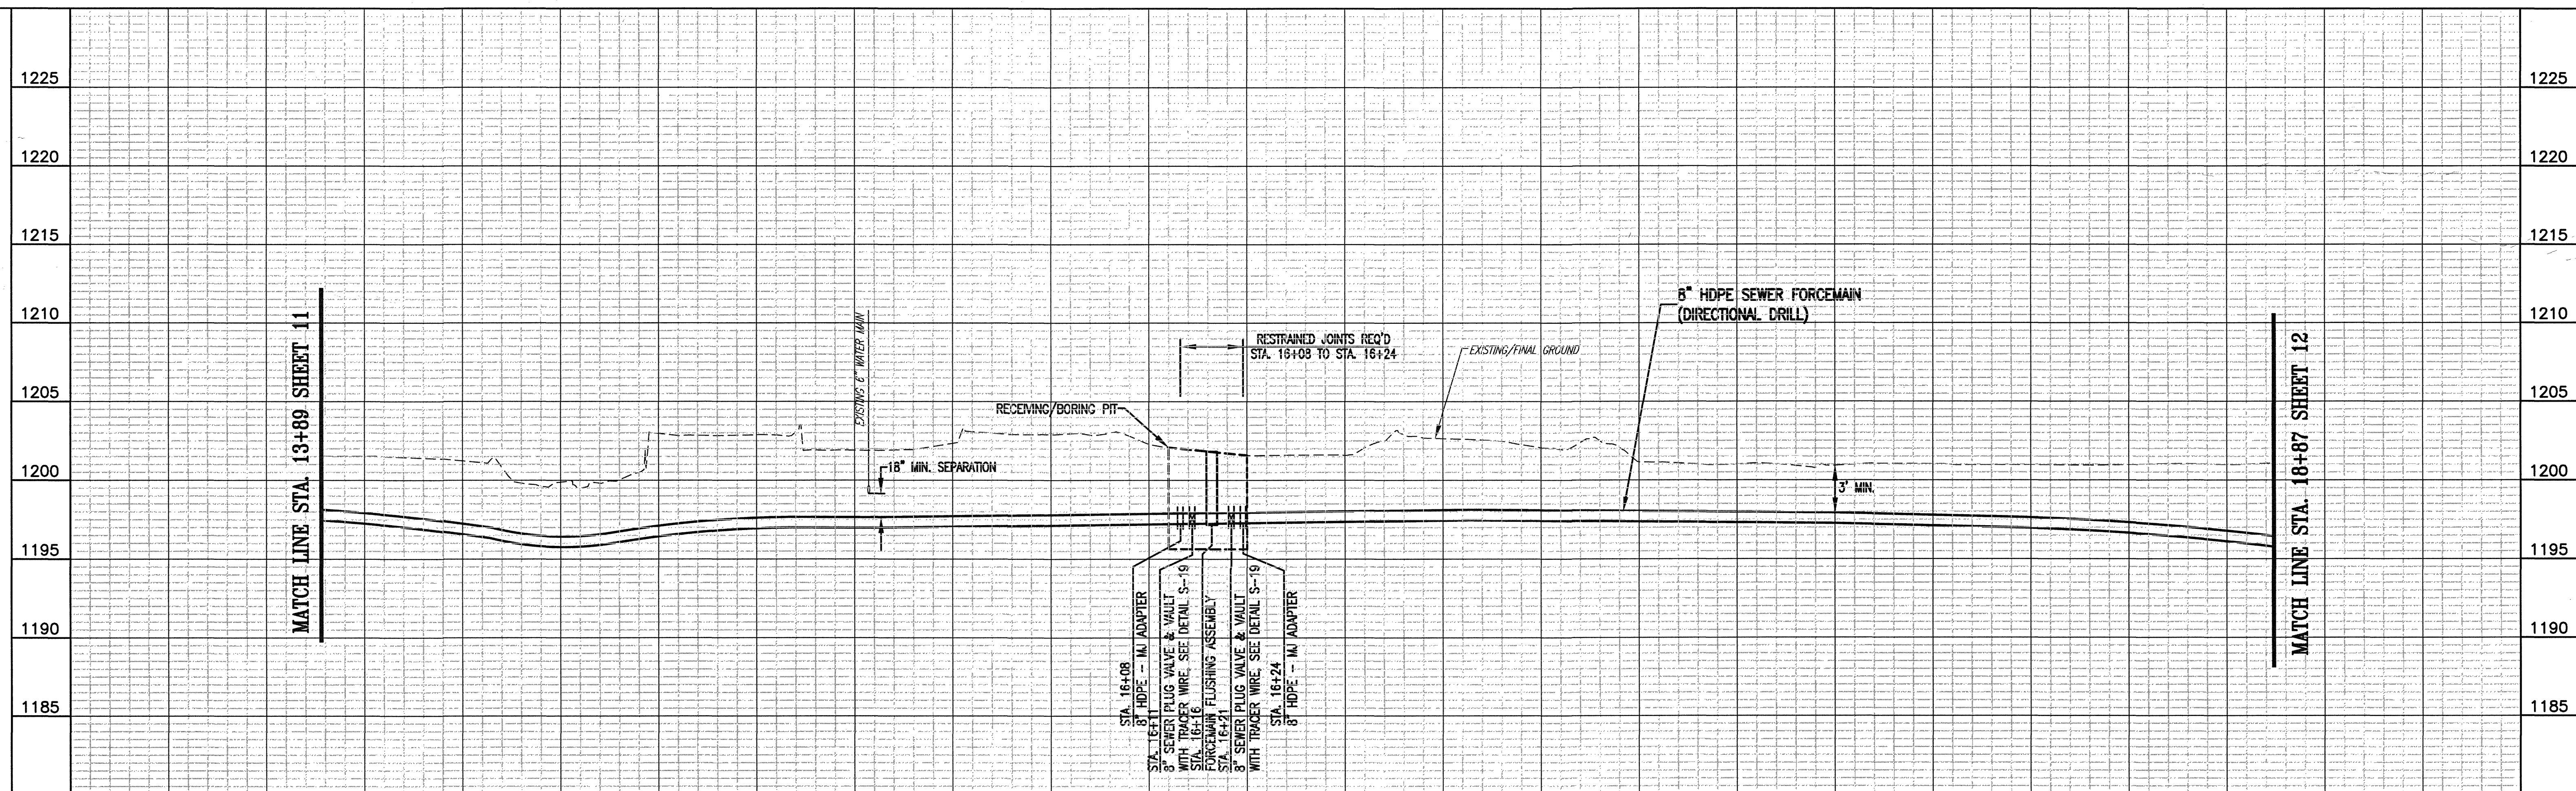


NOTE:

- ALL PIPE MATERIALS SHALL BE AS SPECIFIED ON THE PIPE SCHEDULE SHOWN ON DRAWING C1.08.

Virgil H. Goode Highway
(Route #220)
Variable Width Right-of-Way


Base Pit 1

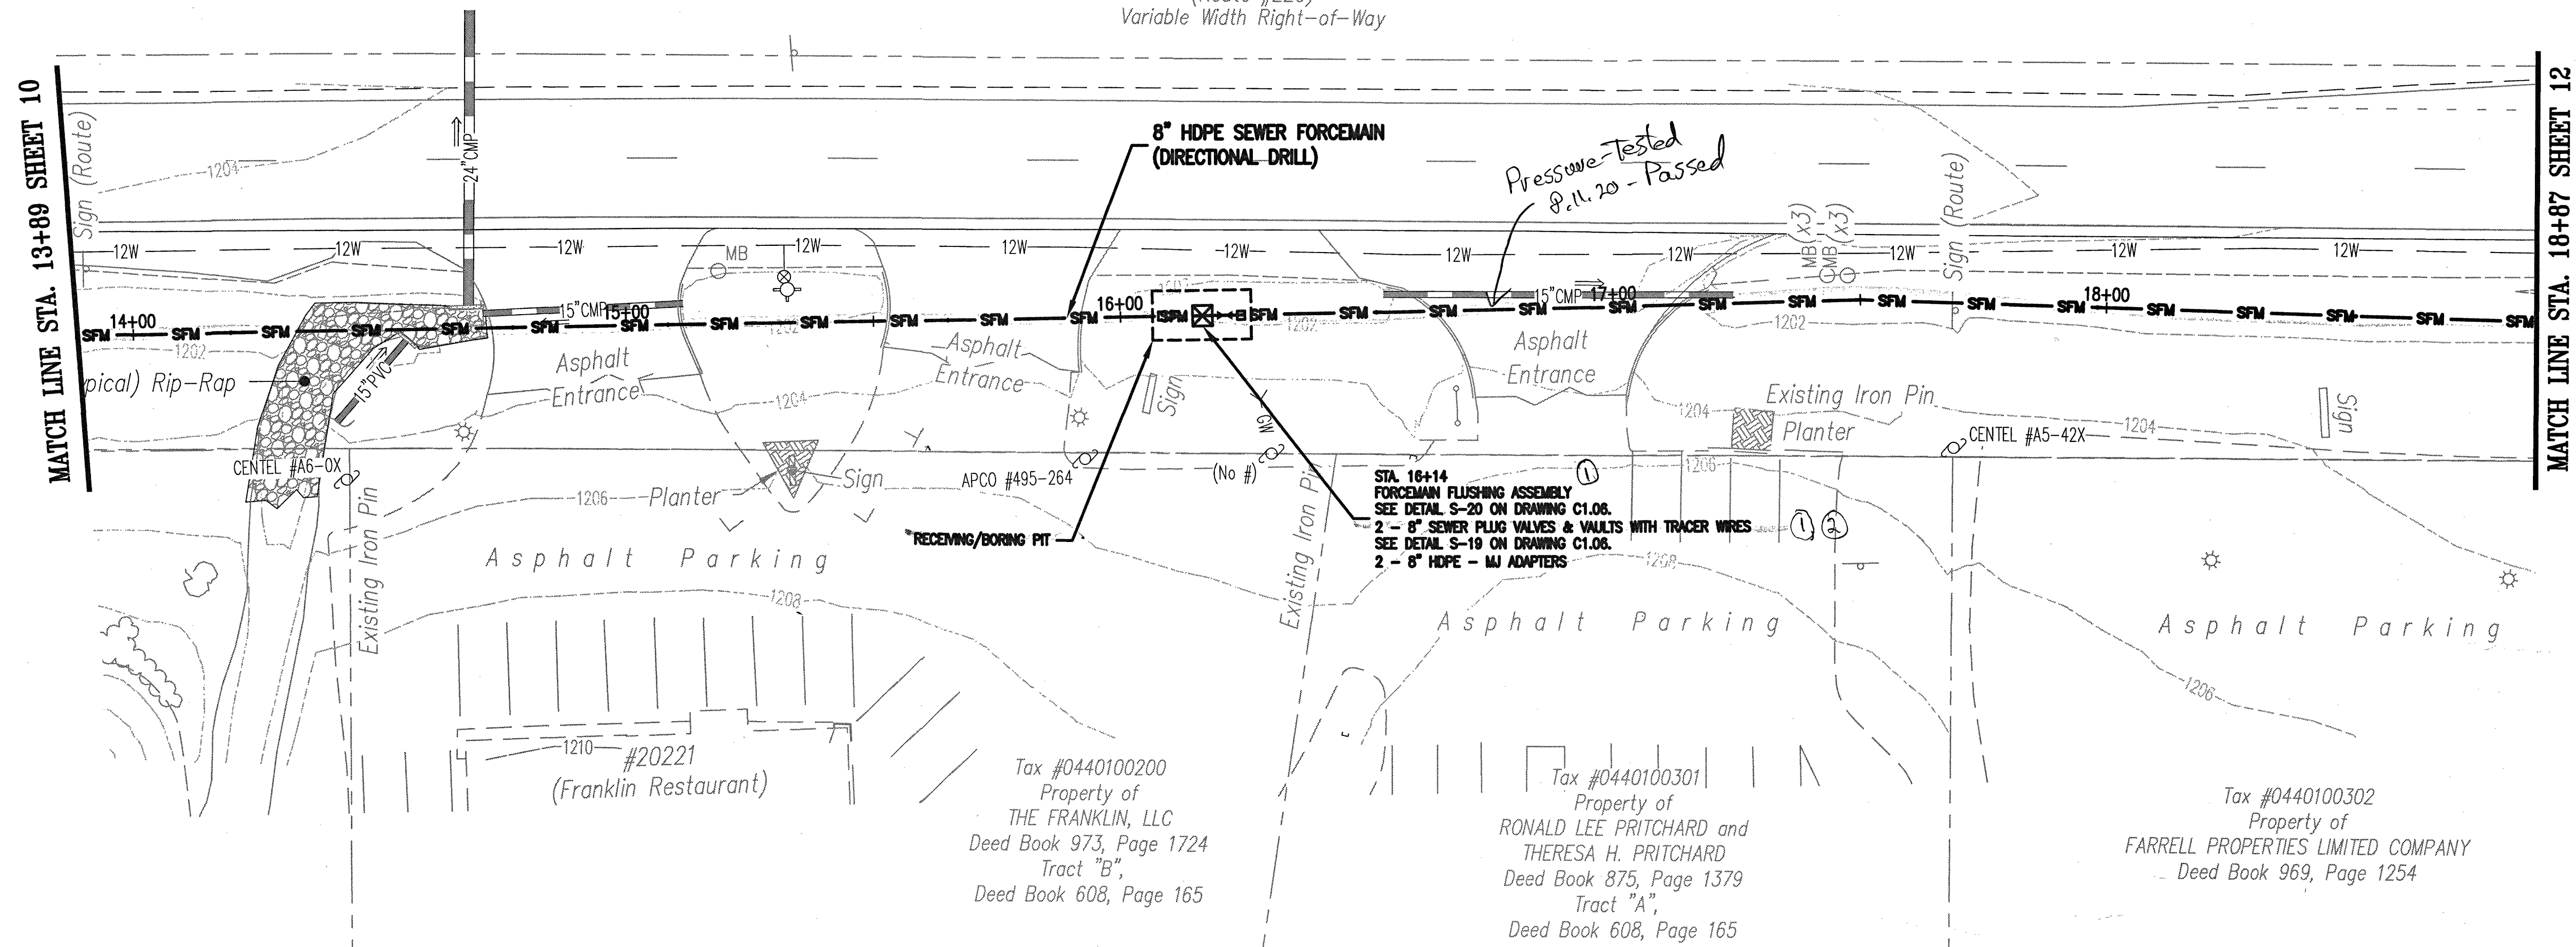

WESTERN VIRGINIA WATER AUTHORITY
601 South Jefferson Street, Suite 300
Roanoke, Virginia 24011

DES: PJM
DRAWN: JES
CHECK: GWF
DATE: 12/17/18

SCALE: AS SHOWN
HORIZ: 1" = 20'
VERT: 1" = 5'

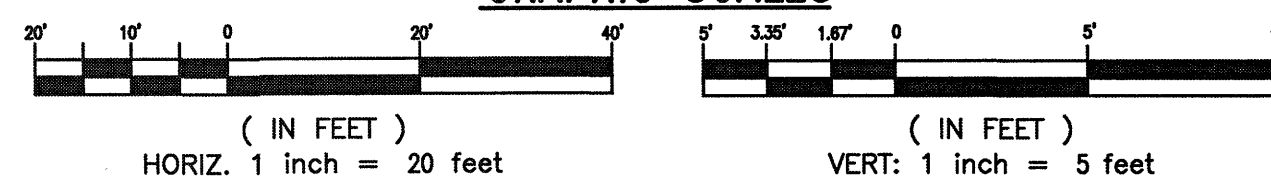

SUMMIT VIEW BUSINESS PARK UTILITY IMPROVEMENTS
PHASE 2

8" SEWER FORCEMAIN PLAN - PROFILE
STA. 13+89 TO STA. 18+87

REV	DATE	DESCRIPTION

DRAWING	SHEET
C1.08	11