
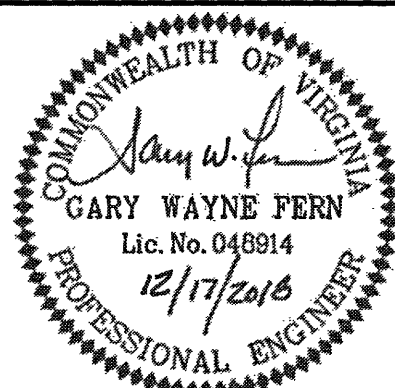
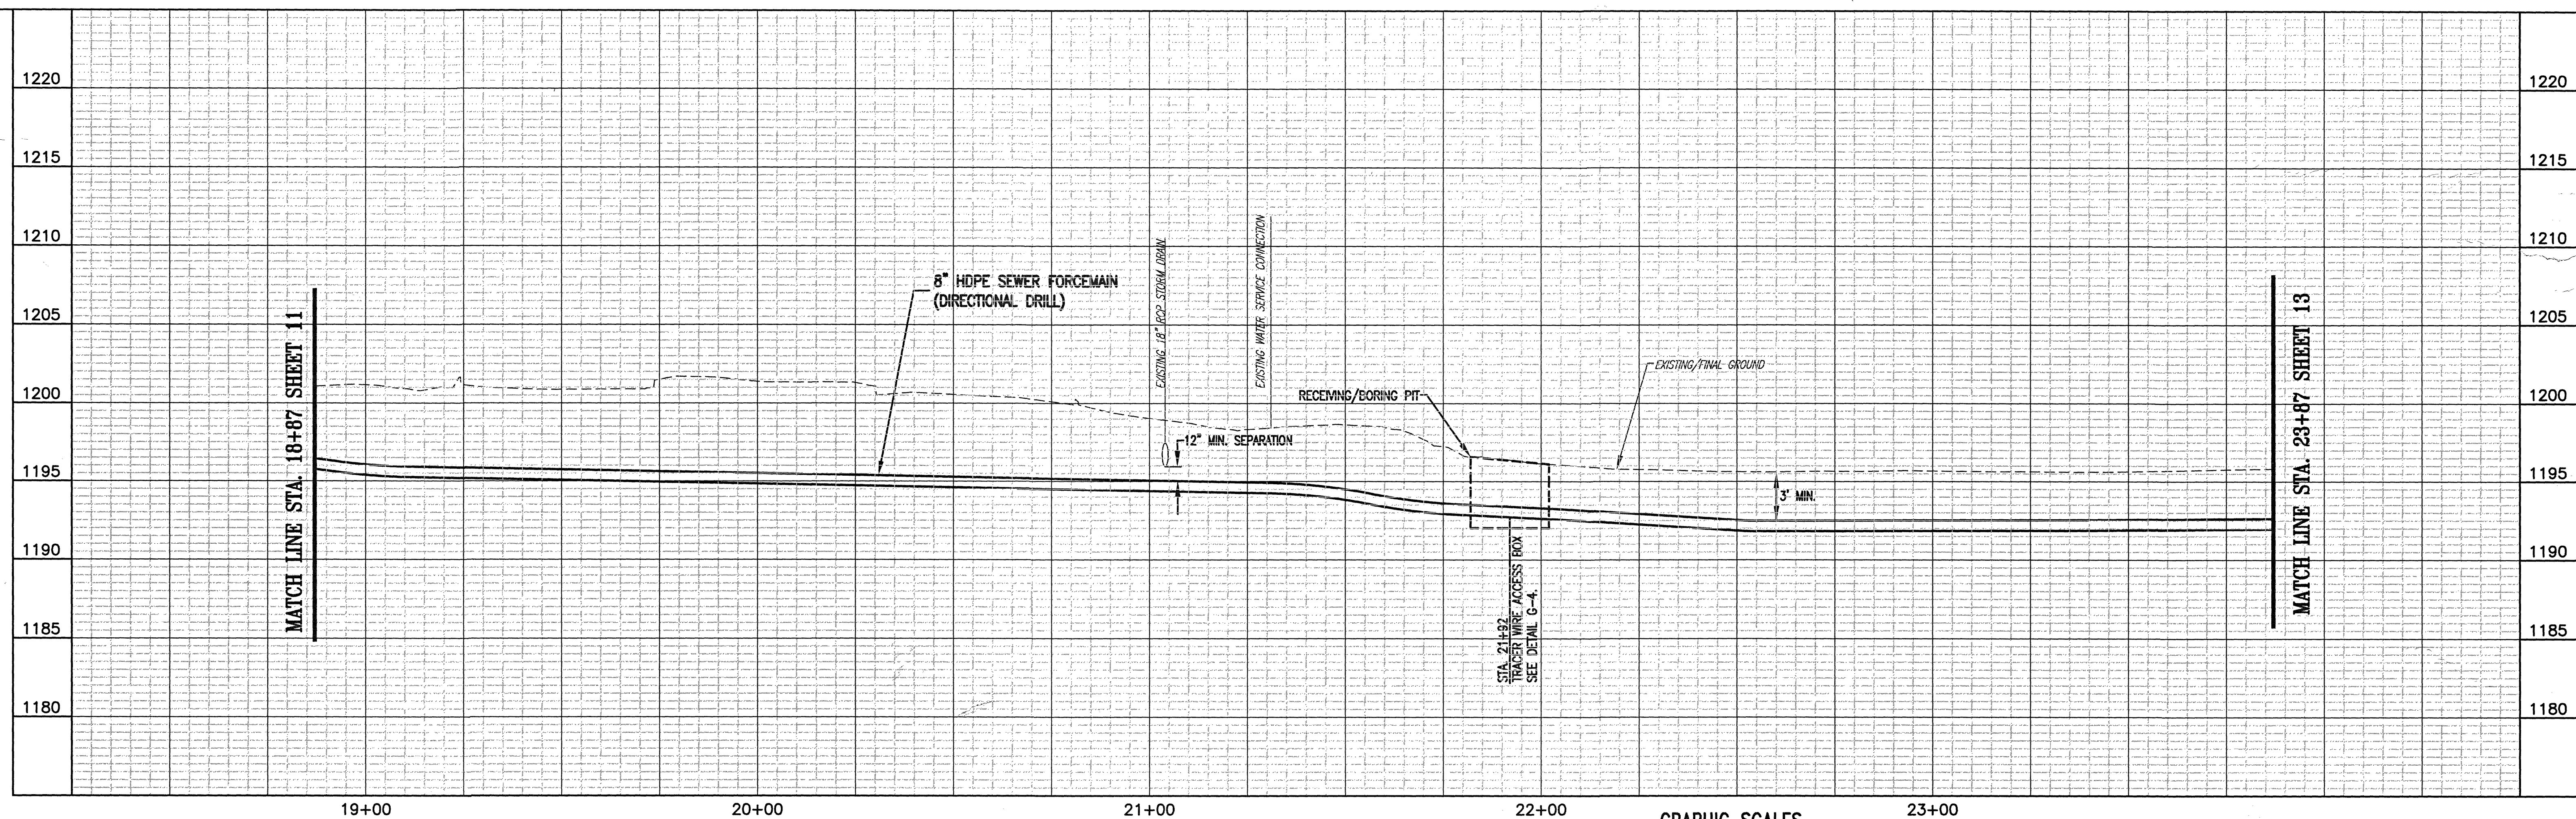


1. ALL PIPE MATERIALS SHALL BE AS SPECIFIED ON THE PIPE SCHEDULE SHOWN ON DRAWING C1.06.

Bove Pit 1

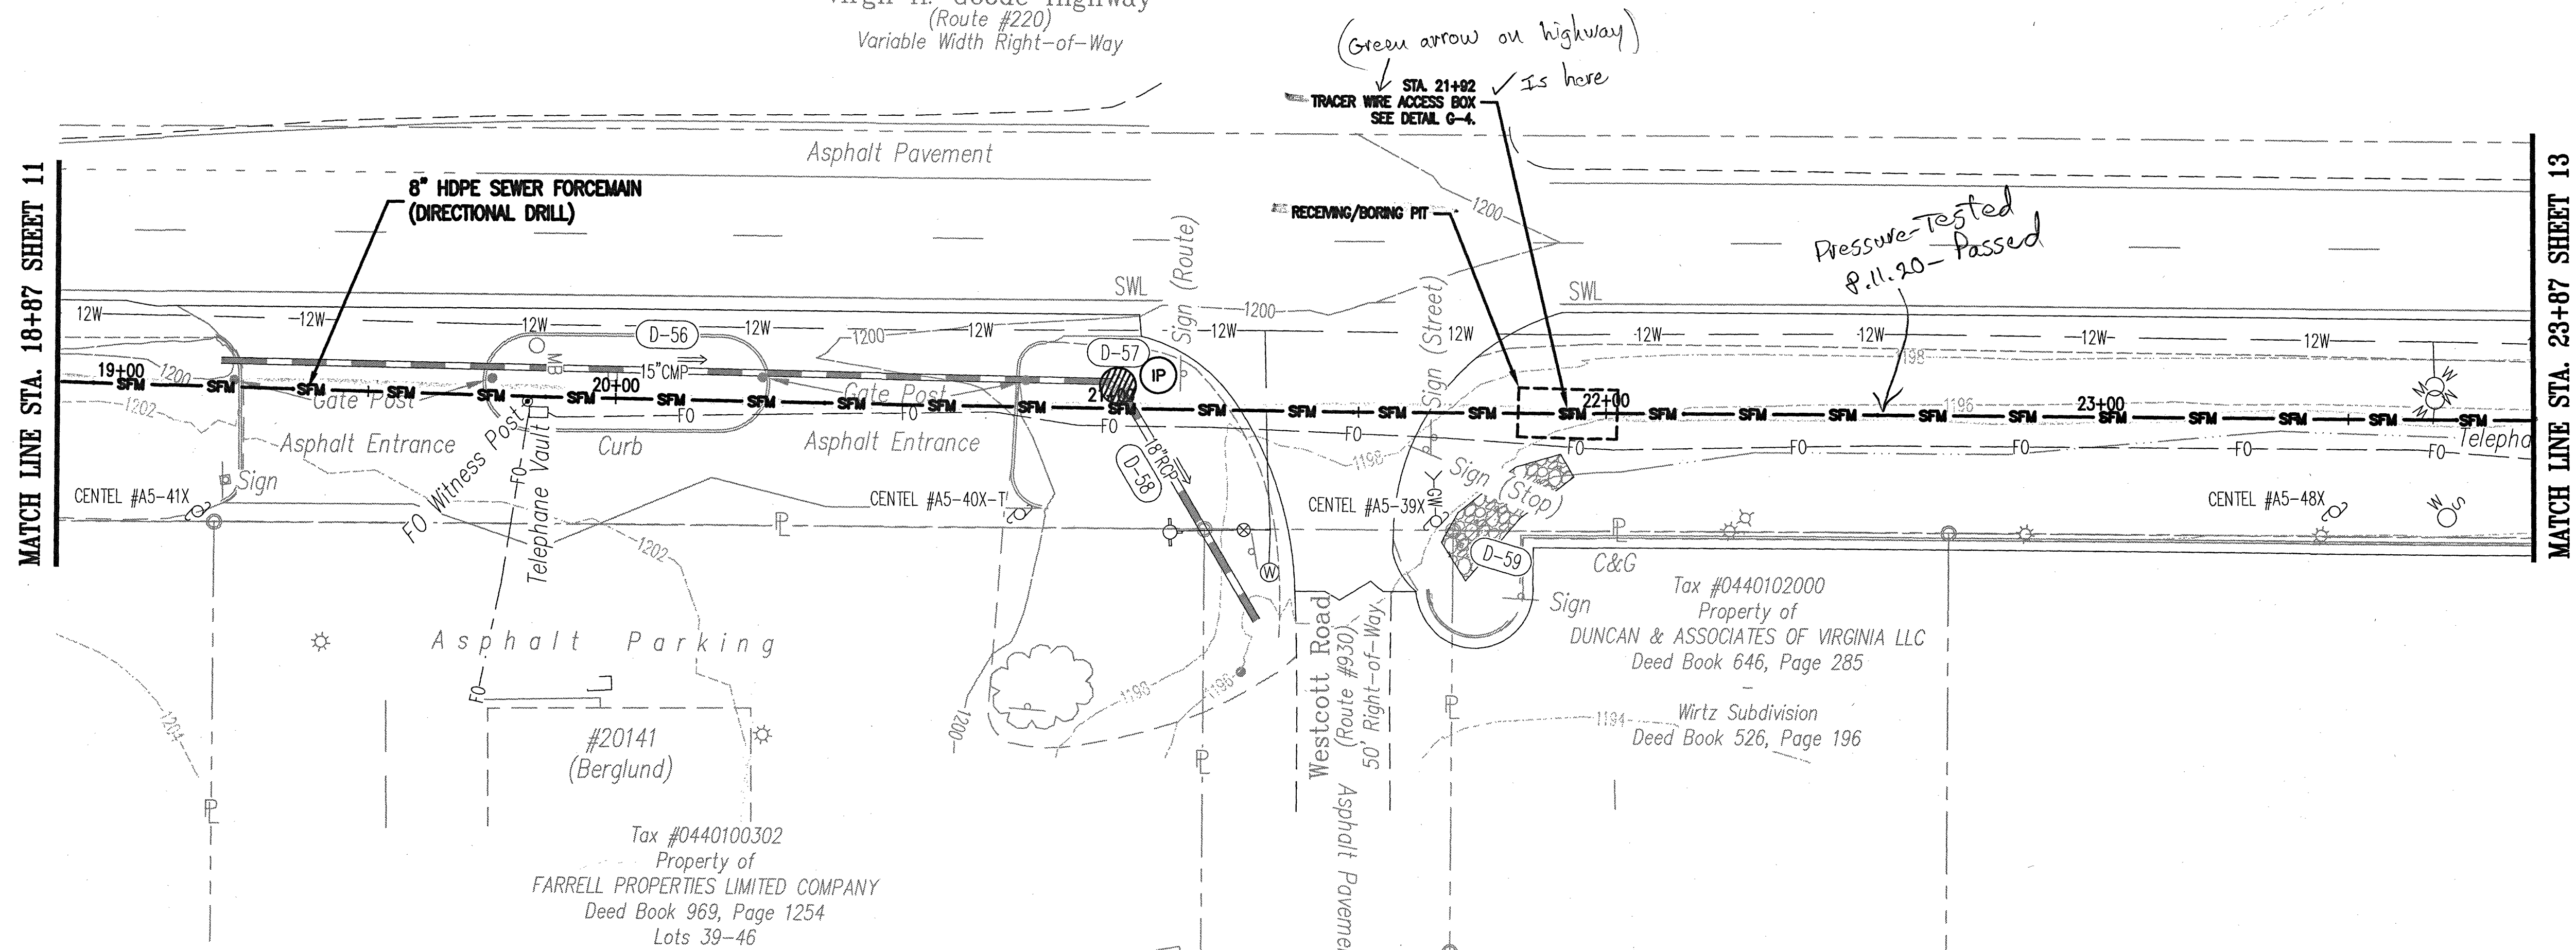

Whitman, Requardt & Associates, LLP
1700 Kraft Dr, Suite 1200, Blacksburg, VA 24060

WESTERN VIRGINIA WATER AUTHORITY
601 South Jefferson Street, Suite 300
Roanoke, Virginia 24011

DES:	PJM
DRAWN:	JES
CHECK:	GWF
DATE:	12/17/18

SCALE:	AS SHOWN
HORIZ:	1" = 20'
VERT:	1" = 5'

SUMMIT VIEW BUSINESS PARK UTILITY IMPROVEMENTS
PHASE 2

8" SEWER FORCEMAIN PLAN - PROFILE
STA. 18+87 TO STA. 23+87

DRAWING

C1.09

SHEET
12

