



NOTE:

1. ALL PIPE MATERIALS SHALL BE AS SPECIFIED ON THE PIPE SCHEDULE SHOWN ON DRAWING C1.06.
2. IN THE EVENT CONTRACTOR DAMAGES EXISTING PAVEMENT, CONTRACTOR SHALL MILL AND RE-PAVE WITH SURFACE MIX (1.5-INCH DEEP) ONE LANE OF ROADWAY AT NO COST TO THE OWNER.

34+15 to 39+00
Installed, invoice dated 5.13.19

Bore Pit 1

Virgil H. Goode Highway
(Route #220)
Variable Width Right-of-Way

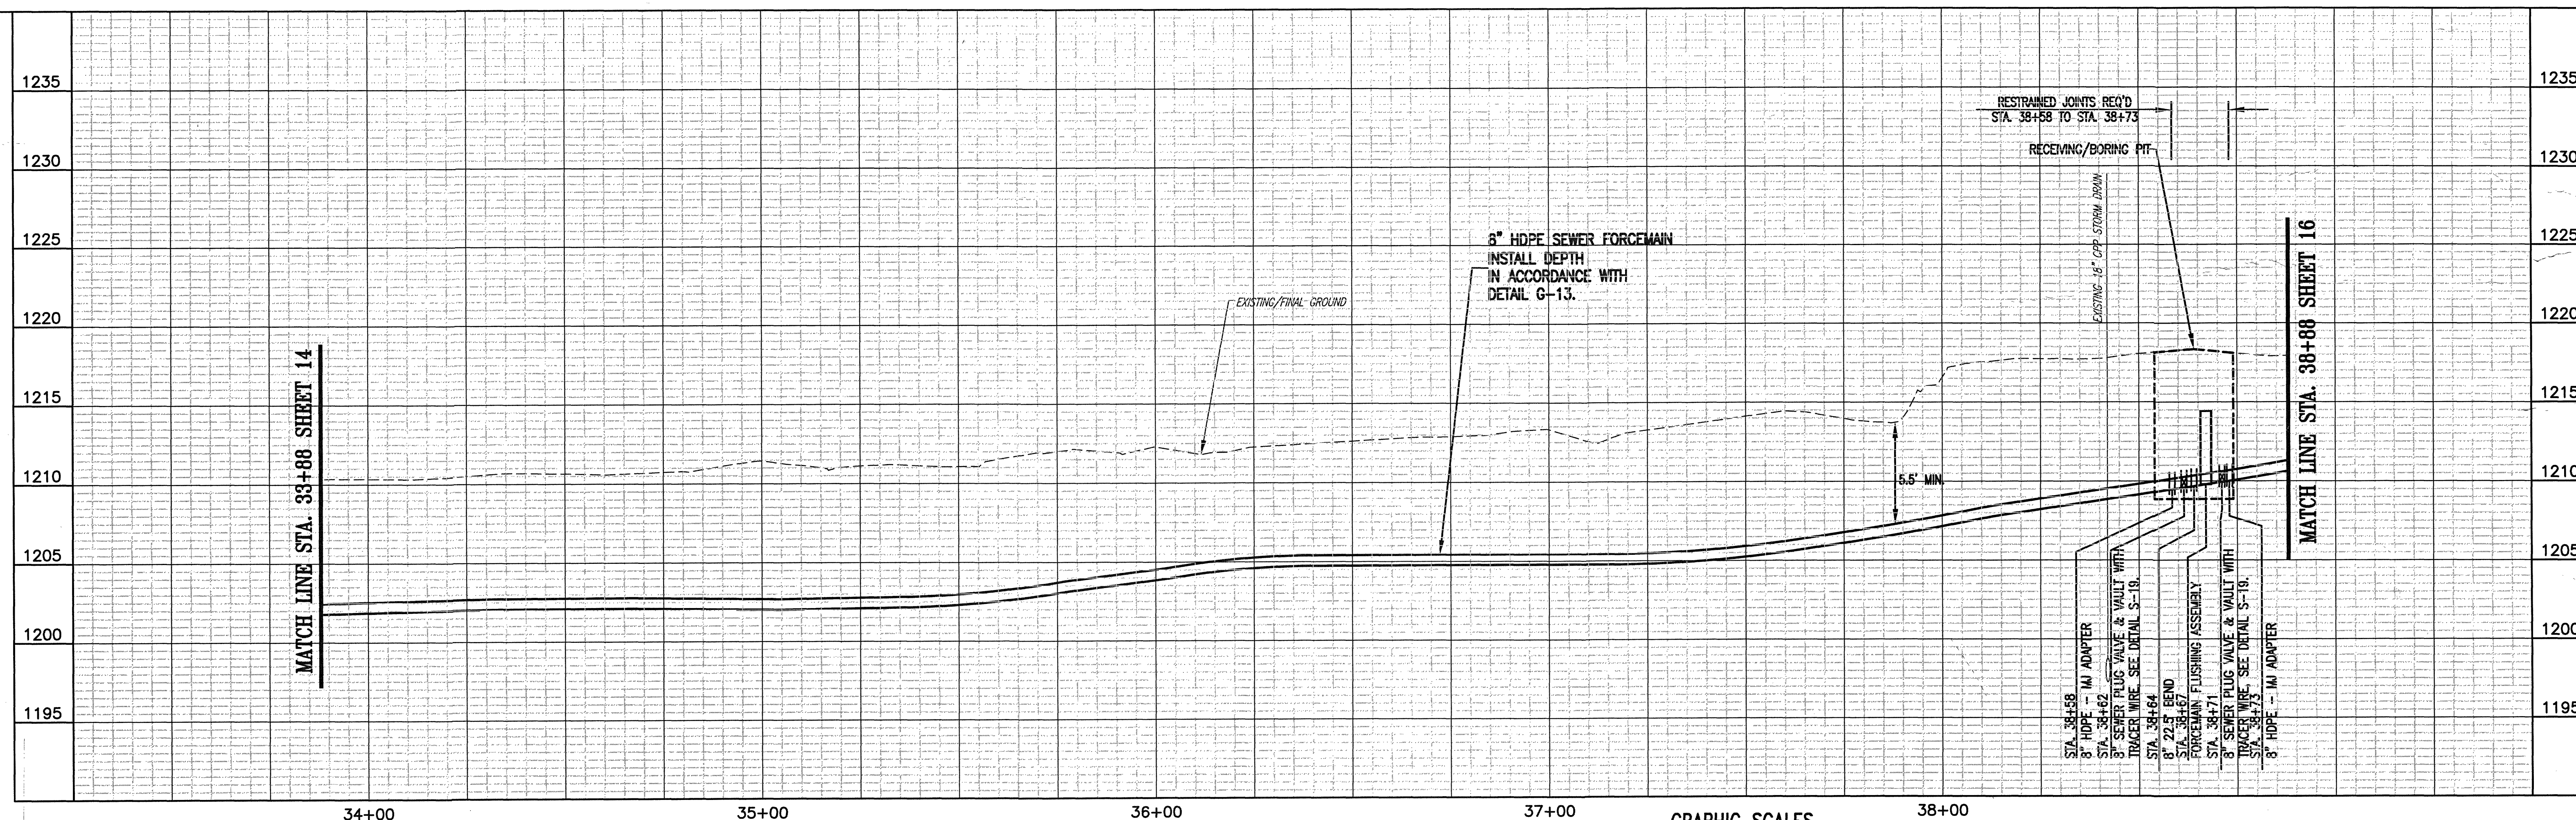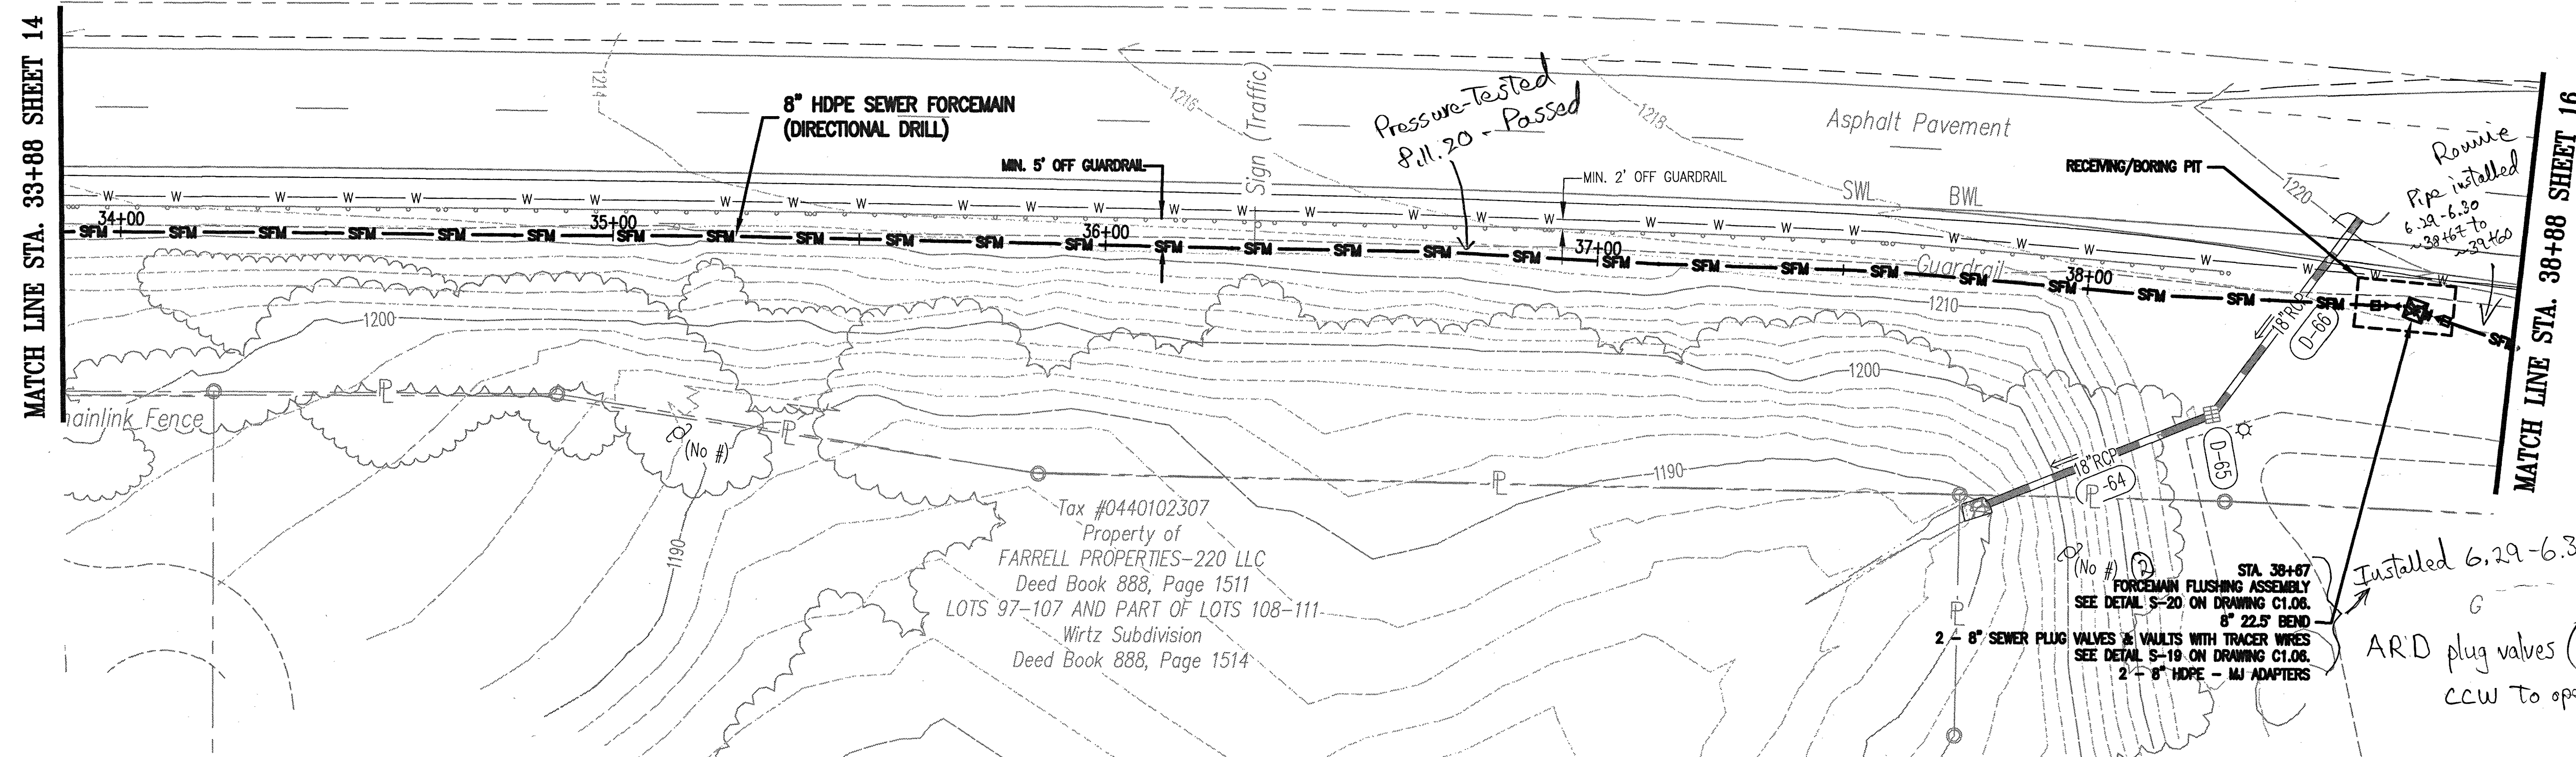

34+00



35+00

36+00

37+00

38+00

GRAPHIC SCALES

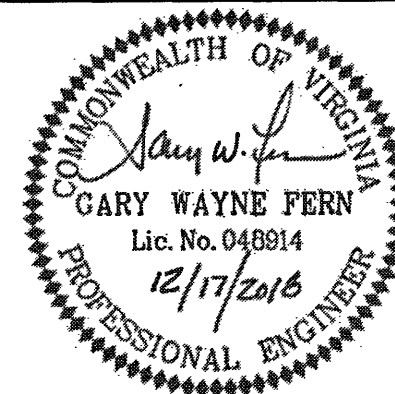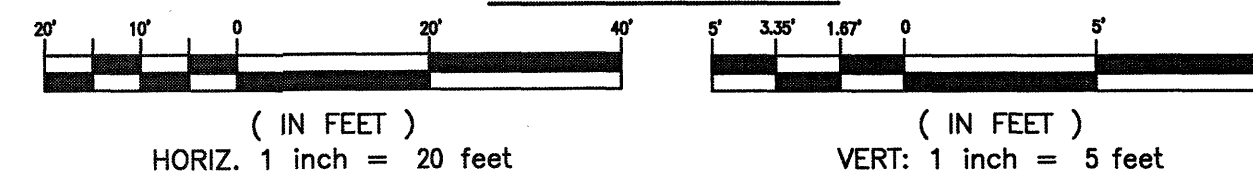

Whitman, Requardt & Associates, LLP
1700 Kraft Dr, Suite 1200, Blacksburg, VA 24060

WESTERN VIRGINIA WATER AUTHORITY
601 South Jefferson Street, Suite 300
Roanoke, Virginia 24011

DES: PJM
DRAWN: JES
CHECK: GWP
DATE: 12/17/18

SCALE: AS SHOWN
HORIZ: 1" = 20'
VERT: 1" = 5'

SUMMIT VIEW BUSINESS PARK UTILITY IMPROVEMENTS
PHASE 2

8" SEWER FORCEMAIN PLAN - PROFILE
STA. 33+88 TO STA. 38+88

REV DATE DESCRIPTION

DRAWING
C1.12

SHEET
15