
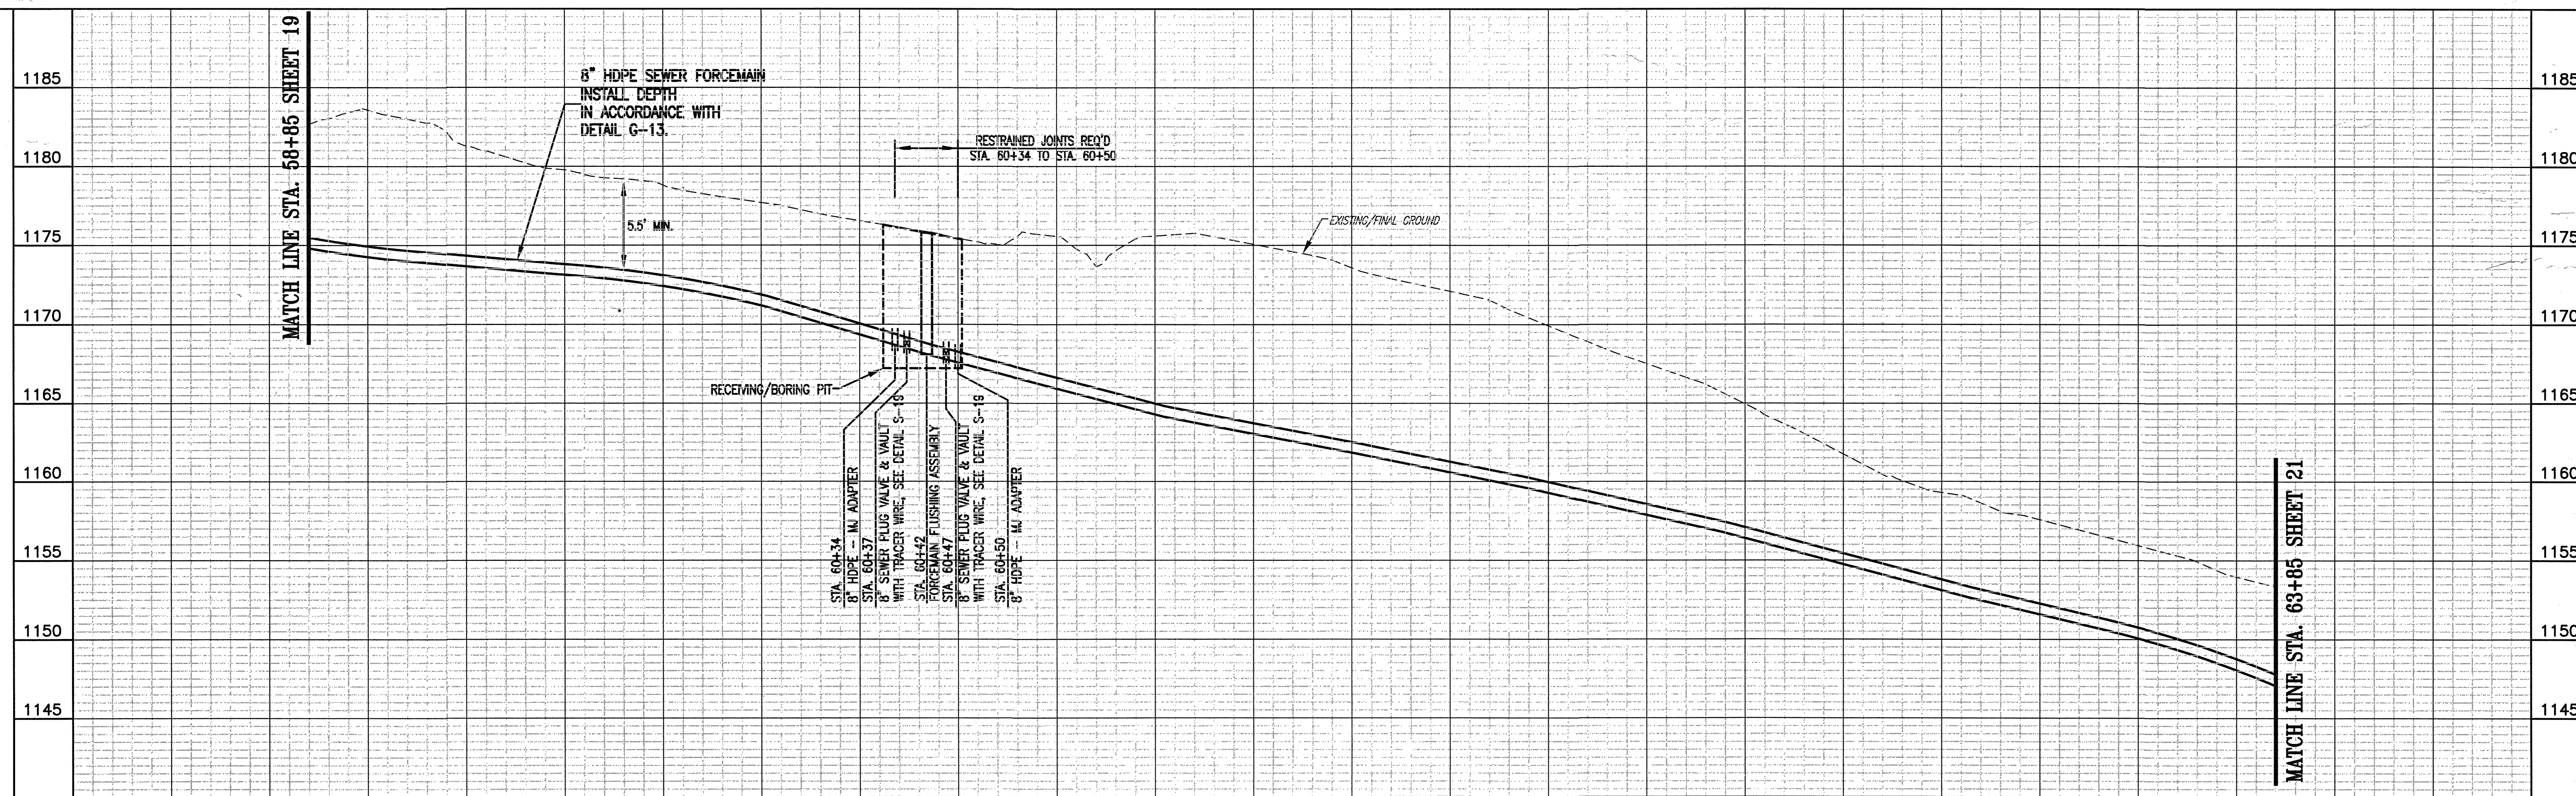




NOTE:

- ALL PIPE MATERIALS SHALL BE AS SPECIFIED ON THE PIPE SCHEDULE SHOWN ON DRAWING C1.06.

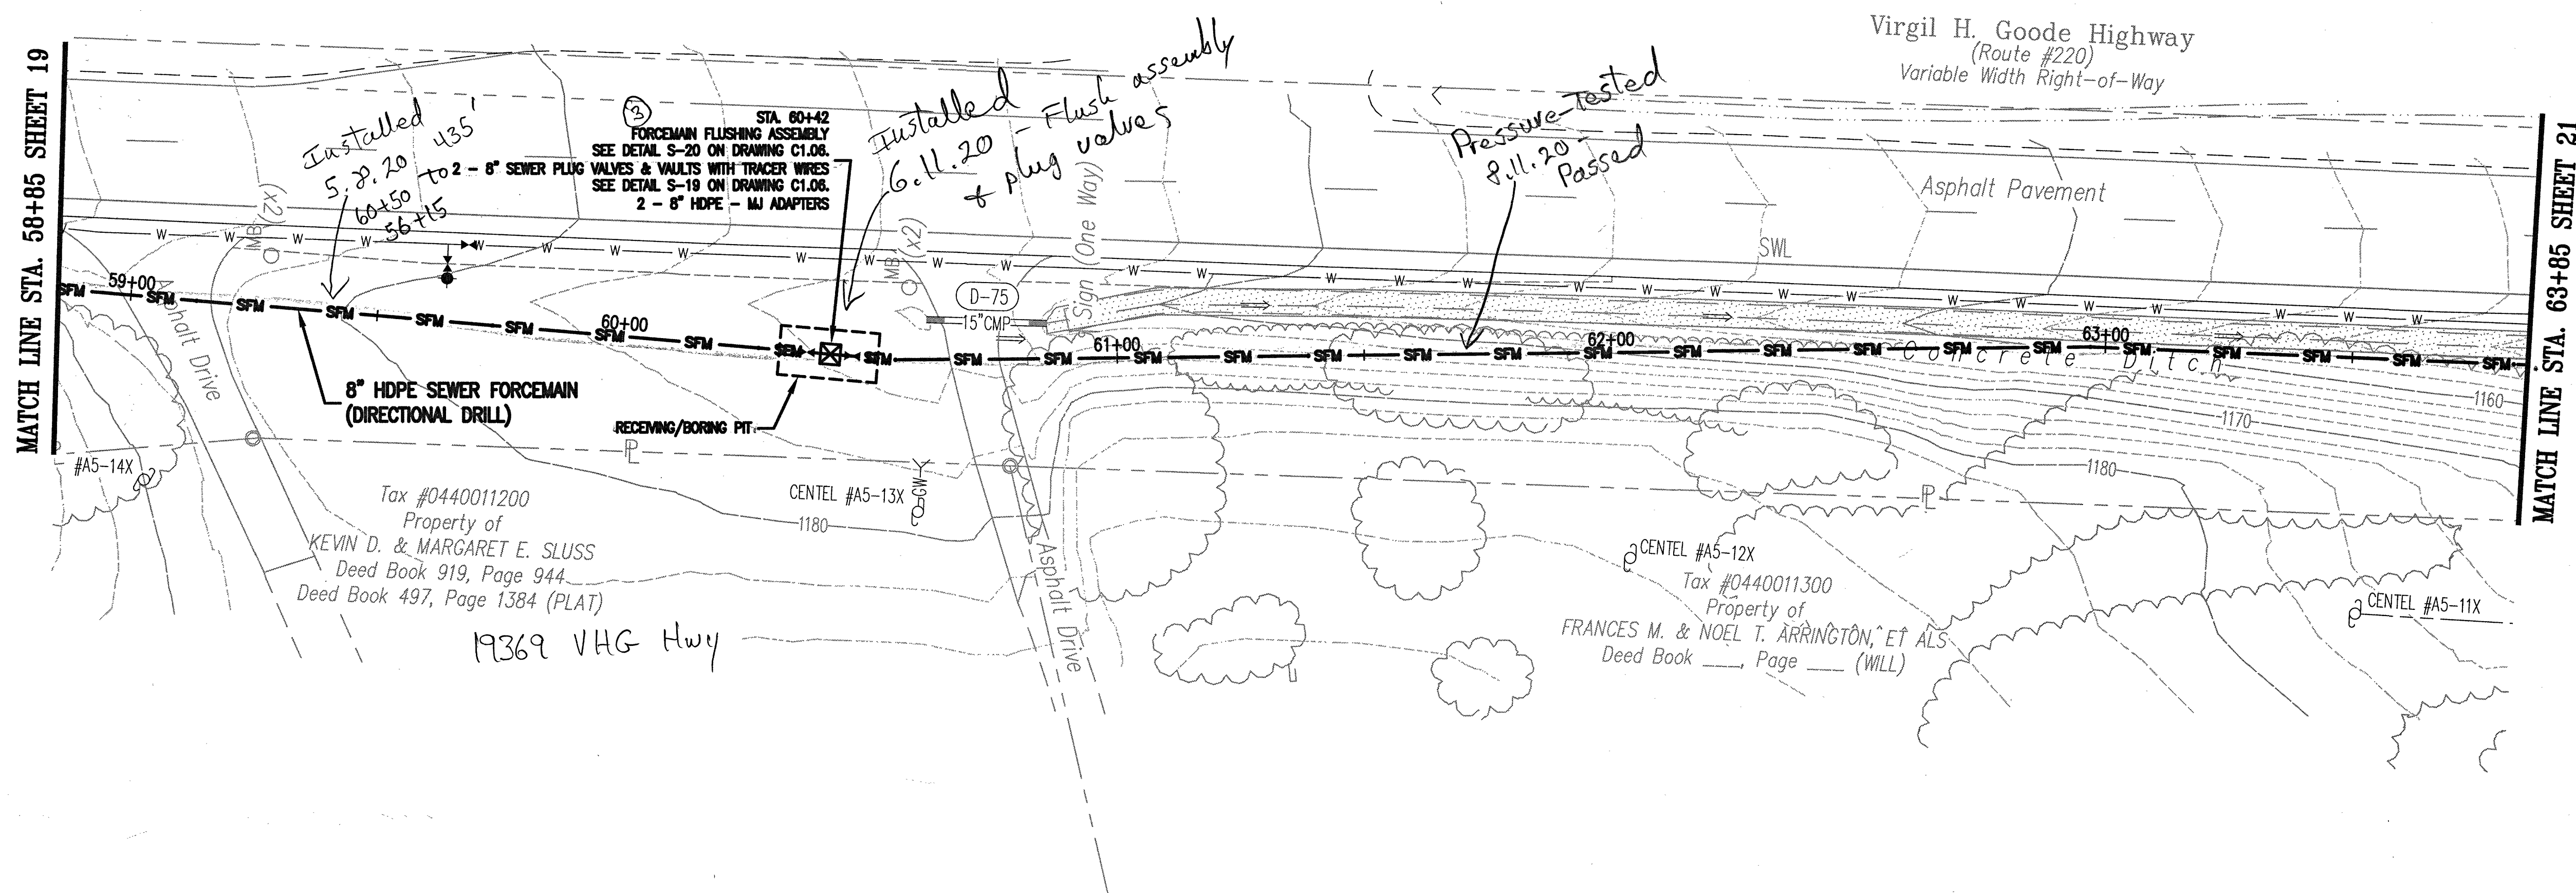

59+00 60+00 61+00 62+00 63+00

GRAPHIC SCALES

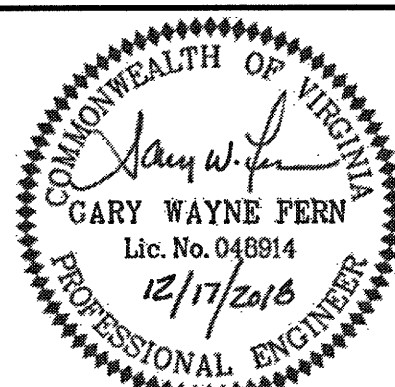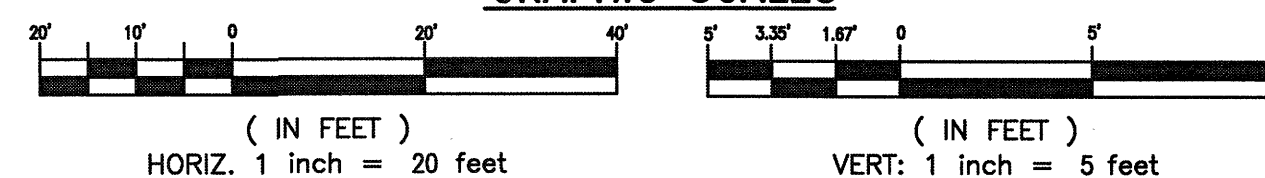

Whitman, Requardt & Associates, LLP
1700 Kraft Dr., Suite 1200, Blacksburg, VA 24060

WESTERN VIRGINIA WATER AUTHORITY
601 South Jefferson Street, Suite 300
Roanoke, Virginia 24011

DES: PJM
DRAWN: JBS
CHECK: GWF
DATE: 12/17/18
SCALE: AS SHOWN
HORIZ: 1" = 20'
VERT: 1" = 5'

SUMMIT VIEW BUSINESS PARK UTILITY IMPROVEMENTS
PHASE 2

8" SEWER FORCEMAIN PLAN - PROFILE
STA. 58+85 TO STA. 63+85

DRAWING
C1.17

SHEET
20

REV	DATE	DESCRIPTION