
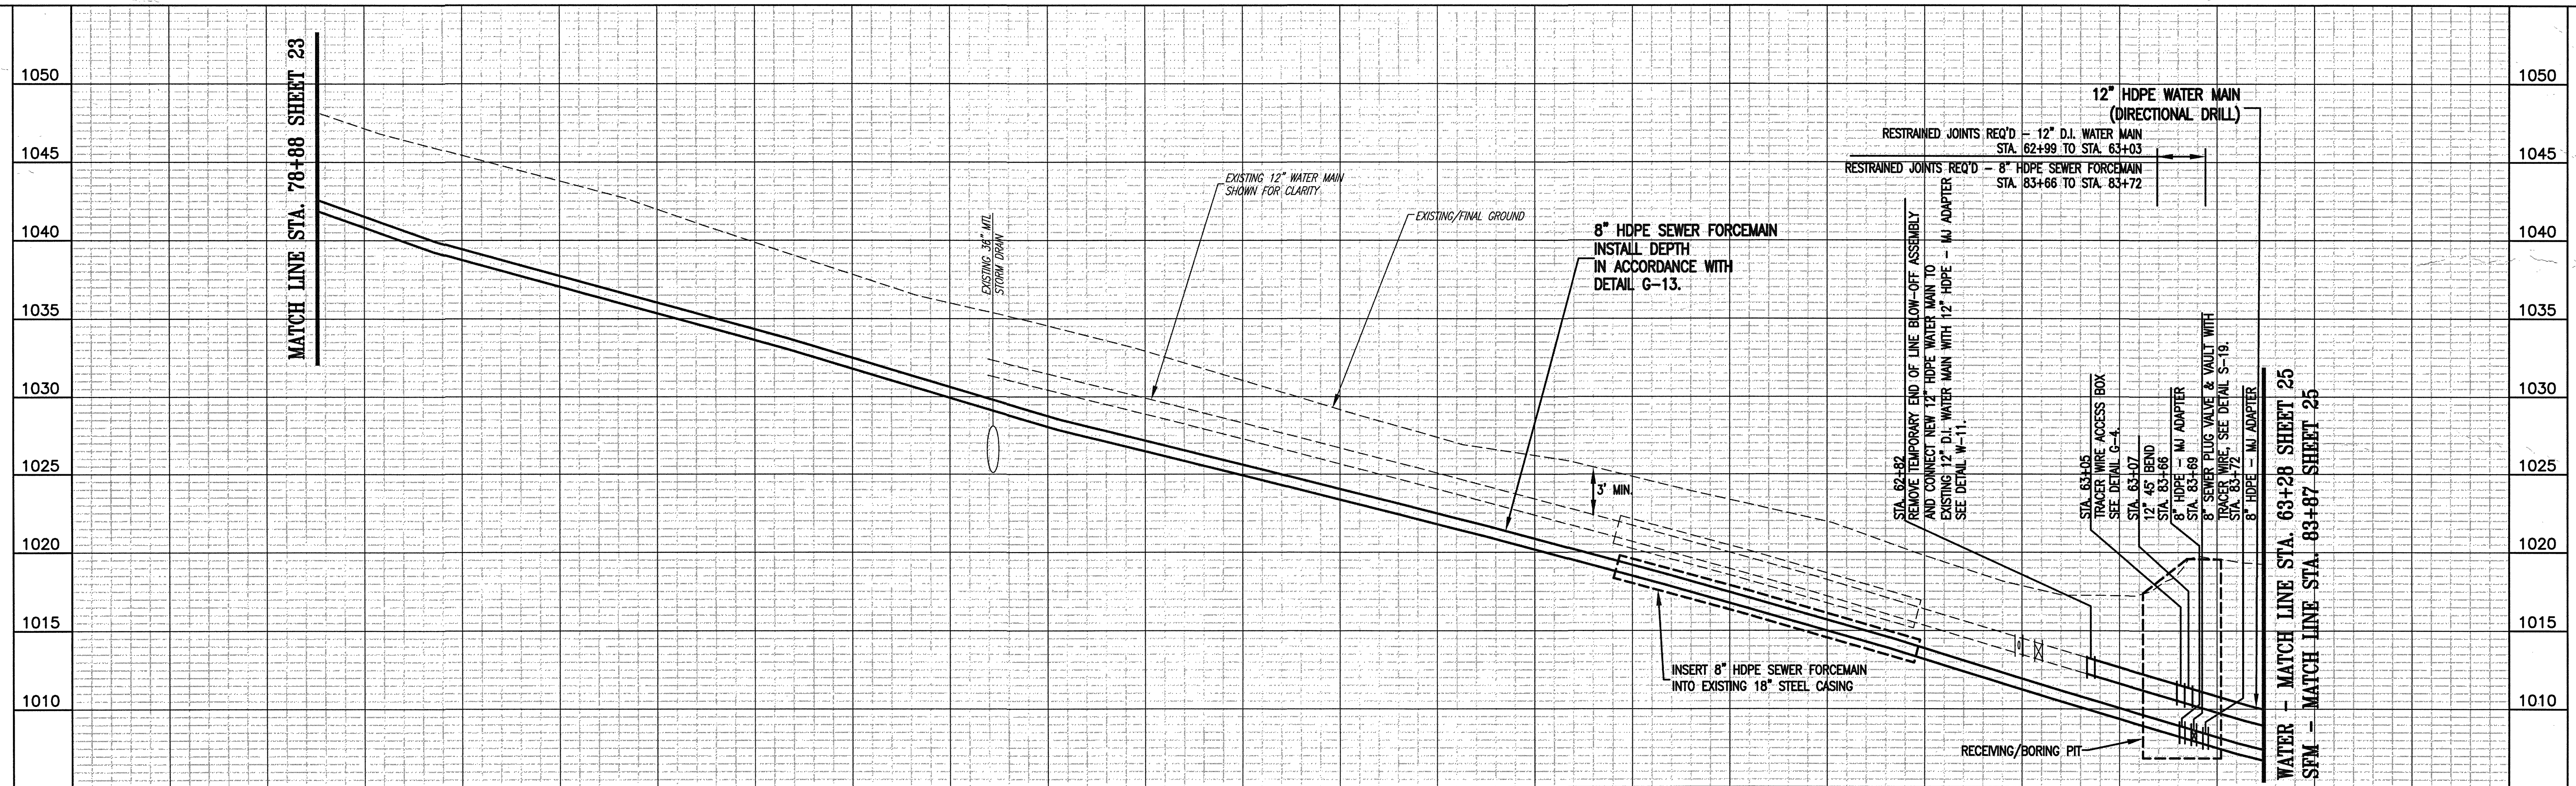


NOTE:

1. ALL PIPE MATERIALS SHALL BE AS SPECIFIED ON THE PIPE SCHEDULE SHOWN ON DRAWING C1.06.
2. IN THE EVENT CONTRACTOR DAMAGES EXISTING PAVEMENT, CONTRACTOR SHALL MILL AND RE-PAVE WITH SURFACE MIX (1.5-INCH DEEP) ONE LANE OF ROADWAY AT NO COST TO THE OWNER.

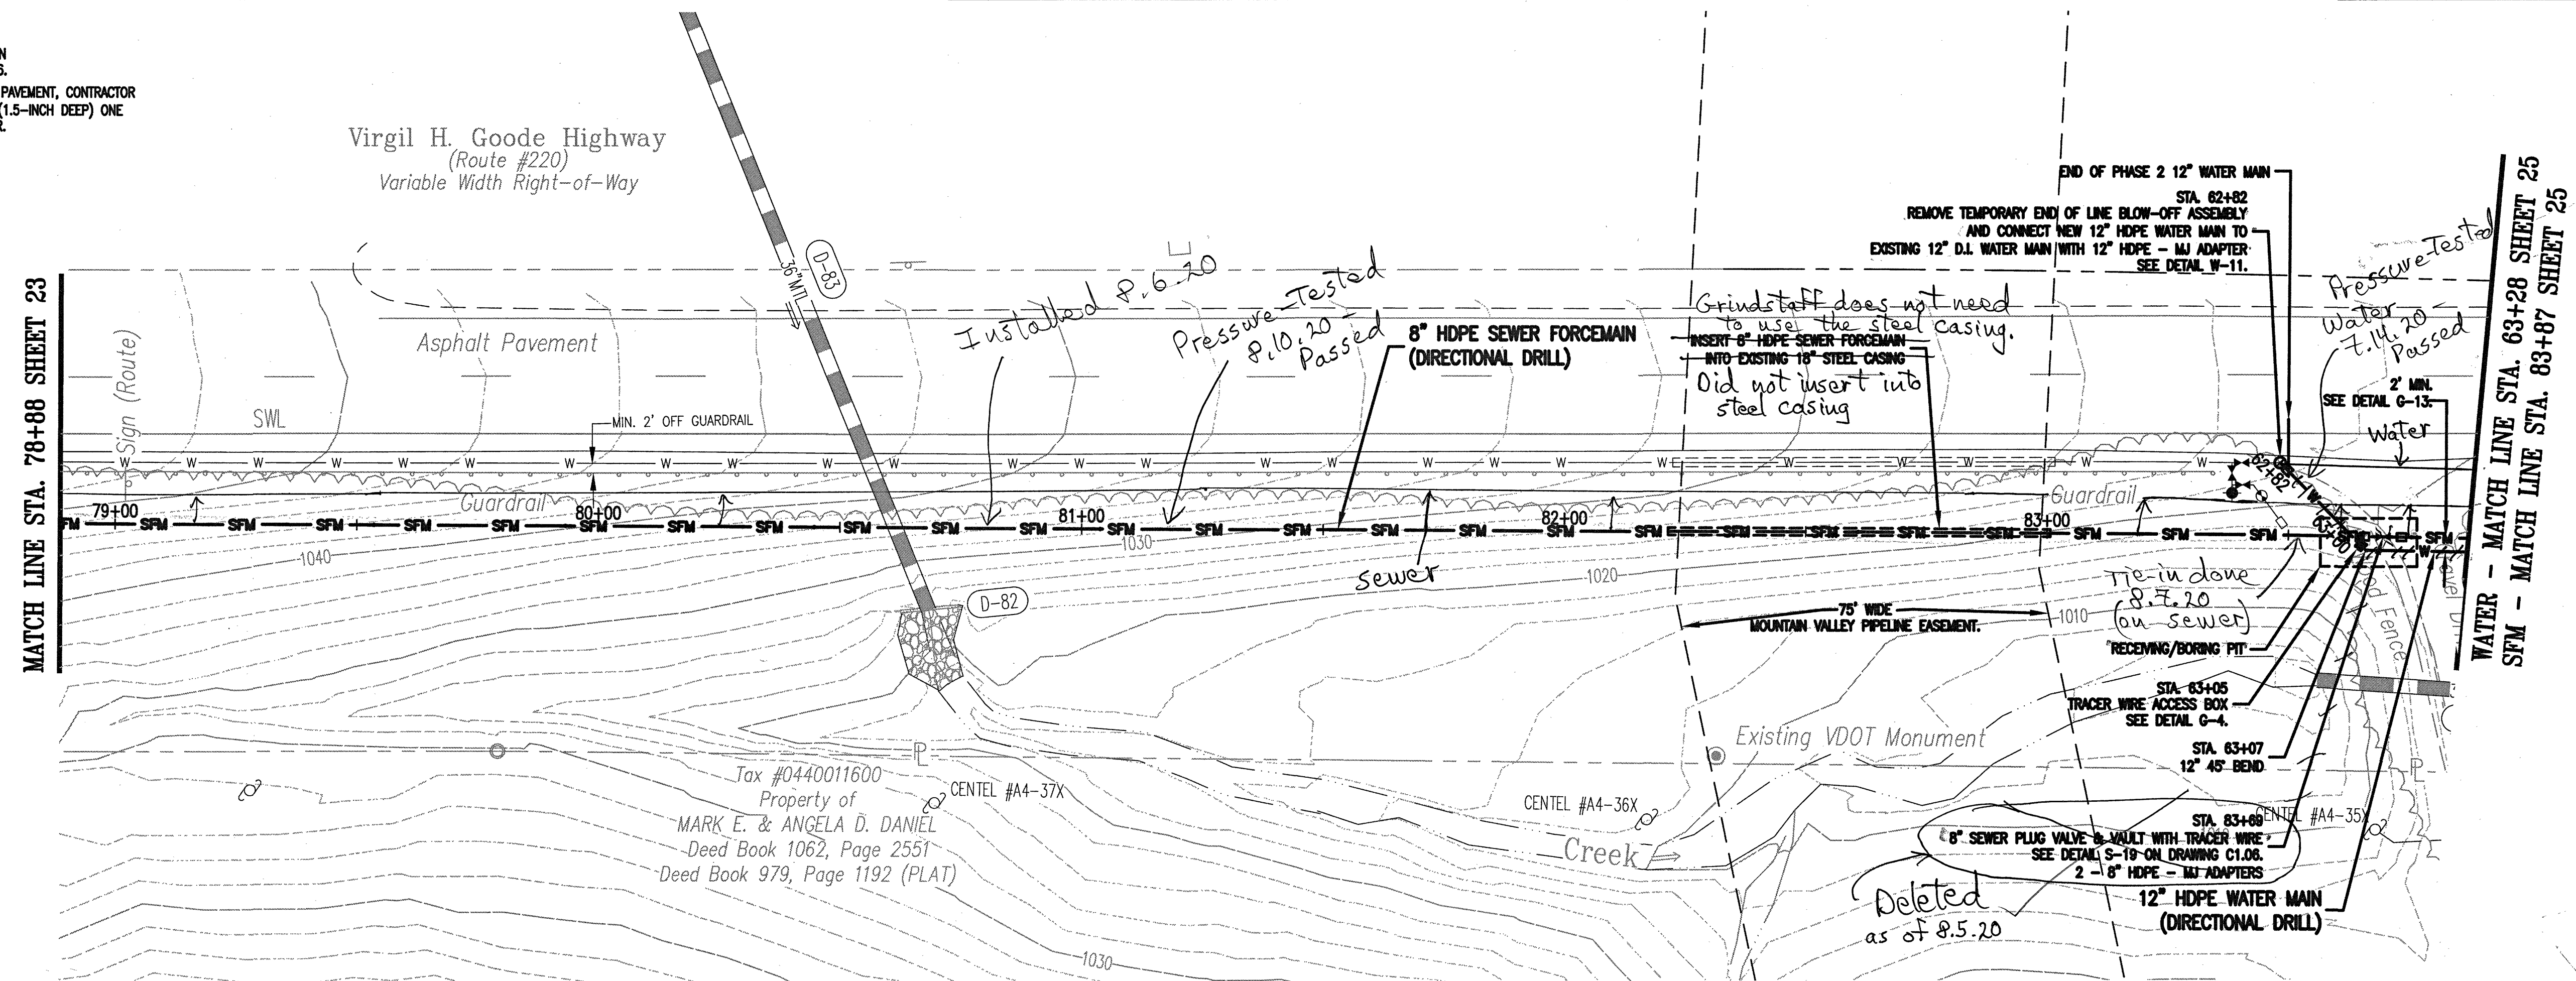

WESTERN VIRGINIA WATER AUTHORITY
601 South Jefferson Street, Suite 300
Roanoke, Virginia 24011

GRAPHIC SCALES

HORIZ. 1 inch = 20 feet

VERT. 1 inch = 5 feet

DES: PJM
DRAWN: JES
CHECK: GWF
DATE: 12/17/18

SCALE: AS SHOWN
HORIZ: 1" = 20'
VERT: 1" = 5'

SUMMIT VIEW BUSINESS PARK UTILITY IMPROVEMENTS
PHASE 2

8" SEWER FORCEMAIN PLAN - PROFILE
STA. 78+88 TO STA. 83+87
12" WATER MAIN PLAN - PROFILE
STA. 62+82 TO STA. 63+28

REV	DATE	DESCRIPTION

WATER - MATCH LINE STA. 63+28 SHEET 25
SFM - MATCH LINE STA. 83+87 SHEET 25

WATER - MATCH LINE STA. 63+28 SHEET 25
SFM - MATCH LINE STA. 83+87 SHEET 25

DRAWING
C1.21

SHEET
24