
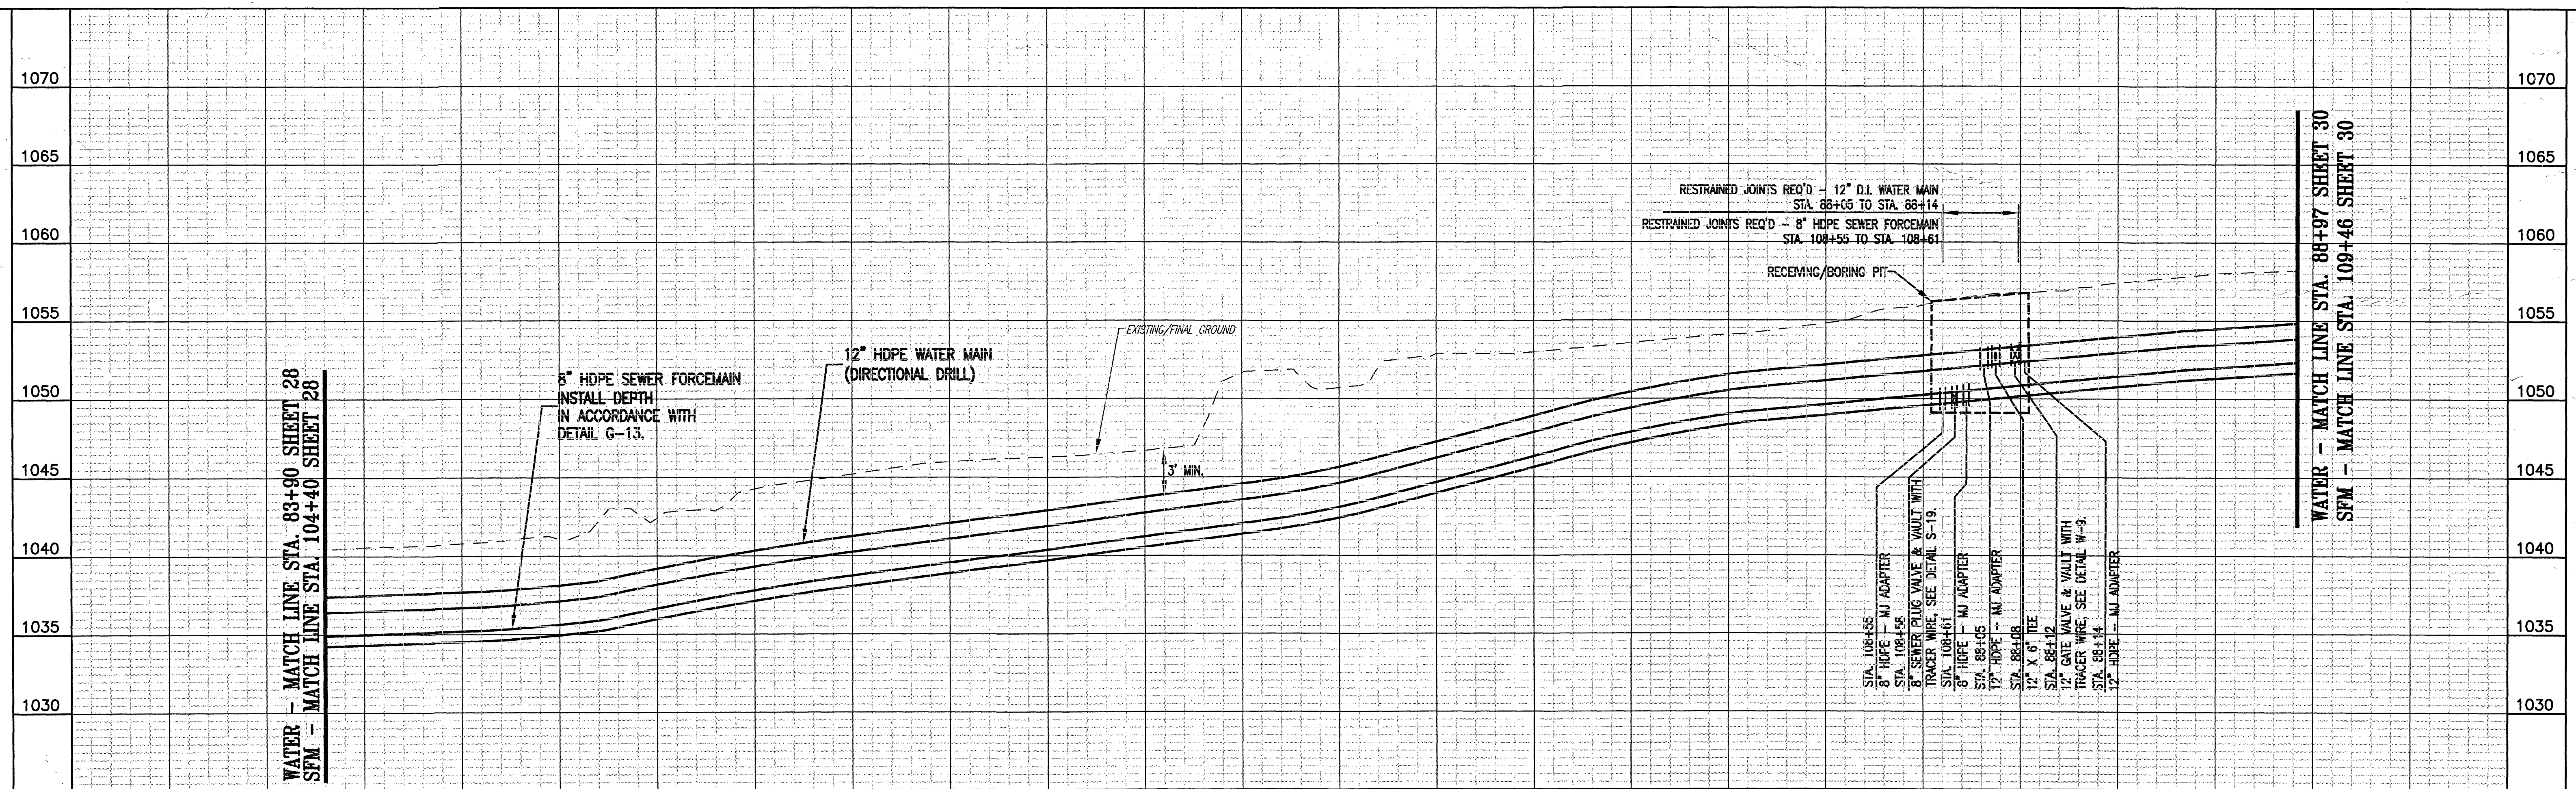




NOTE:

- ALL PIPE MATERIALS SHALL BE AS SPECIFIED ON THE PIPE SCHEDULE SHOWN ON DRAWING C1.06.

Bare Pit 1

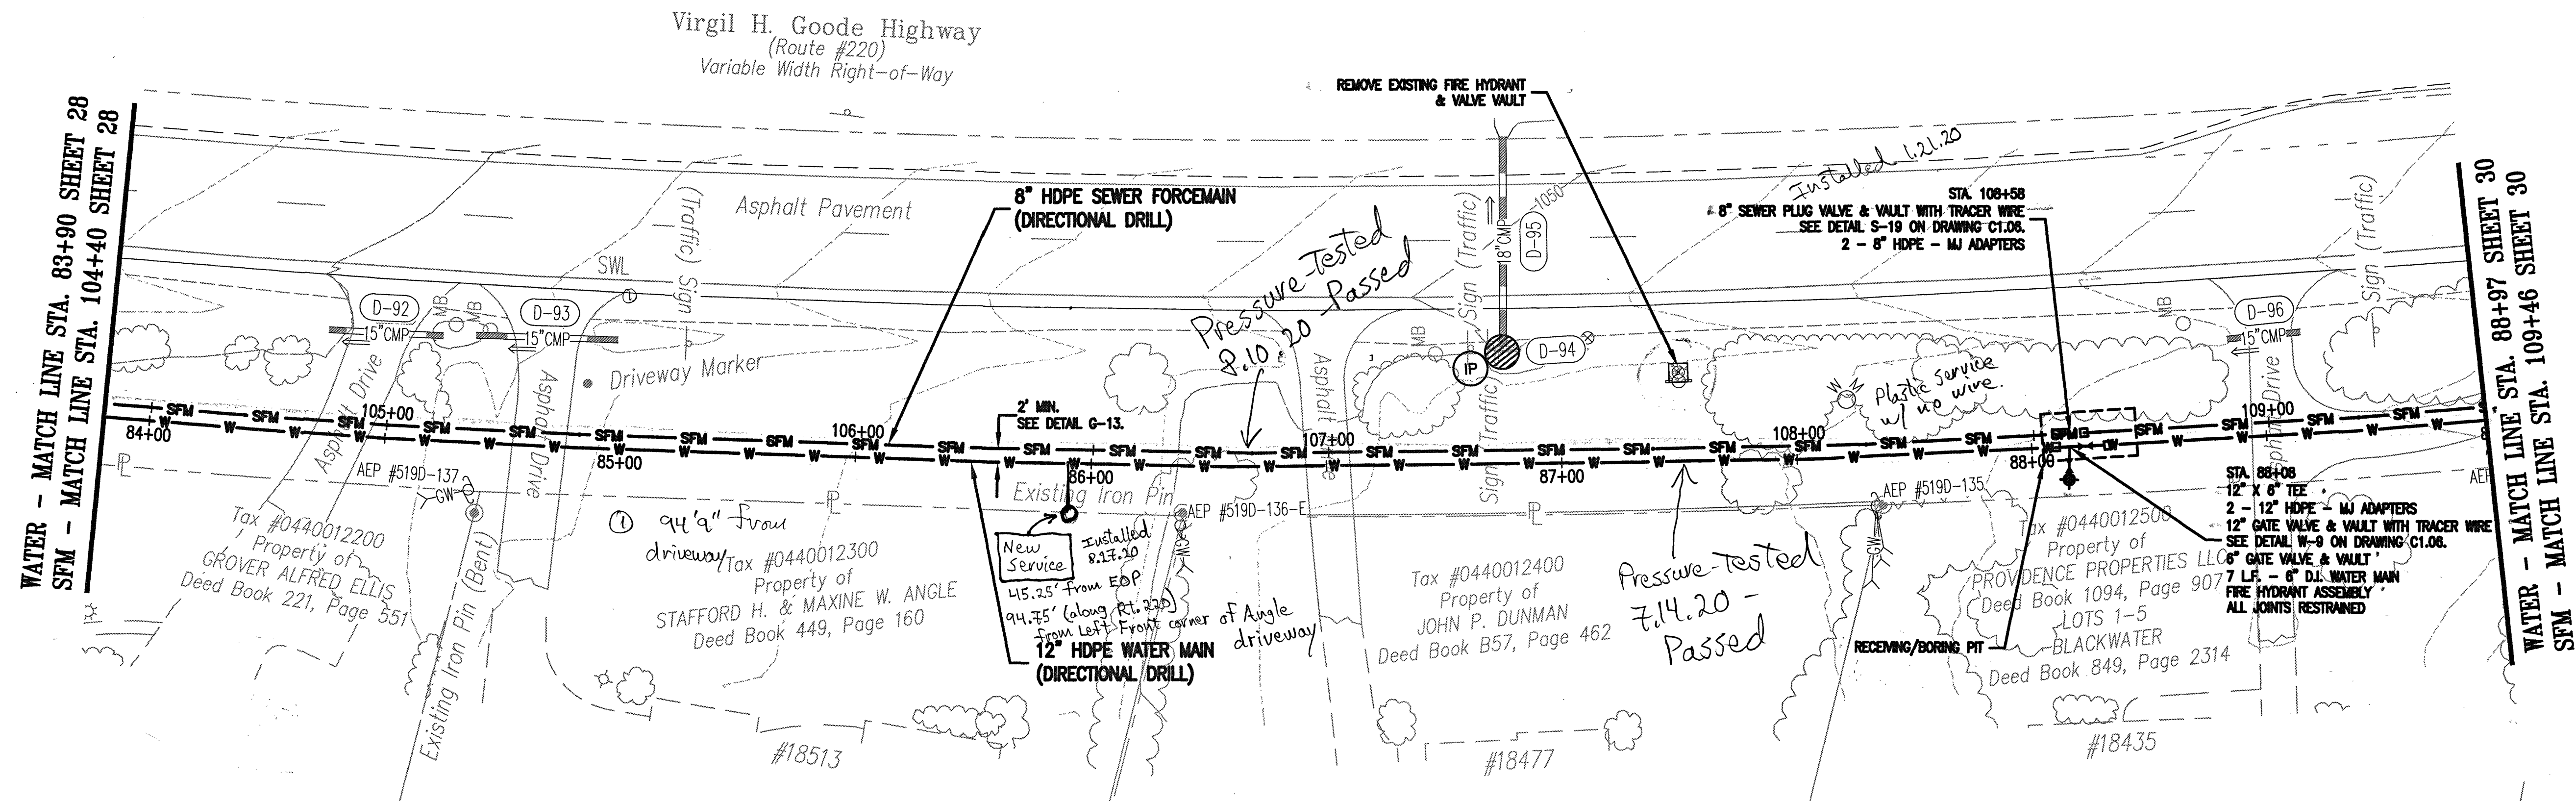

84+00 105+00 85+00 106+00 86+00 107+00 87+00 108+00 88+00 109+00

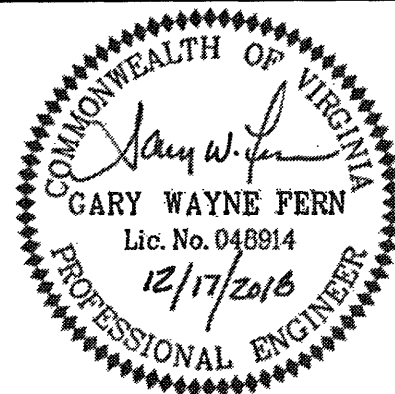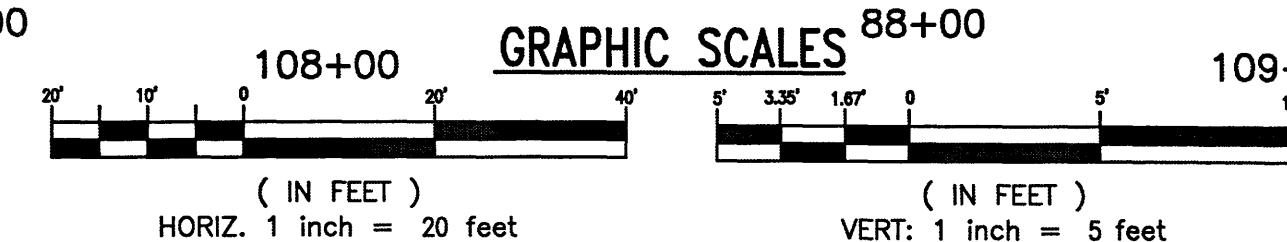

Whitman, Requardt & Associates, LLP  
1700 Kraft Dr. Suite 1200, Blacksburg, VA 24060

WESTERN VIRGINIA WATER AUTHORITY  
601 South Jefferson Street, Suite 300  
Roanoke, Virginia 24011

DES: PJM  
DRAWN: JES  
CHECK: GWF  
DATE: 12/17/18

SCALE: AS SHOWN  
HORIZ: 1" = 20'  
VERT: 1" = 5'

SUMMIT VIEW BUSINESS PARK UTILITY IMPROVEMENTS  
PHASE 2

8" SEWER FORCEMAIN PLAN - PROFILE  
STA. 104+40 TO STA. 109+46  
12" WATER MAIN PLAN - PROFILE  
STA. 83+90 TO STA. 88+97

DRAWING  
C1.26

SHEET  
29