


NOTE:

1. ALL PIPE MATERIALS SHALL BE AS SPECIFIED ON THE PIPE SCHEDULE SHOWN ON DRAWING C1.06.

Town of Rocky Mount: (Water) 1-8" Plug Valve, 2-MJ Adapters, 1-Boring Pit

Total Boring Pits 2

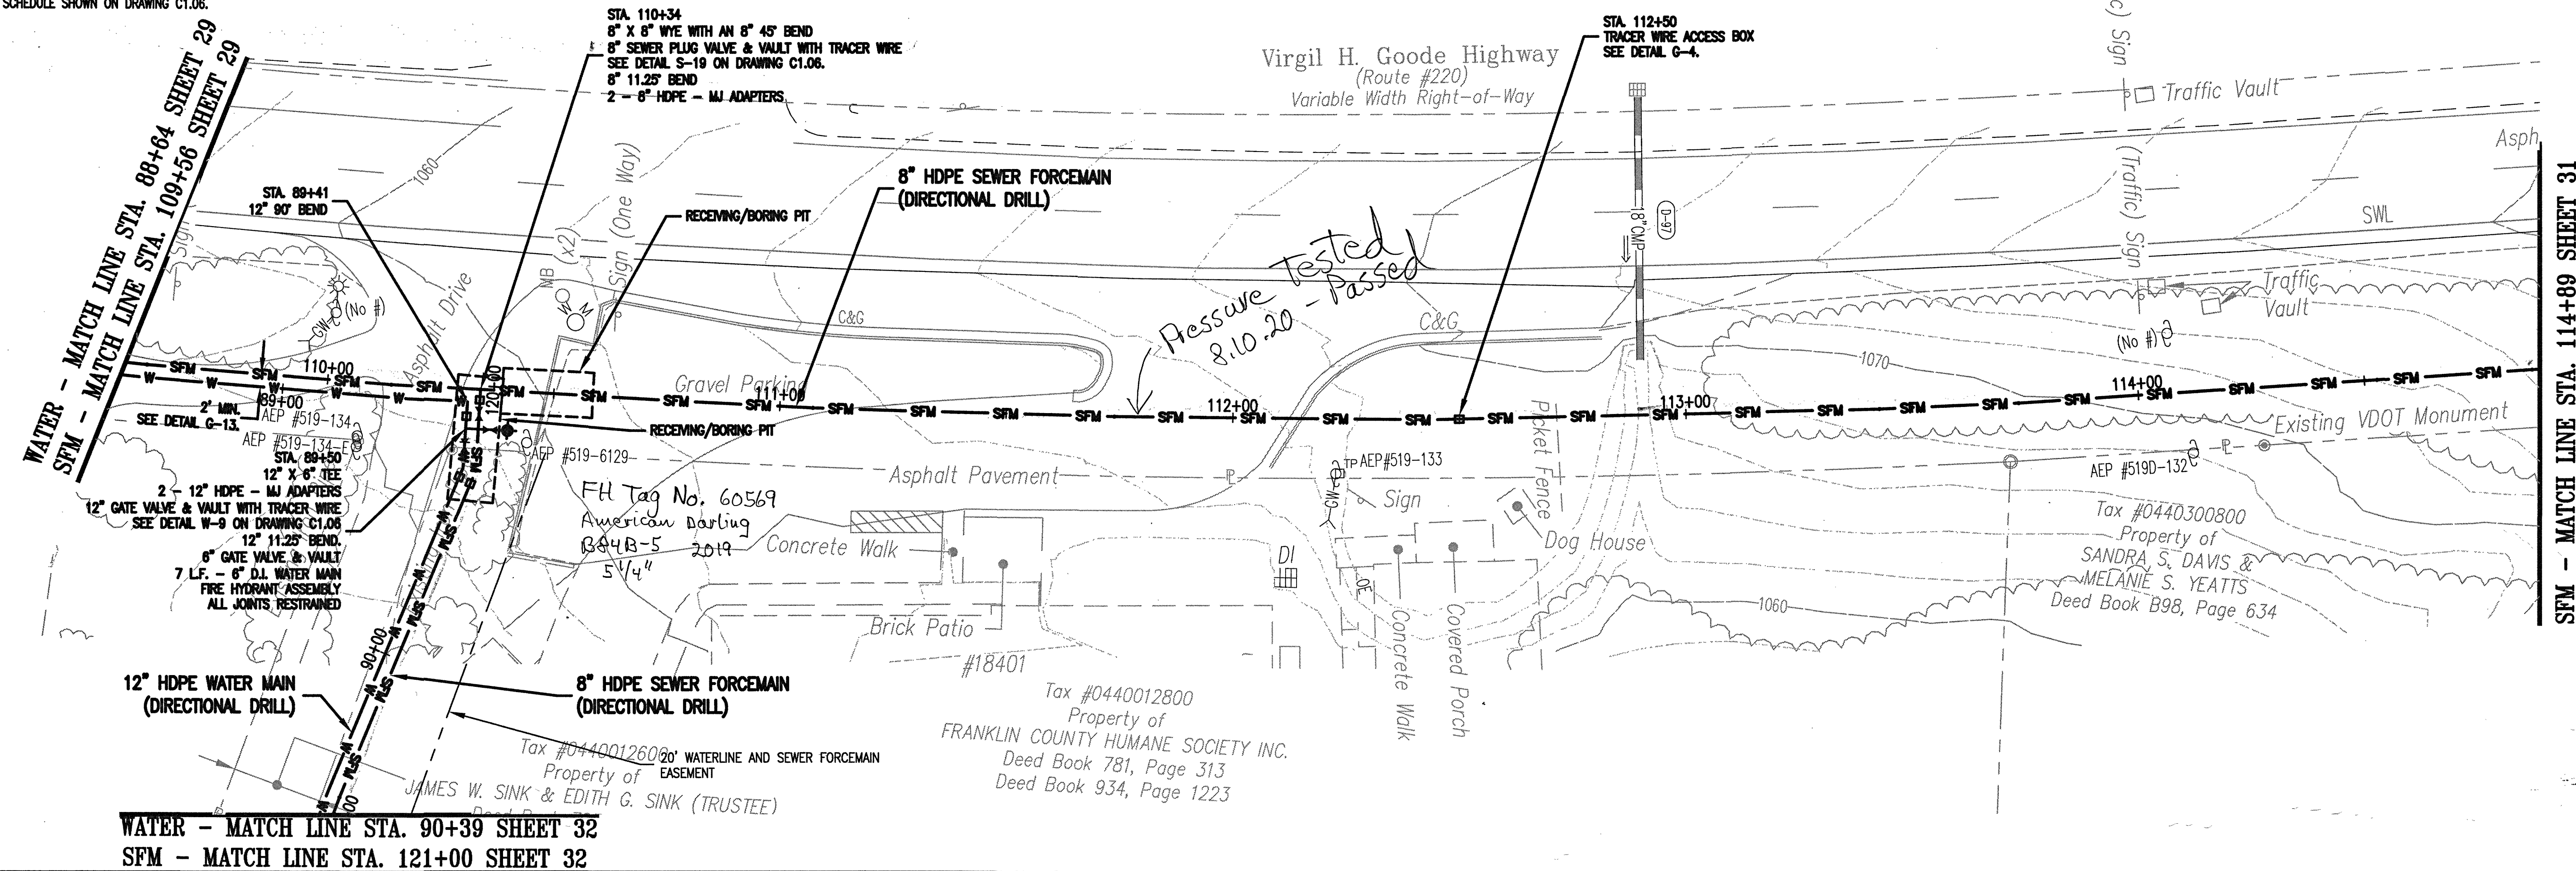

1085

1085

1080

1080

1075

1075

1070

1070

1065

1065

1060

1060

1055


1055

1050

1050

1045

1045

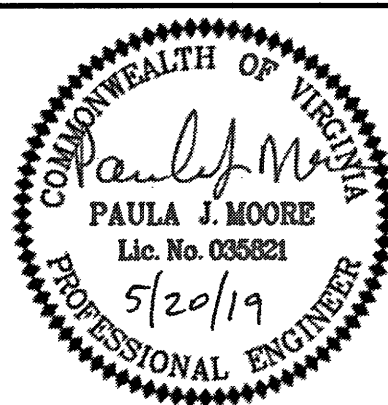

WESTERN VIRGINIA WATER AUTHORITY
601 South Jefferson Street, Suite 300
Roanoke, Virginia 24011

DES: PJM
DRAWN: JES
CHECK: GWF
DATE: 5/20/19

SCALE: AS SHOWN
HORIZ: 1" = 20'
VERT: 1" = 5'


SUMMIT VIEW BUSINESS PARK UTILITY IMPROVEMENTS
PHASE 2

8" SEWER FORCEMAIN PLAN - PROFILE
STA. 109+56 TO STA. 114+89
12" WATER MAIN PLAN - PROFILE
STA. 88+64 TO STA. 90+39

DRAWING
C1.27

SHEET
30

GRAPHIC SCALES

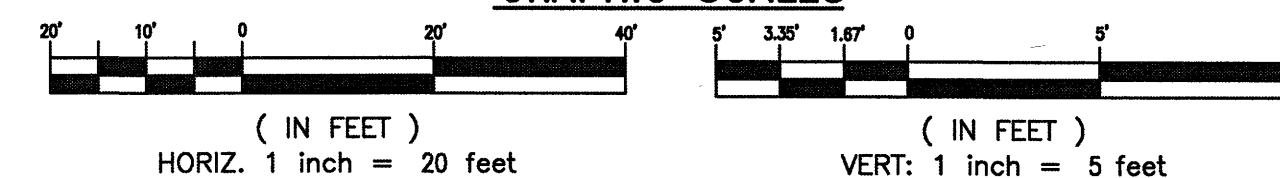

REV	DATE	DESCRIPTION
-----	------	-------------

As-Builts 10.9.20 K. Winslow