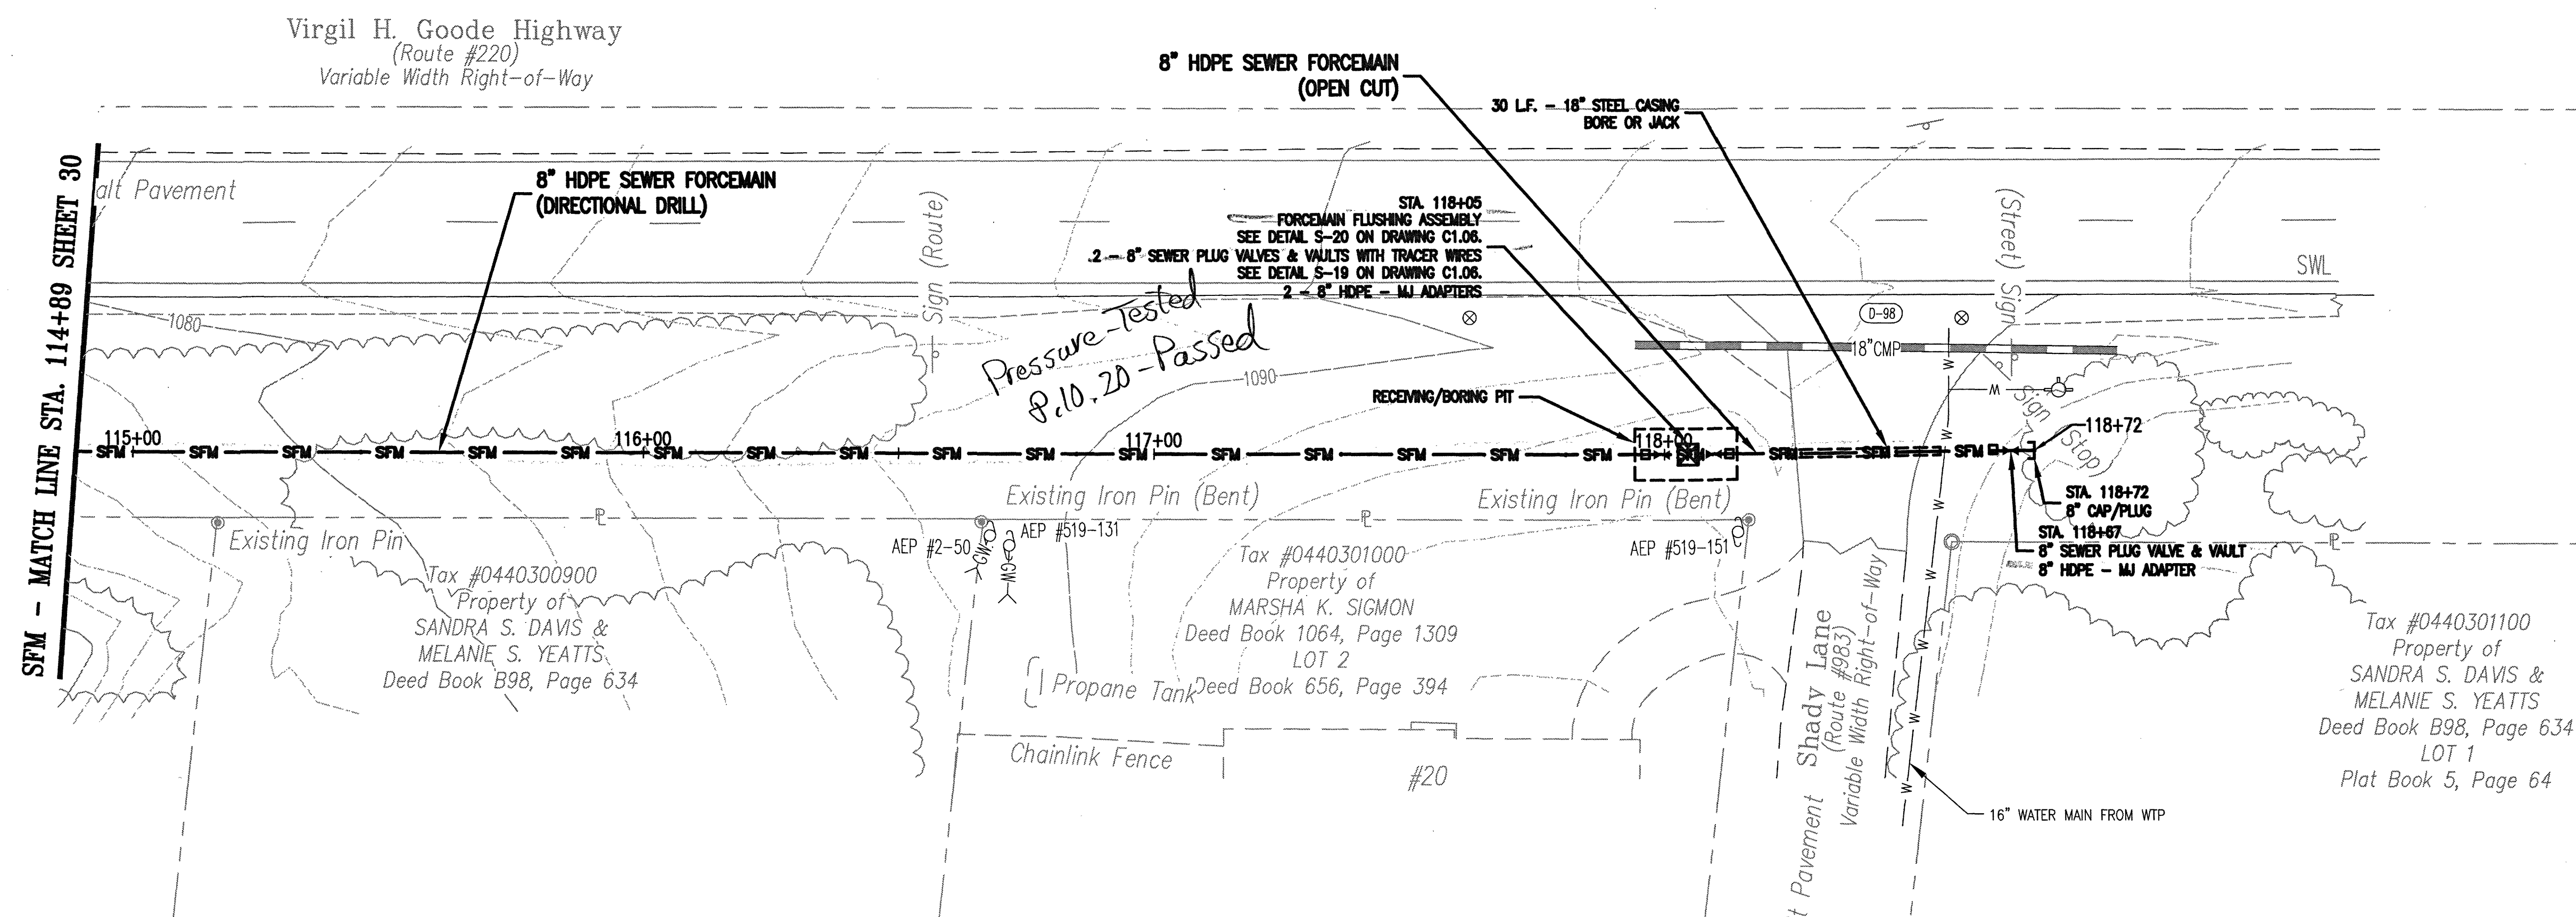
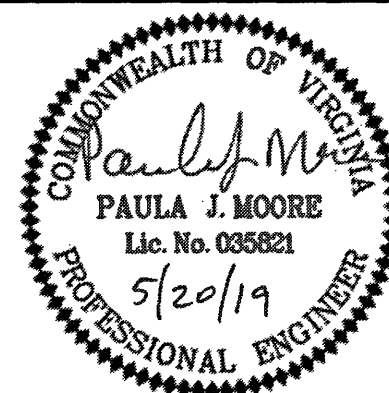


1. ALL PIPE MATERIALS SHALL BE AS SPECIFIED ON THE PIPE SCHEDULE SHOWN ON DRAWING C1.06.

[illegible]

Whitman, Requardt & Associates, LLP
1700 Kraft Dr. Suite 1200, Blacksburg, VA 24060

WESTERN VIRGINIA WATER AUTHORITY
601 South Jefferson Street, Suite 300
Roanoke, Virginia 24011

DES:	PJM
DRAWN:	JES
CHECK:	GWF
DATE:	5/20/19

SCALE:	AS SHOWN
HORIZ:	1" = 20'
VERT:	1" = 5'


SUMMIT VIEW BUSINESS PARK UTILITY IMPROVEMENTS
PHASE 2

8" SEWER FORCEMAIN PLAN - PROFILE
STA. 114+89 TO STA. 118+72

DRAWING

C1.28

SHEET
31

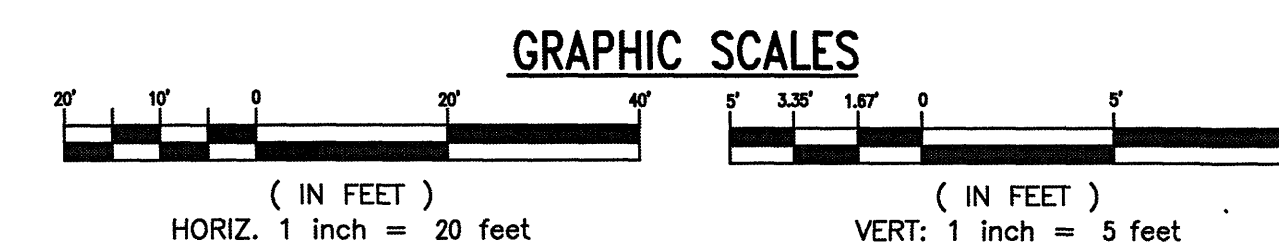

REV	DATE	DESCRIPTION