

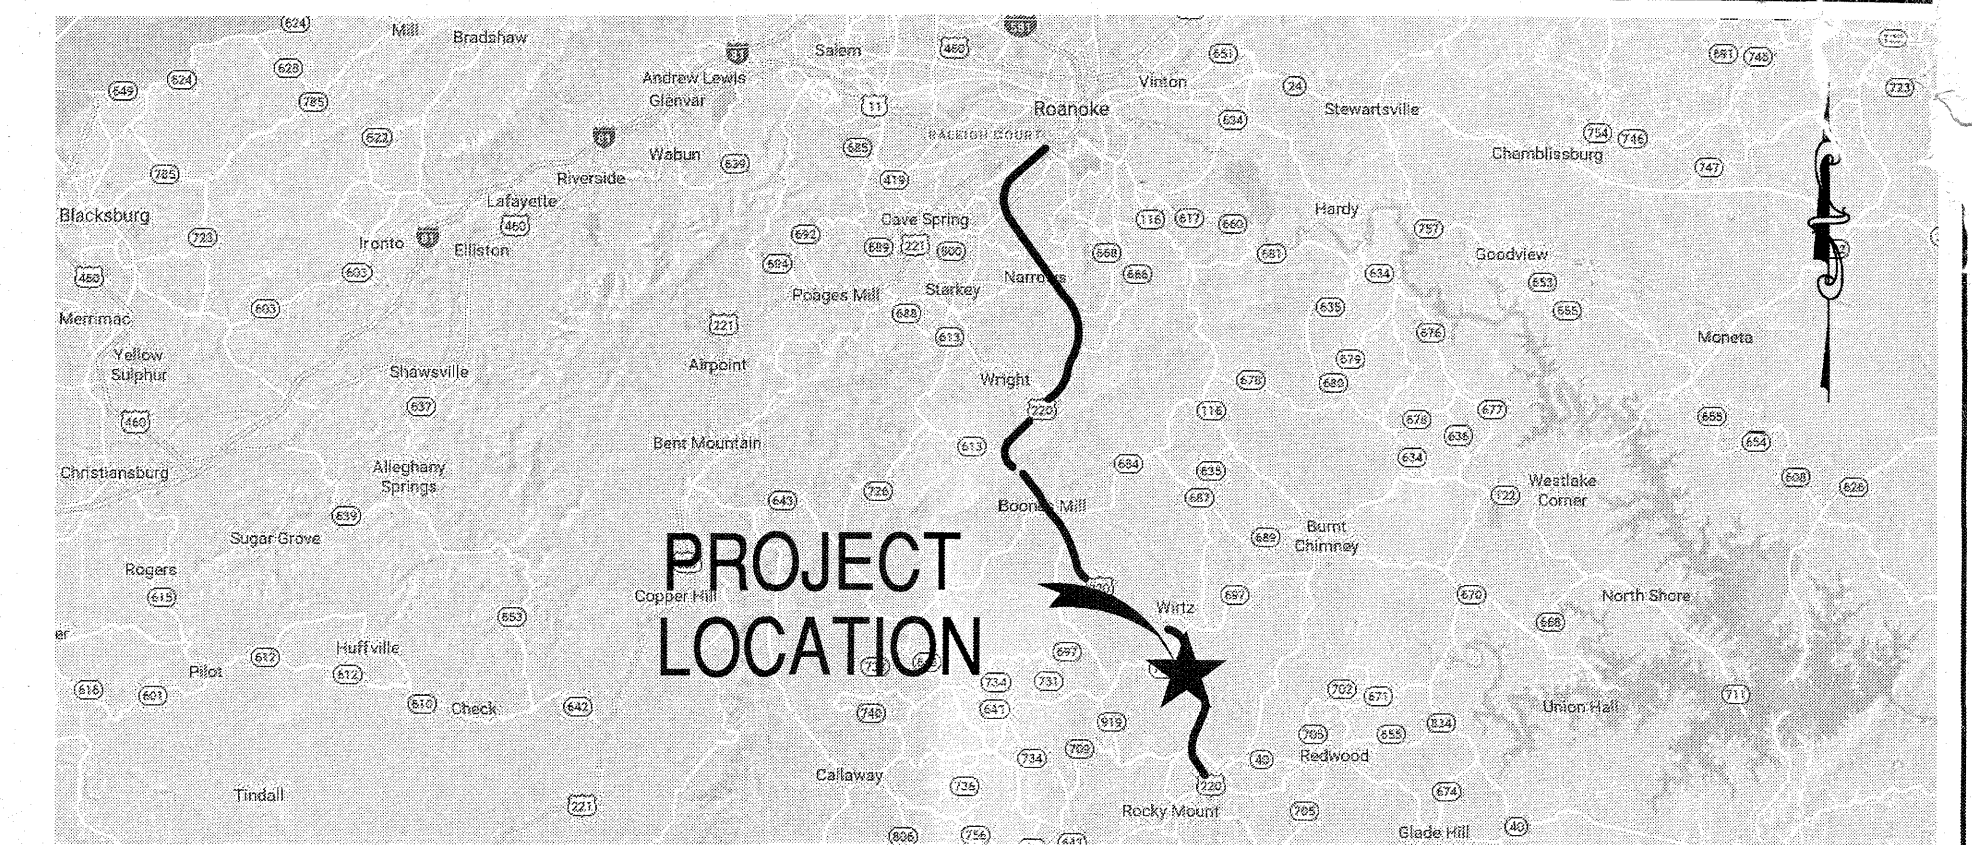


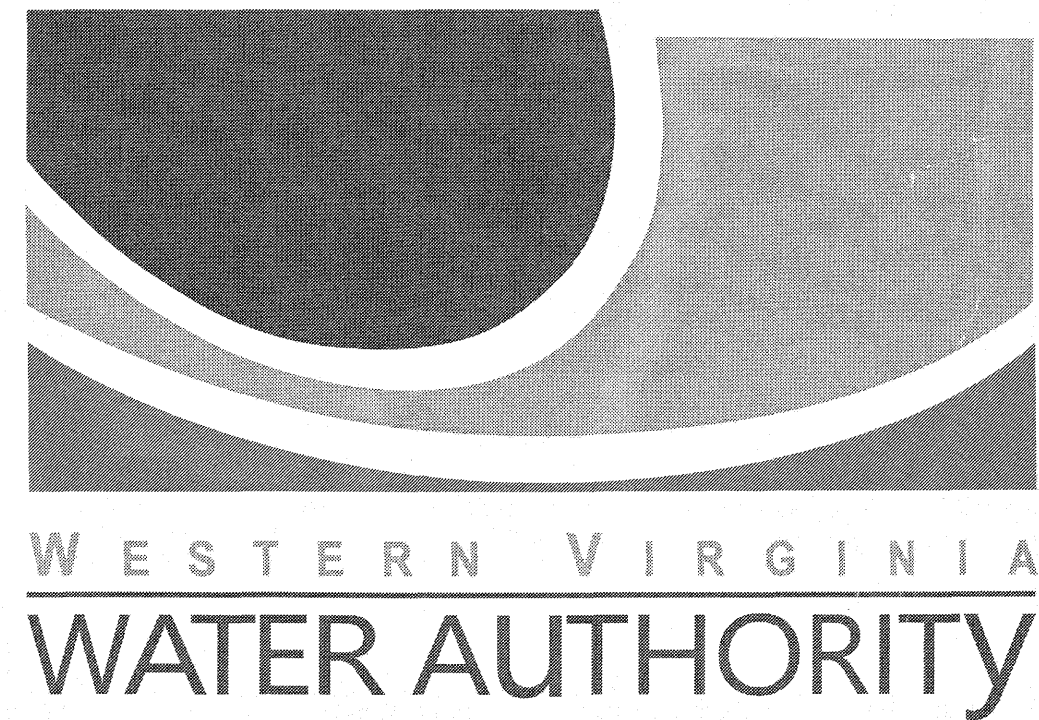

LOCATION MAP
NO SCALE


WESTERN VIRGINIA WATER AUTHORITY SUMMIT VIEW BUSINESS PARK UTILITY IMPROVEMENTS PHASE 2

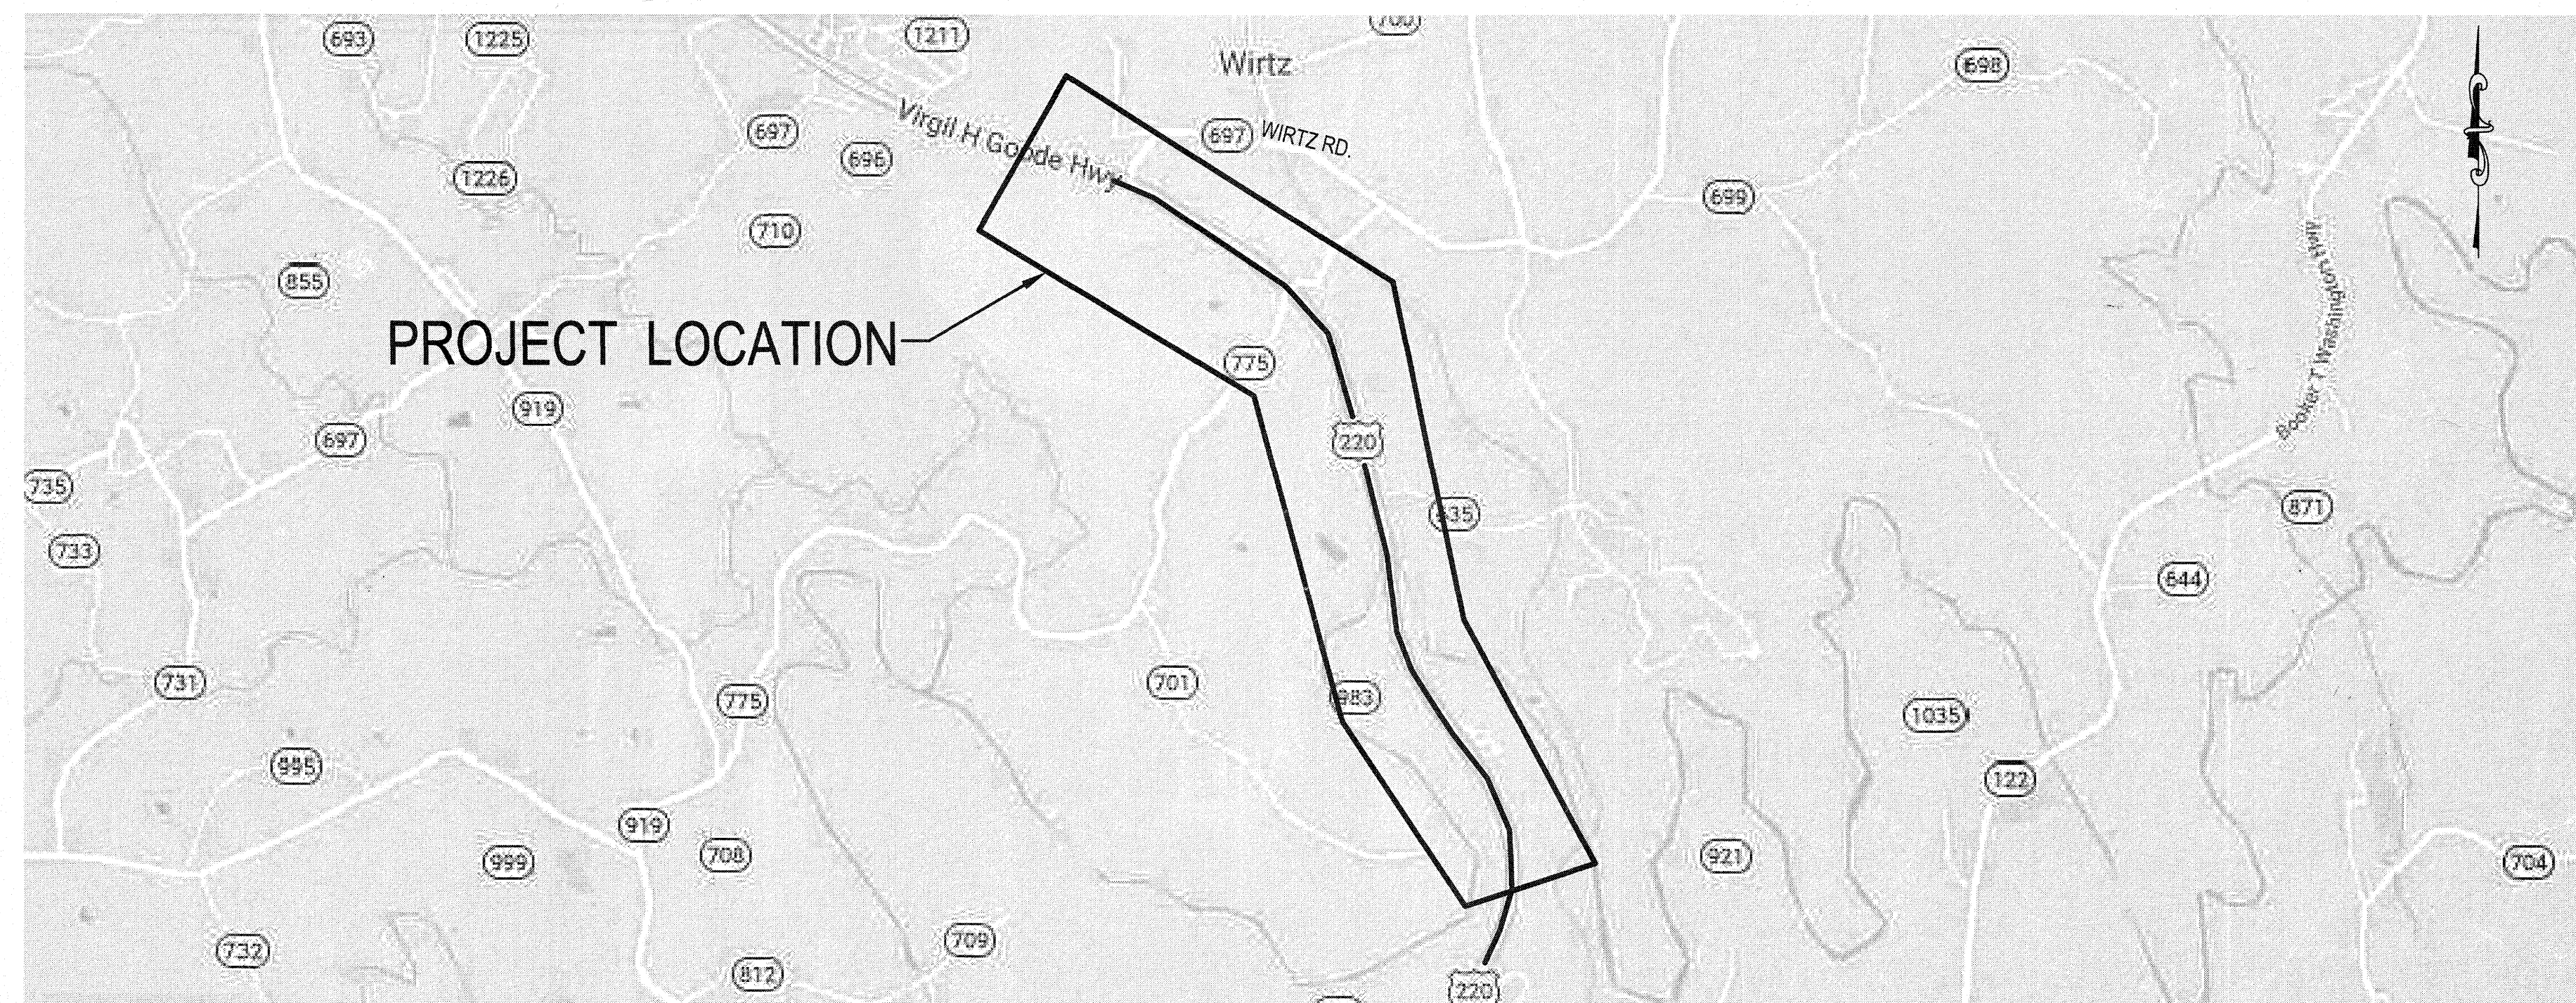

VICINITY MAP
NO SCALE

DECEMBER 2018

Sewer Info:
F&Gs: US Foundry Clow
8" Plug Valves - ARD 11 Turns to close, CCW to open
MH - CSI

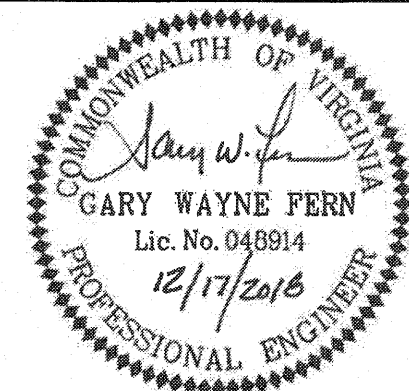

WESTERN VIRGINIA WATER AUTHORITY
601 South Jefferson Street, Suite 300
Roanoke, Virginia 24011

DES: PJM
DRAWN: JBS
CHECK: GWF
DATE: 12/17/18
SCALE: N/A
HORIZ: N/A
VERT: N/A

SUMMIT VIEW BUSINESS PARK UTILITY IMPROVEMENTS
PHASE 2

APPROVED FOR CONSTRUCTION

COVER

DRAWING
G0.01
SHEET
1

As-Builts 10.9.20 K. Winslow

Summit View B.P. Utility Improvements Ph. 2 (12.18 Revision)