
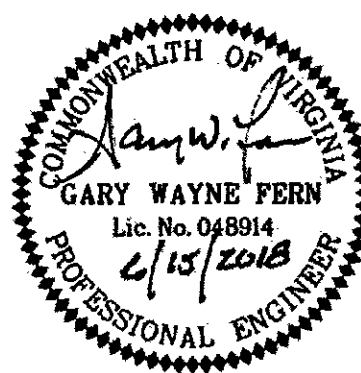
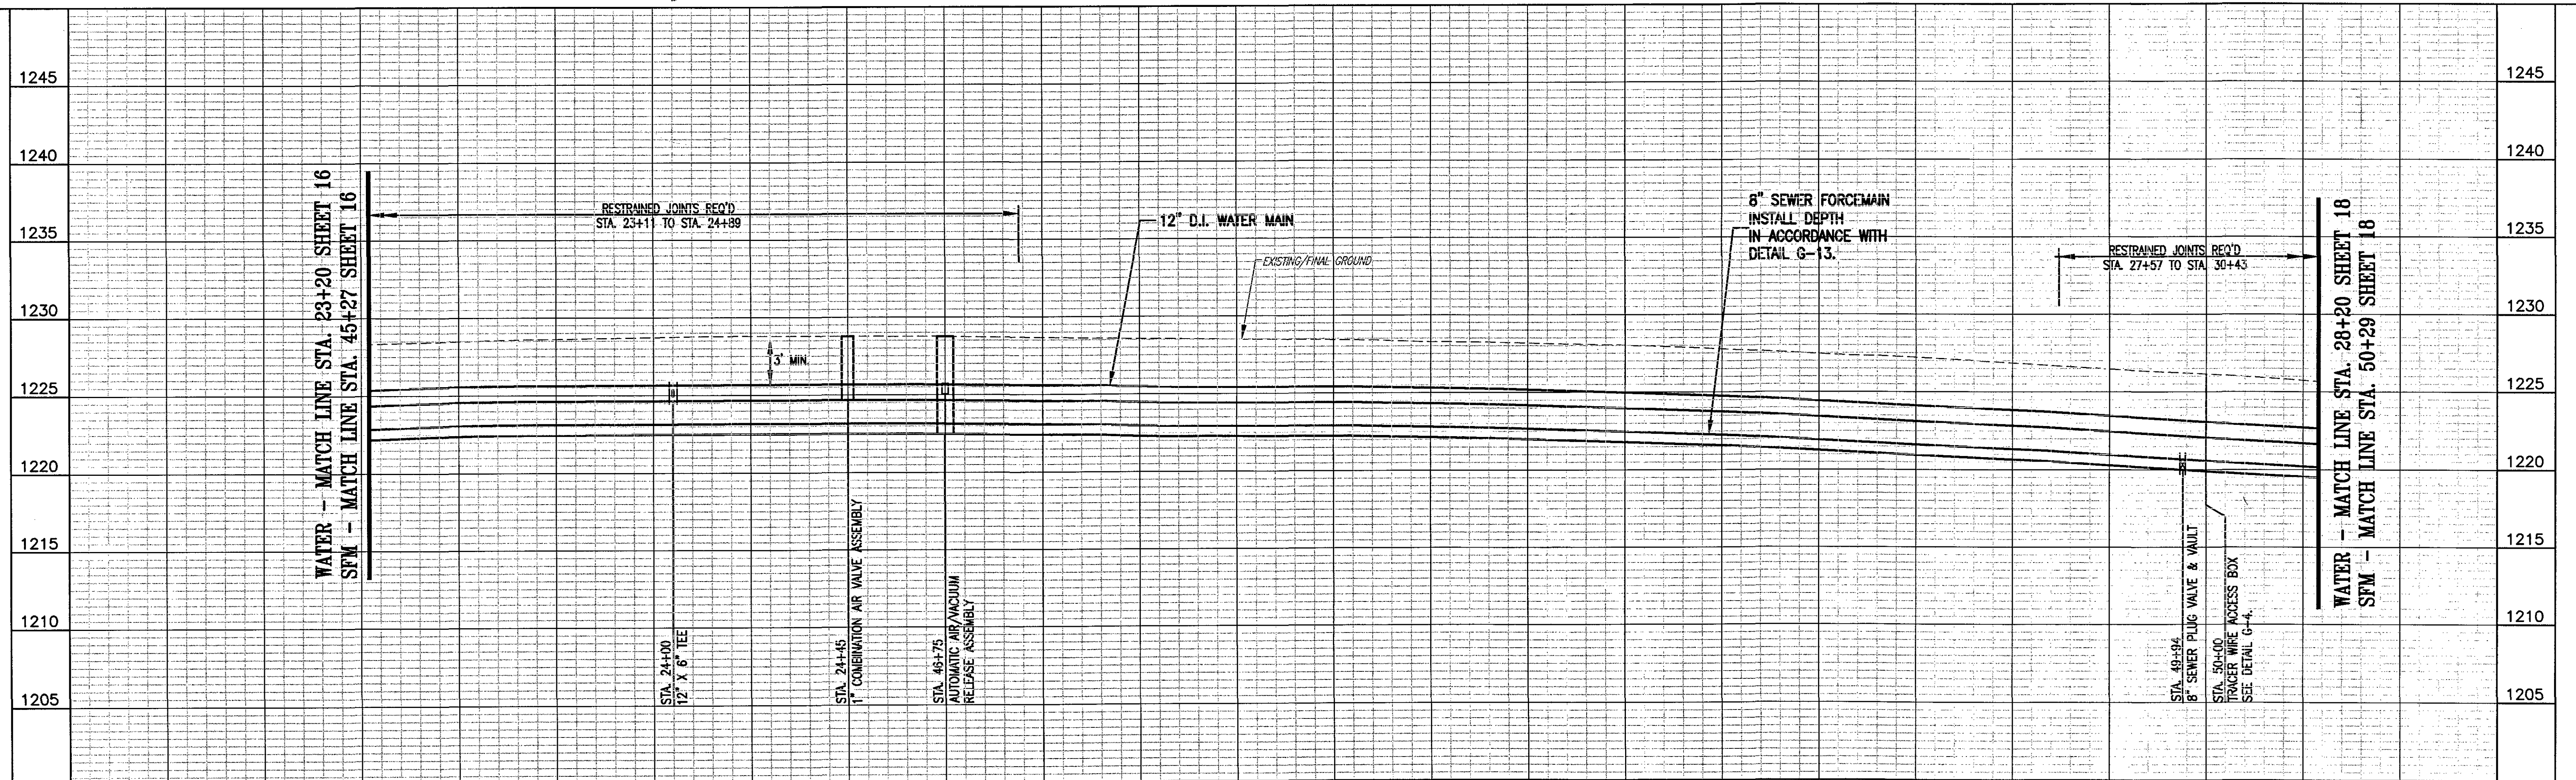


NOTE:

- ALL PIPE MATERIALS SHALL BE AS SPECIFIED ON THE PIPE SCHEDULE SHOWN ON DRAWING C1.08.

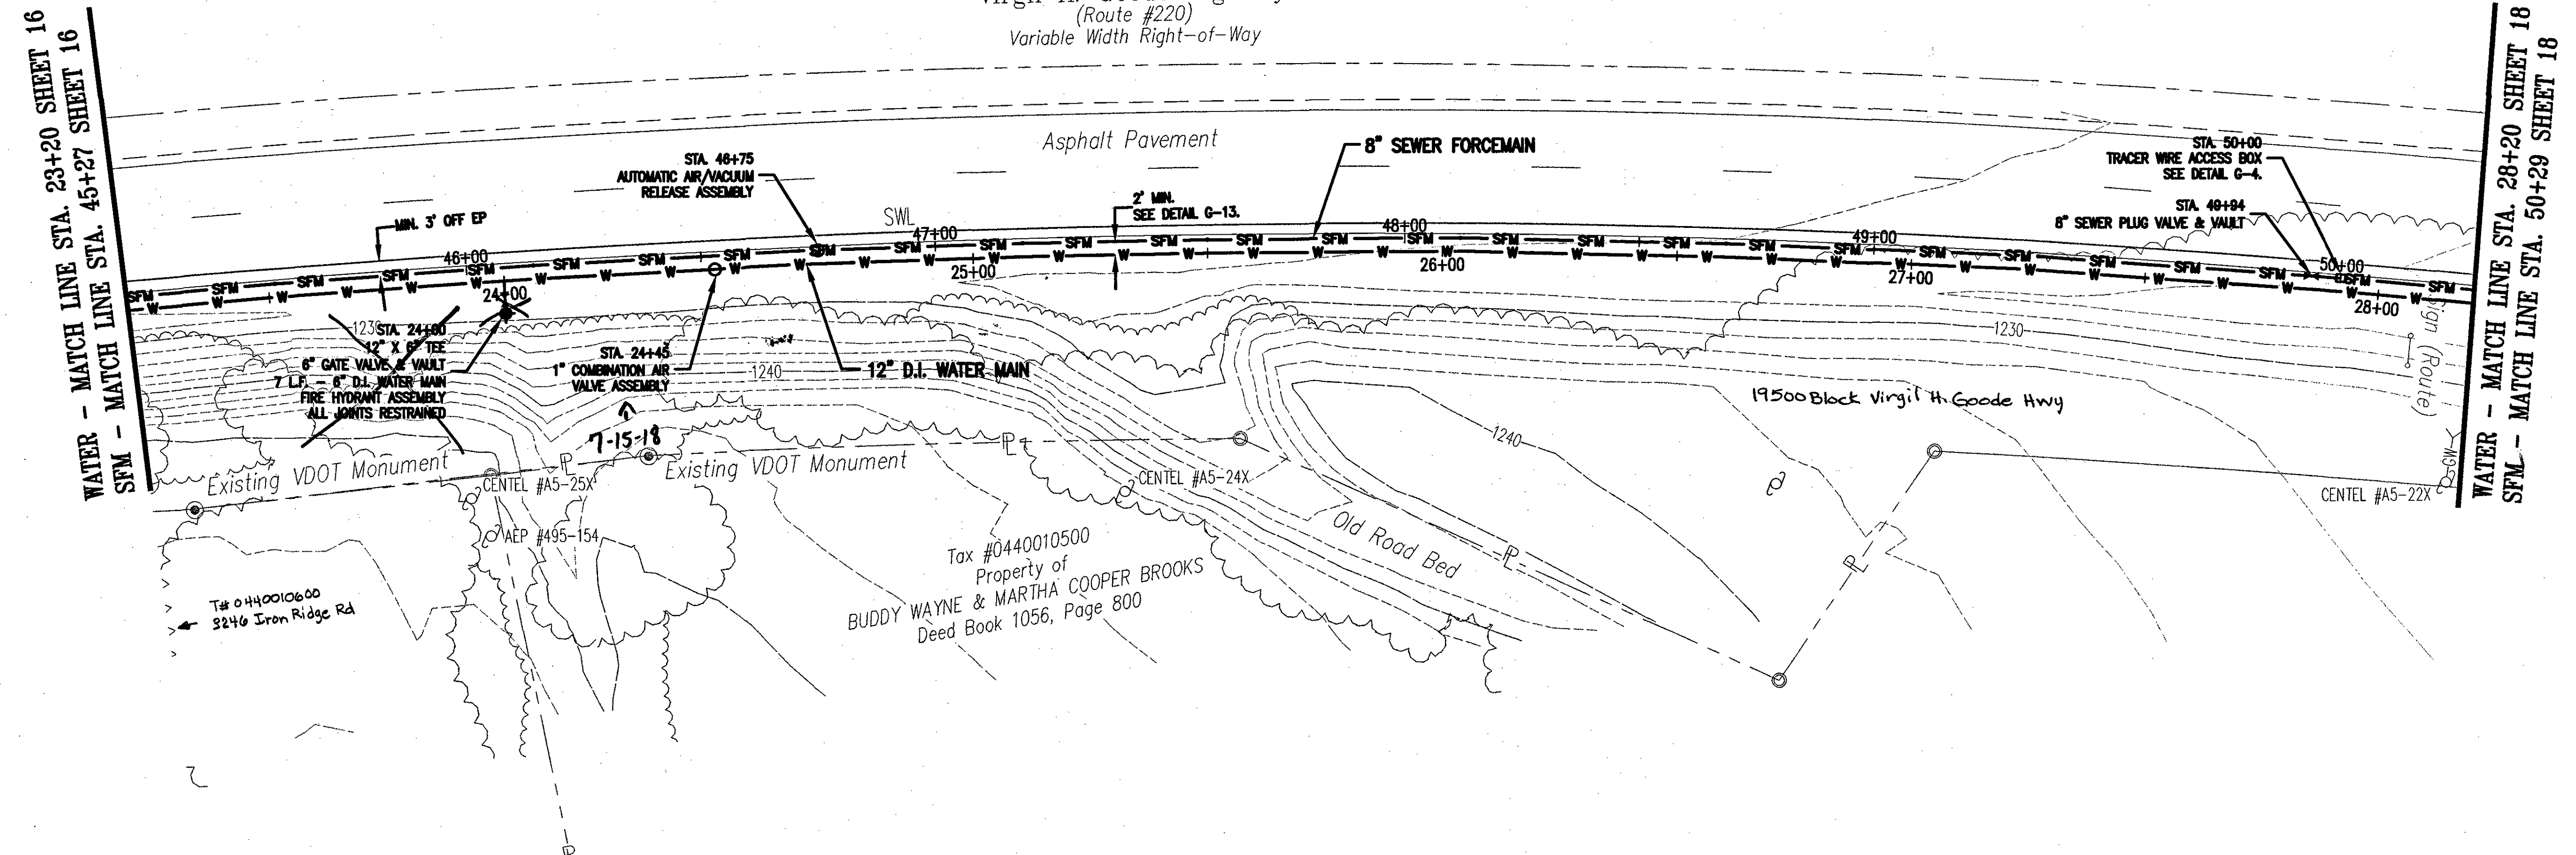

WESTERN VIRGINIA WATER AUTHORITY
601 South Jefferson Street, Suite 300
Roanoke, Virginia 24011

DES: KN
DRAWN: JES
CHECK: GWF
DATE: 06/15/18

SCALE: AS SHOWN
HORIZ: 1" = 20'
VERT: 1" = 5'

SUMMIT VIEW BUSINESS PARK UTILITY IMPROVEMENTS
PHASE 2

WATER ONLY INSTALLED

8" SEWER FORCEMAIN PLAN - PROFILE
STA. 45+27 TO STA. 50+29
12" WATER MAIN PLAN - PROFILE
STA. 23+20 TO STA. 28+20

DRAWING
C1.14

SHEET
17