

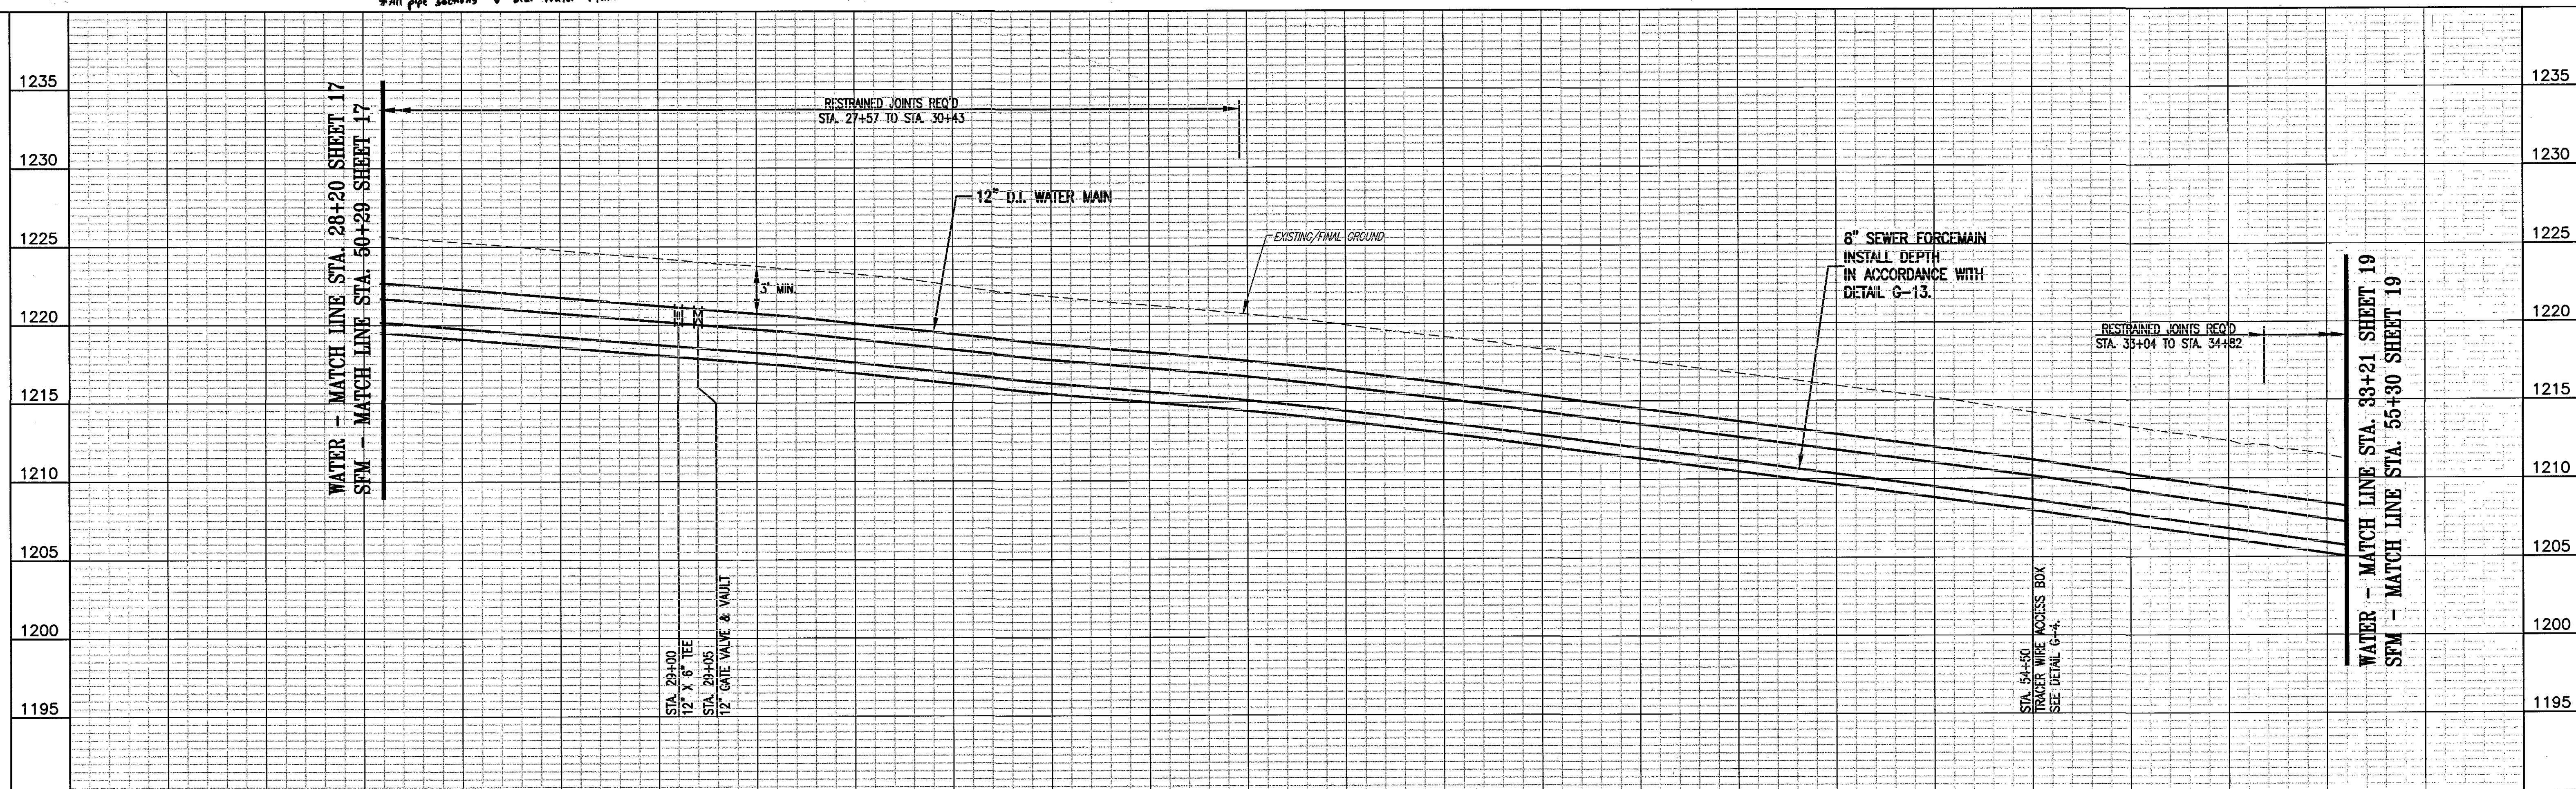
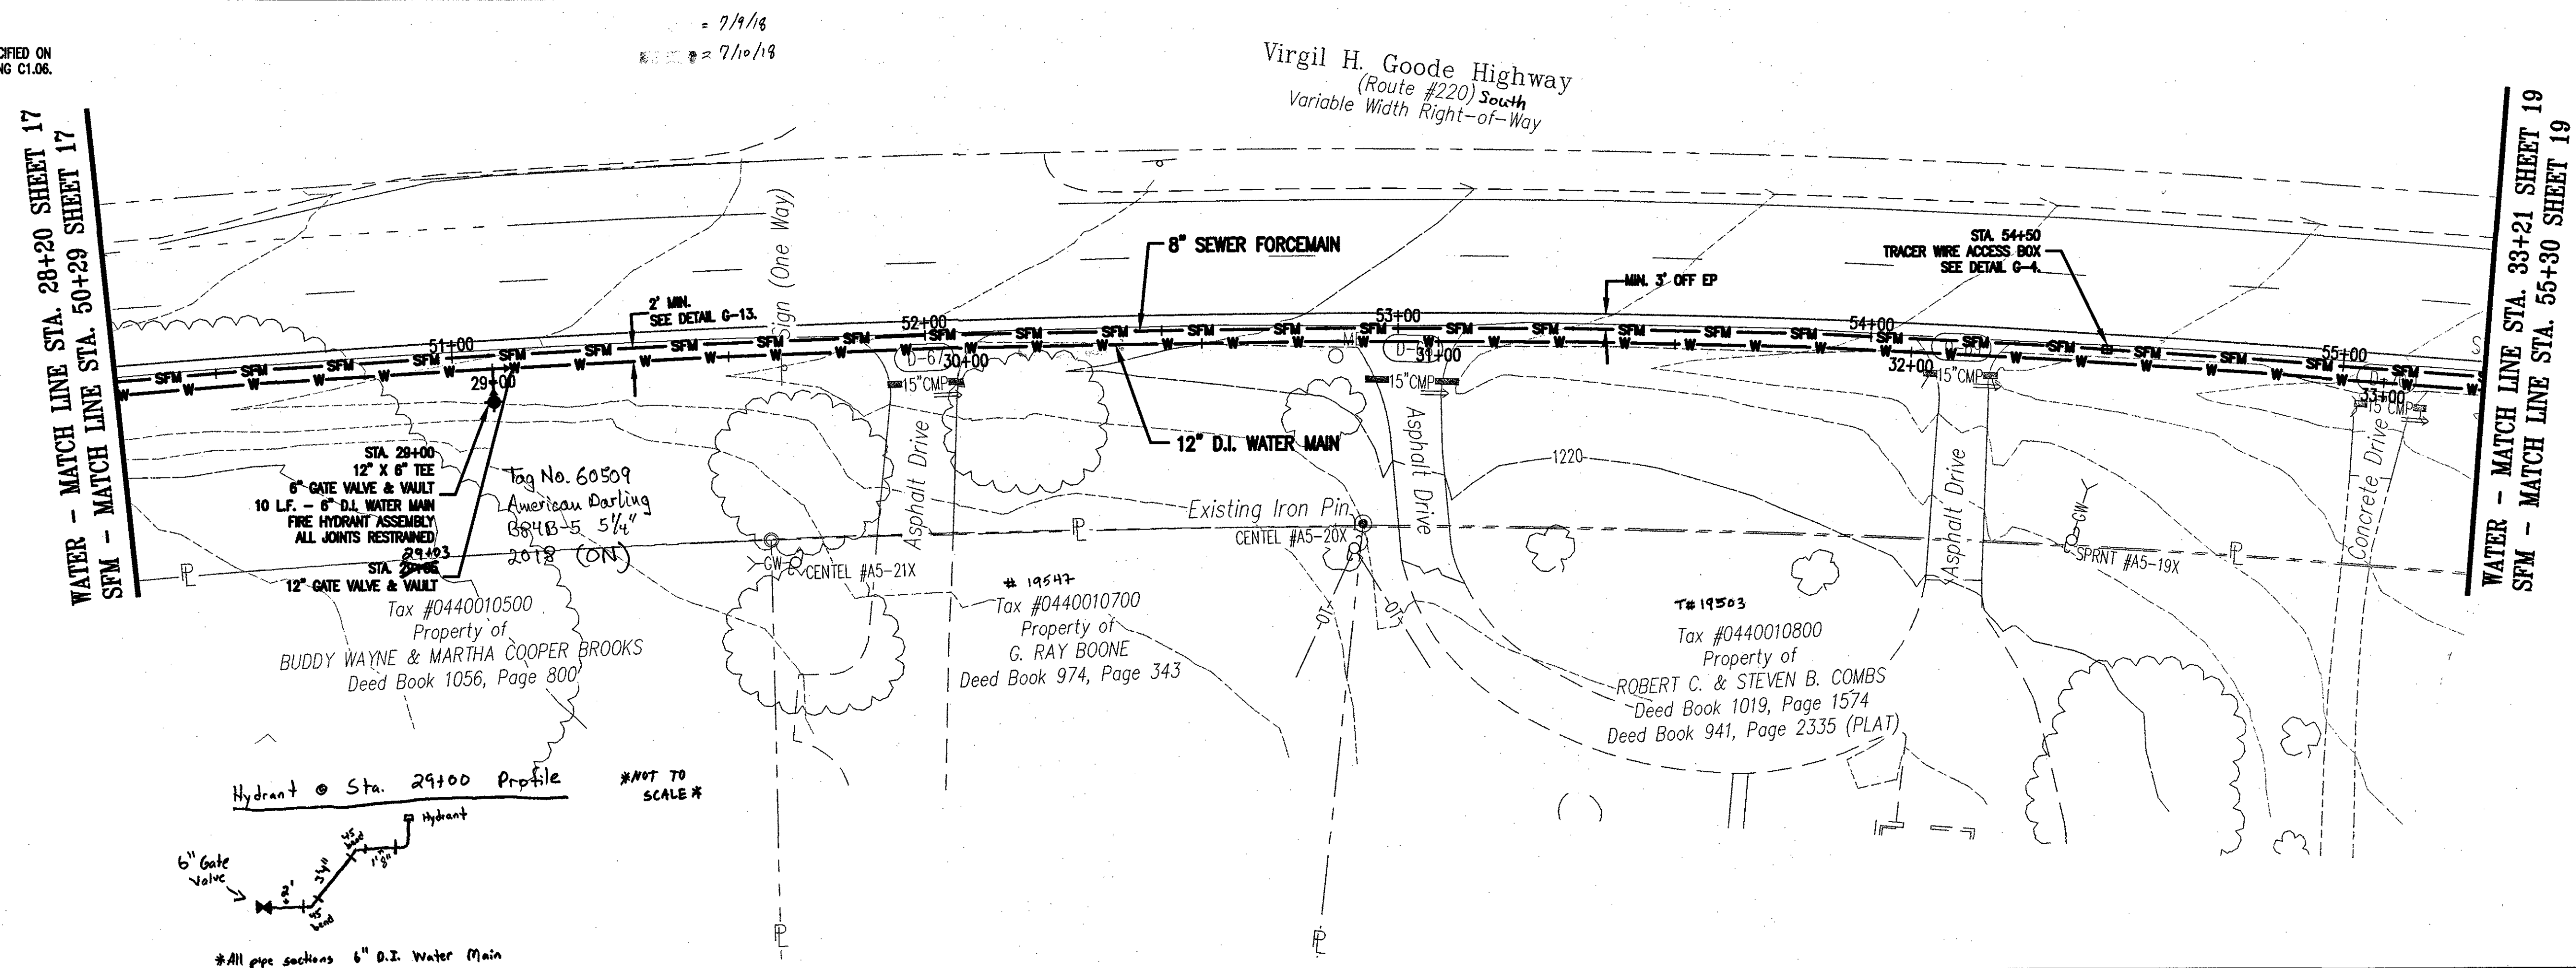


NOTE:

1. ALL PIPE MATERIALS SHALL BE AS SPECIFIED ON THE PIPE SCHEDULE SHOWN ON DRAWING C1.08.

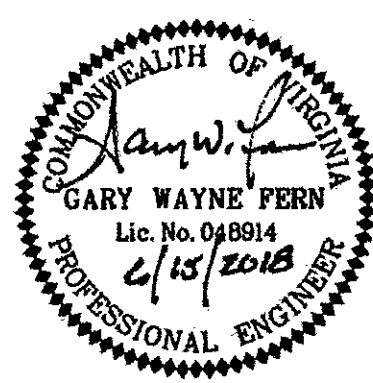

29+00 51+00 30+00 52+00 31+00 53+00 32+00 54+00 33+00 55+00

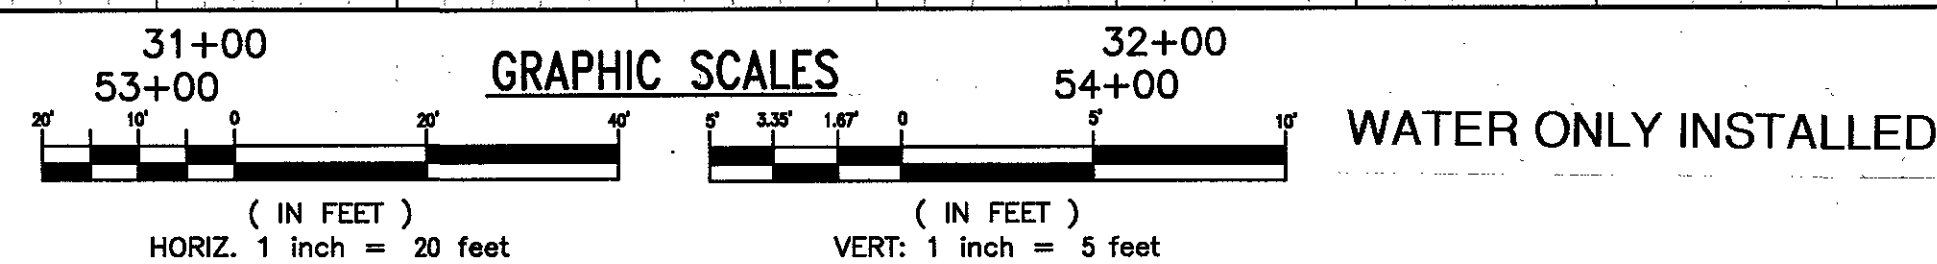

WESTERN VIRGINIA WATER AUTHORITY
601 South Jefferson Street, Suite 300
Roanoke, Virginia 24011

DES: KN
DRAWN: JES
CHECK: GWP
DATE: 06/15/18

SCALE: AS SHOWN
HORIZ: 1" = 20'
VERT: 1" = 5'

SUMMIT VIEW BUSINESS PARK UTILITY IMPROVEMENTS
PHASE 2

8" SEWER FORCEMAIN PLAN - PROFILE
STA. 50+29 TO STA. 55+30
12" WATER MAIN PLAN - PROFILE
STA. 28+20 TO STA. 33+21

DRAWING
C1.15

SHEET
18