
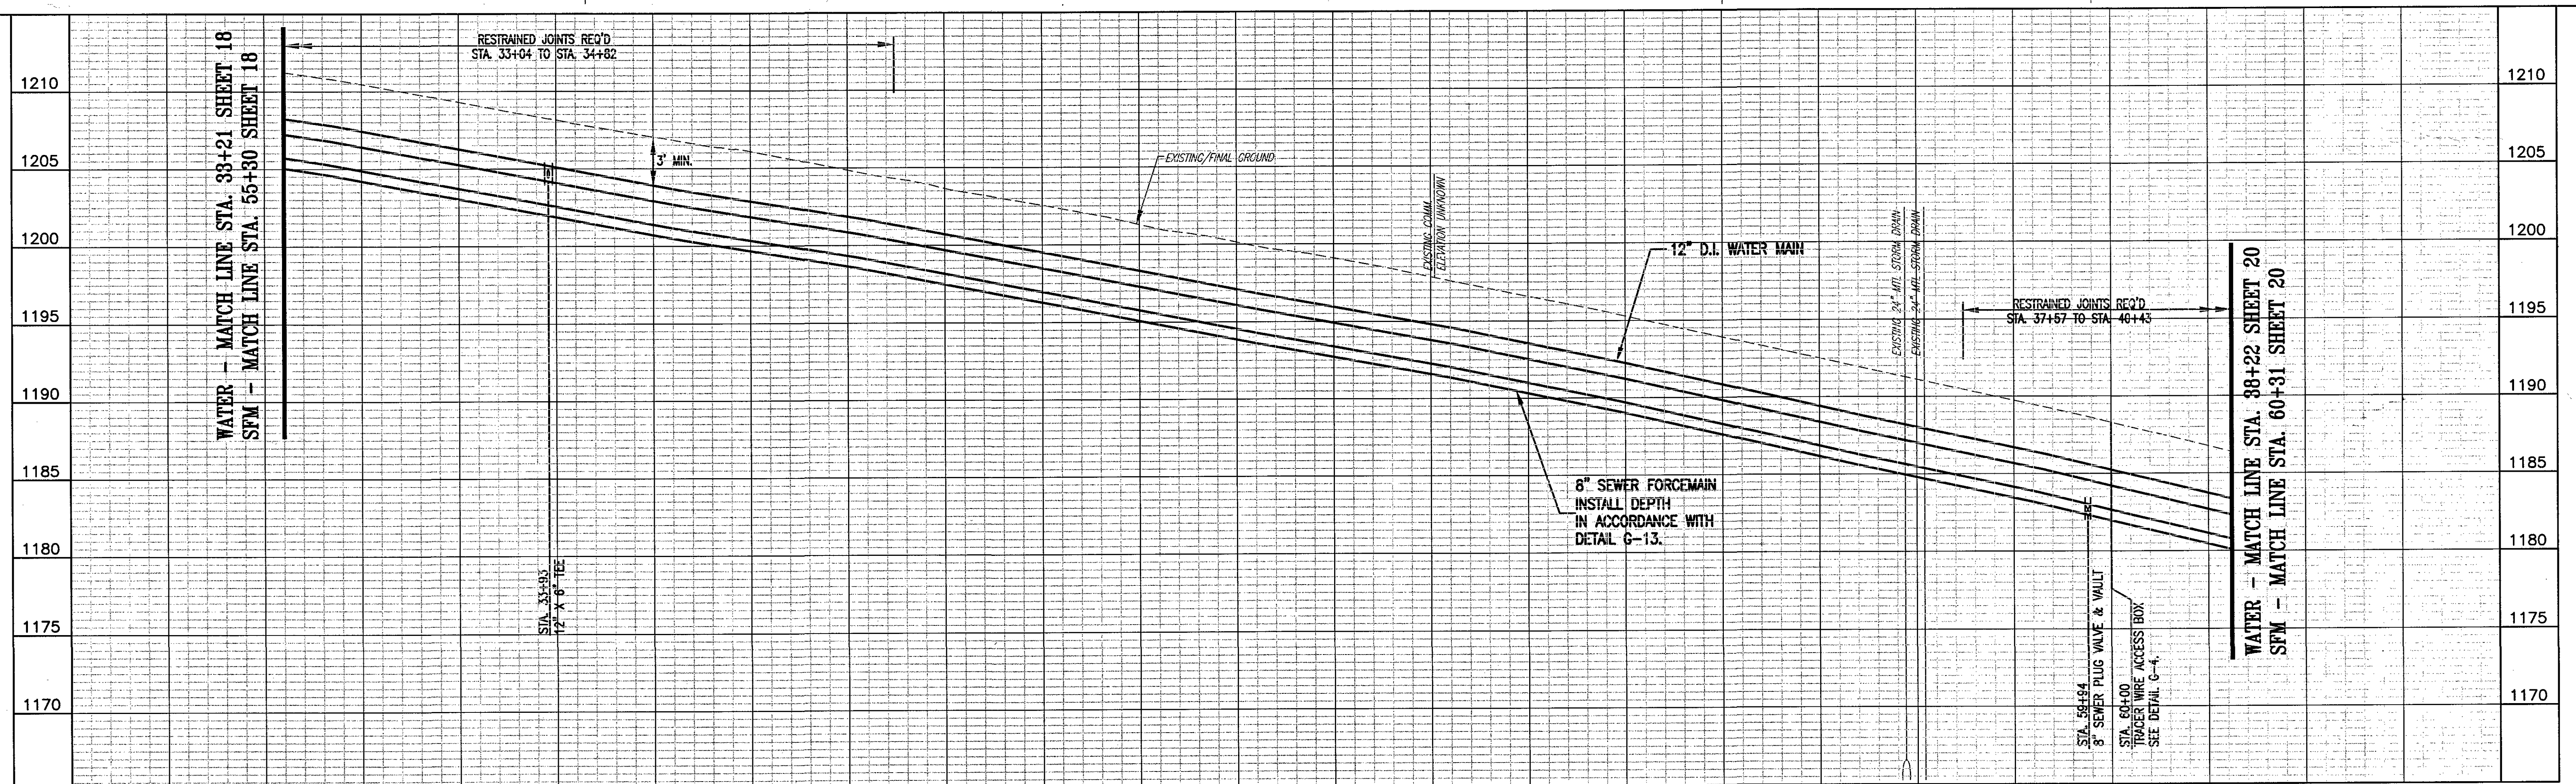




NOTE:

- ALL PIPE MATERIALS SHALL BE AS SPECIFIED ON THE PIPE SCHEDULE SHOWN ON DRAWING C1.06.
- IN THE EVENT CONTRACTOR DAMAGES EXISTING PAVEMENT, CONTRACTOR SHALL MILL AND RE-PAVE WITH SURFACE MIX (1.5-INCH DEEP) ONE LANE OF ROADWAY AT NO COST TO THE OWNER.

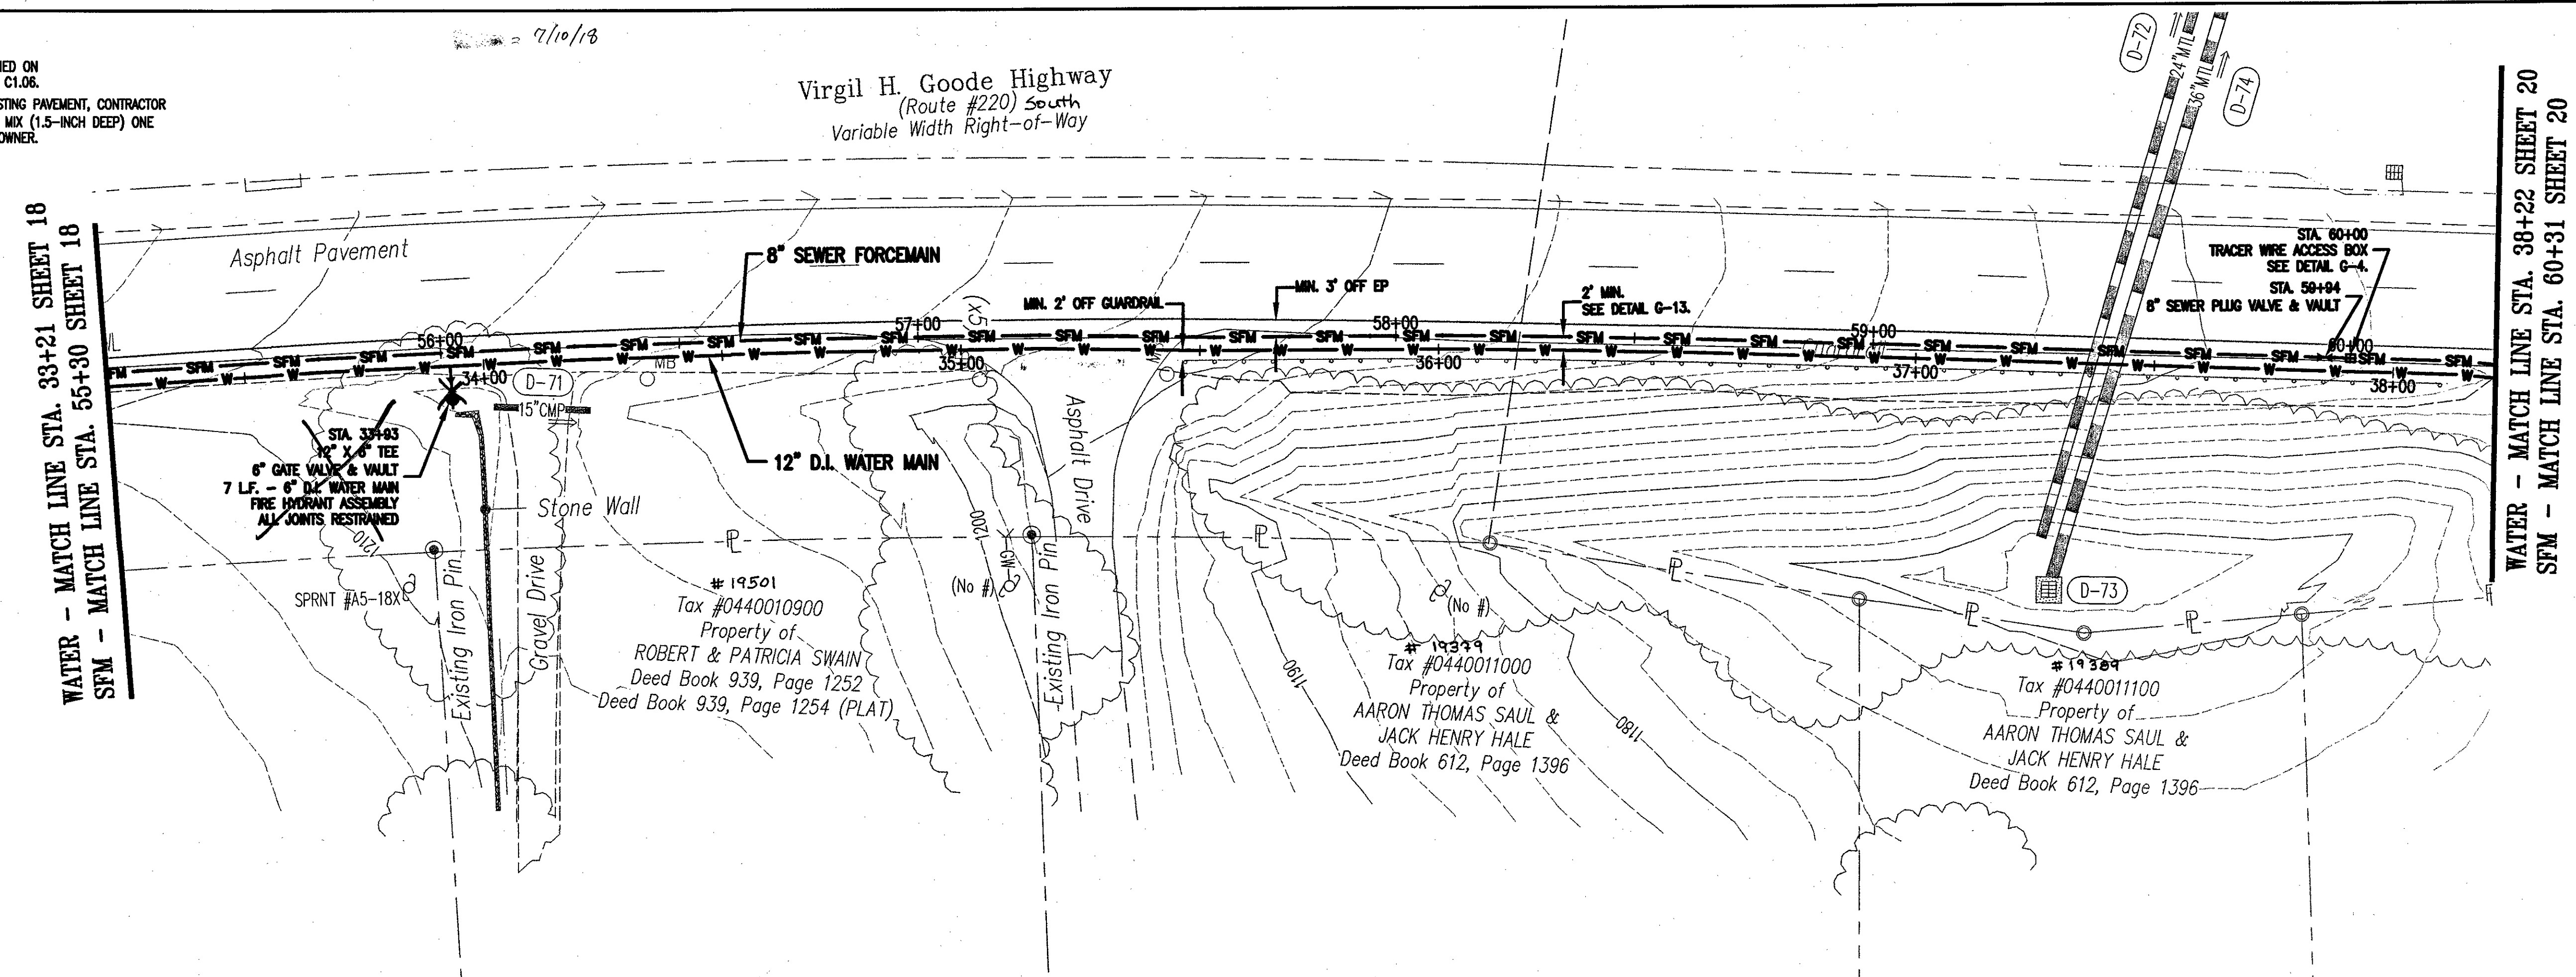

33+00 56+00 34+00 57+00 35+00 58+00 36+00 59+00 37+00 60+00

WATER ONLY INSTALLED

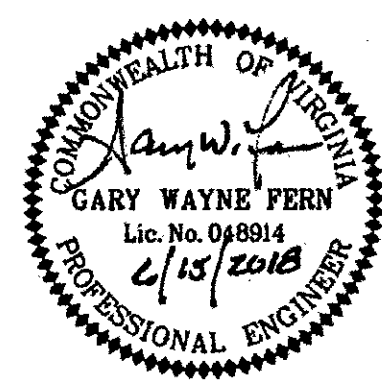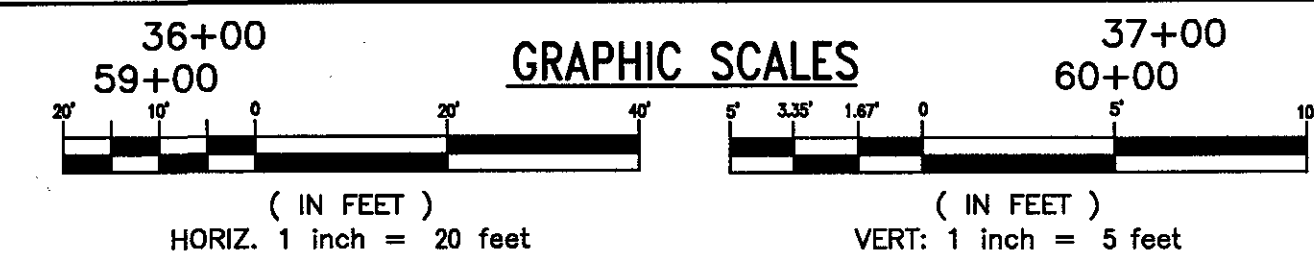

WESTERN VIRGINIA WATER AUTHORITY
601 South Jefferson Street, Suite 300
Roanoke, Virginia 24011

DES: KN
DRAWN: JES
CHECK: GWF
DATE: 06/15/18

SCALE: AS SHOWN
HORIZ: 1" = 20'
VERT: 1" = 5'

SUMMIT VIEW BUSINESS PARK UTILITY IMPROVEMENTS
PHASE 2

8" SEWER FORCEMAIN PLAN - PROFILE
STA. 55+30 TO STA. 60+31
12" WATER MAIN PLAN - PROFILE
STA. 33+21 TO STA. 38+22

DRAWING
C1.16

SHEET
19