
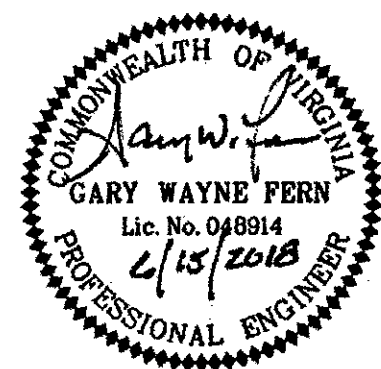
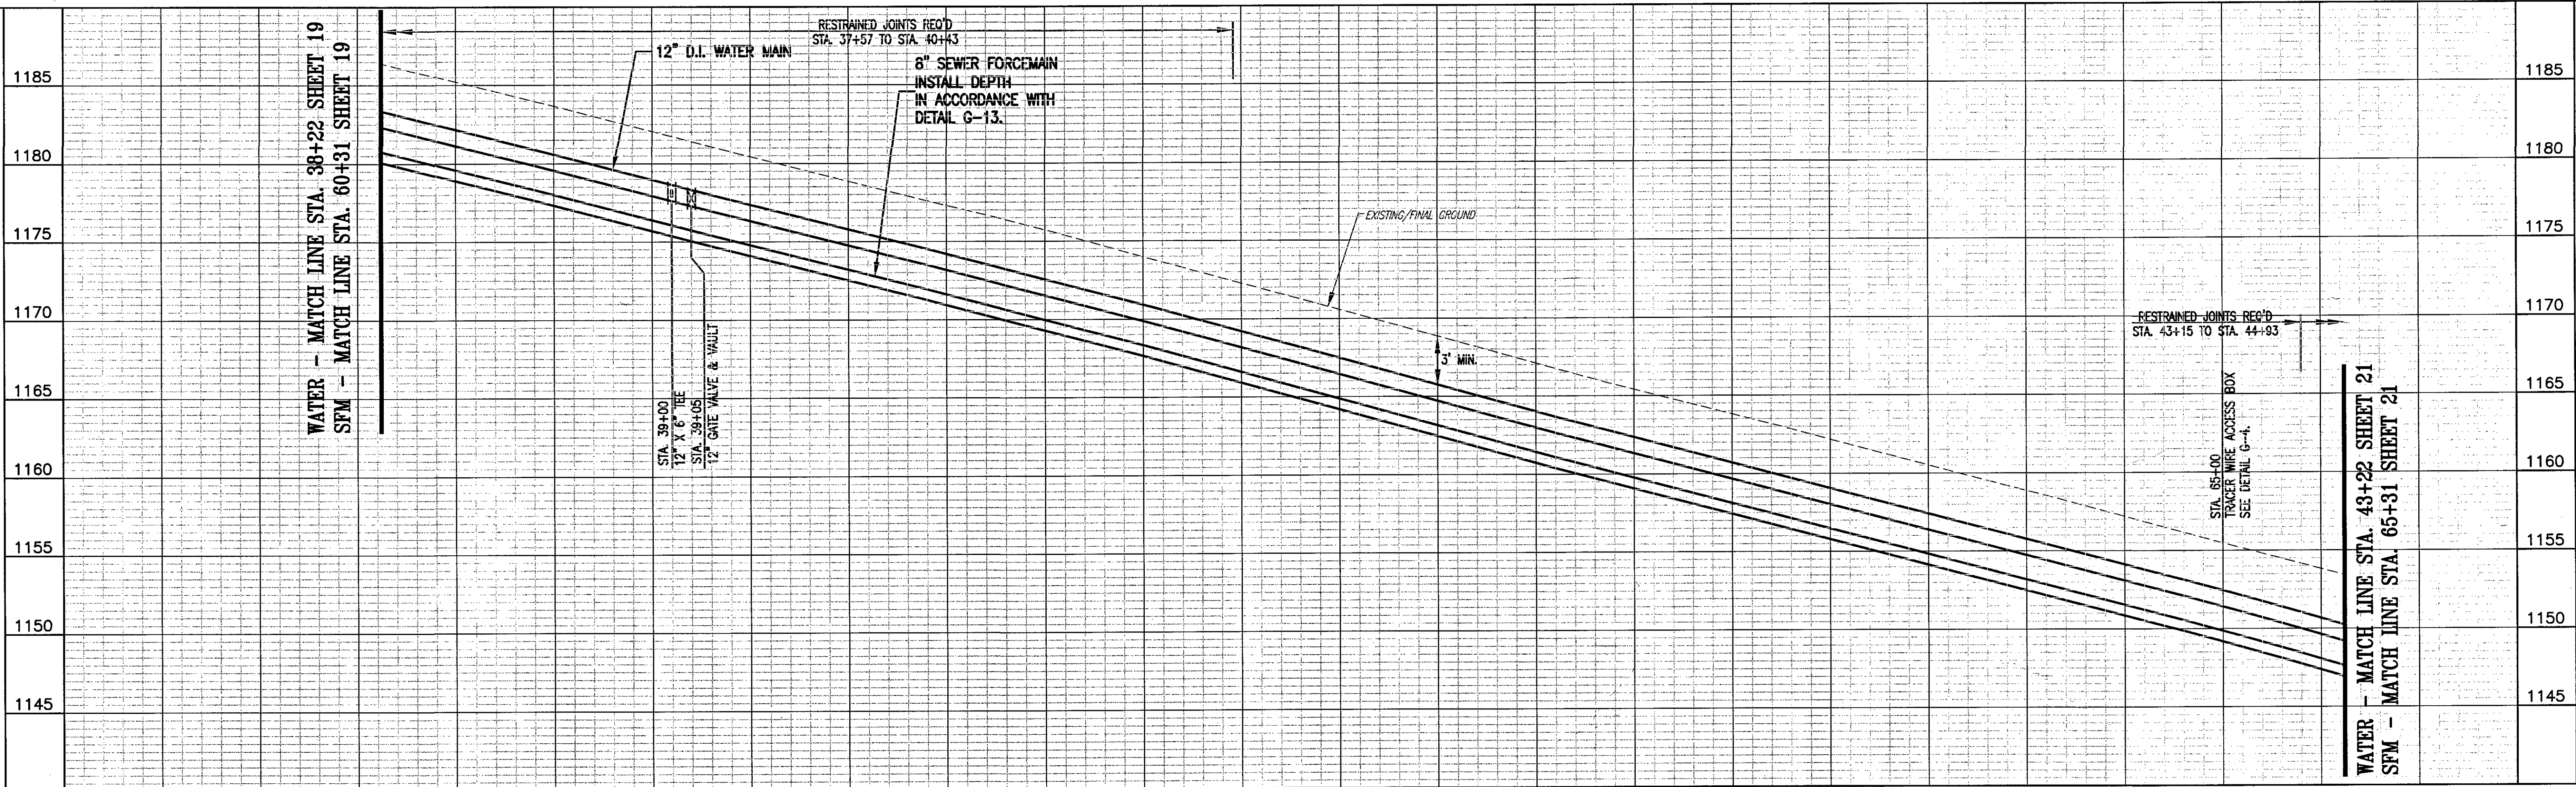


NOTE:

1. ALL PIPE MATERIALS SHALL BE AS SPECIFIED ON THE PIPE SCHEDULE SHOWN ON DRAWING C1.06.

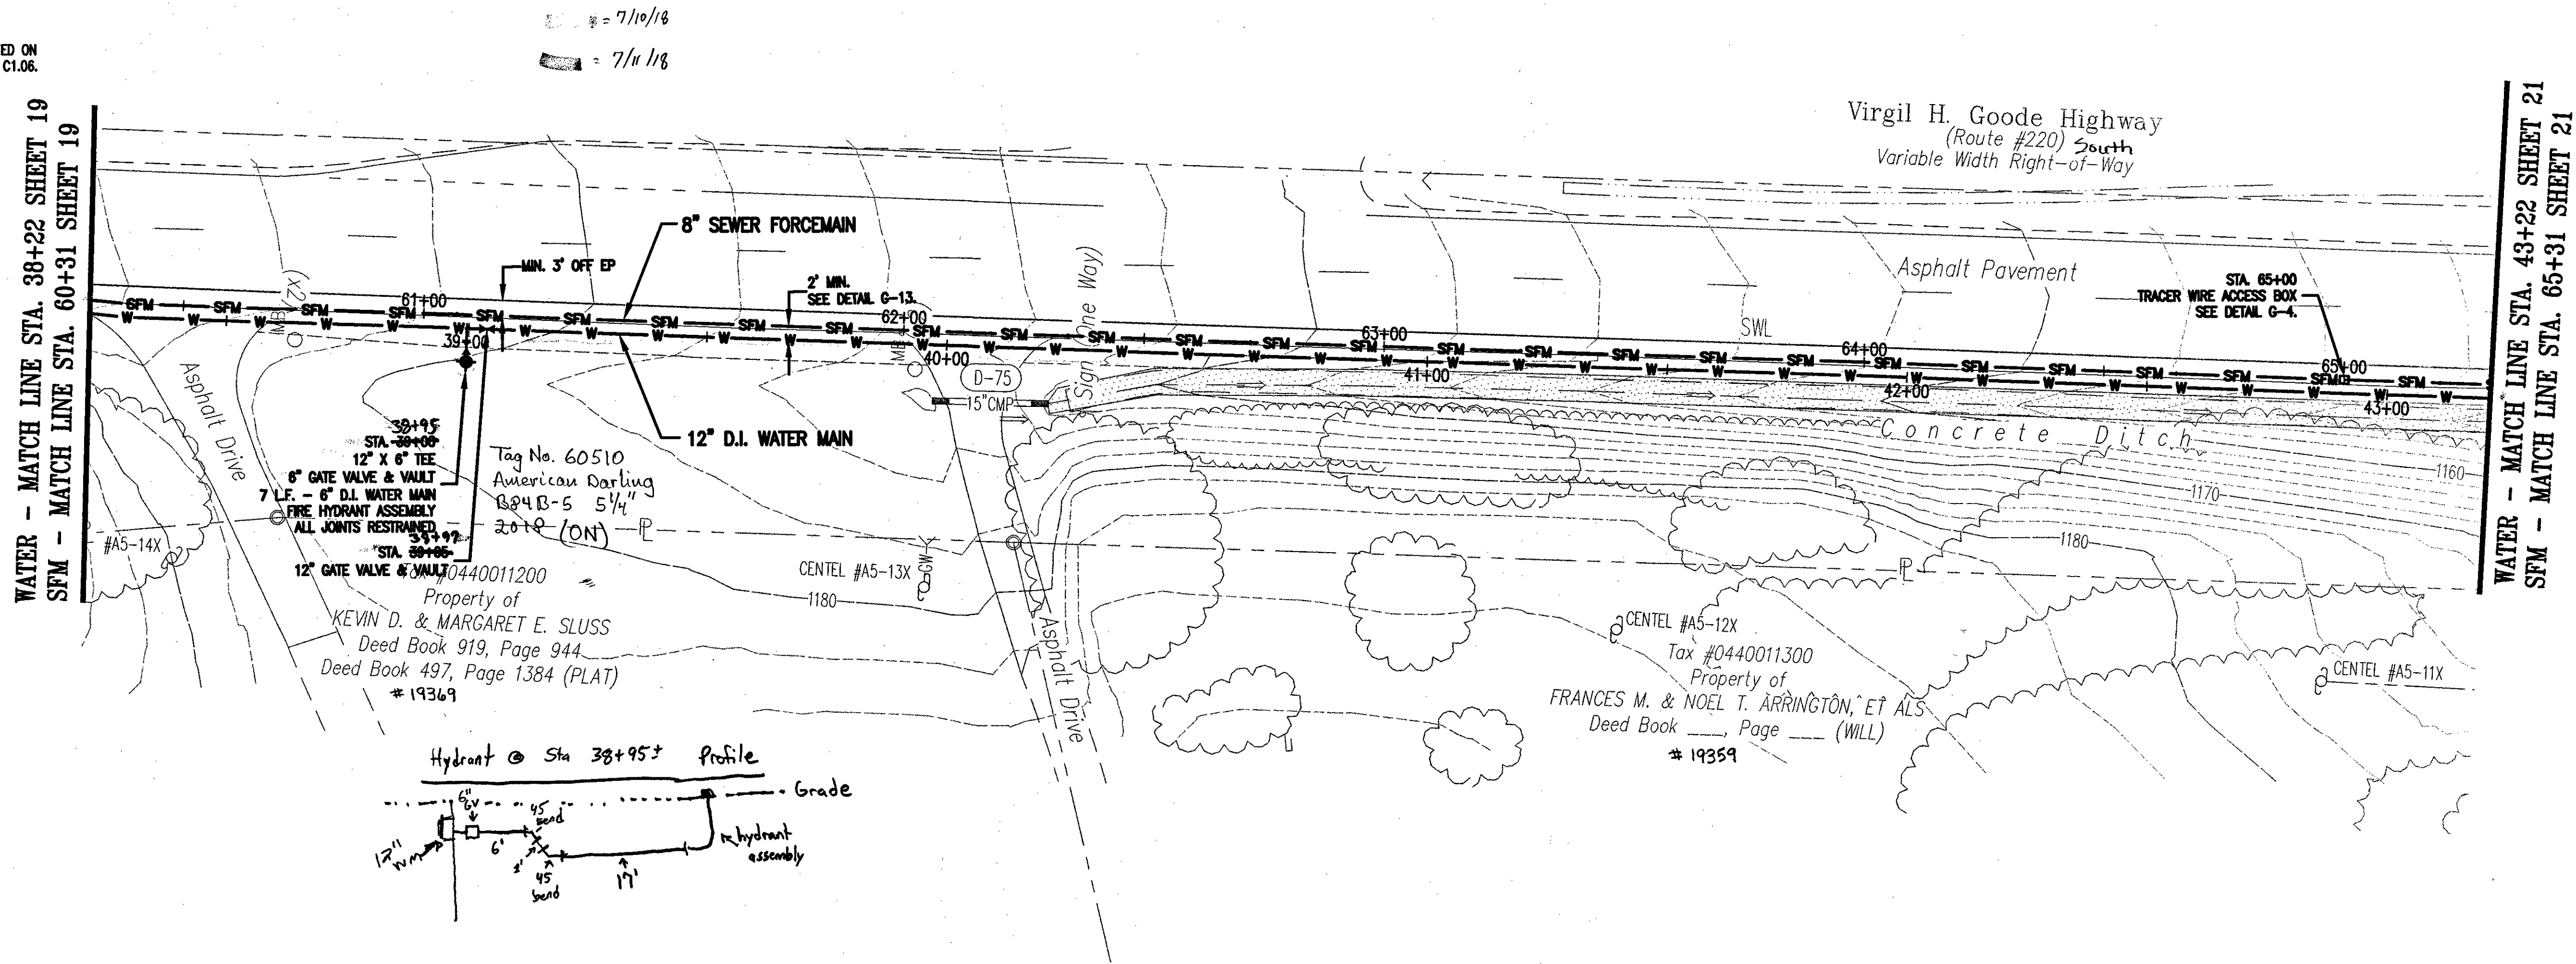

WESTERN VIRGINIA WATER AUTHORITY
601 South Jefferson Street, Suite 300
Roanoke, Virginia 24011

DES: KN
DRAWN: JES
CHECK: GWP
DATE: 06/15/18

SCALE: AS SHOWN
HORIZ: 1" = 20'
VERT: 1" = 5'

SUMMIT VIEW BUSINESS PARK UTILITY IMPROVEMENTS
PHASE 2

WATER ONLY INSTALLED

8" SEWER FORCEMAIN PLAN - PROFILE
STA. 60+31 TO STA. 65+31
12" WATER MAIN PLAN - PROFILE
STA. 38+22 TO STA. 43+22

DRAWING
C1.17

SHEET
20