


NOTE:

1. ALL PIPE MATERIALS SHALL BE AS SPECIFIED ON THE PIPE SCHEDULE SHOWN ON DRAWING C1.06.
2. IN THE EVENT CONTRACTOR DAMAGES EXISTING PAVEMENT, CONTRACTOR SHALL MILL AND RE-PAVE WITH SURFACE MIX (1.5-INCH DEEP) ONE LANE OF ROADWAY AT NO COST TO THE OWNER.



= 7/16/18

Virgil H. Goode Highway
(Route #220)
Variable Width Right-of-Way

WATER - MATCH LINE STA. 53+22 SHEET 22
SFM - MATCH LINE STA. 75+31 SHEET 22

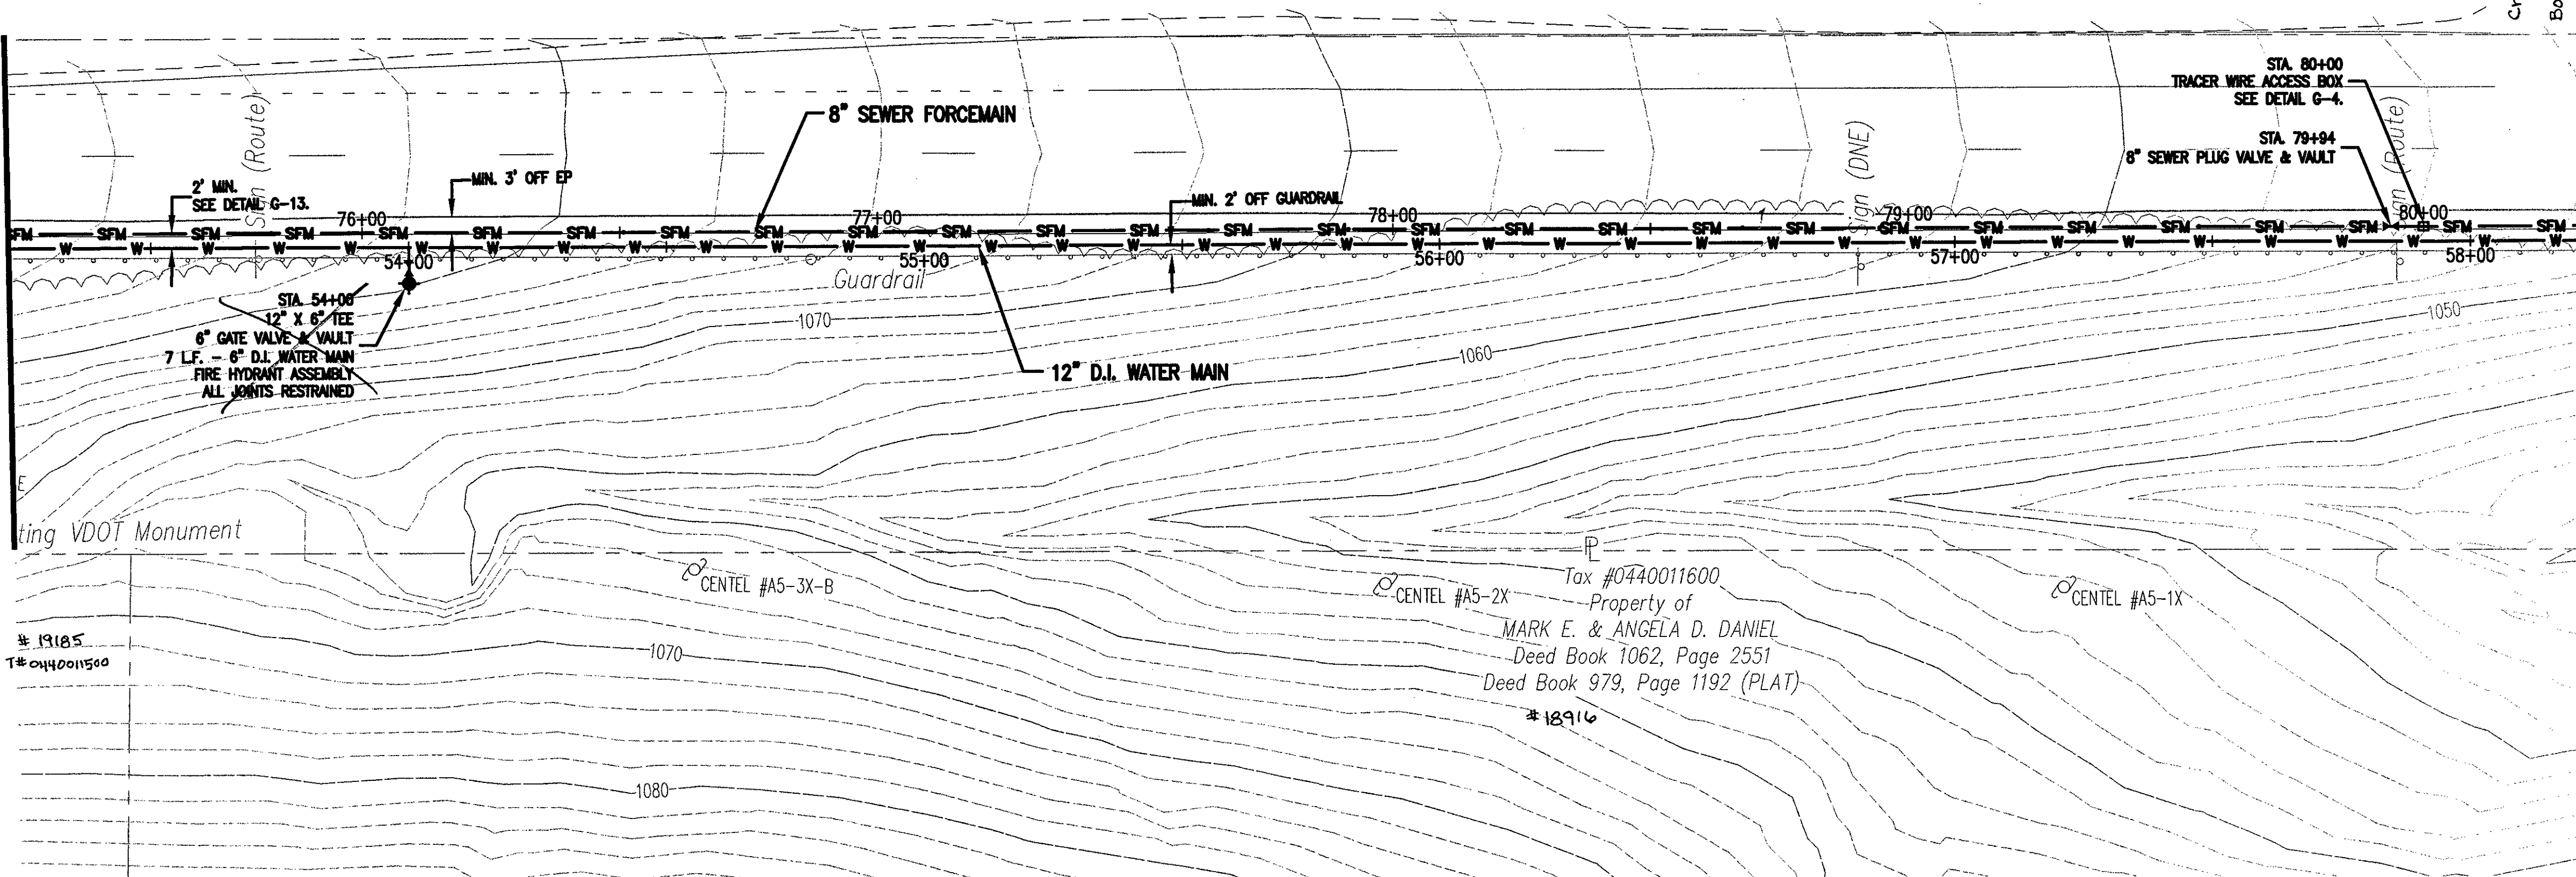

WATER - MATCH LINE STA. 58+22 SHEET 24
SFM - MATCH LINE STA. 80+31 SHEET 24

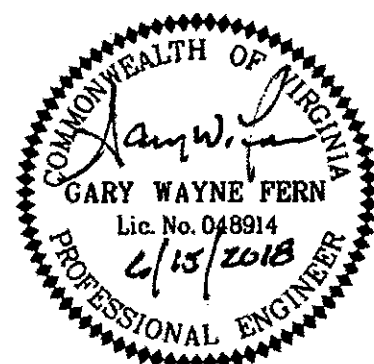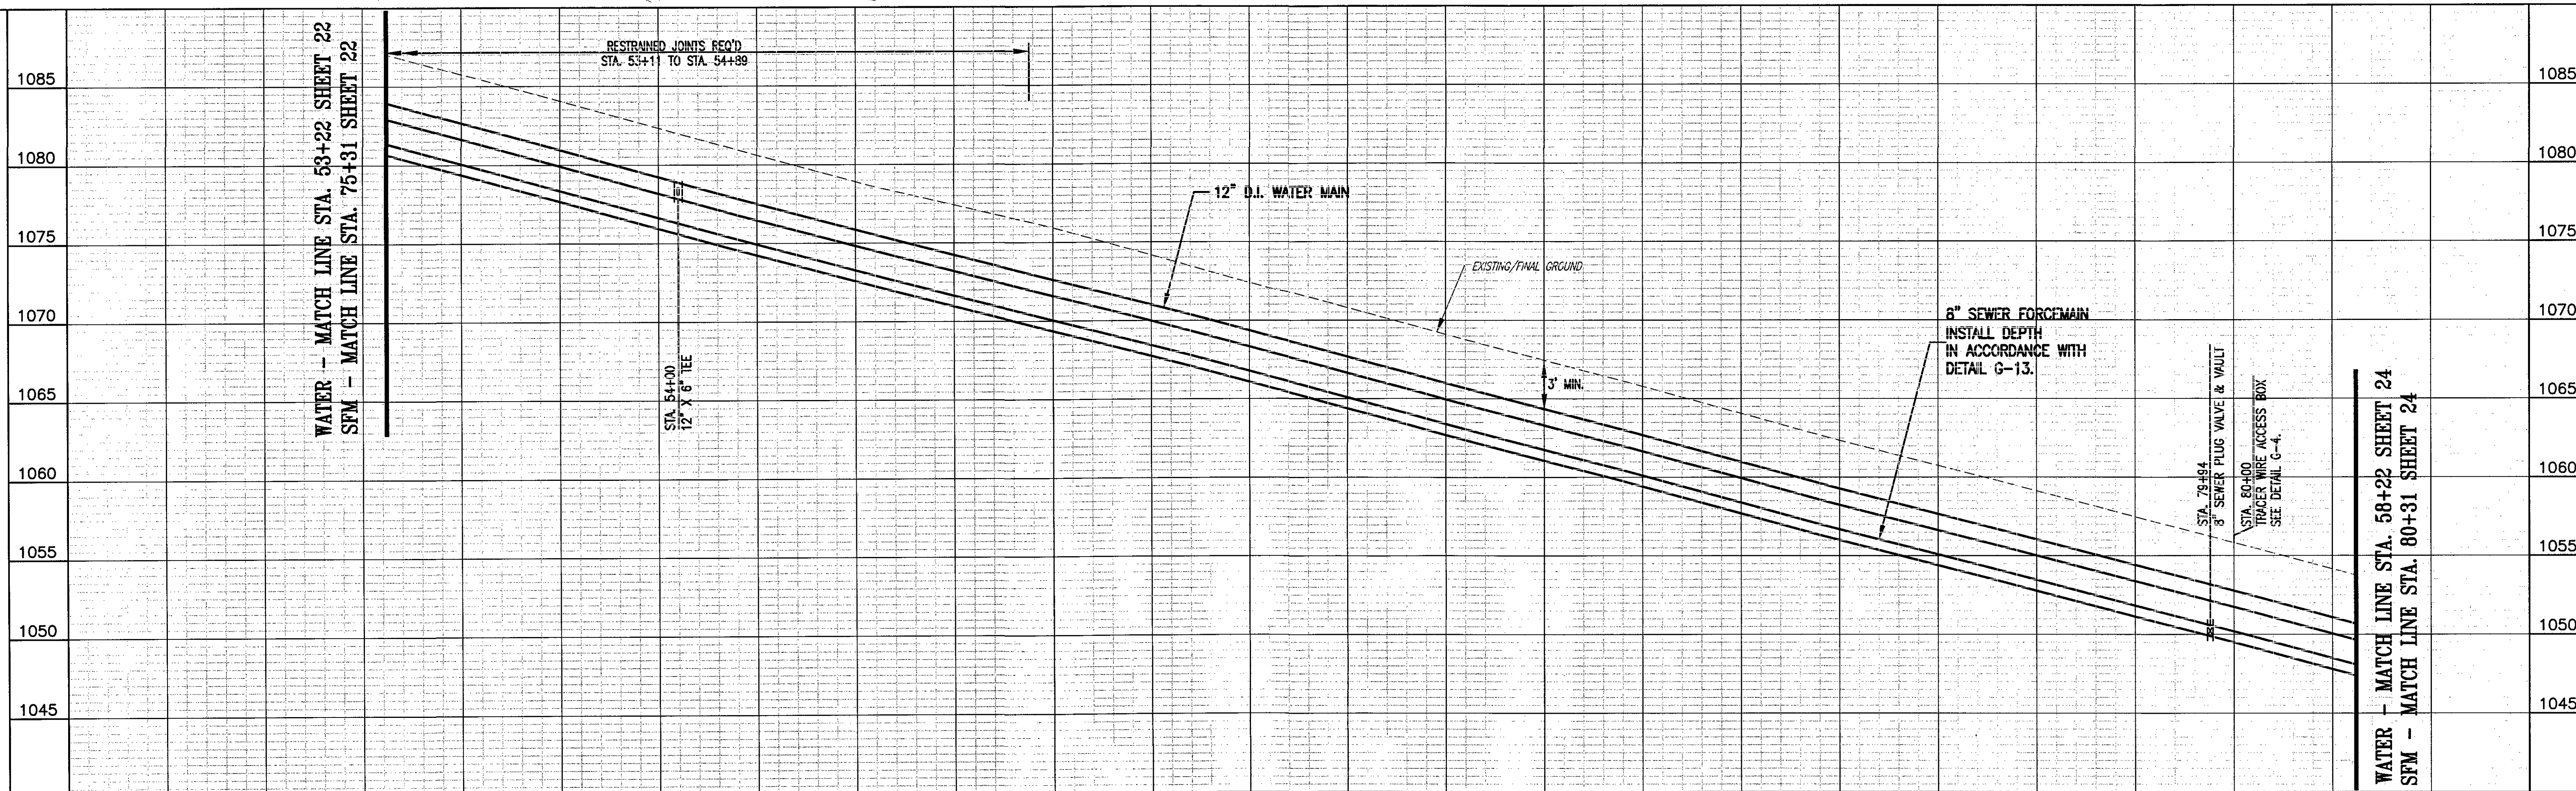

WESTERN VIRGINIA WATER AUTHORITY
601 South Jefferson Street, Suite 300
Roanoke, Virginia 24011

DES: KN
DRAWN: JES
CHECK: GWF
DATE: 06/15/18

SCALE: AS SHOWN
HORIZ: 1" = 20'
VERT: 1" = 5'

SUMMIT VIEW BUSINESS PARK UTILITY IMPROVEMENTS
PHASE 2

WATER ONLY INSTALLED

8" SEWER FORCEMAIN - PROFILE
- STA. 75+31 TO STA. 80+31 -
12" WATER MAIN PLAN - PROFILE
STA. 53+22 TO STA. 58+22

DRAWING
C1.20

SHEET
23