
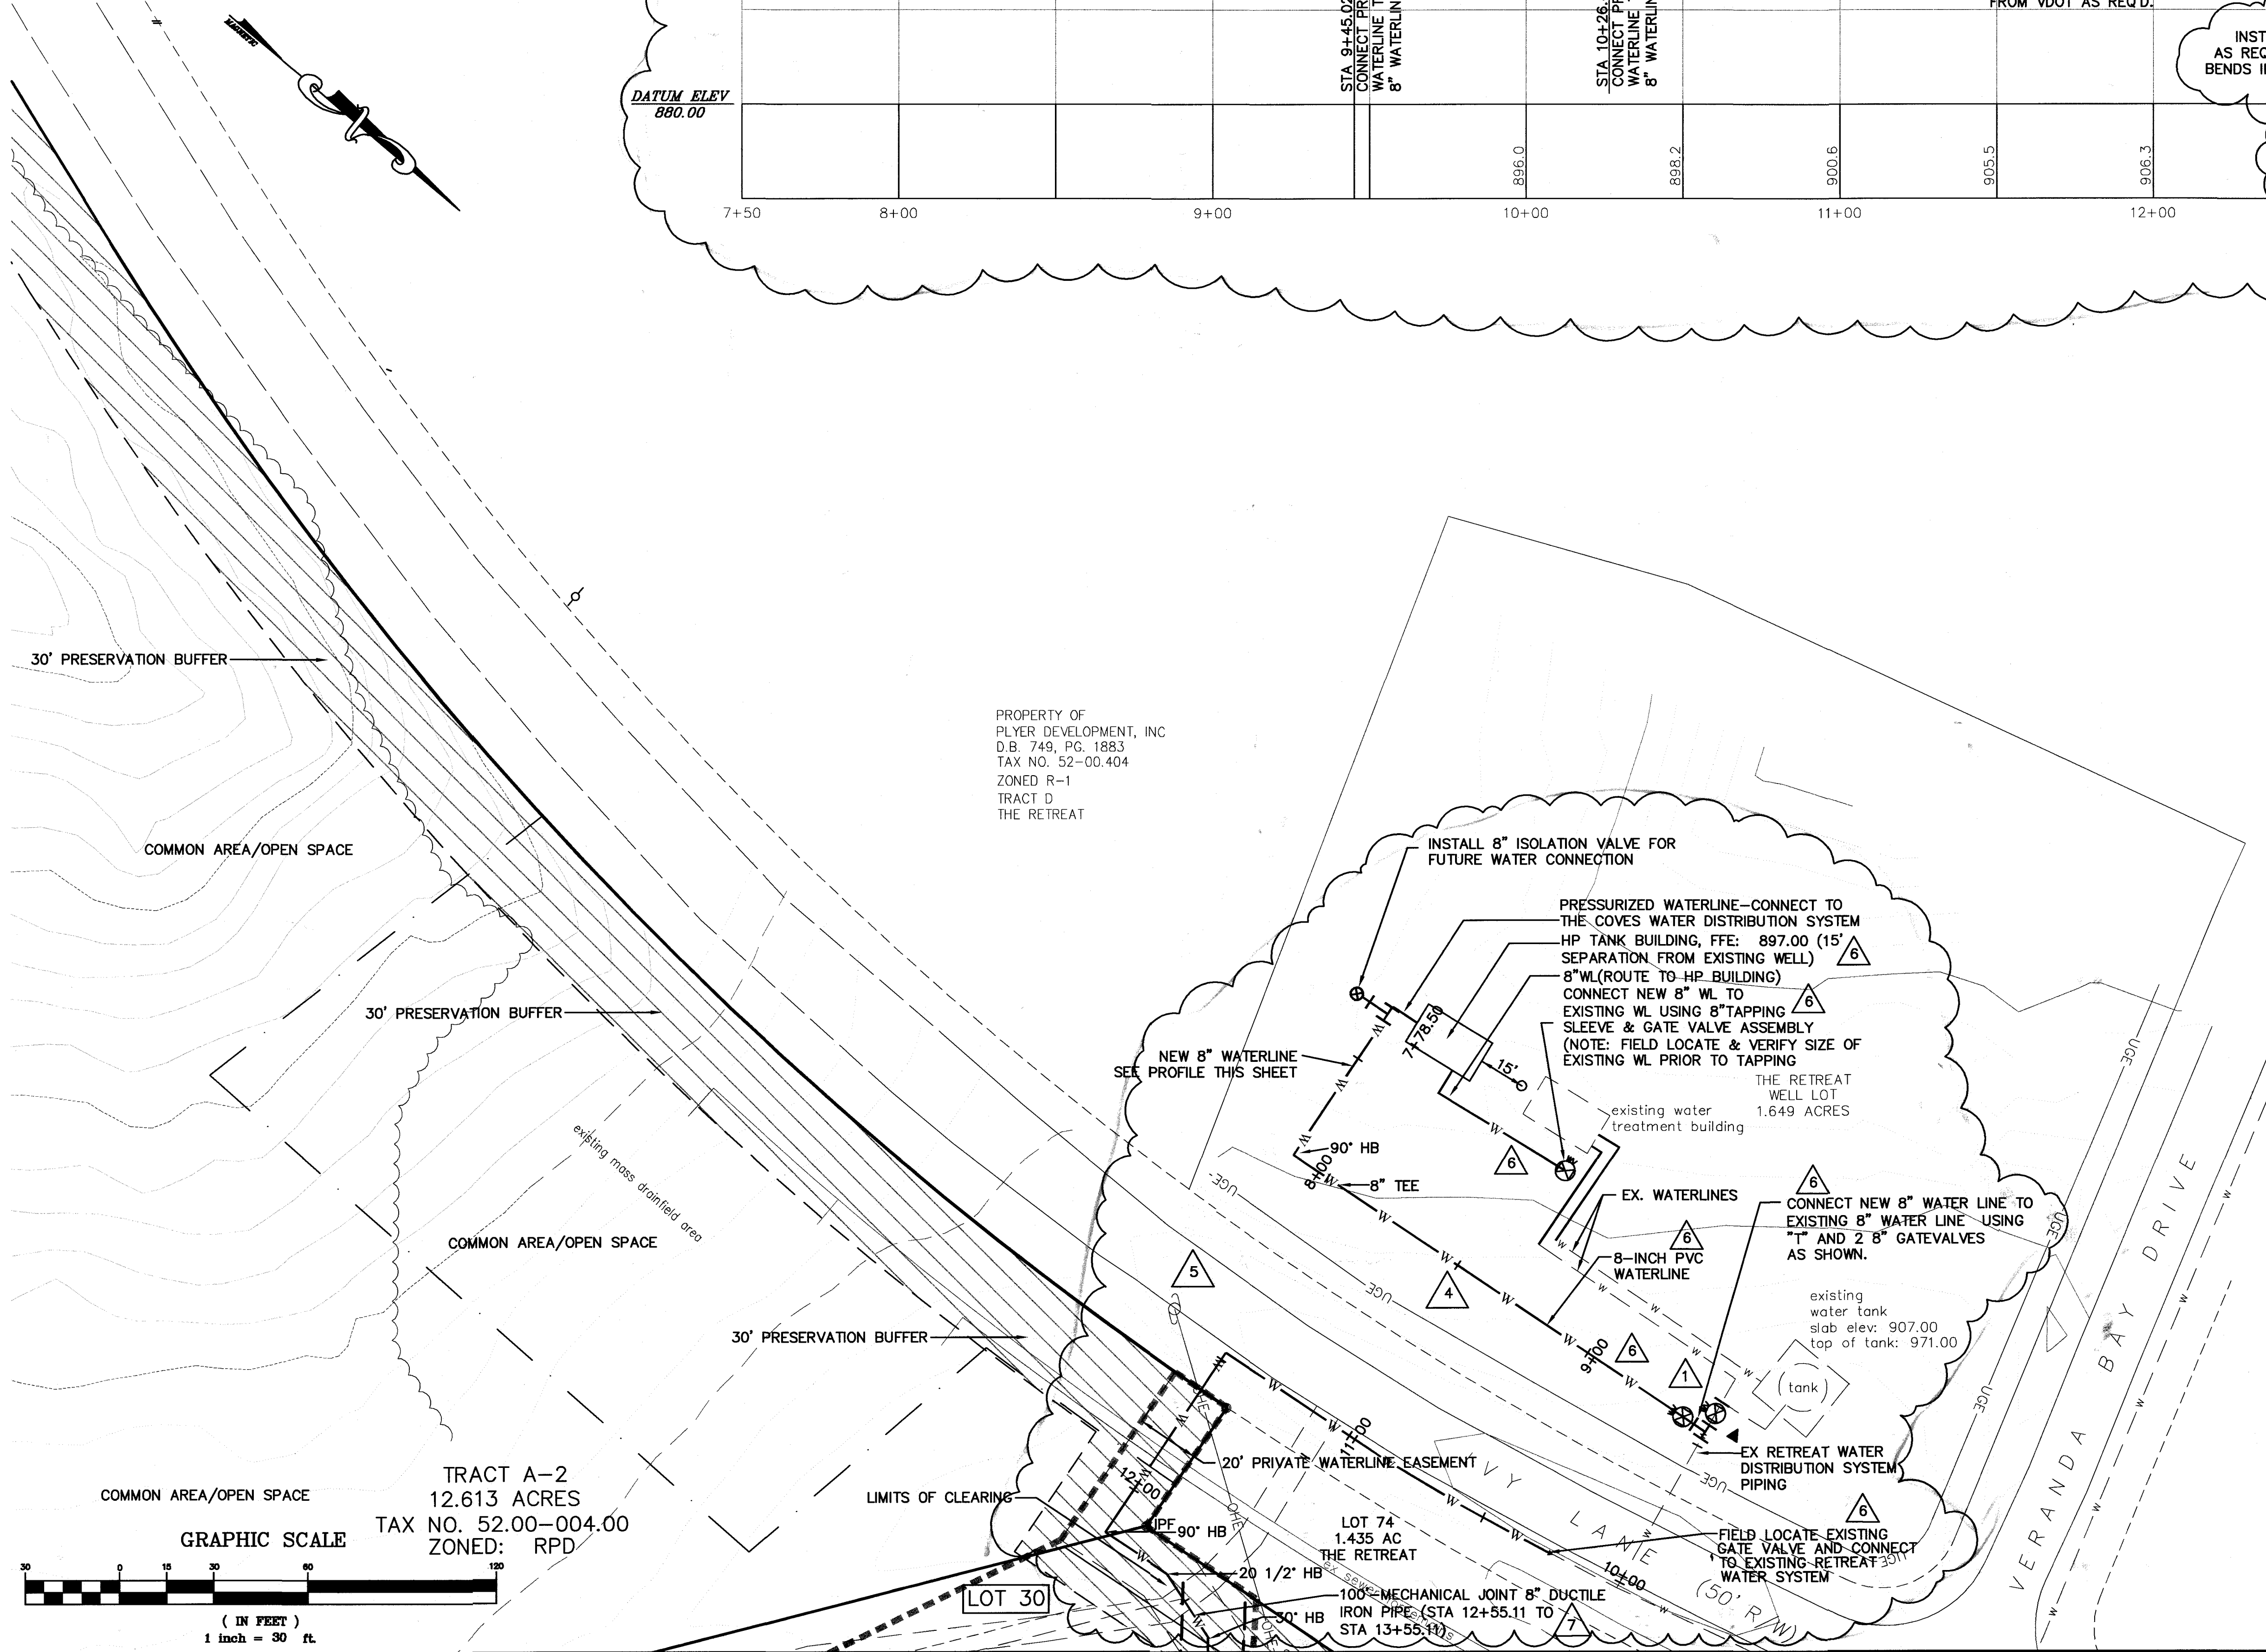


EROSION & SEDIMENT CONTROL LEGEND


- CE CONSTRUCTION ENTRANCE
- SF SILT FENCE
- IP INLET PROTECTION
- OP OUTLET PROTECTION
- CRS CONSTRUCTION ROAD STABILIZATION
- TS TEMPORARY SEEDING
- PS PERMANENT SEEDING
- ST SEDIMENT TRAP
- BD DIVERSION DIKE
- CD CHECK DAM

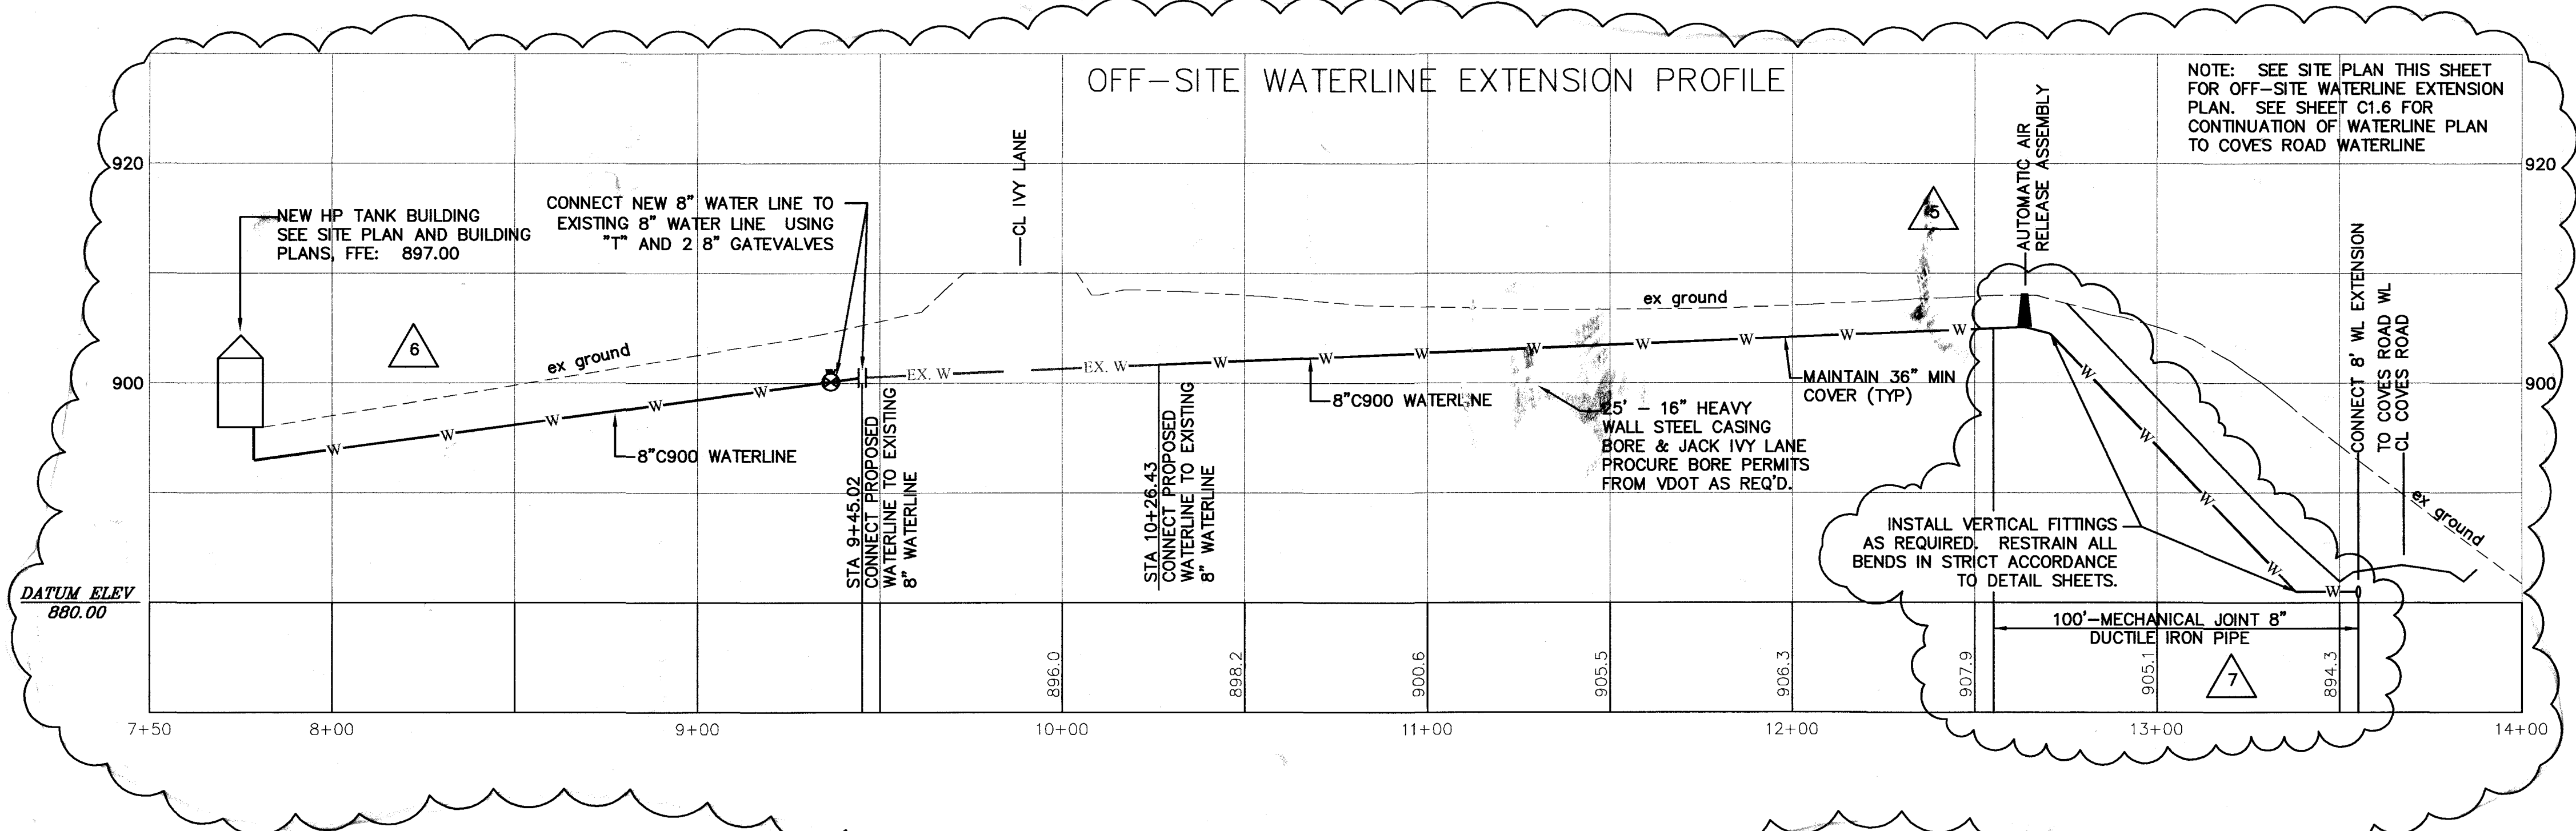

HP TANK BUILDING GENERAL NOTES:

- COORDINATE SITE WORK AND YARD PIPING WITH PROPOSED HP TANK BUILDING AND EQUIPMENT PLAN.
- ALL CONSTRUCTION SHALL ADHERE TO THE MINIMUM STANDARDS SET FORTH BY FRANKLIN COUNTY CHAPTER 22 UTILITY REGULATIONS AND VIRGINIA DEPARTMENT OF HEALTH WATER WORKS REGULATIONS.
- REFER TO PROJECT MANUAL FOR DETAILED PROJECT SPECIFICATIONS.
- PROCURE NECESSARY BUILDING PERMITS PRIOR TO COMMENCEMENT OF CONSTRUCTION.
- LOCATE AND VERIFY THE HORIZONTAL AND VERTICAL LOCATION OF ALL EXISTING UTILITIES PRIOR TO EXCAVATION.

No. 7 12/18/2007
Revise Water Line Pipe Material

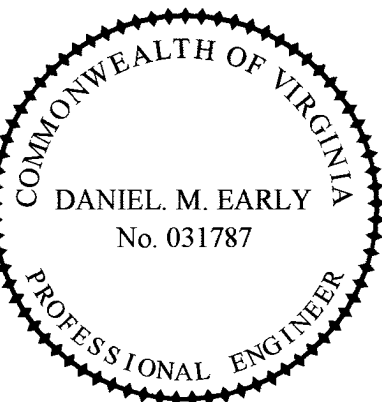

ACS DESIGN

ENGINEERING • SURVEYING
LANDSCAPE ARCHITECTURE
CONSTRUCTION MANAGEMENT

2203 PETERS CREEK ROAD
ROANOKE, VIRGINIA 24017
P 540.562.2345 F 562.2344
INFO@ACSDSIGNLLC.COM
WWW.ACSDESIGNLLC.COM

The Coves at Smith Mountain Lake
Optima Properties-Smith Mountain Lake, LLC
Franklin County, Virginia

DRAWN BY: dne
DESIGNED BY: dne
CHECKED BY: dne
DATE: 15 May 2006
JOB NUMBER: 05271

REVISIONS:
No. 1 08/28/2006
Per FCI/ACS
No. 2 09/12/2006
Per VDH & ACS
No. 3 05/11/2007
Final For Construction
No. 4 11/7/2007
Water System Revisions
No. 5 11/22/2007
Revise Water System
SHEET NO.:

C1.10

No. 6 12/14/2007
Revise Water System

UTILITY PLAN
E&S PLAN