


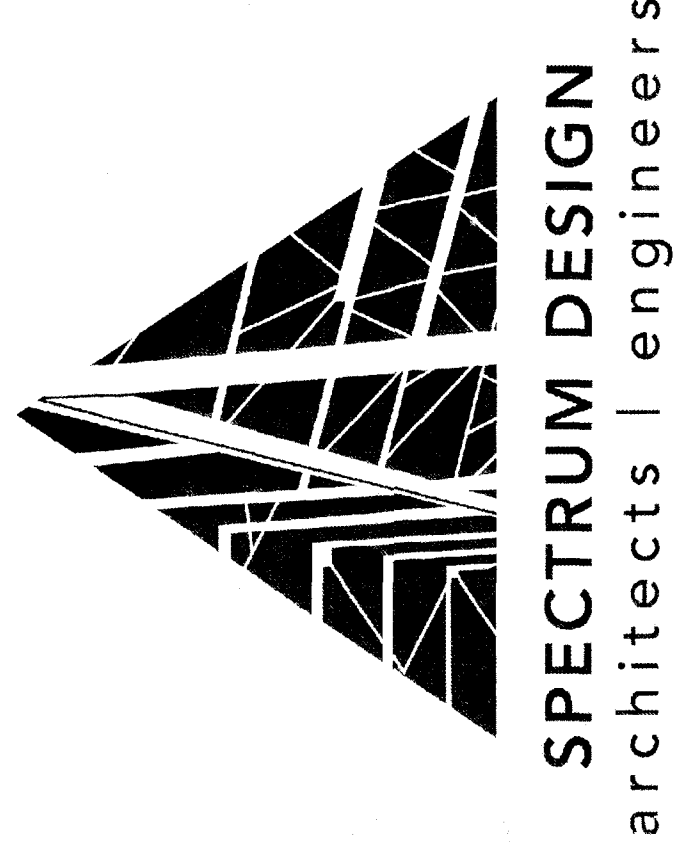

PLAZA SUITE 1 | 10 CHURCH AVENUE SE
ROANOKE, VA 24011

540 . 342 . 6001

FAX: 540 . 342 . 6055

www.spectrumpc.com

PROJECT NUMBER: 18018



NEW CORPORATE HEADQUARTERS

VALLEYSTAR CREDIT UNION

PROJECT ADDRESS
SUMMIT VIEW BUSINESS PARK
FRANKLIN COUNTY, VIRGINIA



ValleyStar Credit Union
P.O. Box 5511
Martinsville, VA 24115

SITE DEVELOPMENT PLAN

MARCH 6, 2019

INDEX OF DRAWINGS

COVER SHEET

- CIVIL
 - C001 GENERAL NOTES
 - C002 EXISTING CONDITIONS & REMOVAL PLAN
 - C003 DIMENSIONS & LOCATION PLAN
 - C201 SANITARY SEWER PROFILE
 - C301 GRADING & DRAINAGE PLAN
 - C302 STORM DRAIN PROFILES
 - C303 STORM DRAIN PROFILES
 - C304 STORM DRAIN PROFILES
 - C401 EASC NARRATIVE
 - C402 EASC DETAILS
 - C501 CONSTRUCTION DETAILS
 - C502 CONSTRUCTION DETAILS
 - C503 CONSTRUCTION DETAILS
 - C601 EASC DETAILS
 - C602 EASC DETAILS
 - C603 EASC DETAILS
 - C701 VDOT SIGHT INTERSECTION SIGHT DISTANCE PLAN
 - C702 VDOT SIGHT INTERSECTION SIGHT DISTANCE PLAN
 - L101 LANDSCAPE PLAN
 - L102 LANDSCAPE PLAN
 - IR-1 IRRIGATION PLAN
- ELECTRICAL
 - E301 ELECTRICAL SITE PLAN
 - E302 ELECTRICAL SITE LIGHTING CALCULATIONS

SITE DEVELOPMENT PLAN
MARCH 6, 2019
PLAN CASE # 16134

Reviewed
APR 16 2019
WYMA - Engr Steve

OWNER / DEVELOPER CERTIFICATION


I, _____, HEREBY ACKNOWLEDGE THE SITE IMPROVEMENTS IMPOSED BY THIS PLAN AND FRANKLIN COUNTY. I HEREBY AGREE TO DEVELOP THE SUBJECT PROPERTY IN COMPLIANCE WITH THE PLAN AND WILL SUBMIT ANY PLAN REVISIONS TO FRANKLIN COUNTY FOR APPROVAL. I AGREE TO POST ALL REQUIRED BONDS WITH FRANKLIN COUNTY FOR DEVELOPMENT AND ACKNOWLEDGE ALL IMPROVEMENTS MUST BE COMPLETED TO THE COUNTY'S SATISFACTION PRIOR TO ISSUANCE OF THE CERTIFICATE OF OCCUPANCY.

SIGNATURE _____ DATE _____

RESPONSIBLE LAND DISTURBER CERTIFICATE:

RID #:

NAME

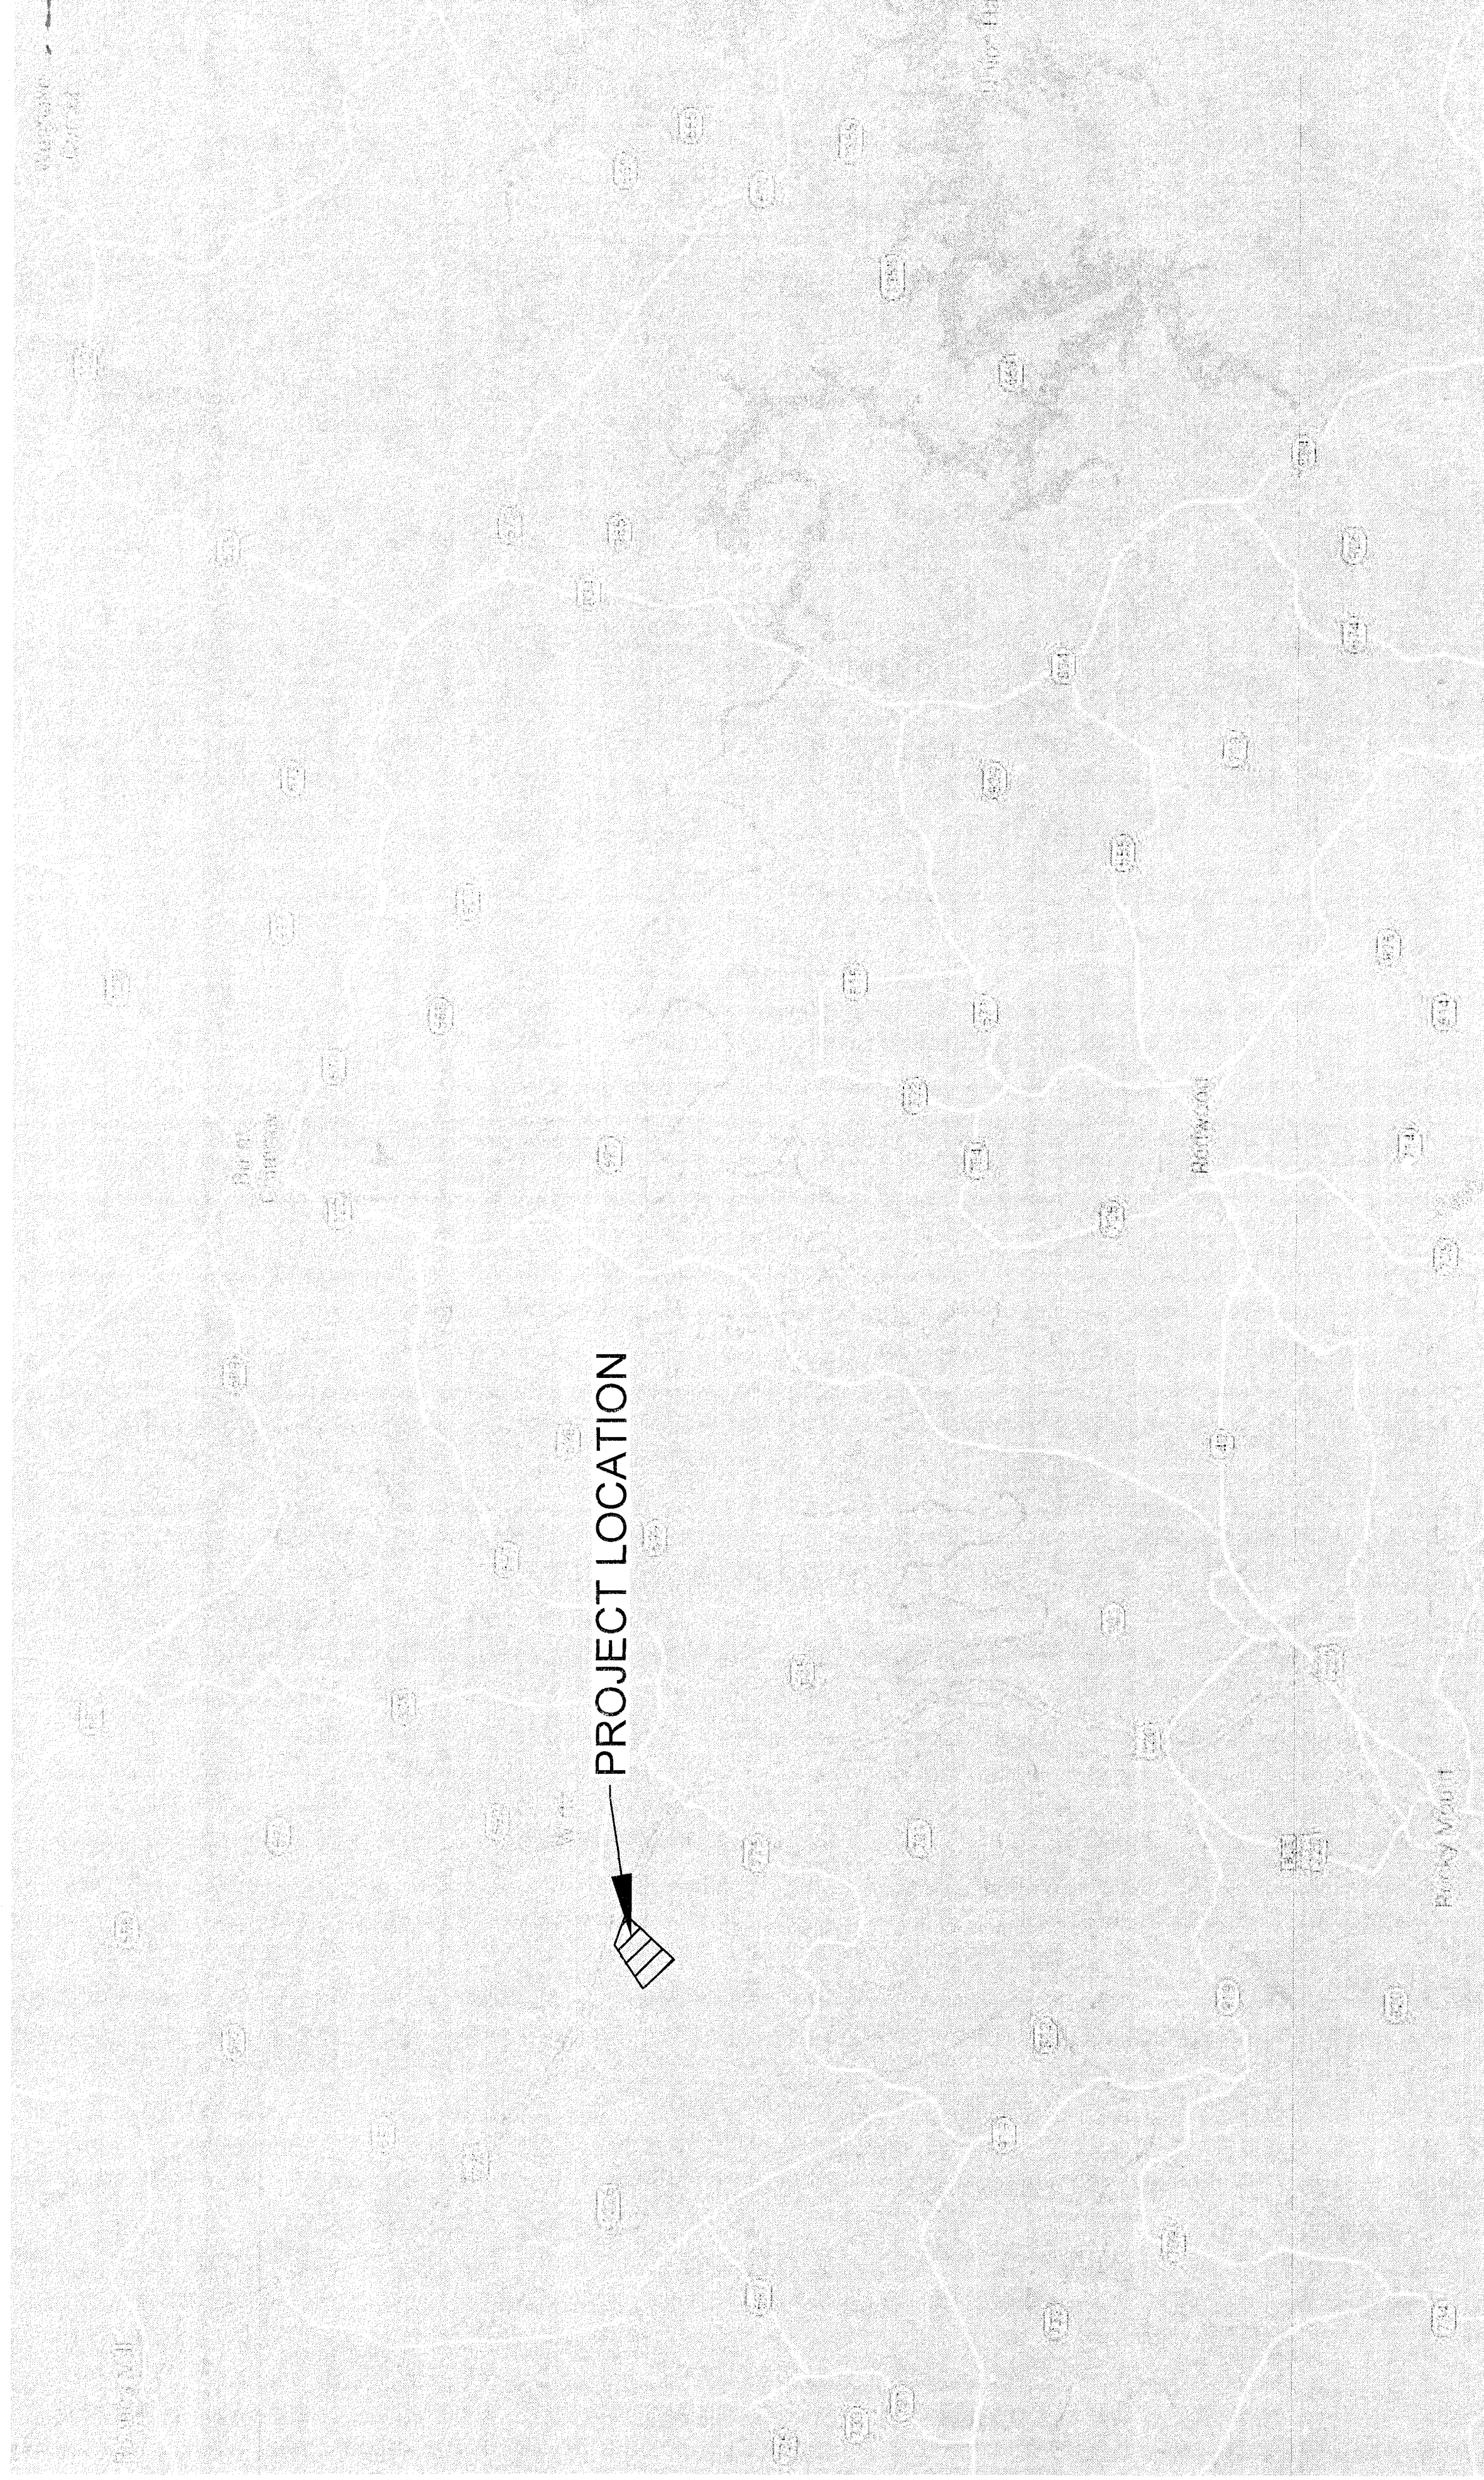

RECEIVED APR 18 2019

As-Built 10.9.19 K. Winslow

LOCATION MAP

VALLEYSTAR CREDIT UNION
NEW CORPORATE HEADQUARTERS
As-Built

PROJECT NO.
18018