


WEST ARROWHEAD VILLAGE CENTRAL WATER SYSTEM FRANKLIN COUNTY, VA.

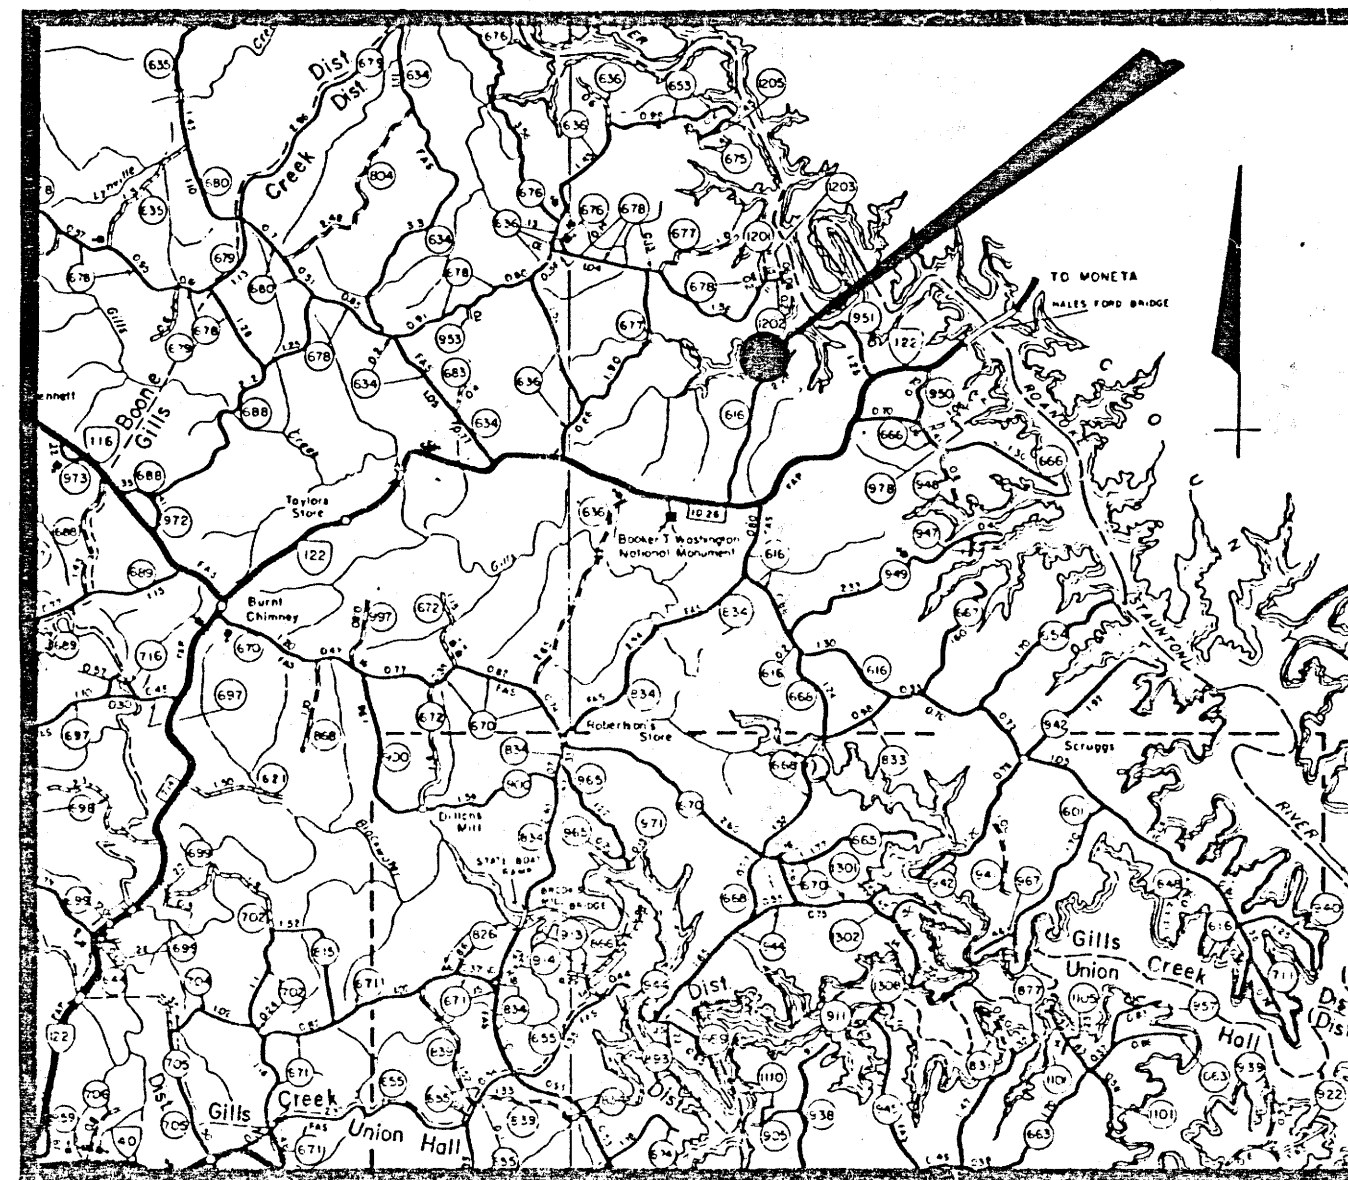

VICINITY MAP

OWNER:
ARROWHEAD WATER COMPANY, INC.

NOTE:
THESE PLANS ARE BASED ON THE ORIGINAL PLANS FOR WEST
ARROWHEAD VILLAGE, DATED 12-6-89. THESE PLANS ARE REVISED TO
SHOW CONNECTIONS FOR WELLS A, C, E AND F.
THESE PLANS ARE 'AS-BUILT' DRAWINGS.

REVISED 1-22-01 PER HEALTH DEPARTMENT COMMENTS.

Berkley Howell & Asso. ENGINEERS • SURVEYORS • PLANNERS		
SCALE:	APPROVED BY:	DRAWN BY:
DATE: 8-23-00		REVISED 1-22-01
WEST ARROWHEAD VILLAGE		
CENTRAL WATER SYSTEM		
DRAWING NUMBER 1 OF 6		

COMM. NO. 000235