


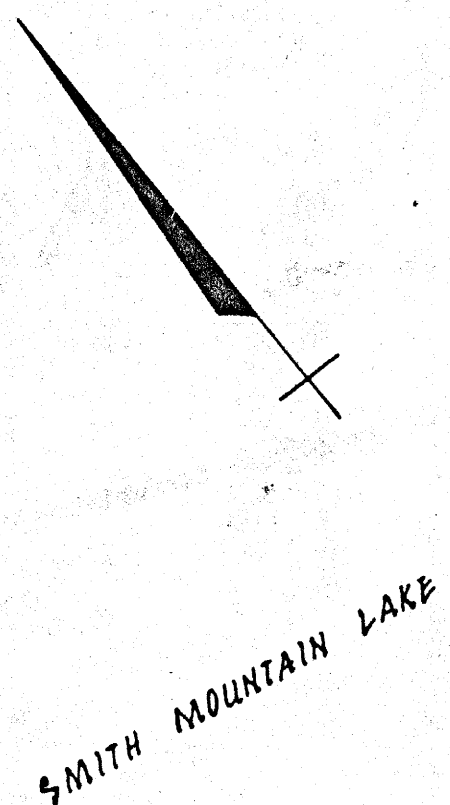

SMITH MOUNTAIN LAKE

INDIAN POINT SUBDIVISION

RECREATION AREA
(INDIAN POINT SUBDIVISION)

THOMAS JUNIOR ELLIS
& THELMA MEADOR ELLIS
D.B. 204 PG. 160

KIT B. KISER &
BONNIE H. KISER
D.B. 304 PG. 426

ECHOWOOD DRIVE


ENLARGED PLAN

NOTE:
FOR WELL LOCATIONS, EASEMENTS
AND WELL LOT DIMENSIONS SEE
WELL LOT DESIGNATIONS & PRIVATE
ACCESS EASEMENT PLAT BY
BERKLEY-HOWELL & ASSOC., DATED
AUGUST 16, 2000.

EXISTING AIR
RELEASE VALVE
SEE ENLARGED PLAN FOR FITTINGS IN THIS AREA.
EXISTING: 1-6"X6" TEE
1-6" GATE VALVE
1-CONCRETE ANCHOR

NOTE:
EXISTING PUMP FOR WELL #1 TO BE REPLACED
AS CALLED FOR ON PLANS.

NOTE:
THESE PLANS ARE BASED ON THE ORIGINAL PLANS FOR WEST
ARROWHEAD VILLAGE, DATED 12-6-89. THESE PLANS ARE REVISED TO
SHOW CONNECTIONS FOR WELLS A, C, E AND F.
THESE PLANS ARE "AS-BUILT" DRAWINGS.

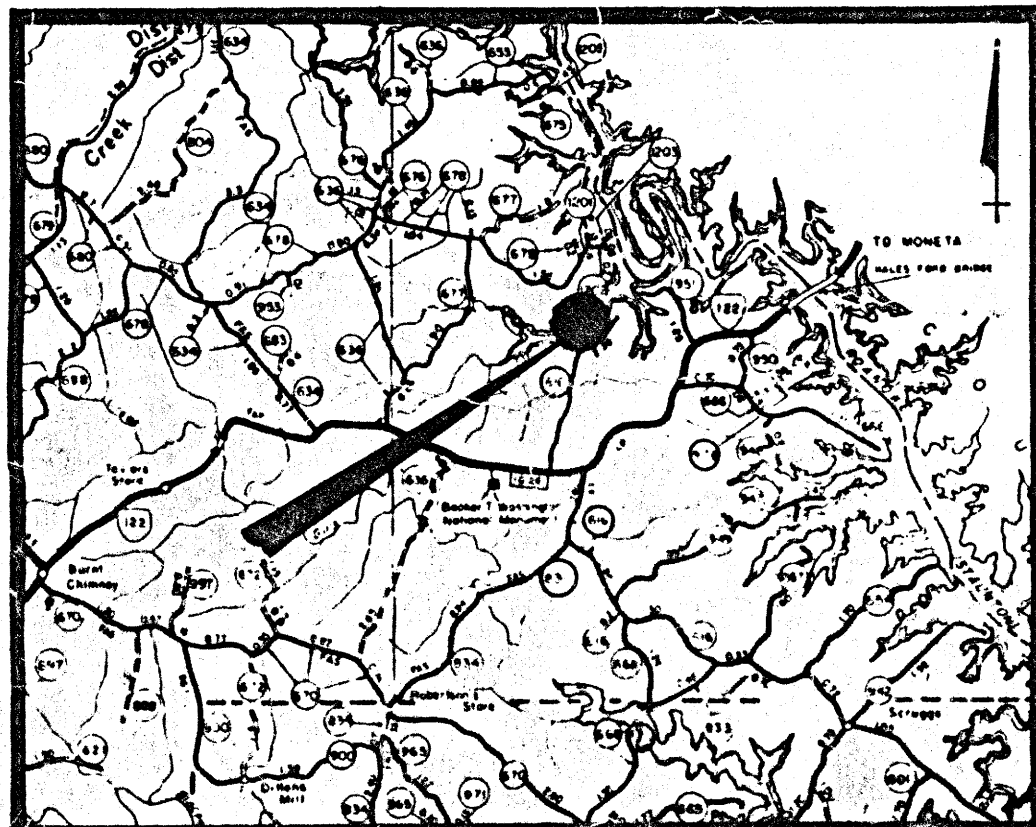

LOCATION MAP

Berkley Howell & Assoc. ENGINEERS • SURVEYORS • PLANNERS			
SCALE: 1" = 100'	MASTER PLAN		DRAWN BY
DATE: 8-23-00			REVISED 1-22-01
WEST ARROWHEAD VILLAGE			
CENTRAL WATER SYSTEM			DRAWING NUMBER 2 OF 6

REVISED 1-22-01 PER HEALTH DEPARTMENT COMMENTS.