


NOTES:

1. ALL PIPING BELOW GRADE AND UNDER CONCRETE SLAB SHALL BE GALVANIZED STEEL OR DUCTILE IRON.
2. ALL EXPOSED PIPING SHALL BE INSULATED TO PREVENT FROST DAMAGE TO BELOW GRADE W/ CERTAINTED WRAP OR APPROVED EQUIV.
3. CUT OR FILE ALL THREADS FROM DISCHARGE OF SAMPLE TRAPS.
4. GALVANIZED STEEL OR DUCTILE IRON PIPE SHALL BE USED FOR ALL ABOVE-GRADE PIPING AT THE WELLS.
5. FILTER GAUGES TO BE GRADUATED IN FEET OF WATER.

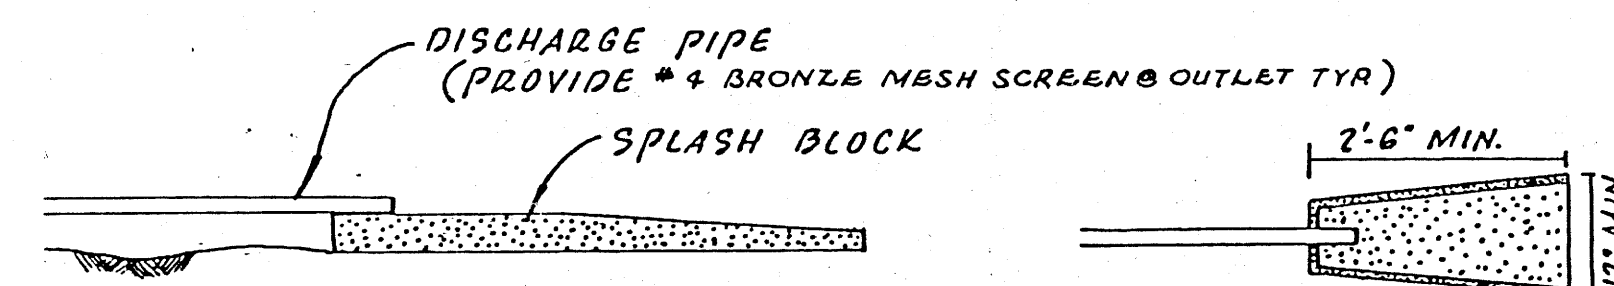

EROSION CONTROL
ALL BLOW-OFFS AND DISCHARGES EMPTY INTO
SPLASH BLOCKS

NOTE: CONTACT TANK SHALL BE ASME APPROVED 2500 GALLON TANK. ALSO, UPON COMPLETION OF TANK INSTALLATION, THE TANK SHALL BE INSPECTED BY DEPT. OF LABOR AND INDUSTRY. A COPY OF THE LETTER VERIFYING THE INSPECTION SHALL BE SUBMITTED TO THE VIRGINIA DEPT. OF HEALTH.

NOTE:
THESE PLANS ARE BASED ON THE ORIGINAL PLANS FOR WEST
ARROWHEAD VILLAGE, DATED 12-6-89. THESE PLANS ARE REVISED TO
SHOW CONNECTIONS FOR WELLS A, C, E AND F. THESE PLANS ARE "AS-BUILT" DRAWINGS.

<i>Berkley Howell & Assoc.</i> ENGINEERS • SURVEYORS • PLANNERS		
SCALE:	APPROVED BY:	DRAWN BY:
DATE: 8-23-00		REVISED 1-22-01
WEST ARROWHEAD VILLAGE TREATMENT BUILDING		
DRAWING NUMBER		3 OF 6