


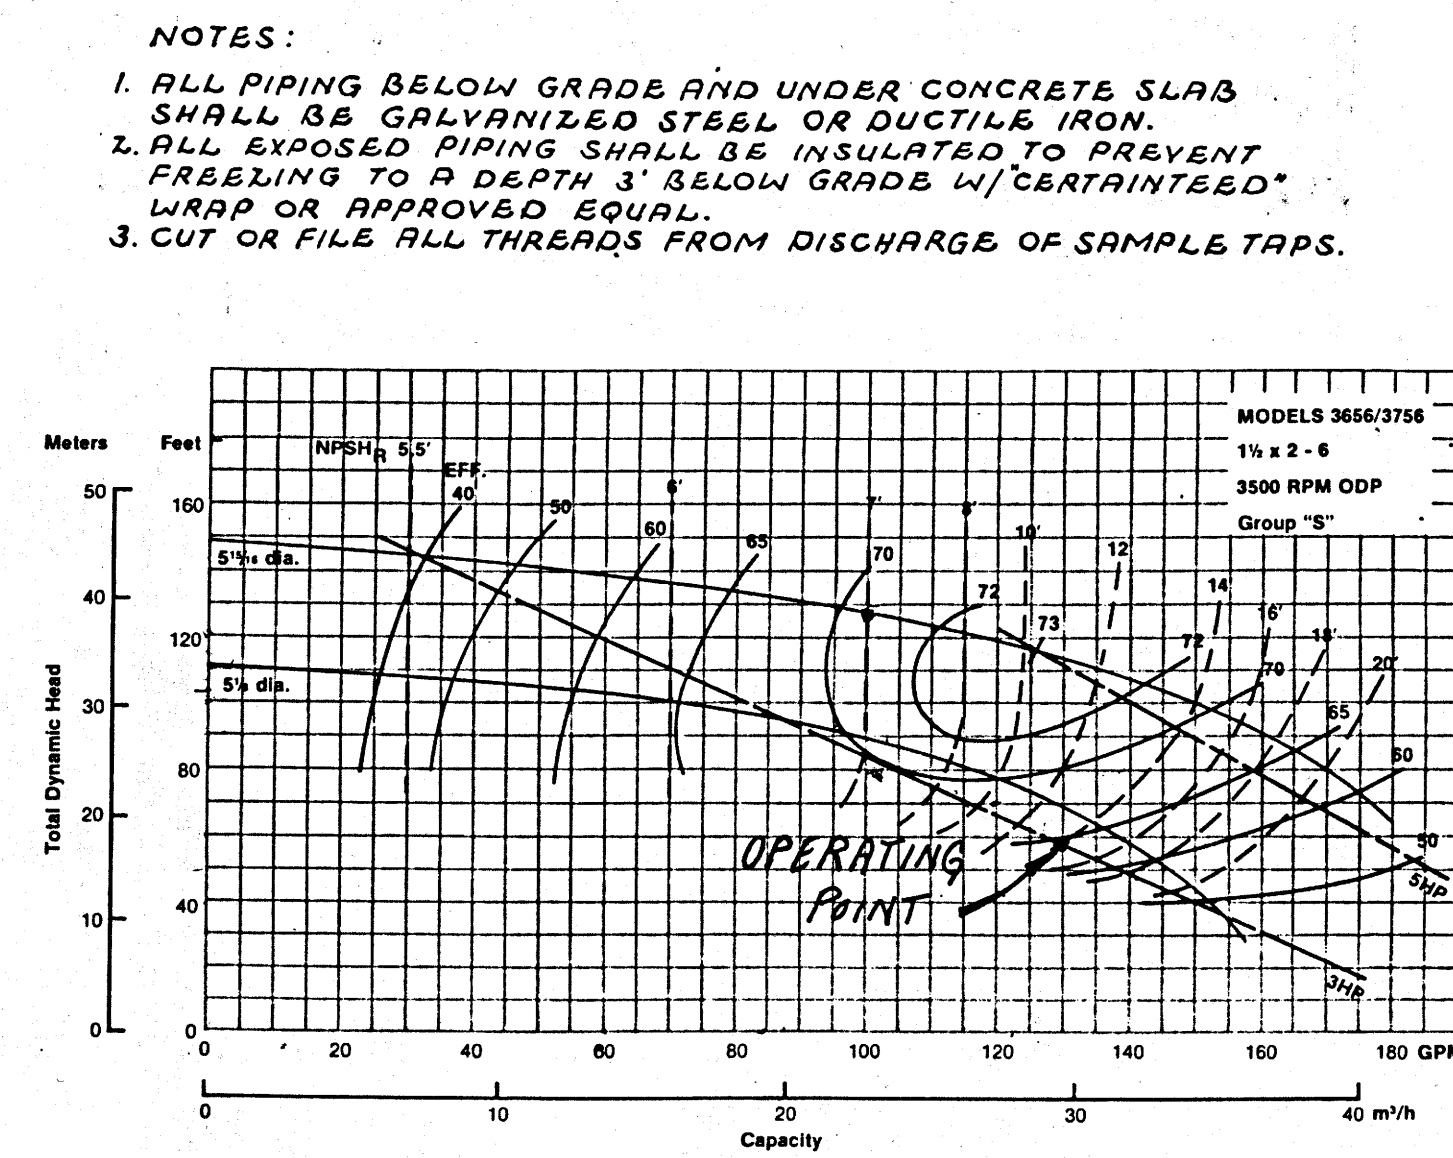
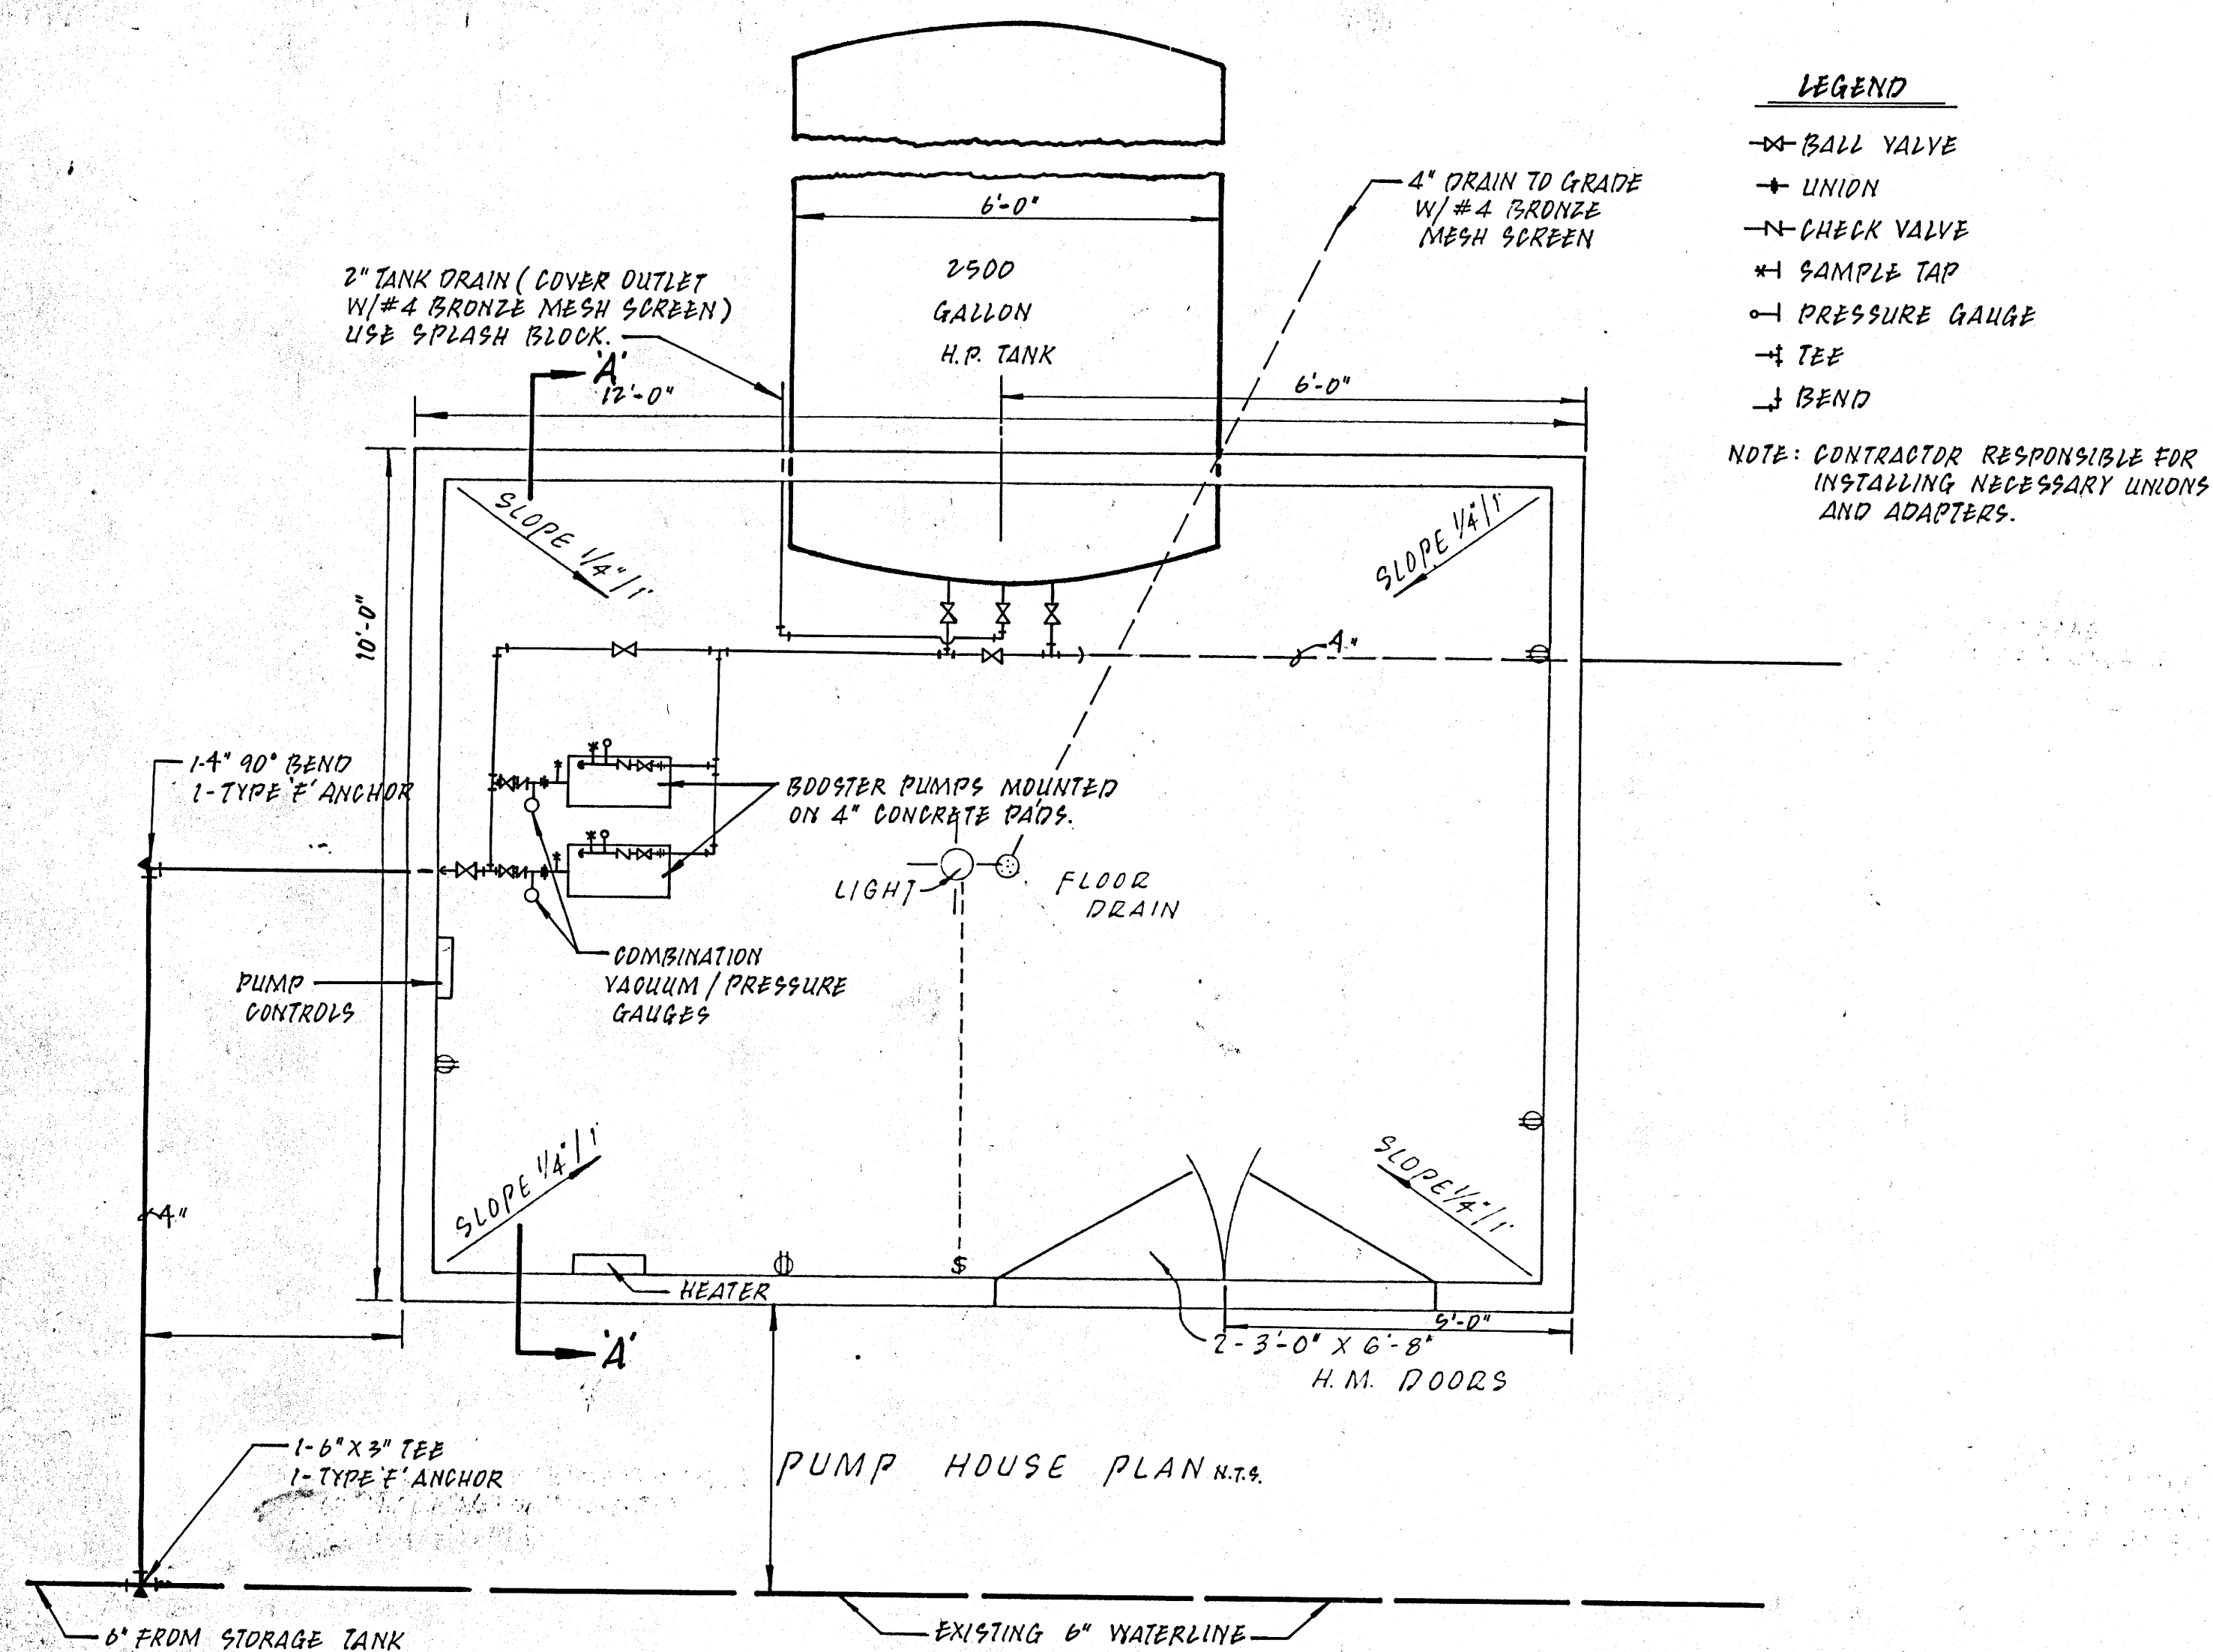


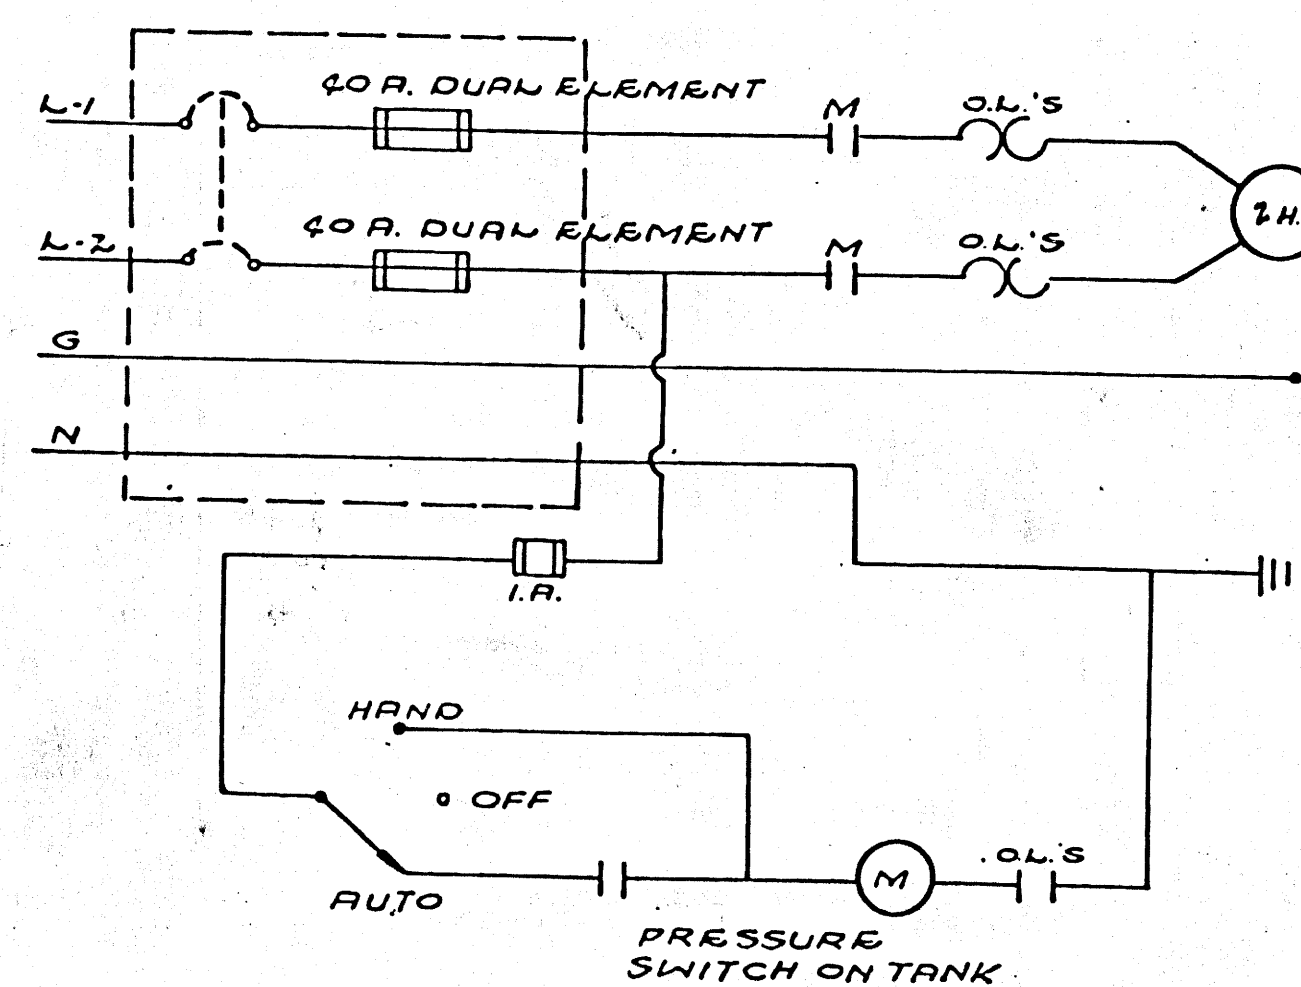

BOOSTER PUMP - GOULDS MODEL 3656
ODP 3 HP - 130 GPM @ 58 TDH

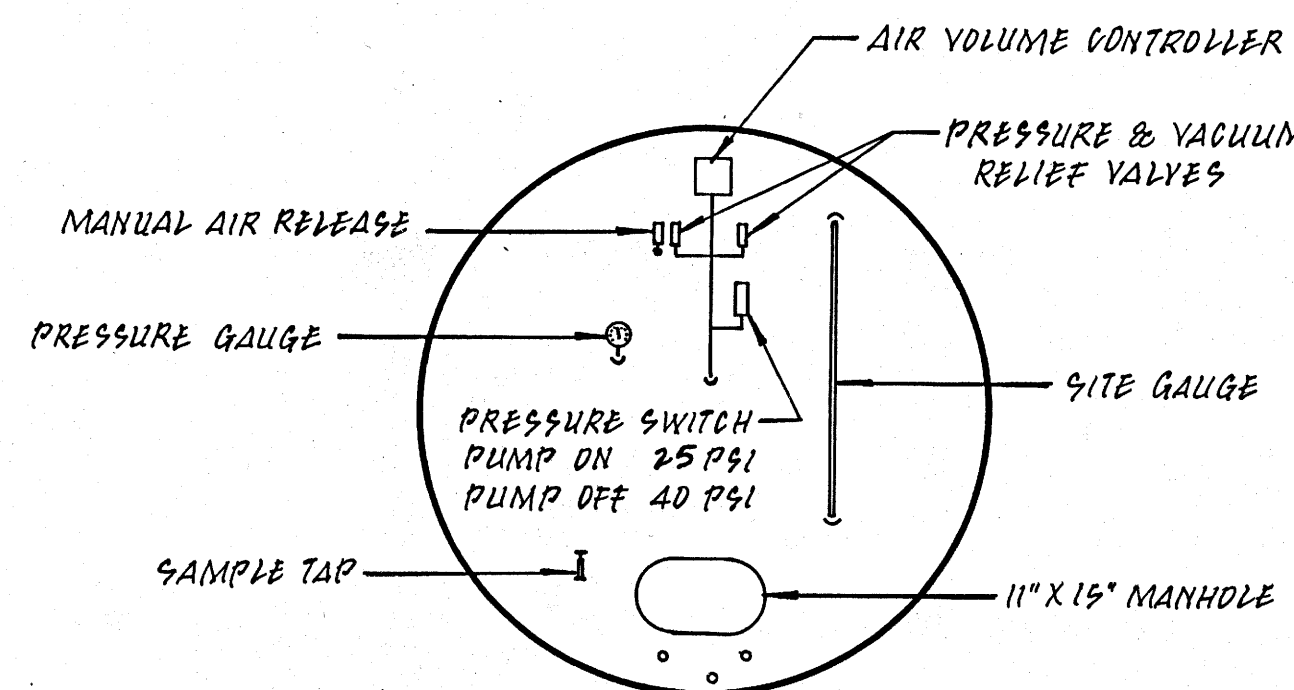

BOOSTER PUMP WIRING SCHEMATIC
(TYPICAL OF 2)

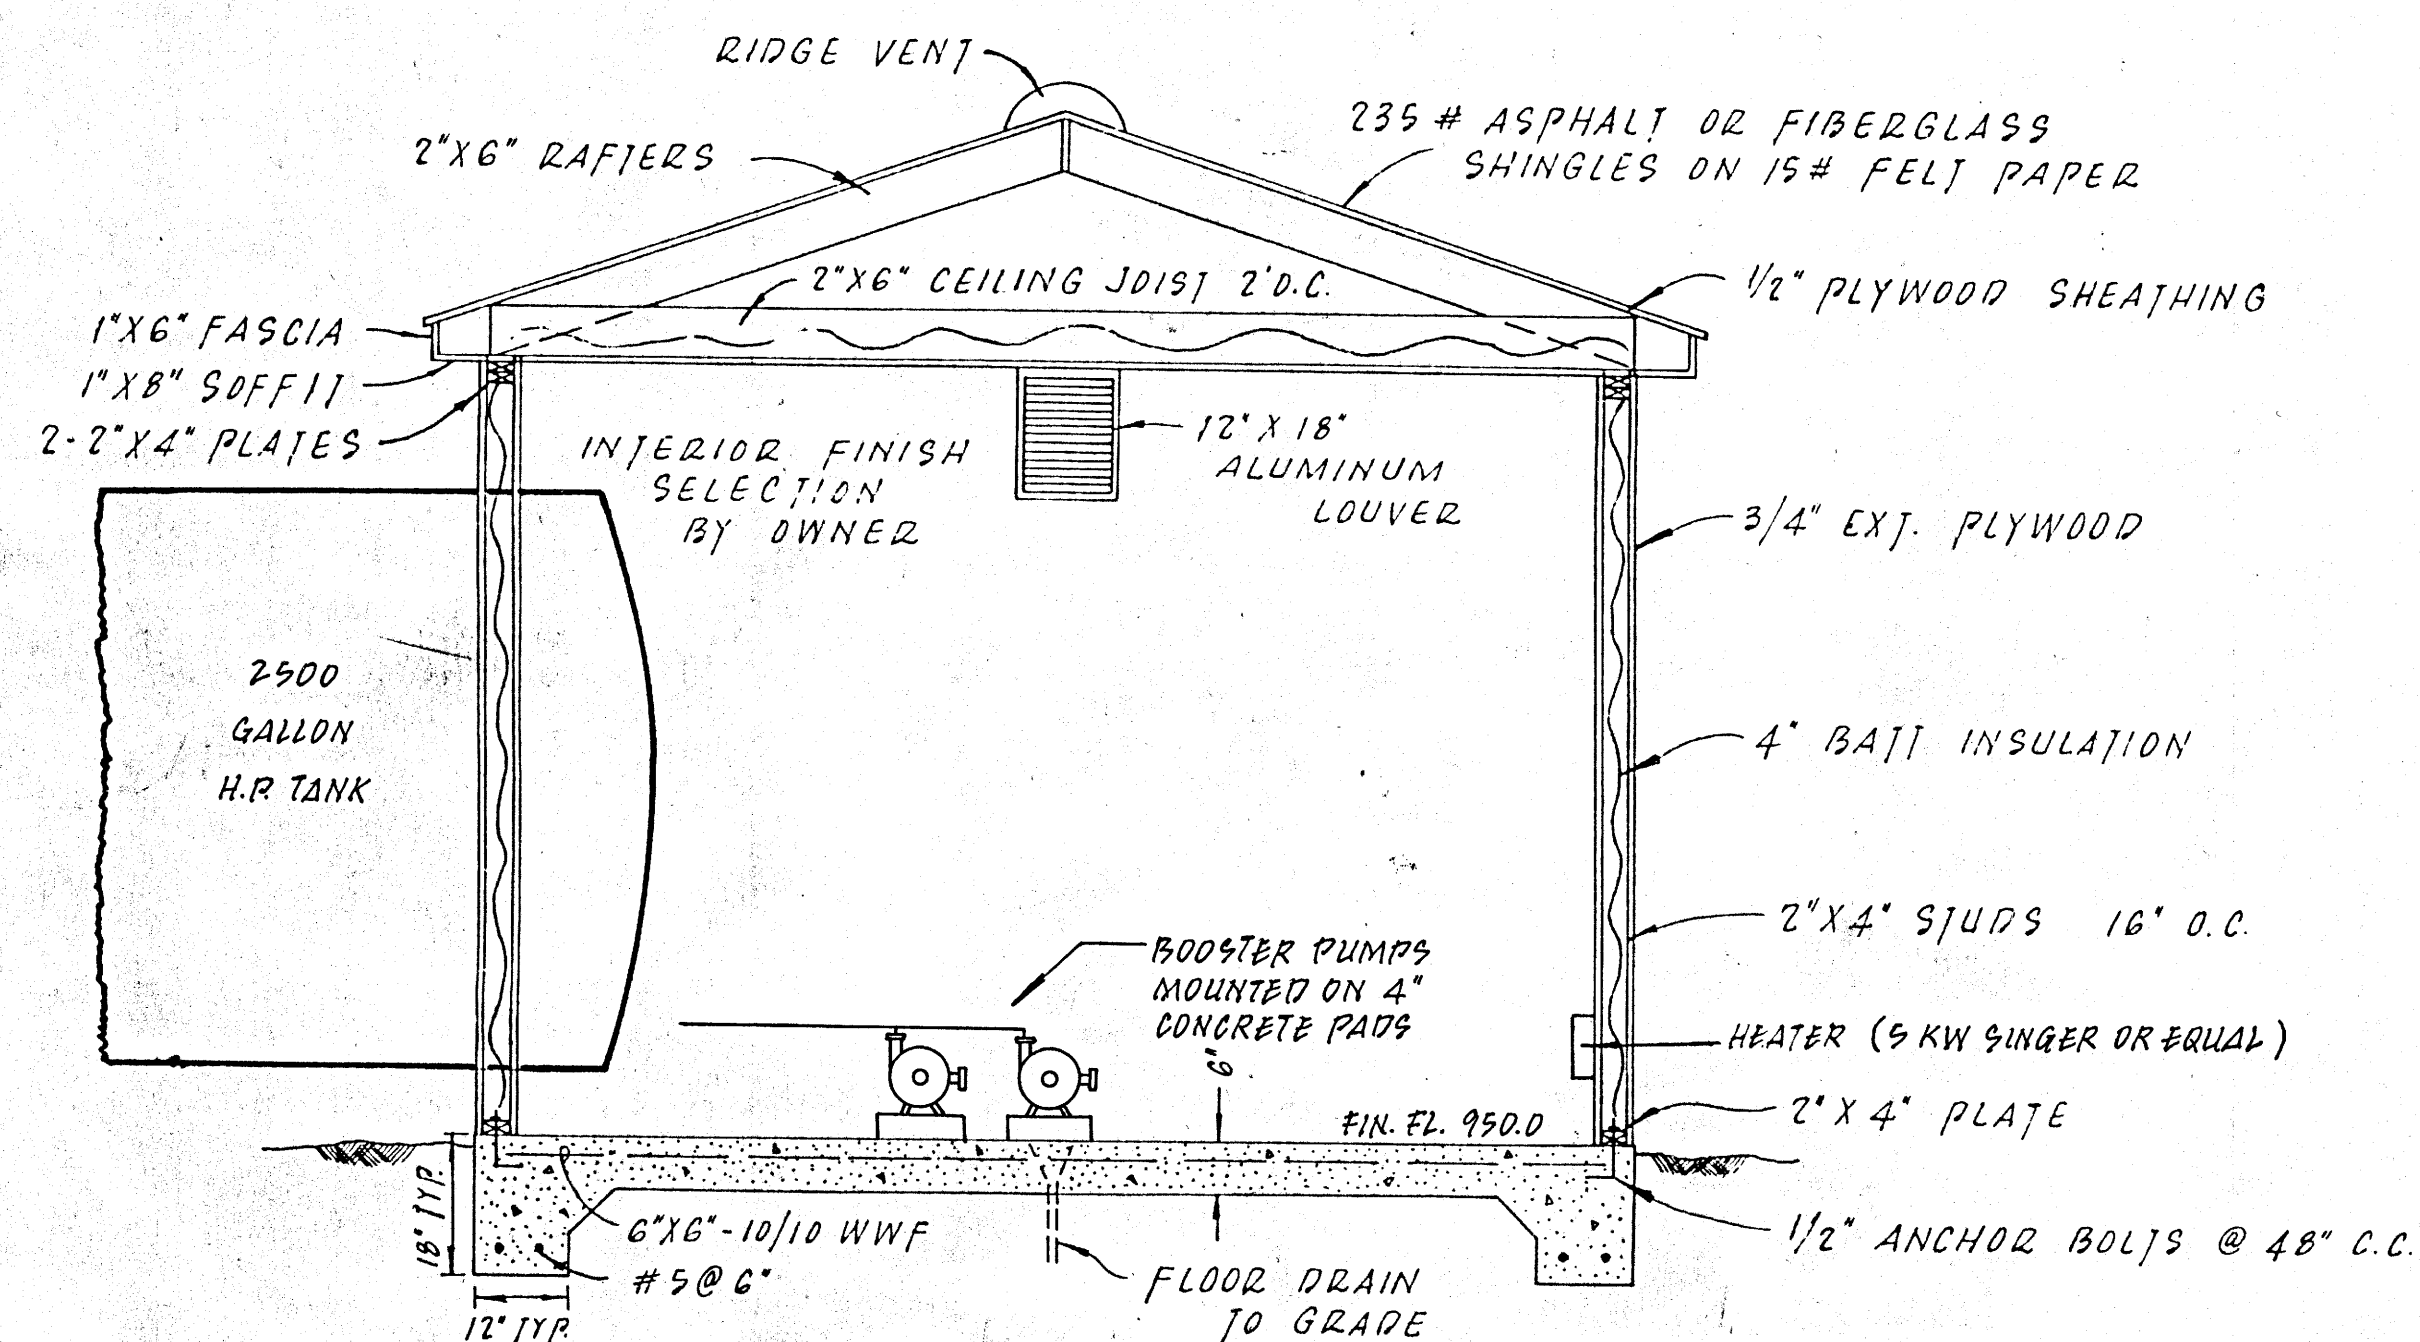

END VIEW
2500 GALLON H.P. TANK

NOTE: CONTACT TANK SHALL BE ASME APPROVED 2500 GALLON TANK. ALSO, UPON COMPLETION OF TANK INSTALLATION, THE TANK SHALL BE INSPECTED BY DEPT. OF LABOR AND INDUSTRY. A COPY OF THE LETTER VERIFYING THE INSPECTION SHALL BE SUBMITTED TO THE VIRGINIA DEPT. OF HEALTH.

NOTE: THESE PLANS ARE BASED ON THE ORIGINAL PLANS FOR WEST ARROWHEAD VILLAGE, DATED 12-6-89. THESE PLANS ARE REVISED TO SHOW CONNECTIONS FOR WELLS A, C, E AND F. THESE PLANS ARE "AS-BUILT" DRAWINGS.

Berkley Howell & Assoc. ENGINEERS • SURVEYORS • PLANNERS			
SCALE:	APPROVED BY:	DRAWN BY:	
DATE: 8-23-00		REVISED 1-22-01	
WEST ARROWHEAD VILLAGE			
PUMP HOUSE DETAILS			DRAWING NUMBER 5 OF 6

REVISED 1-22-01 PER HEALTH DEPARTMENT COMMENTS.