



AS BUILT

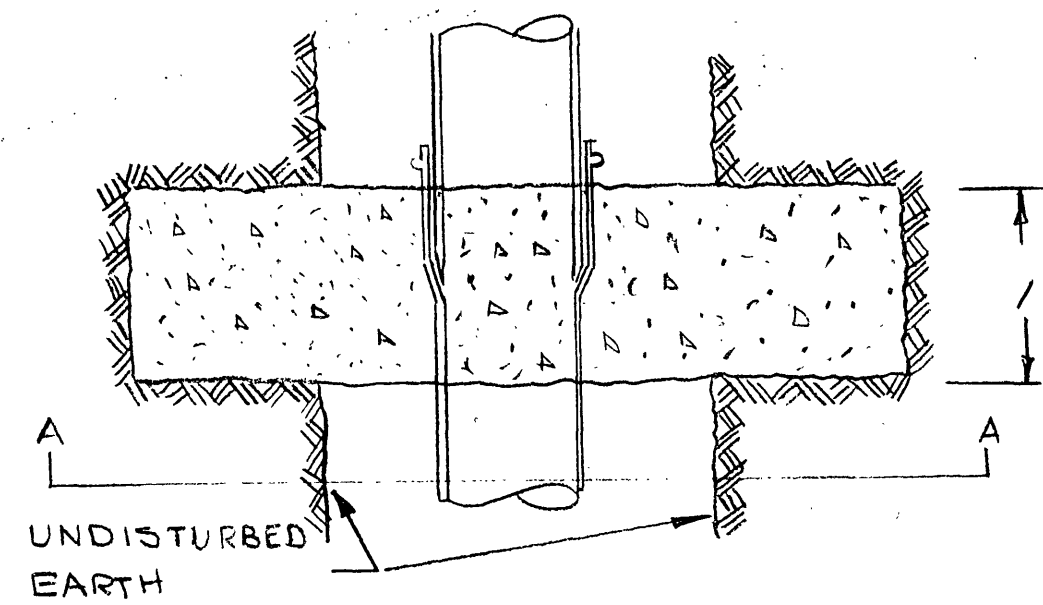

1. POUR CONCRETE AGAINST UNDISTURBED EARTH
2. ANCHOR BLOCK TO BE MONOLITHIC
3. CONCRETE TO BE 2000 lb TEST OR GREATER

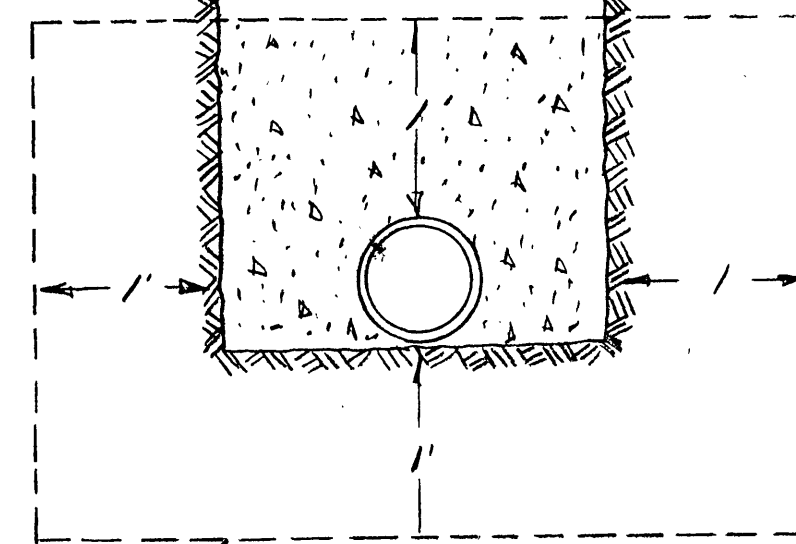

UNDISTURBED EARTH
A-A
ANCHOR BLOCK

INTERSTATE 581

EXISTING MANHOLE #14
TOP 1026.4
INV. 1020.9

M.H. "B" SHALL HAVE WATER TIGHT COVER & FRAME

BILLY H. HARBOUR
PROPERTY

EXISTING MANHOLE D
TOP 1084.0
INV. 1074.7

M.H. C
TOP 1074.7
INV. 1069.5

PUMP STATION
ABANDON
PLUG LINE TO STATION

GOLDEN KEY SHOPPING CENTER
3535 Franklin Rd
T# 5500116

K-Mart

AS BUILT

CONTRACTOR SHALL COMPLY WITH
CITY OF ROANOKE EROSION &
SEDIMENT CONTROL ORDINANCE

AS BUILT

PLAN AND PROFILE
OF
GOLDEN KEY SHOPPING CENTER SEWER MAIN

ROUTE 220 SOUTH
ROANOKE, VIRGINIA


SCALE: AS NOTED

NOVEMBER 9, 1982

T. P. PARKER & SON
ENGINEERS & SURVEYORS, LTD.

Approved in so far as this department has
jurisdiction.
No construction to commence within public
right of way without first obtaining permit
from Director of Public Works

City Engineer

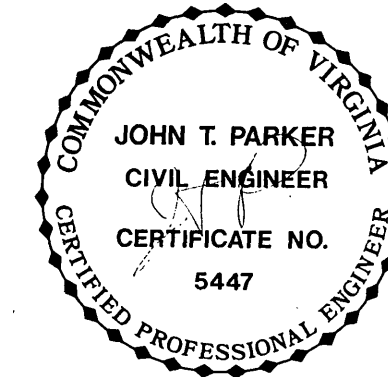

W.O. 5672
N.B. 5-94

SCALE: HOR. 1" = 25'
VERT. 1" = 10'

NOTE:
SEWER TO BE CONSTRUCTED TO CITY OF
ROANOKE SEWER SPECIFICATIONS

BENCH MARK
TOP MANHOLE 14
ELEVATION 1026.4

INSTALL ANCHOR BLOCKS
AT EACH JOINT (MAX 20 FT)
BETWEEN MANHOLES B & C
SEE ANCHOR BLOCK DETAIL

ADD MATERIAL TO
MAINTAIN 3 FT. COVER

TOP 1032.5
INV. 1027.0

EXISTING
MANHOLE
TOP 1026.4
INV. 21" 1020.9
INV. FROM B" PIPE 1022.0

AS BUILT

Golden Key
Shopping Center