



G - GAS LINE
W - WATER LINE
T - UNDERGROUND TELEPHONE CABLE
M.H. - MANHOLE
S.S. - SANITARY SEWER

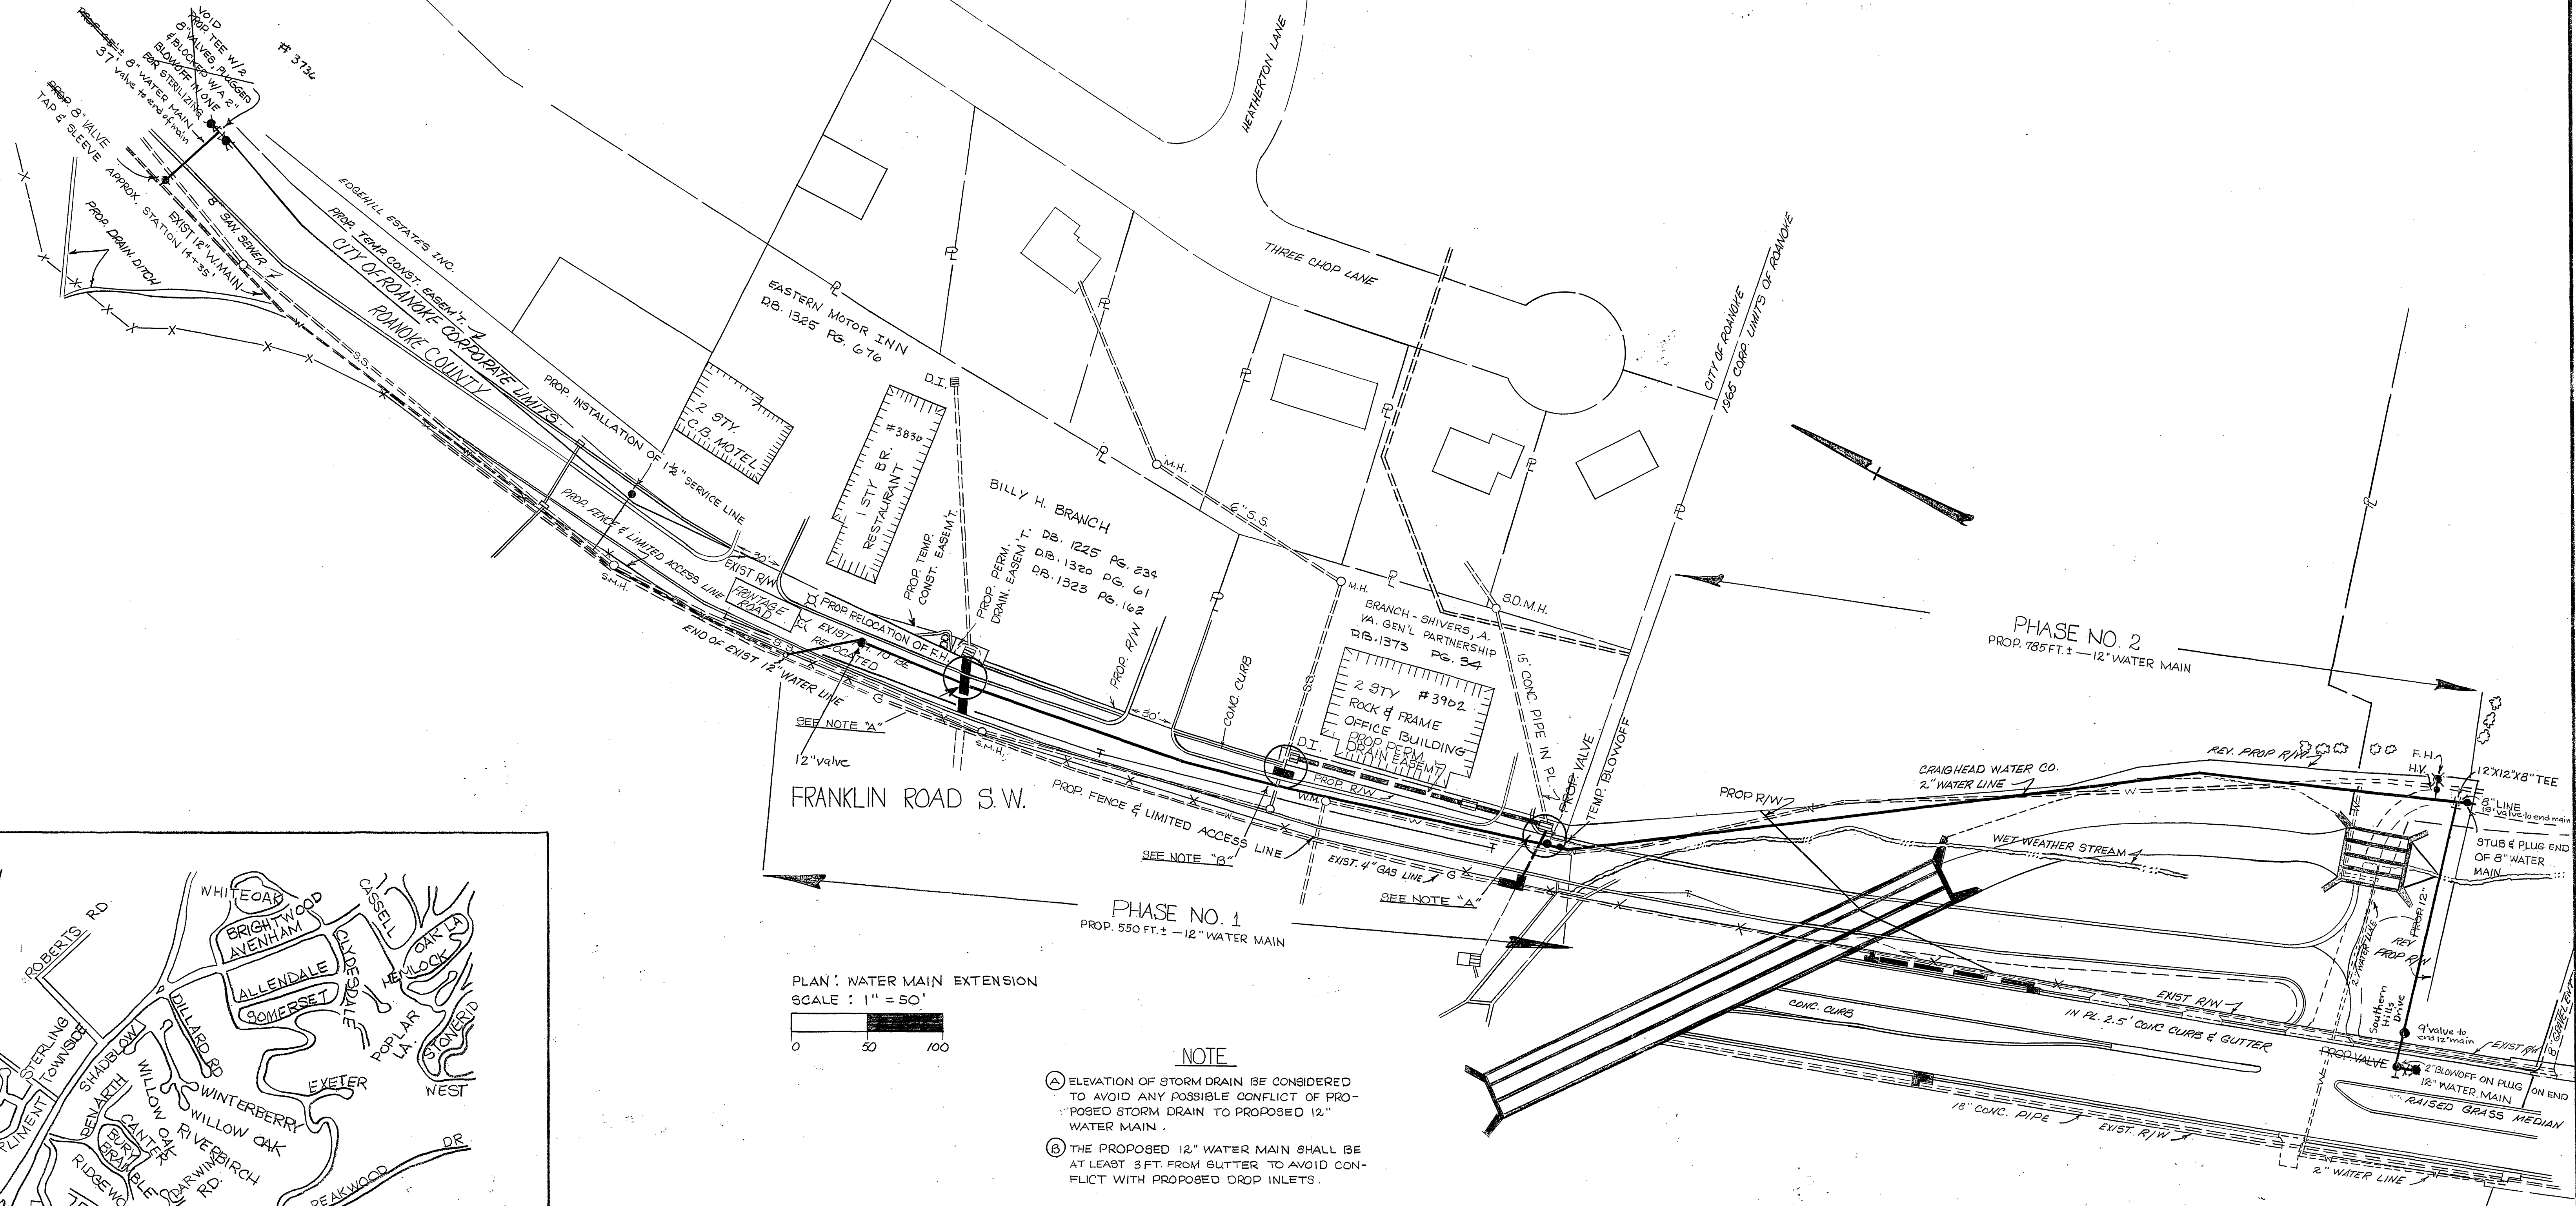

(A) ELEVATION OF STORM DRAIN BE CONSIDERED TO AVOID ANY POSSIBLE CONFLICT OF PROPOSED STORM DRAIN TO PROPOSED 12" WATER MAIN .

(B) THE PROPOSED 12" WATER MAIN SHALL BE AT LEAST 3 FT. FROM GUTTER TO AVOID CONFLICT WITH PROPOSED DROP INLETS .

EXISTING UTILITIES TO BE ASCERTAINED
IN THE FIELD PRIOR TO CONSTRUCTION

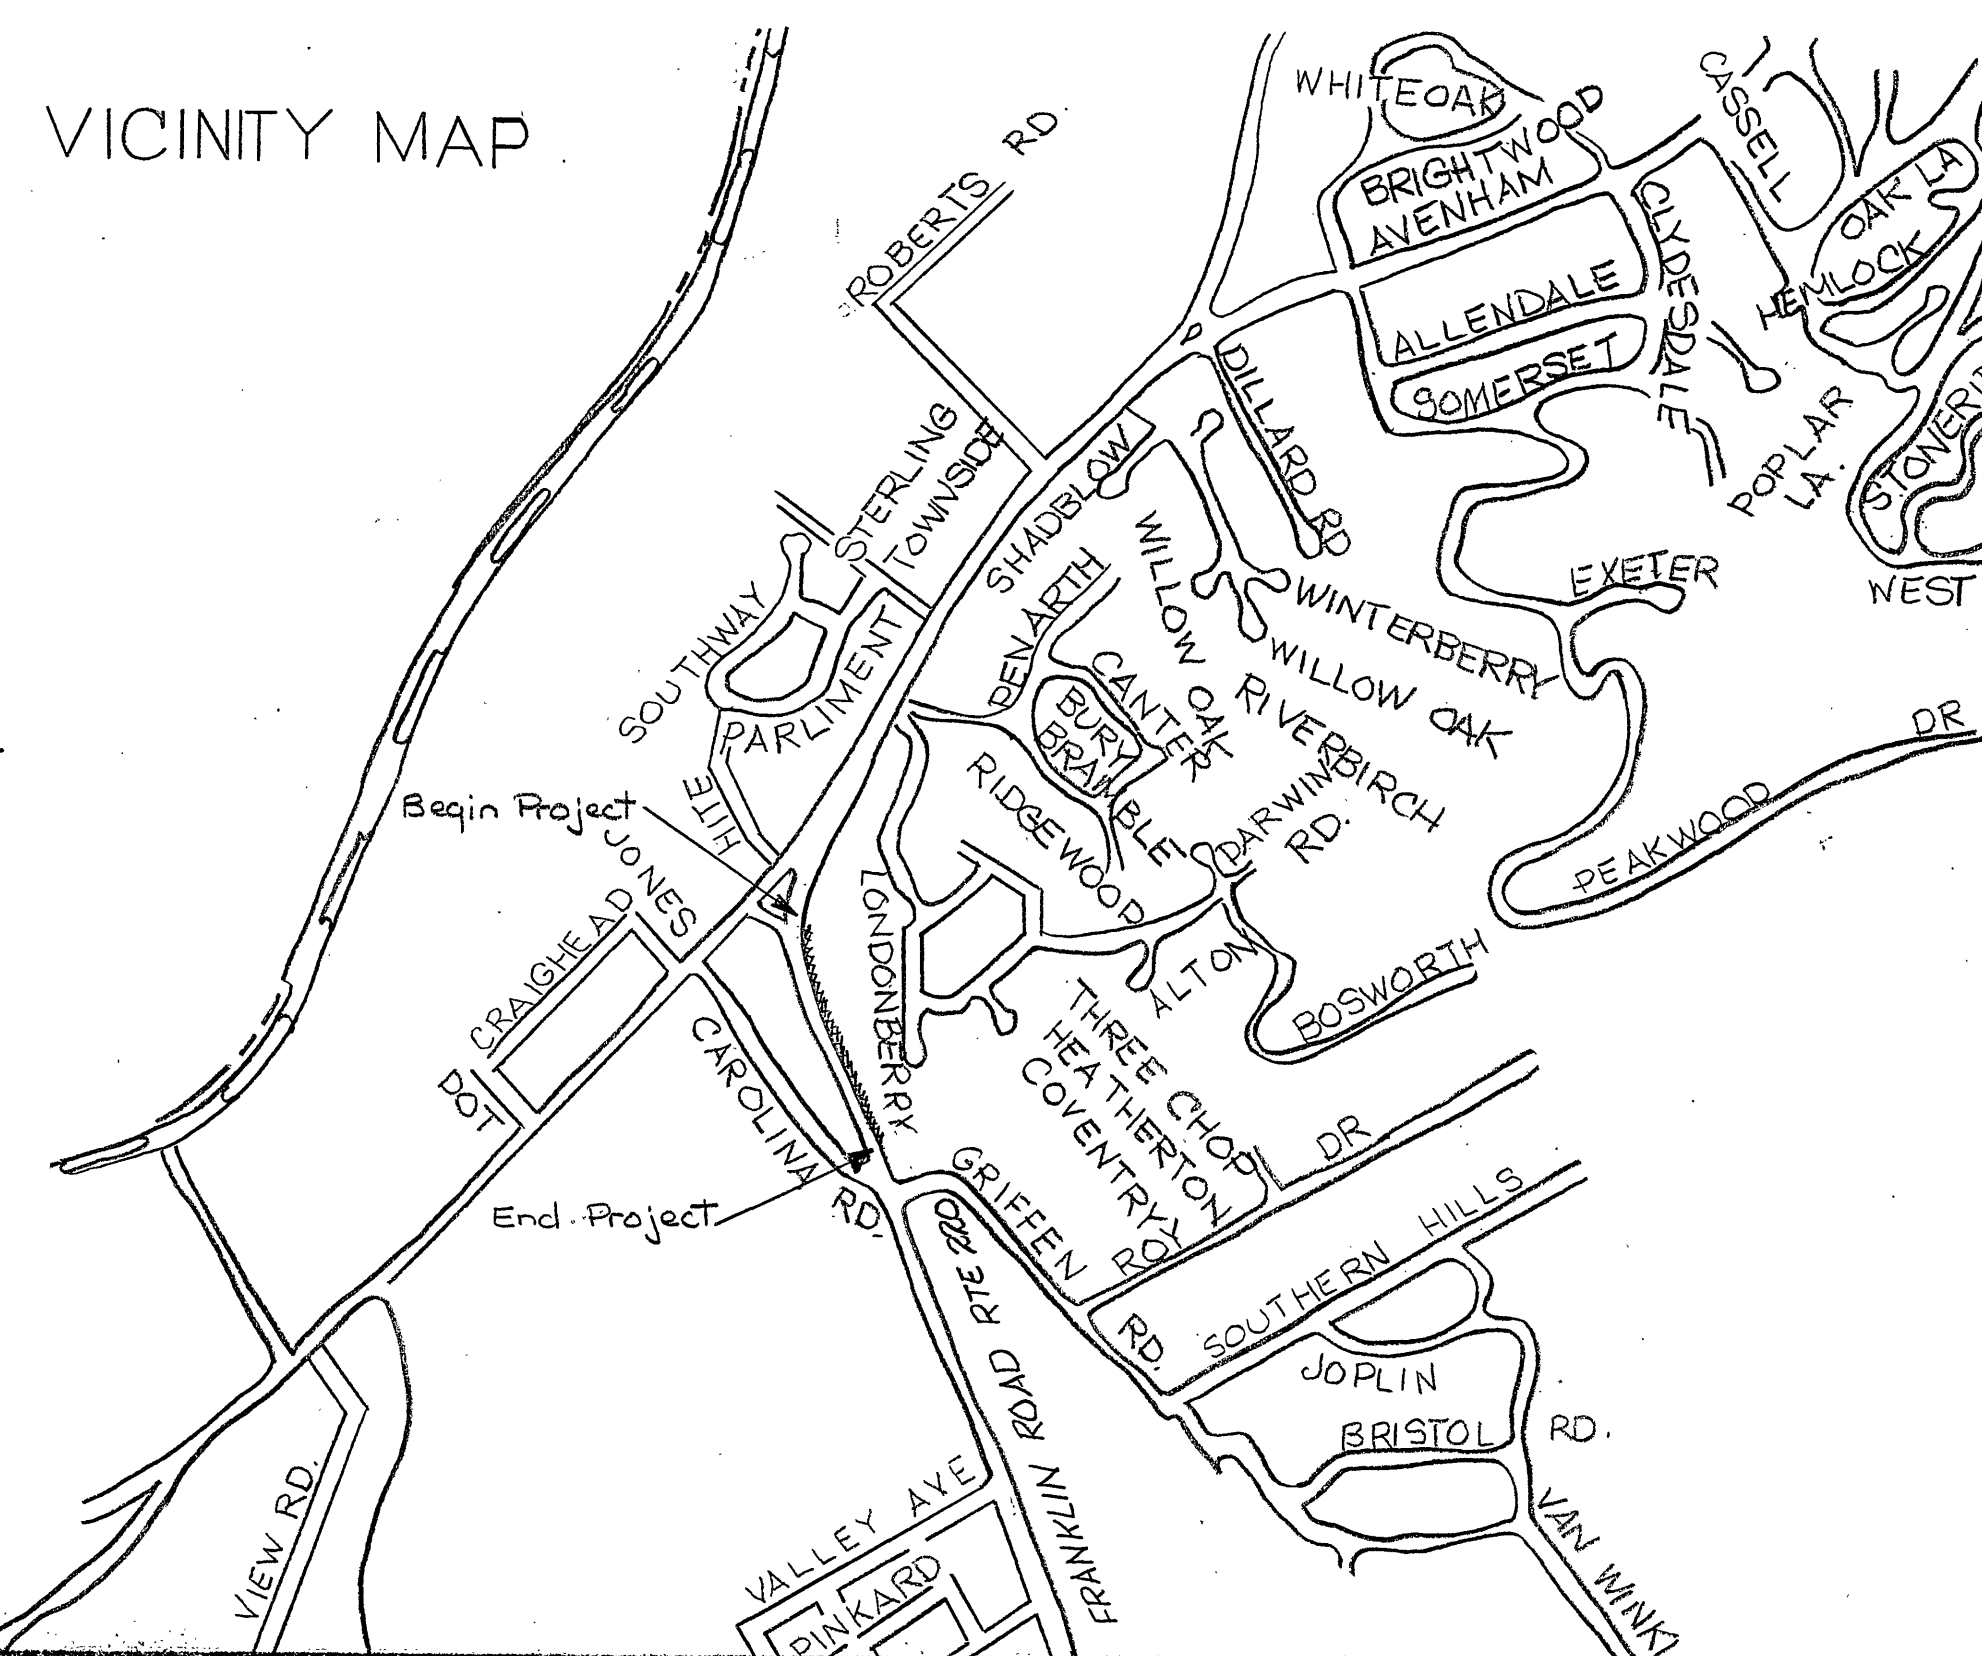

DATE PRINTED: 7-79

DATE SHIP. 7-79

FEET	MAIN	SIZE	VALVE	VALVE #	#
13	19	2	1		#
45		8	2		*

E.H. SNIP.

E.H. STUB ONLY

SERV. INS. BY:

MAIN INS. BY: U.L.F.

NO. 301 SERV. INS.

CITY # 60

DEPT. INSP.

J.W.M

3x
 1
 2
 2

[Signature]
 DIRECTOR UTILITIES & OPERATIONS
 [Signature]
 CITY ENGINEER OF ROANOKE VA.
 [Signature]
 DIRECTOR OF PUBLIC WORKS
 [Signature]
 For AGENT FOR ROANOKE PLANNING COMM.

PLAN NO. 78-8
Tax Map # 117 + 548

DATE	REV.	DESCRIPTION	BY
			CITY ENGINEER
PROP. 12" WATER MAIN EXTENSION FROM THE PRESENT LOCATION AT RTE. 220 FRANKLIN RD TO RKE. CITY CORP. LIMITS.			DRAWN M.P.C. CHECKED M.C. APP'D C.A. DATE 8-2-78
CITY OF ROANOKE OFFICE OF CITY ENGINEER ROANOKE, VIRGINIA			JOB NO. 76-8 SHEET 1
CONTRACTOR MUST VERIFY ALL DIMENSIONS AT PROJECT BEFORE PROCEEDING WITH WORK			
			OF 1