


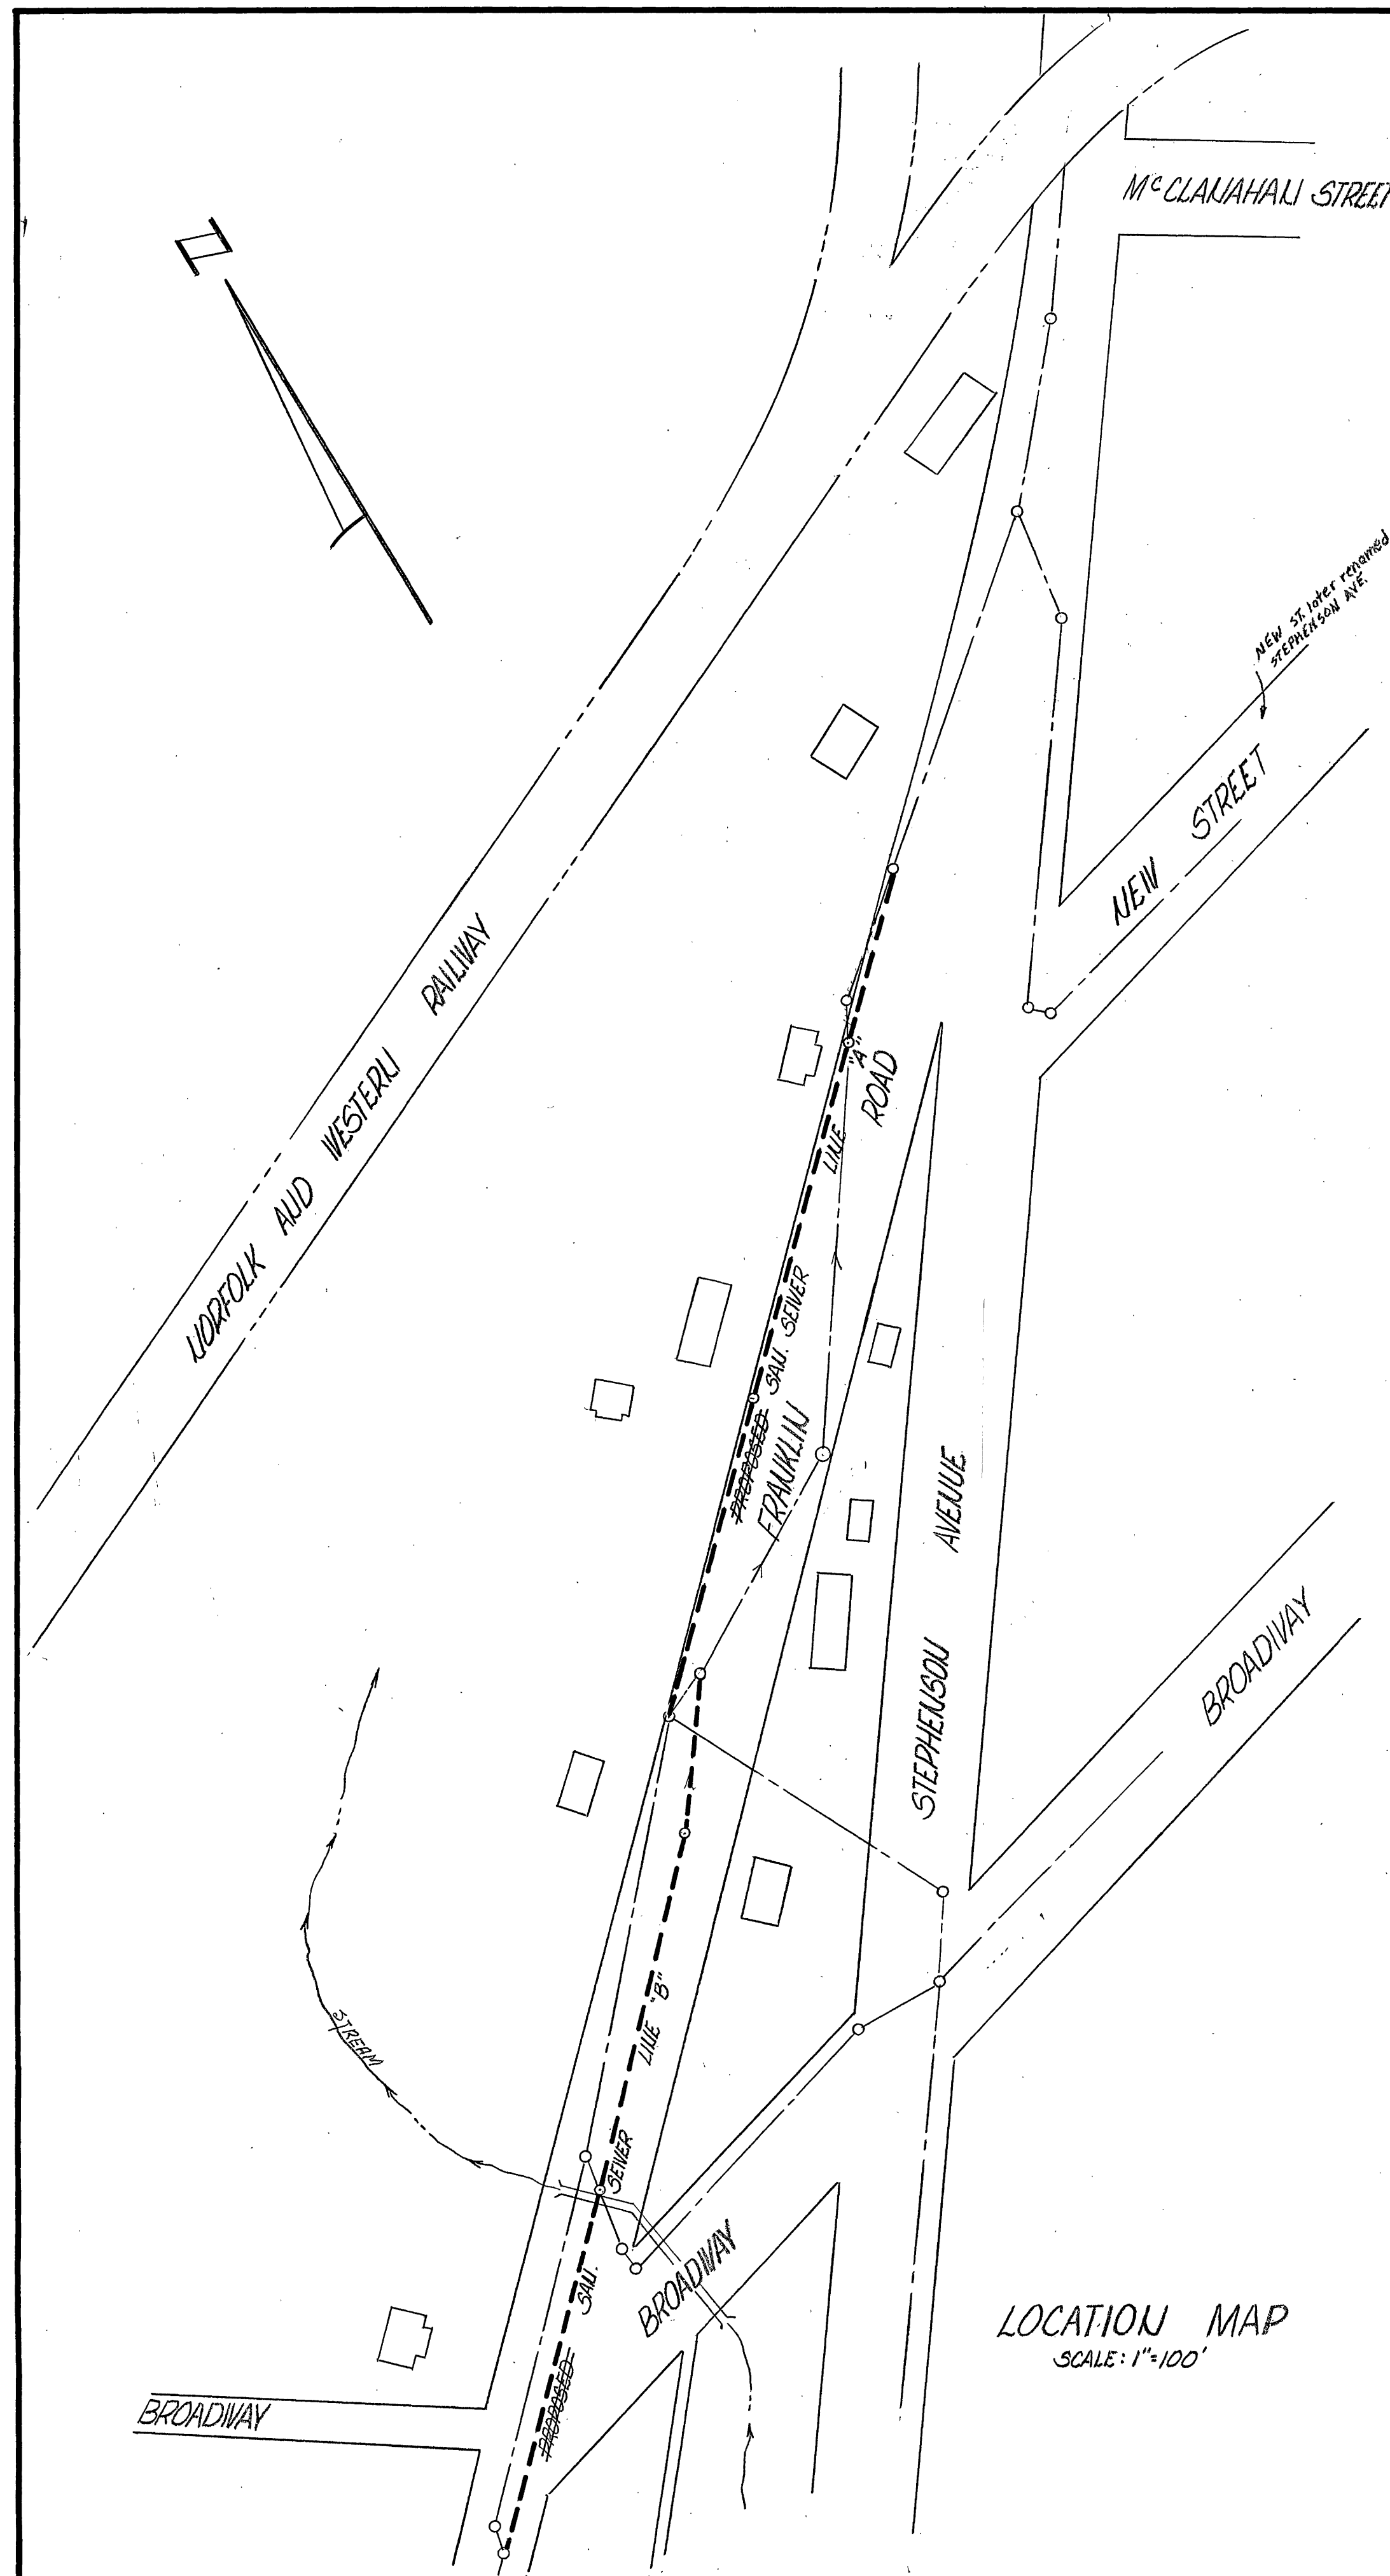

PLANS *OF* PROPOSED SANITARY SEWER *ON* FRANKLIN ROAD NORTH OF BROADWAY

AS BUILT F.B. 507
SEE SHEETS 2 THRU 4

DESCRIPTION OF REVISION		DATE
OFFICE OF CITY ENGINEER ROANOKE VIRGINIA		
SEE TITLE ABOVE		
SCALE: AS SHOWN	APPROVED: <i>William F. Clark</i> CITY ENGINEER	
DATE: OCTOBER 28, 1966	<i>H. Charles</i> DIRECTOR OF PUBLIC WORKS	
SHEET 1 OF 4		PLAN NO. 5012