

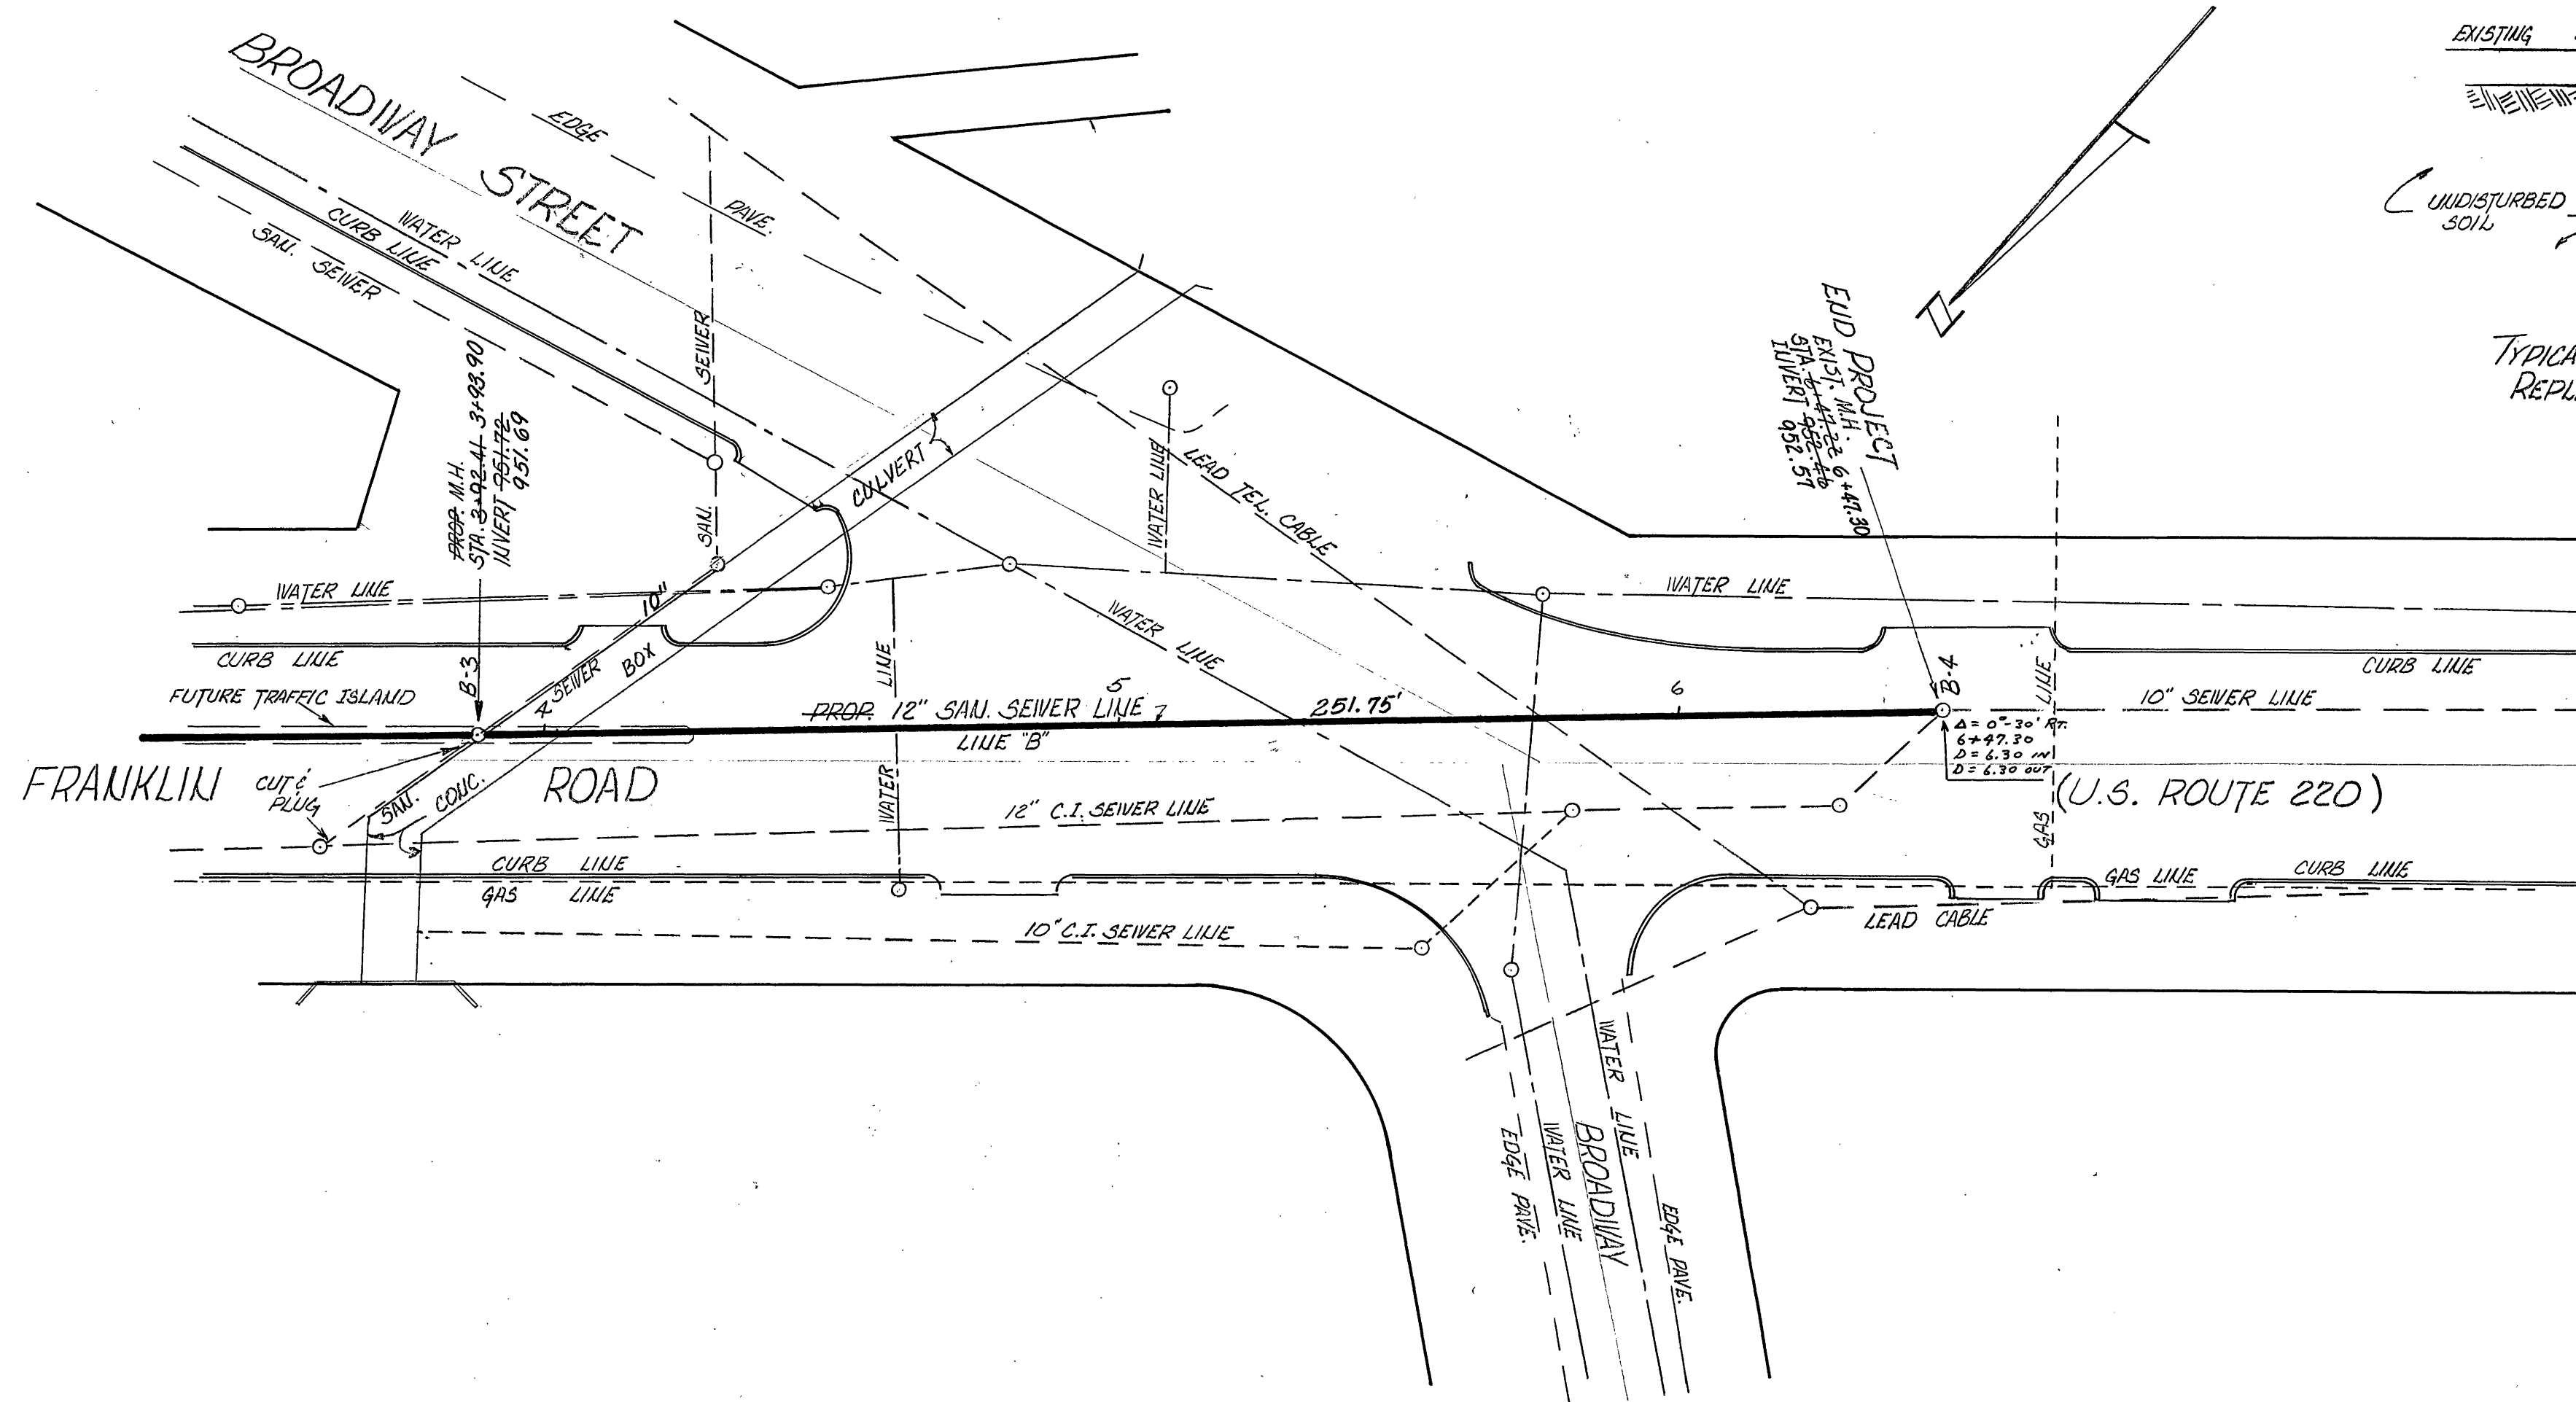
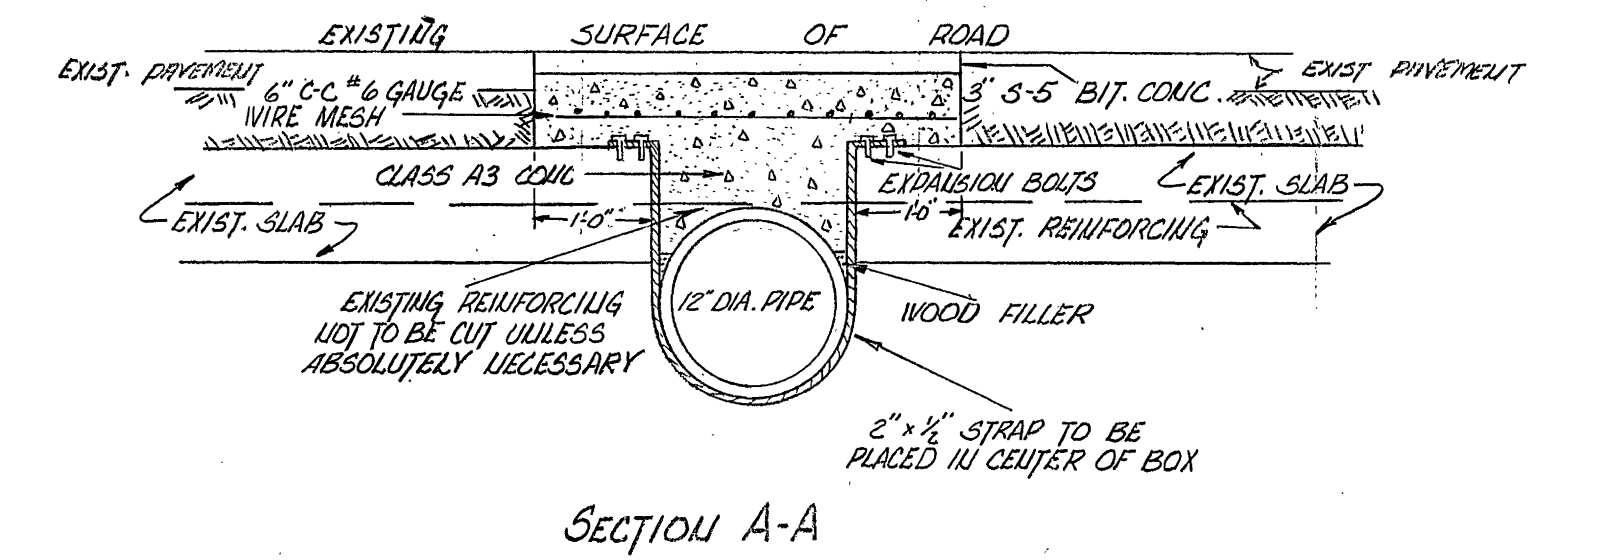


PLAN	DATE	BY
SURVEYED		
NOTE BOOK		
NO. 473		
STRUCTURE NOTING CHKO.		

PROFILE	DATE	BY
SURVEYED		
NOTE BOOK		
NO. 473		
STRUCTURE NOTING CHKO.		

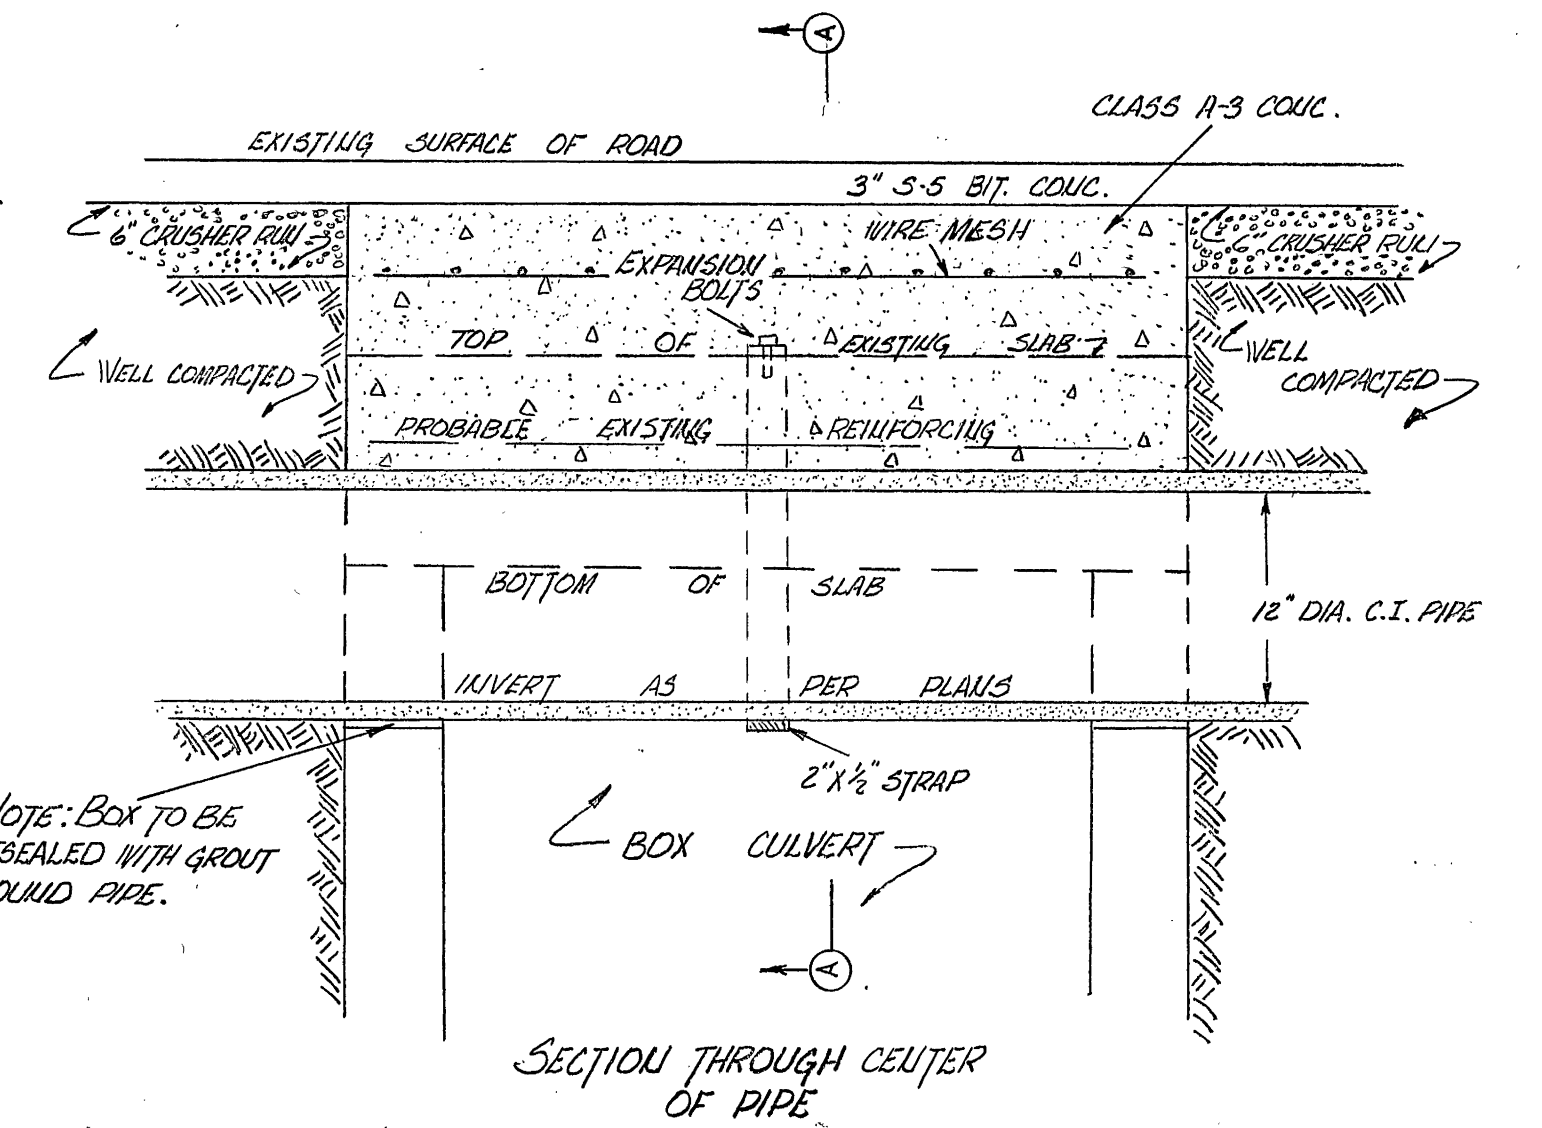

SCALE: 1" = 25'

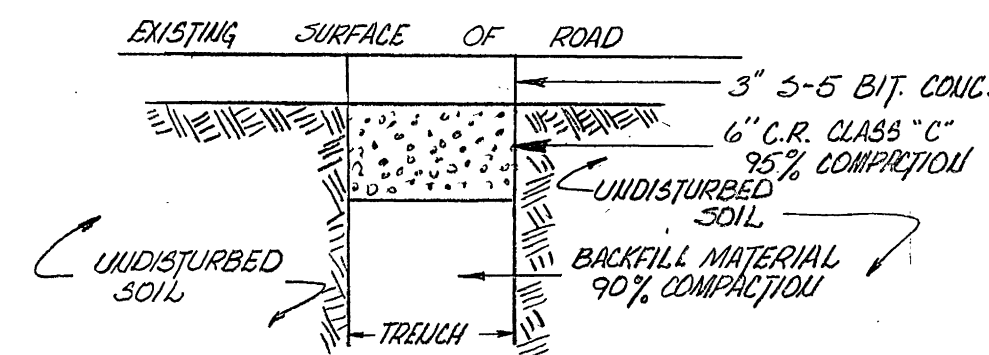

SEE SHEET 3 FOR PROFILE
OF THIS AREA AND GENERAL NOTES.
BENCH MARK ALSO ON SHEET 3.

As Built
F.B. 507
Page 46