


PROJECT LOCATION MAP

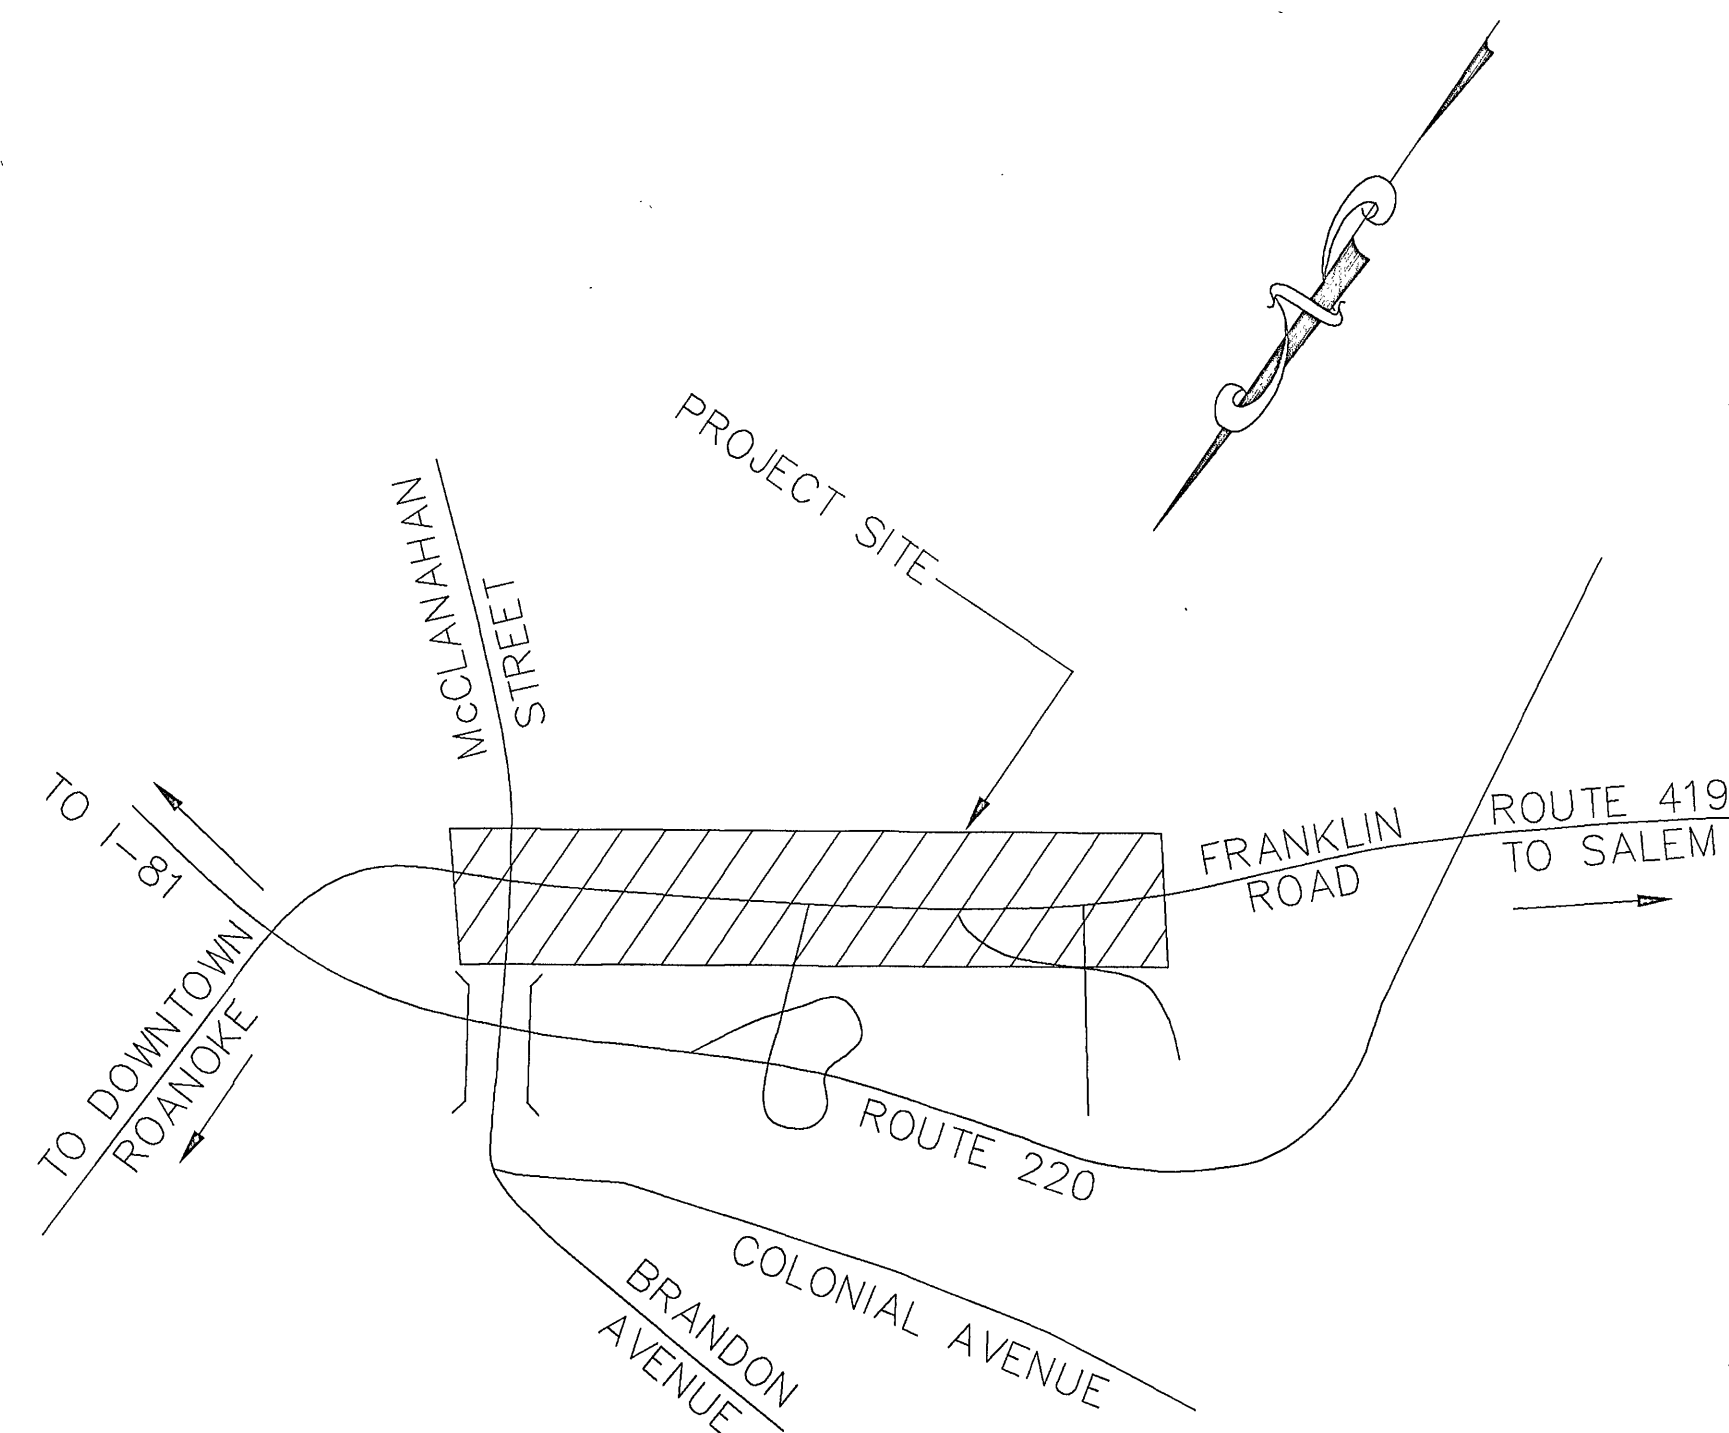

OFFICE OF CITY ENGINEER
ROOM 350
MUNICIPAL BUILDING
215 CHURCH AVENUE, S.W.
ROANOKE, VIRGINIA 24011


INDEX OF SHEETS

SHEET #1 OF 16	COVER
SHEET #2 OF 16	QUANTITIES & SHEET LAYOUT
SHEET #3 OF 16	ABBREVIATIONS, LEGEND, & GENERAL NOTES
SHEET #4 OF 16	PLAN & PROFILE
SHEET #5 OF 16	PLAN & PROFILE
SHEET #6 OF 16	PLAN & PROFILE
SHEET #7 OF 16	PLAN & PROFILE
SHEET #8 OF 16	PLAN & PROFILE
SHEET #9 OF 16	PLAN & PROFILE
SHEET #10 OF 16	PLAN & PROFILE
SHEET #11 OF 16	PLAN & PROFILE
SHEET #12 OF 16	PAVEMENT MARKING PLAN
SHEET #13 OF 16	PAVEMENT MARKING PLAN
SHEET #14 OF 16	STANDARD DETAILS
SHEET #15 OF 16	STANDARD DETAILS
SHEET #16 OF 16	STANDARD DETAILS

CONSULTING ENGINEERS

LMW P.C.
ENGINEERING • ARCHITECTURE • SURVEYING
☎ (540) 345-0675 102 ALBEMARLE AVE., S.E.
FAX (540) 342-4456 ROANOKE, VIRGINIA 24013

COMMISSION NUMBER: 1497

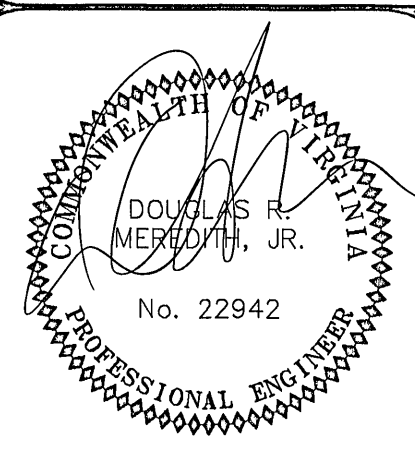

PROJECT NAME

FRANKLIN ROAD
WATER LINE
REPLACEMENT PROJECT

PROJECT NUMBER: 6366

REVISION BY	DESCRIPTION:	DATE
REVISION BY	DESCRIPTION:	DATE
REVISION BY	DESCRIPTION:	DATE
REVISION BY	DESCRIPTION:	DATE

APPROVED FOR CONSTRUCTION

ROANOKE CITY ENGINEER

DATE

DIRECTOR OF PUBLIC WORKS

DATE

DIRECTOR OF UTILITIES AND OPERATIONS

DATE

DATE

DATE

ADVERTISED DATE:

SET, NUMBER:

SHEET NUMBER: 1 OF 16

RECORD DRAWINGS 5/27/99

DWG: 1497CVR.DWG