
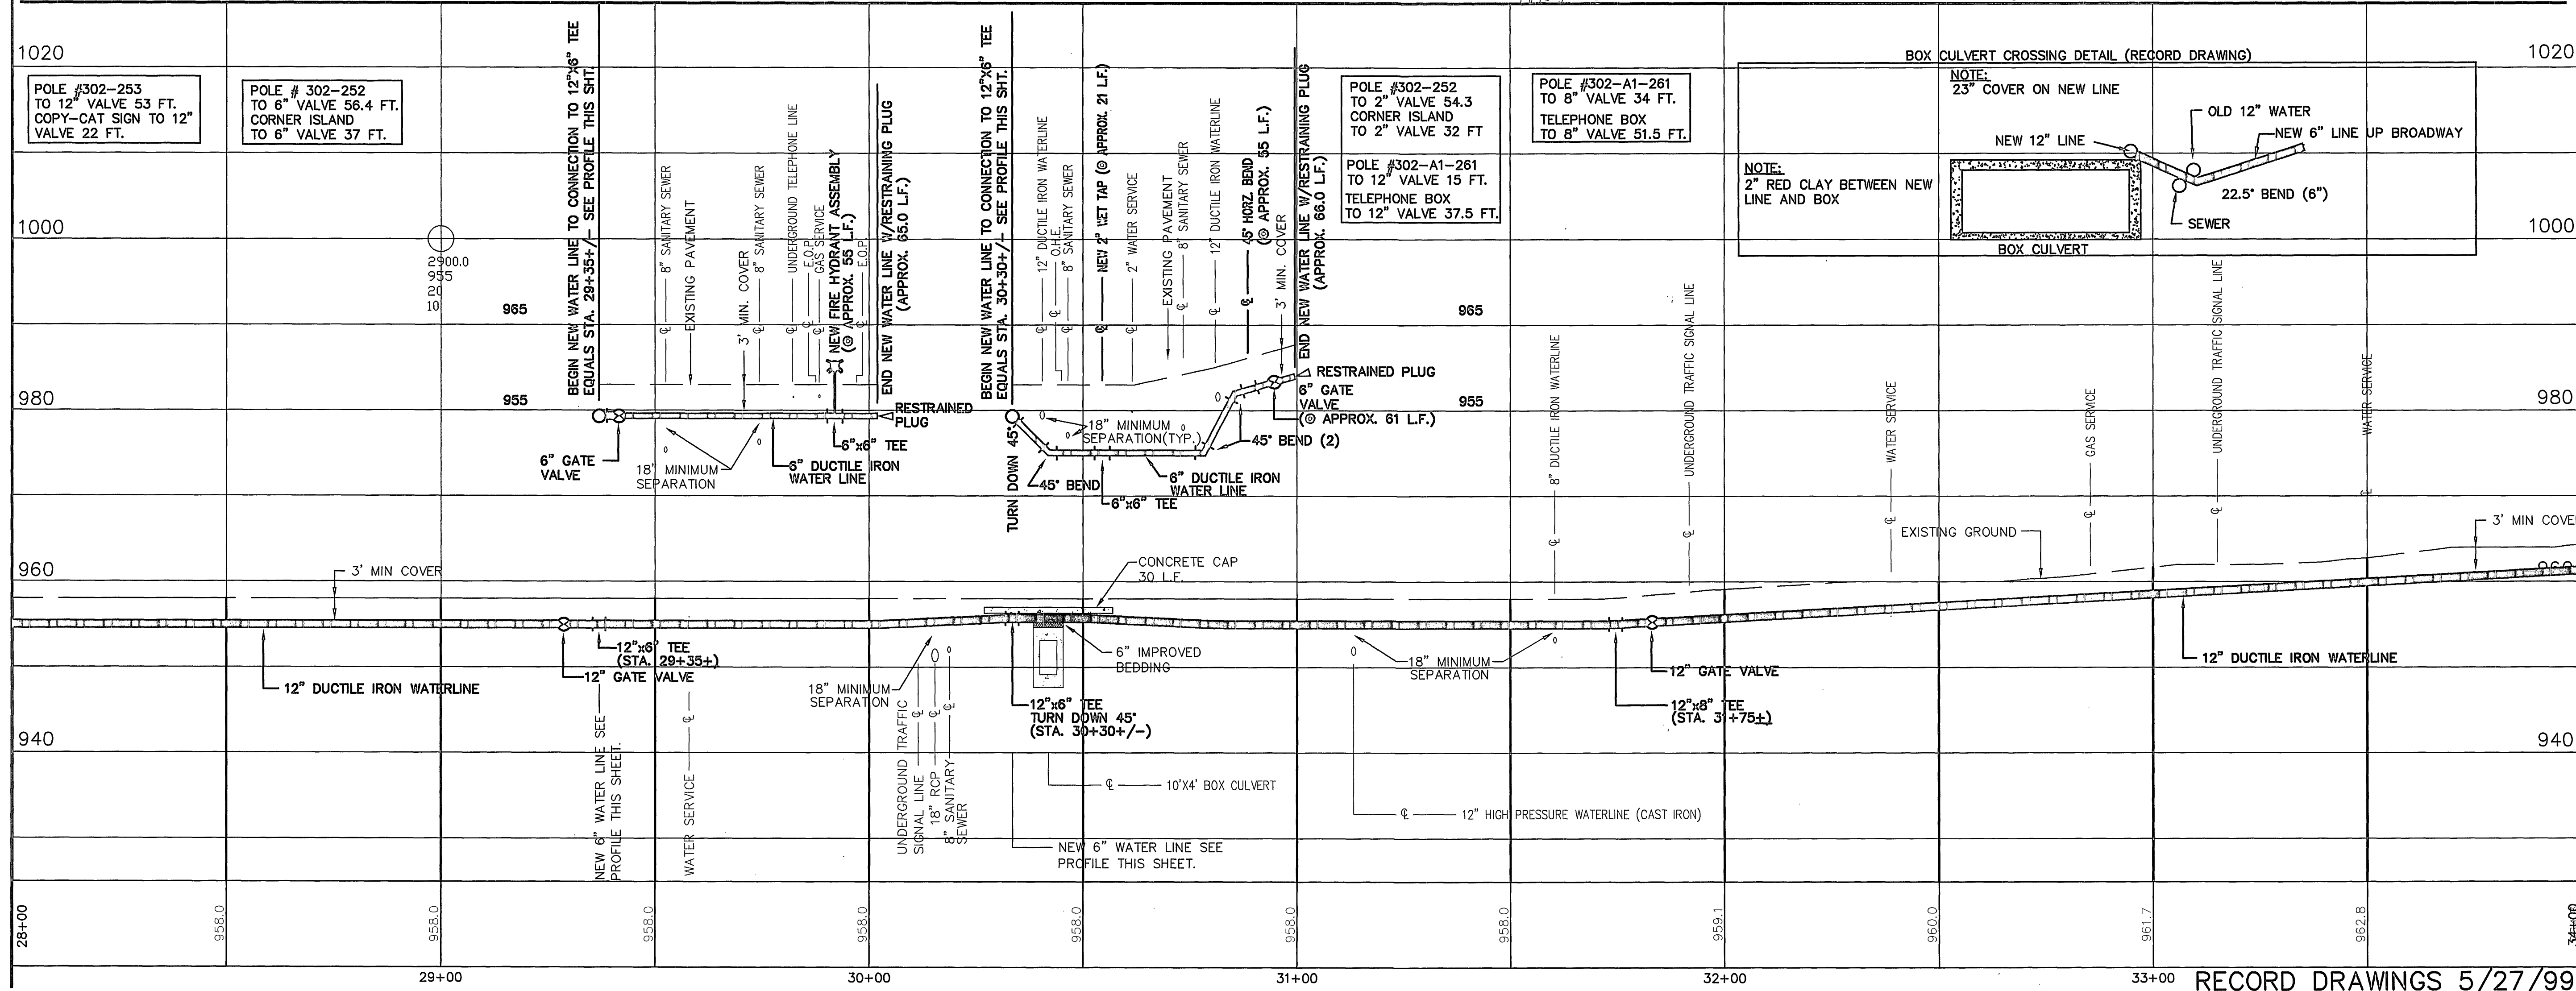


MATCH LINE SHEET #6

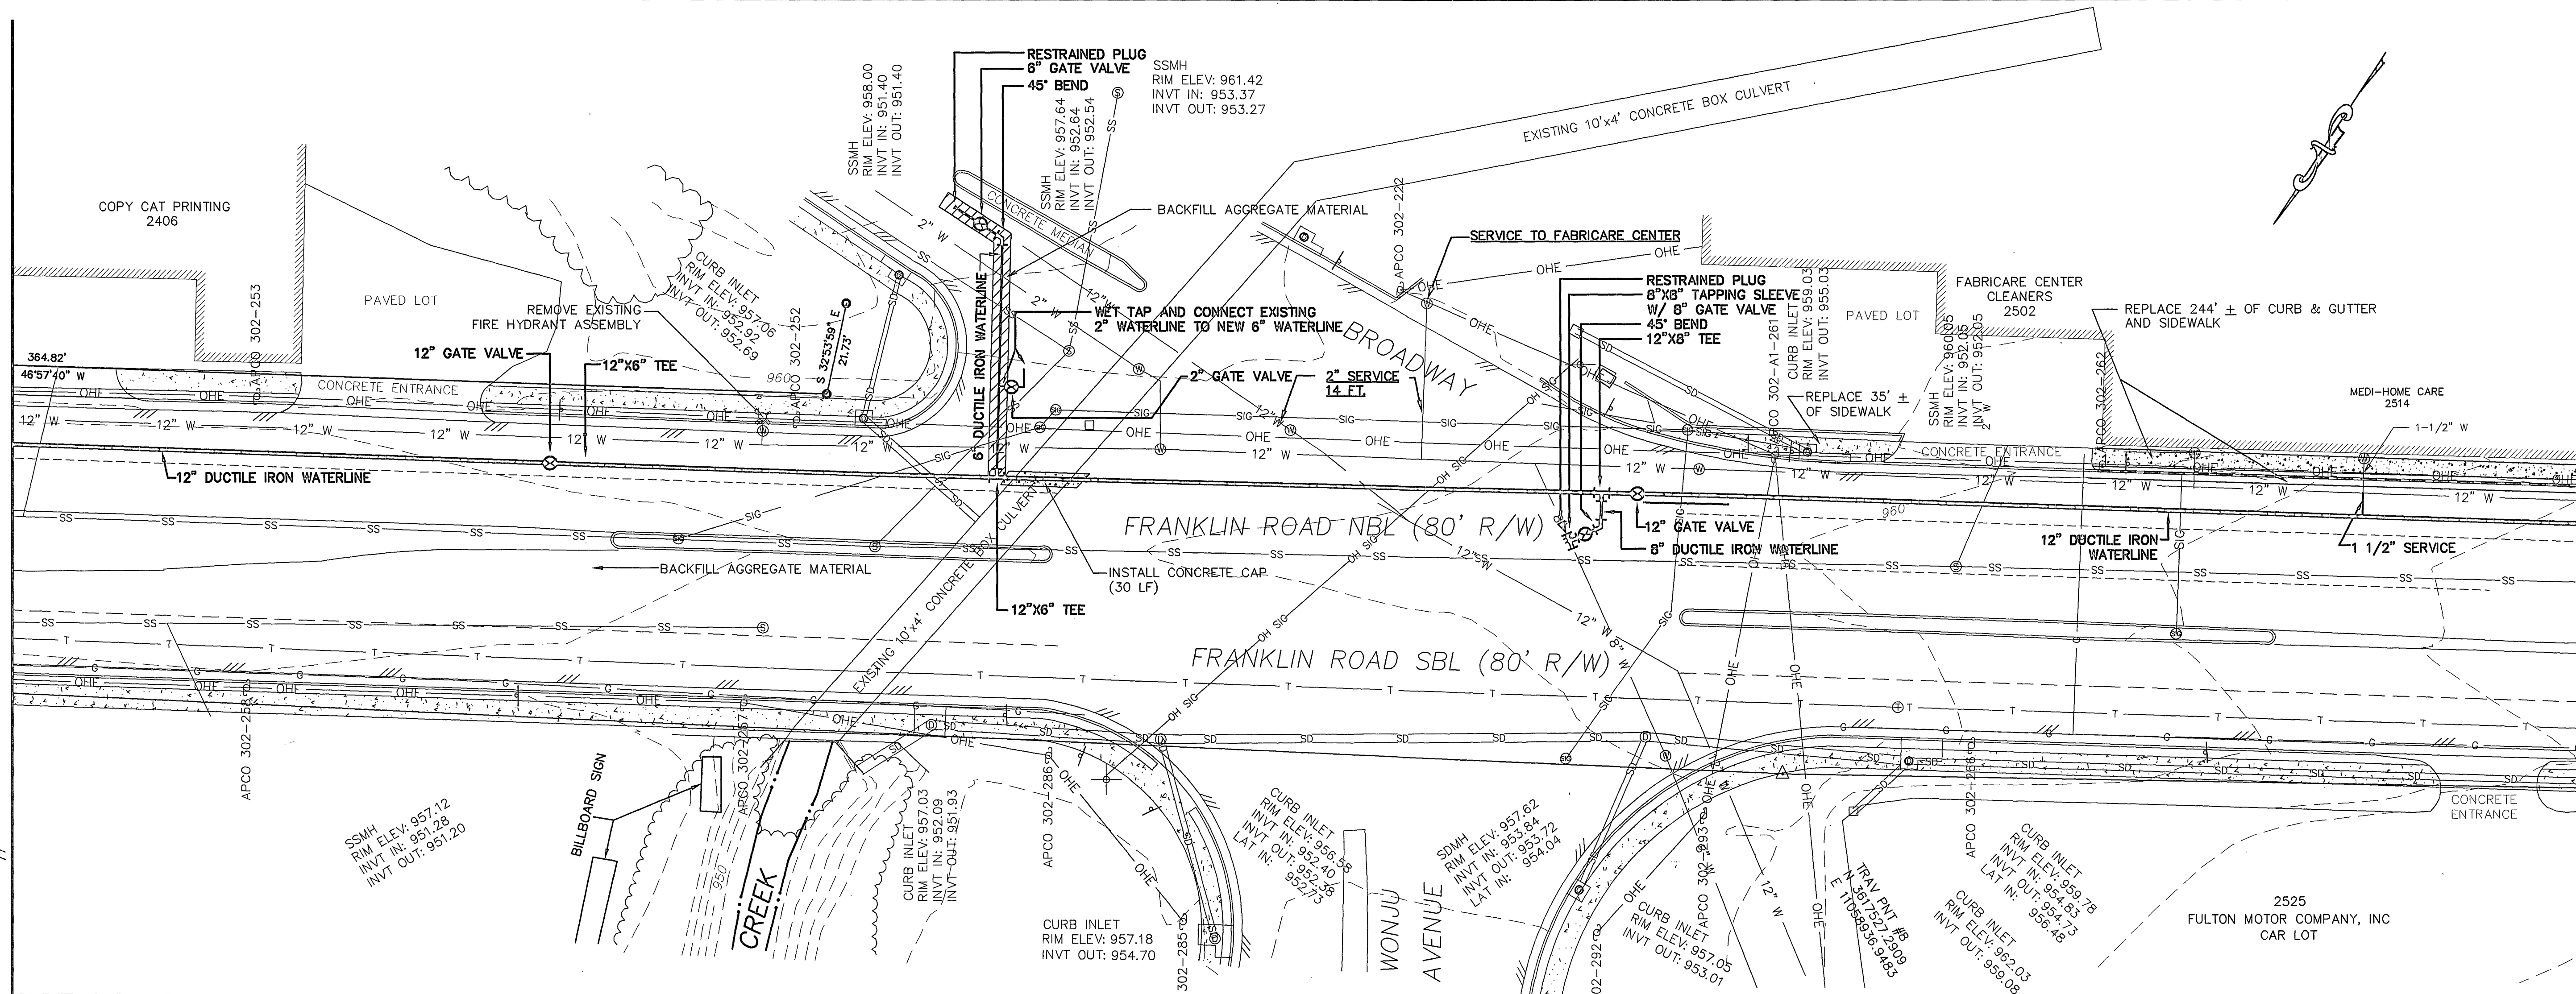


RECORD DRAWINGS 5/27/99

MATCH LINE SHEET #8

FRANKLIN ROAD WATER MAIN  
REPLACEMENT PROJECT  
CITY OF ROANOKE, VIRGINIA

| NO. | DATE | DESCRIPTION | BY |
|-----|------|-------------|----|
|     |      |             |    |
|     |      |             |    |
|     |      |             |    |
|     |      |             |    |

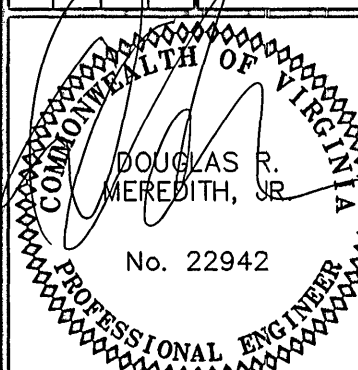

|                |                                 |
|----------------|---------------------------------|
| Designed By    | DME                             |
| Drawn By       | DME/JDC                         |
| Checked By     | RCW                             |
| Approved By    | RCW                             |
| Submitted By   | DRM                             |
| Drawing        | 1497SH7.DWG                     |
| Date           | 4/2/98                          |
| Scale          | HOR: 1" = 20'<br>VERT: 1" = 10' |
| Commission No. | 1497                            |

Sheet 7 of 16

LMWP.C.  
ENGINEERING ARCHITECTURE SURVEYING  
102 ALBEMARLE AVE., S.E.  
ROANOKE, VIRGINIA 24013  
(540) 345-0675  
FAX (540) 345-4456