
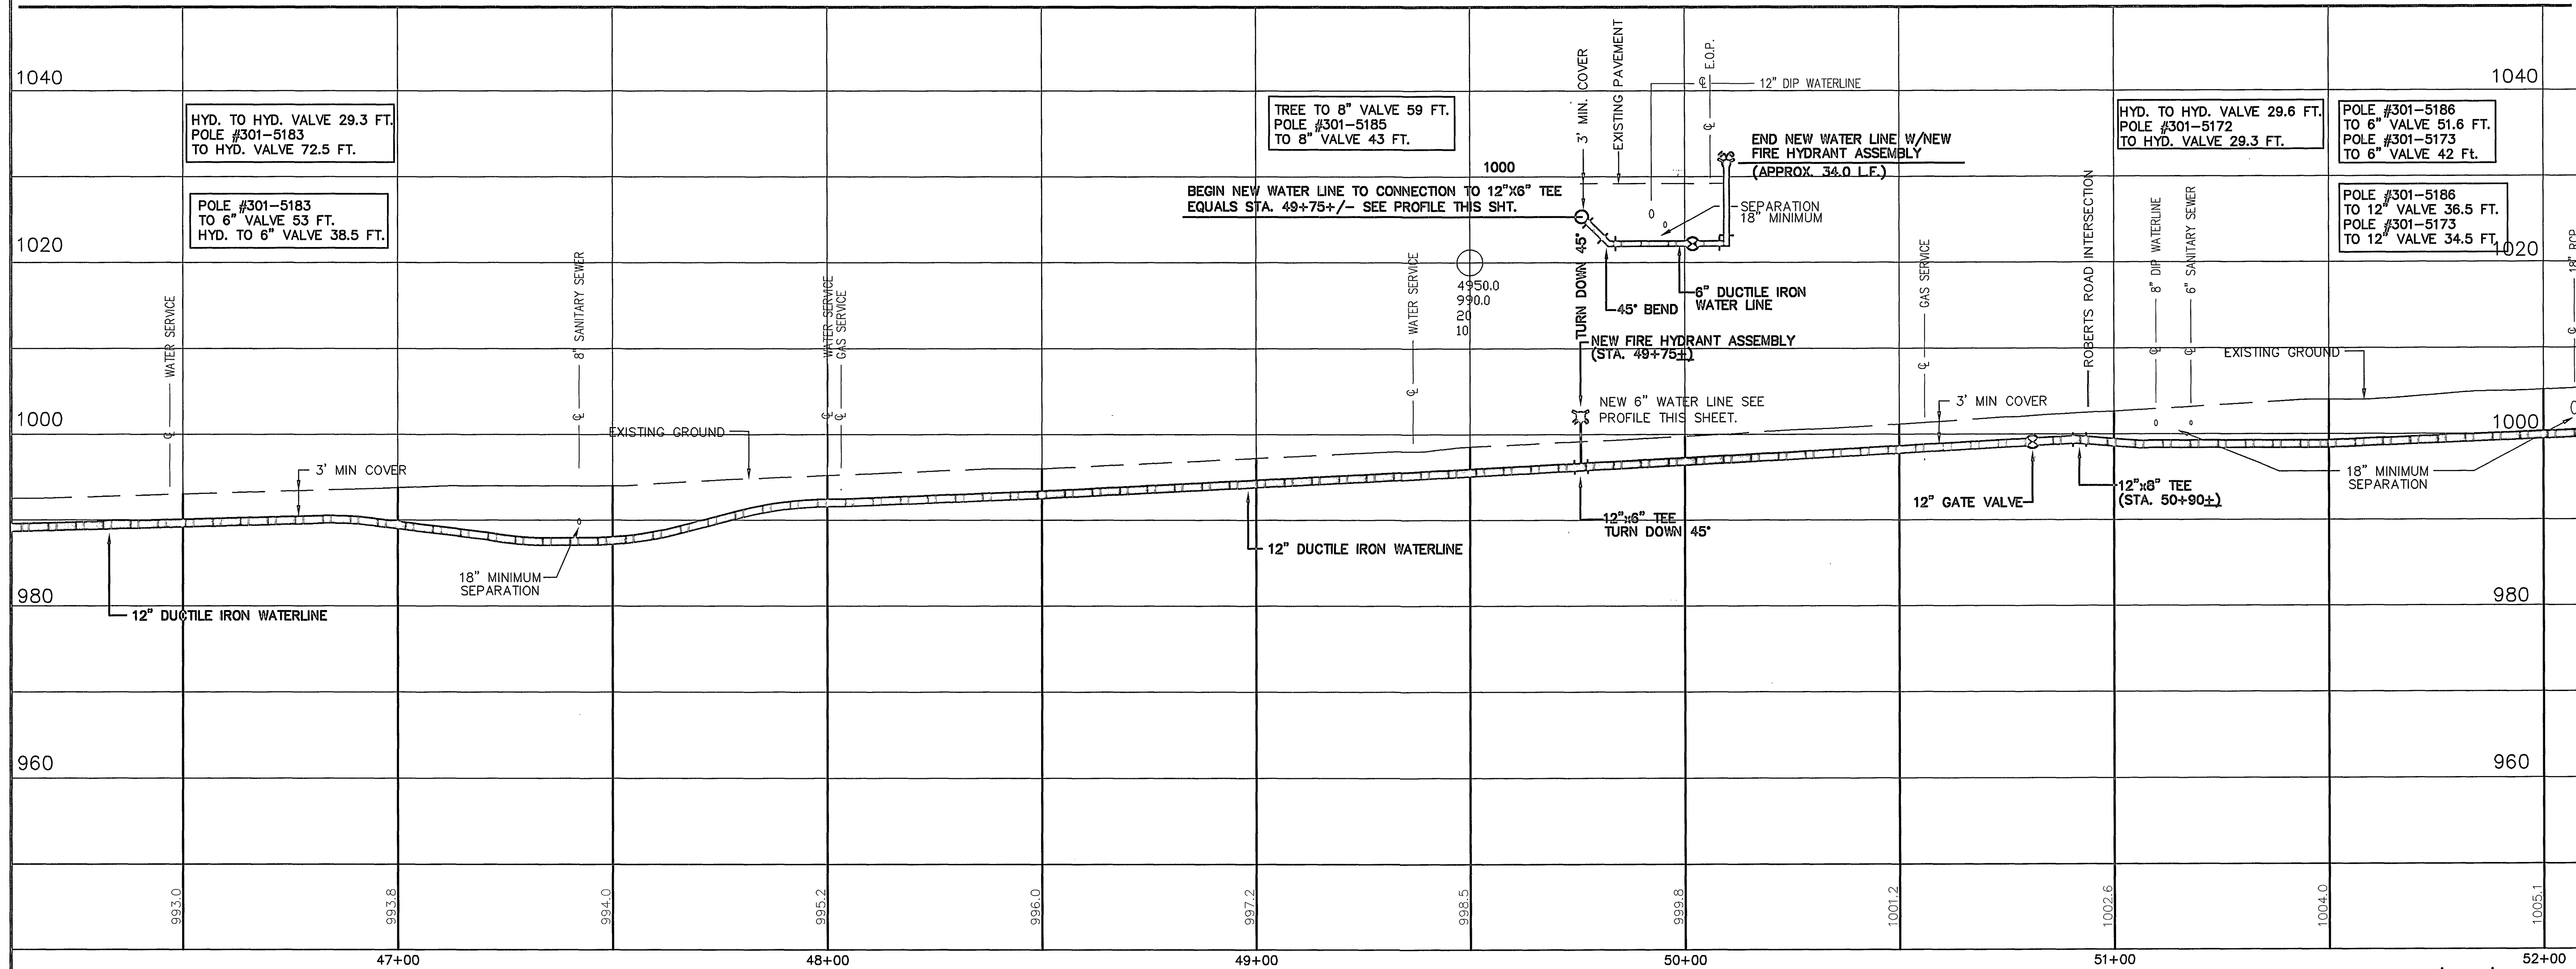


MATCHLINE SHEET #9

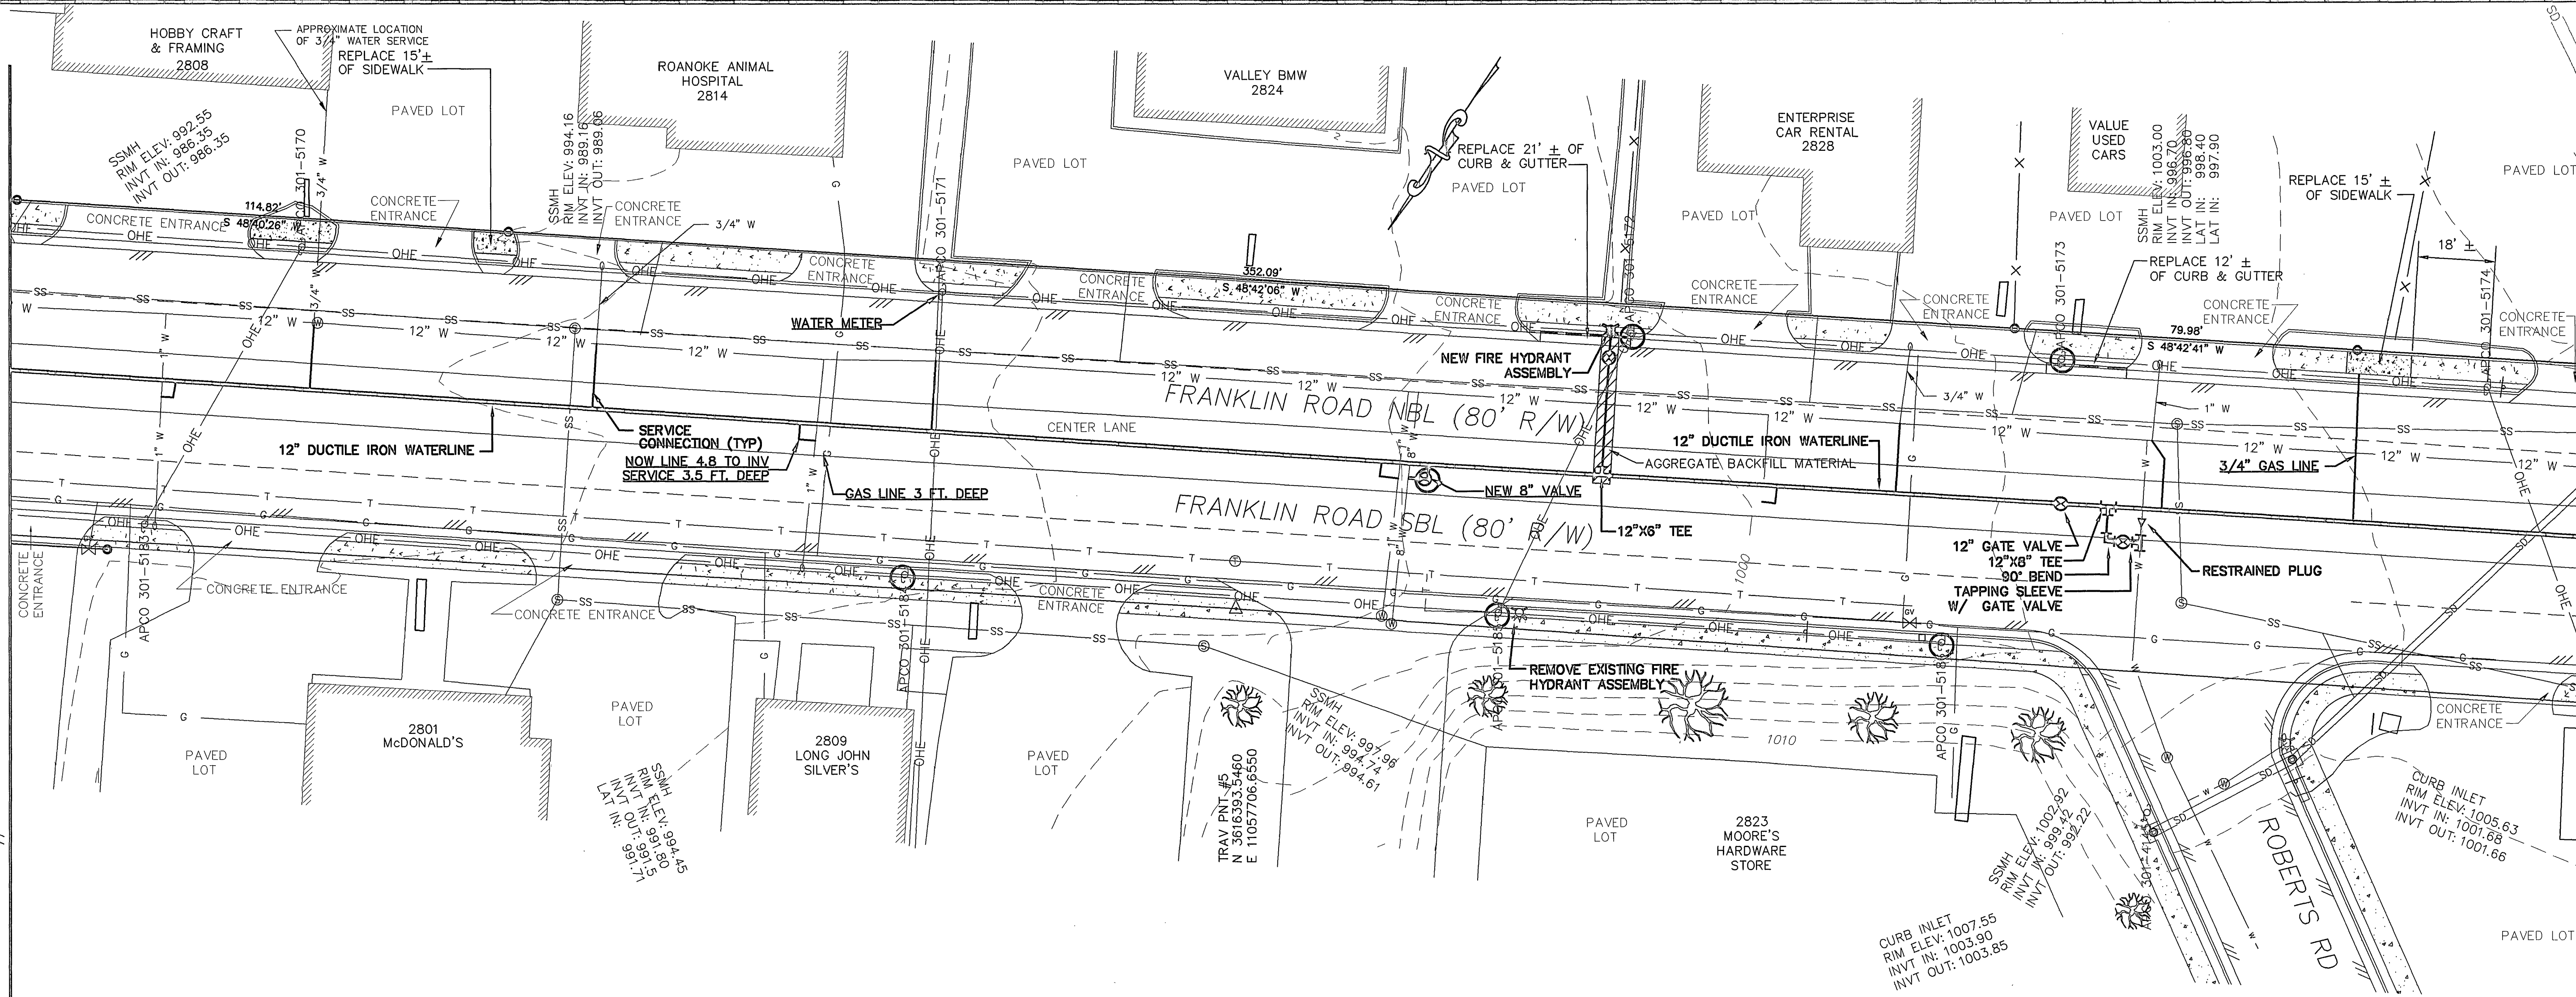


RECORD DRAWINGS 5/27/99

LMW P.C.
ENGINEERING ARCHITECTURE SURVEYING
102 ALBEMARLE AVE., S.E.
ROANOKE, VIRGINIA 24013
(540) 345-0675
FAX (540) 342-4456

FRANKLIN ROAD WATER MAIN
REPLACEMENT PROJECT
CITY OF ROANOKE, VIRGINIA

NO.	DATE	DESCRIPTION	BY

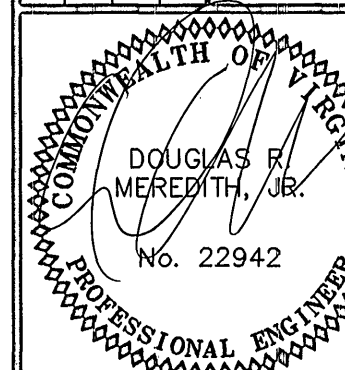

Designed By	DME
Drawn By	DME/JDC
Checked By	RCW
Approved By	RCW
Submitted By	DRM
Drawing	1497SH10.DWG
Date	4/2/98
Scale	HOR: 1" = 20' VERT: 1" = 10'
Commission No.	1497

Sheet 10 of 16

6366