


MATCHLINE SHEET #12

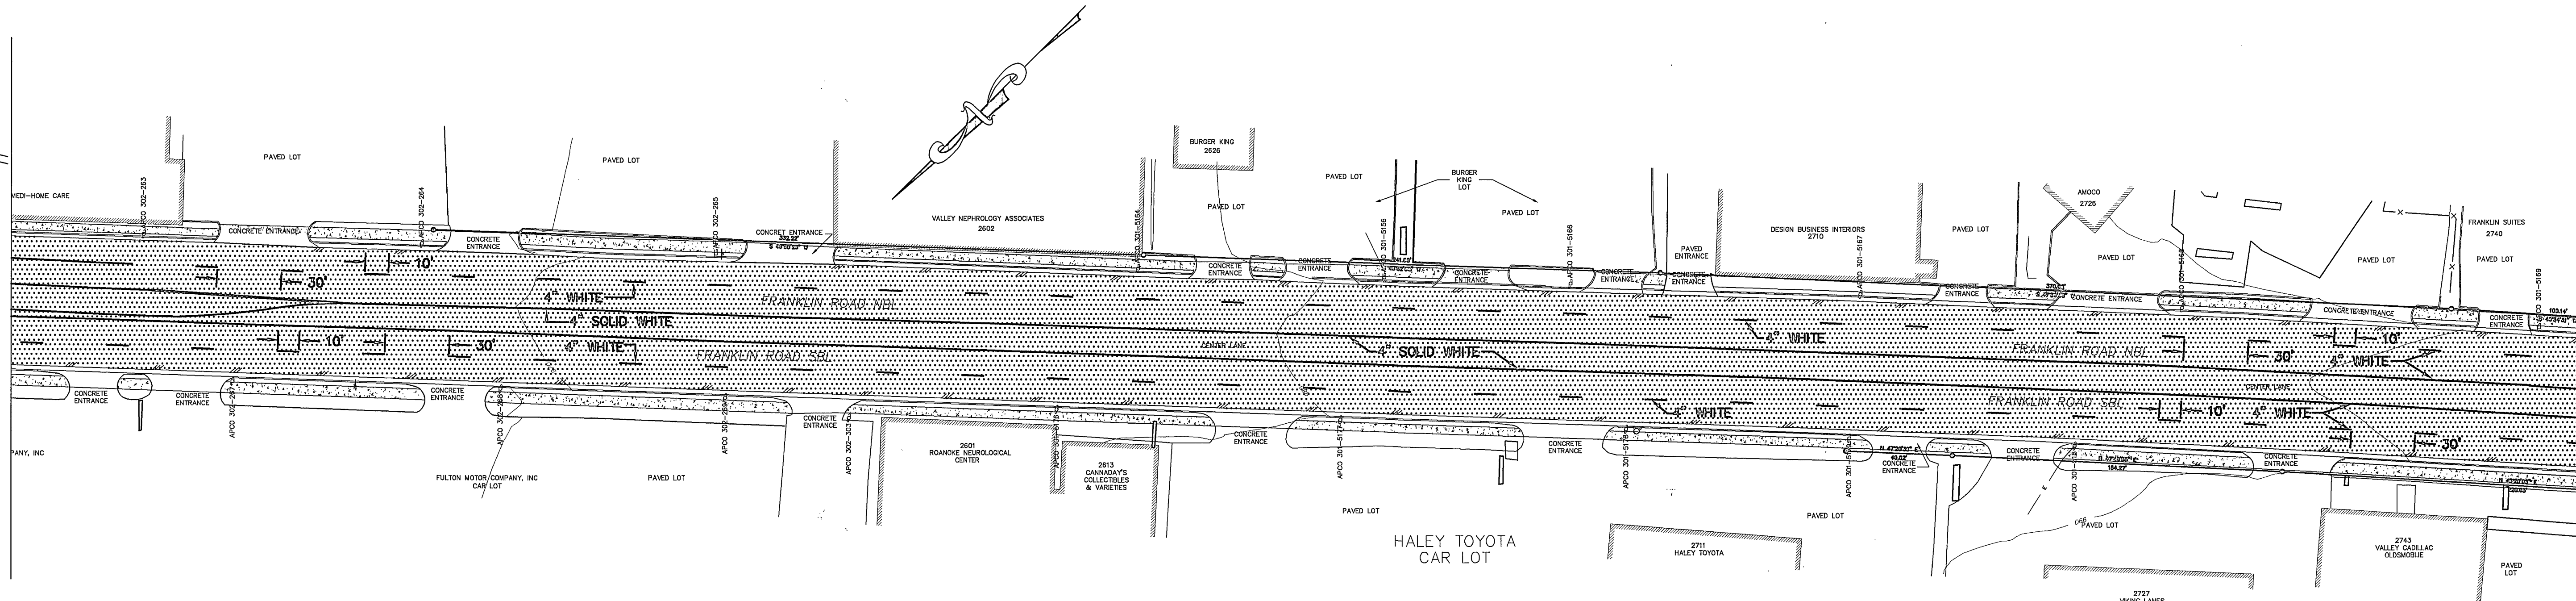

RECORD DRAWINGS 5/27/99

MATCHLINE THIS SHEET


FRANKLIN ROAD WATER MAIN
REPLACEMENT PROJECT
CITY OF ROANOKE, VIRGINIA

M.W.P.C.

ENGINEERING · ARCHITECTURE · SURVEYING
102 ALBEMARLE AVE., S.E.
ROANOKE, VIRGINIA 24013

NO.	DATE	DESCRIPTION	BY

PAVEMENT OVERLAY PAVEMENT MARKING PLAN

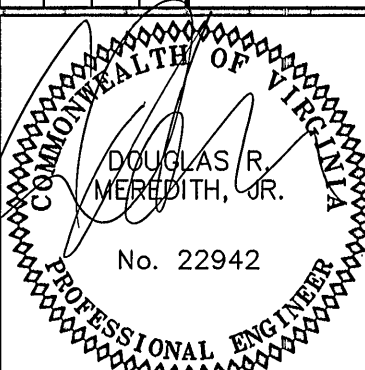

Designed By	DME
Drawn By	DME
Checked By	RCW
Approved By	RCW
Submitted By	DRM
Drawing	1497SH13.DWG
Date	4/2/98
Scale	1" = 40'
Commission No.	1497
Sheet	13 of 16