




TYPICAL TRAFFIC CONTROL FOR REPAIRS TO PAVEMENT ON FOUR-LANE PRIMARY HIGHWAYS (NON-LIMITED ACCESS)

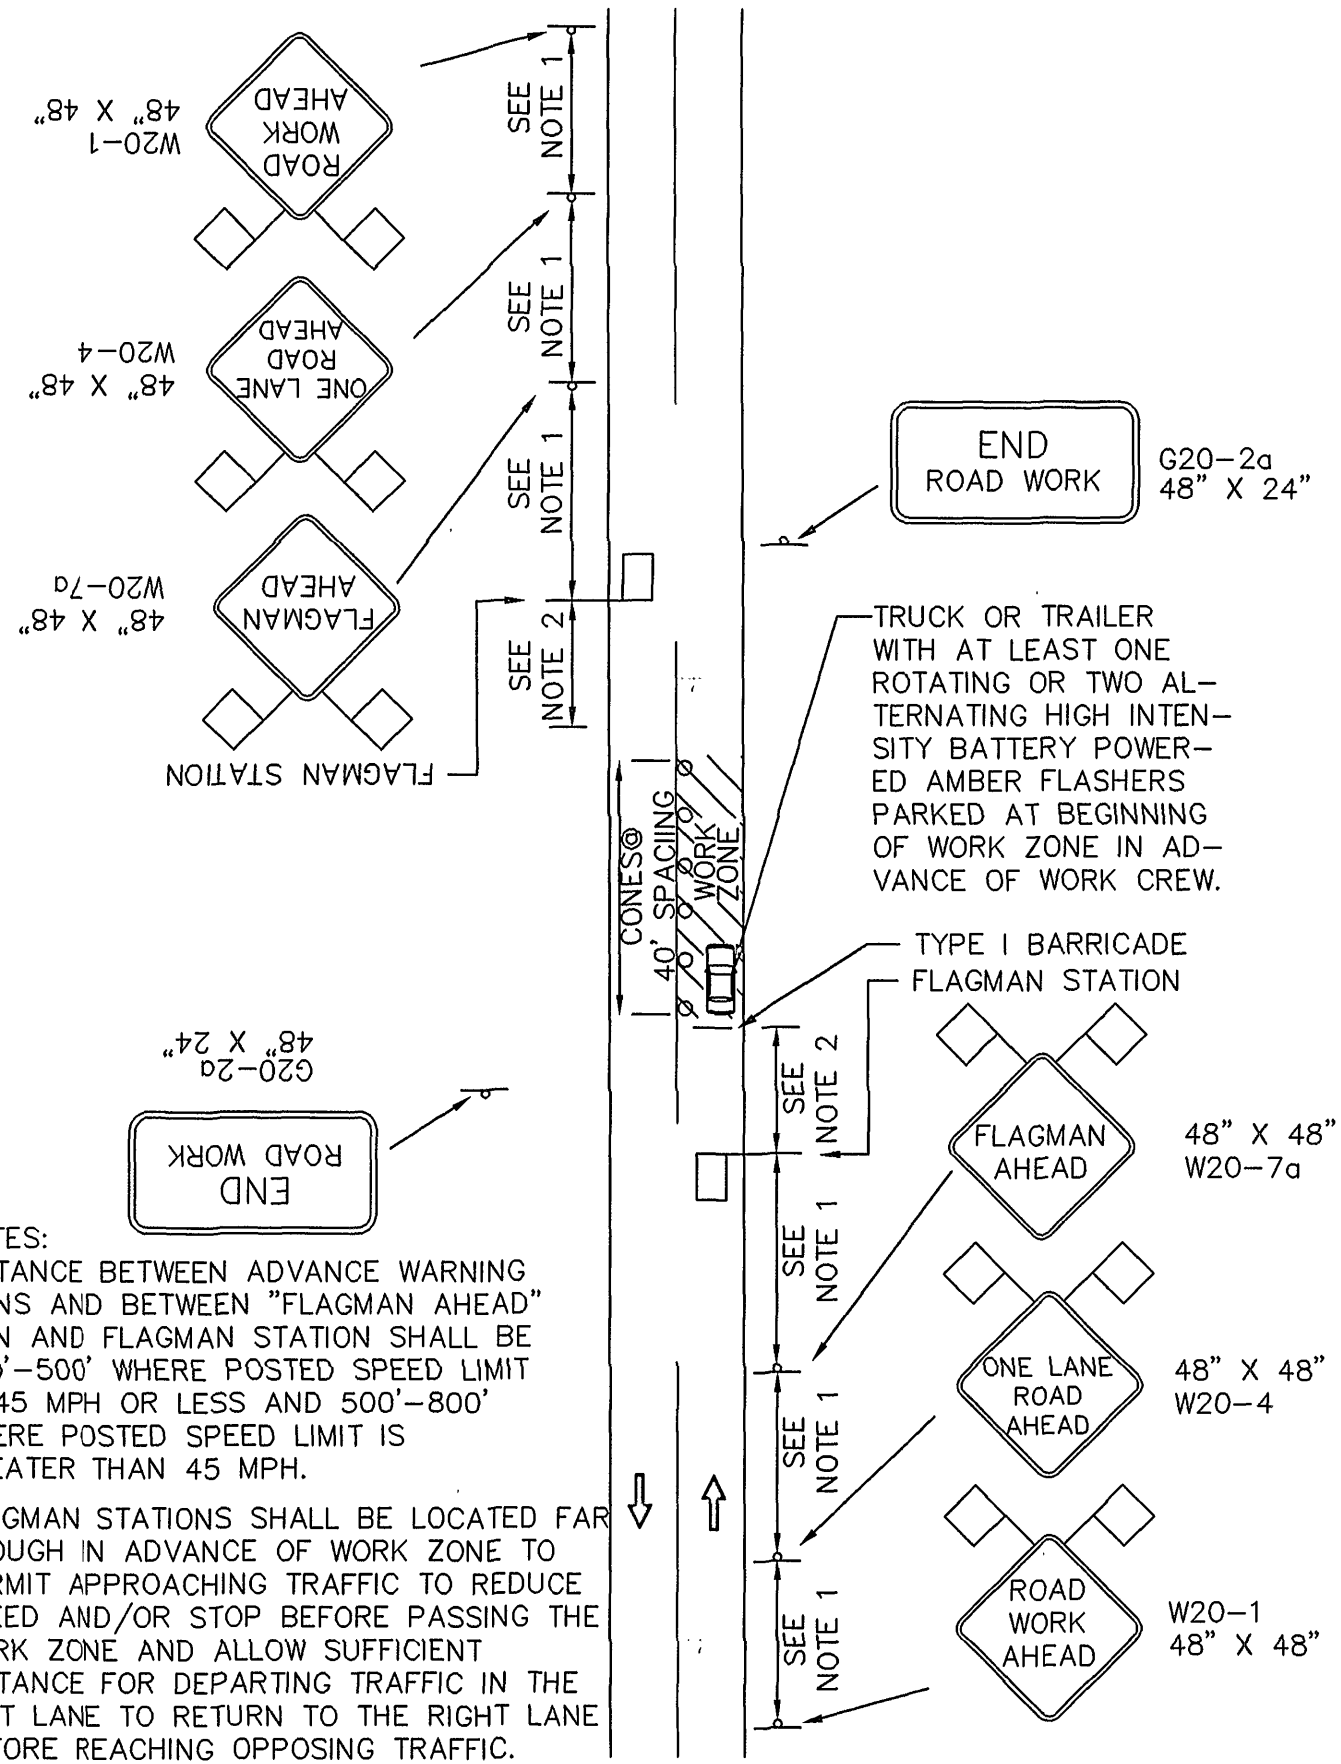

TYPICAL TRAFFIC CONTROL FOR REPAIRS TO PAVEMENT ON TWO-LANE PRIMARY HIGHWAYS (NON-LIMITED ACCESS)

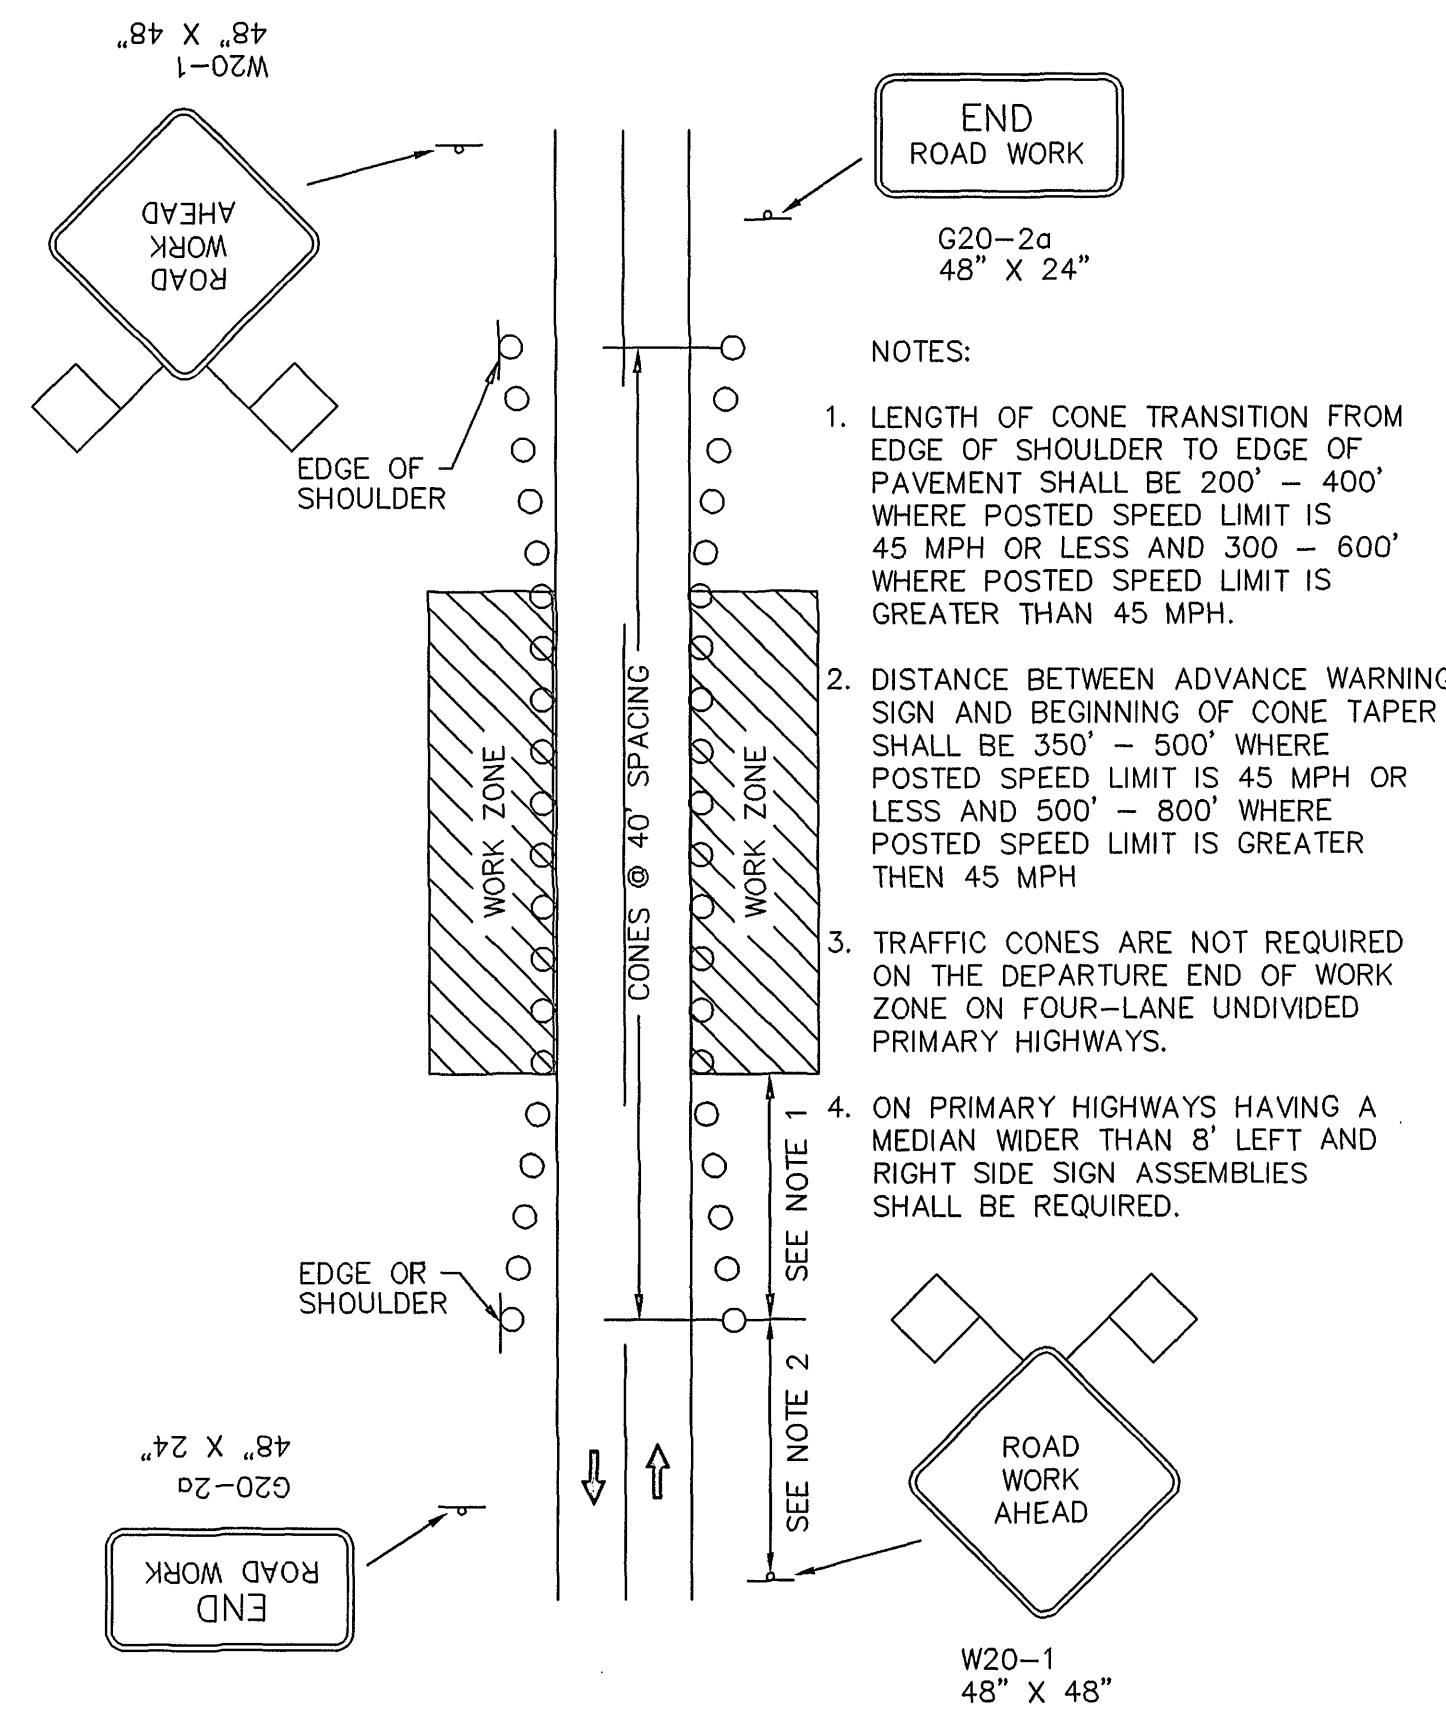

TYPICAL TRAFFIC CONTROL WORK BETWEEN PAVEMENT AND DITCH LINE ON PRIMARY HIGHWAYS (NON-LIMITED ACCESS)

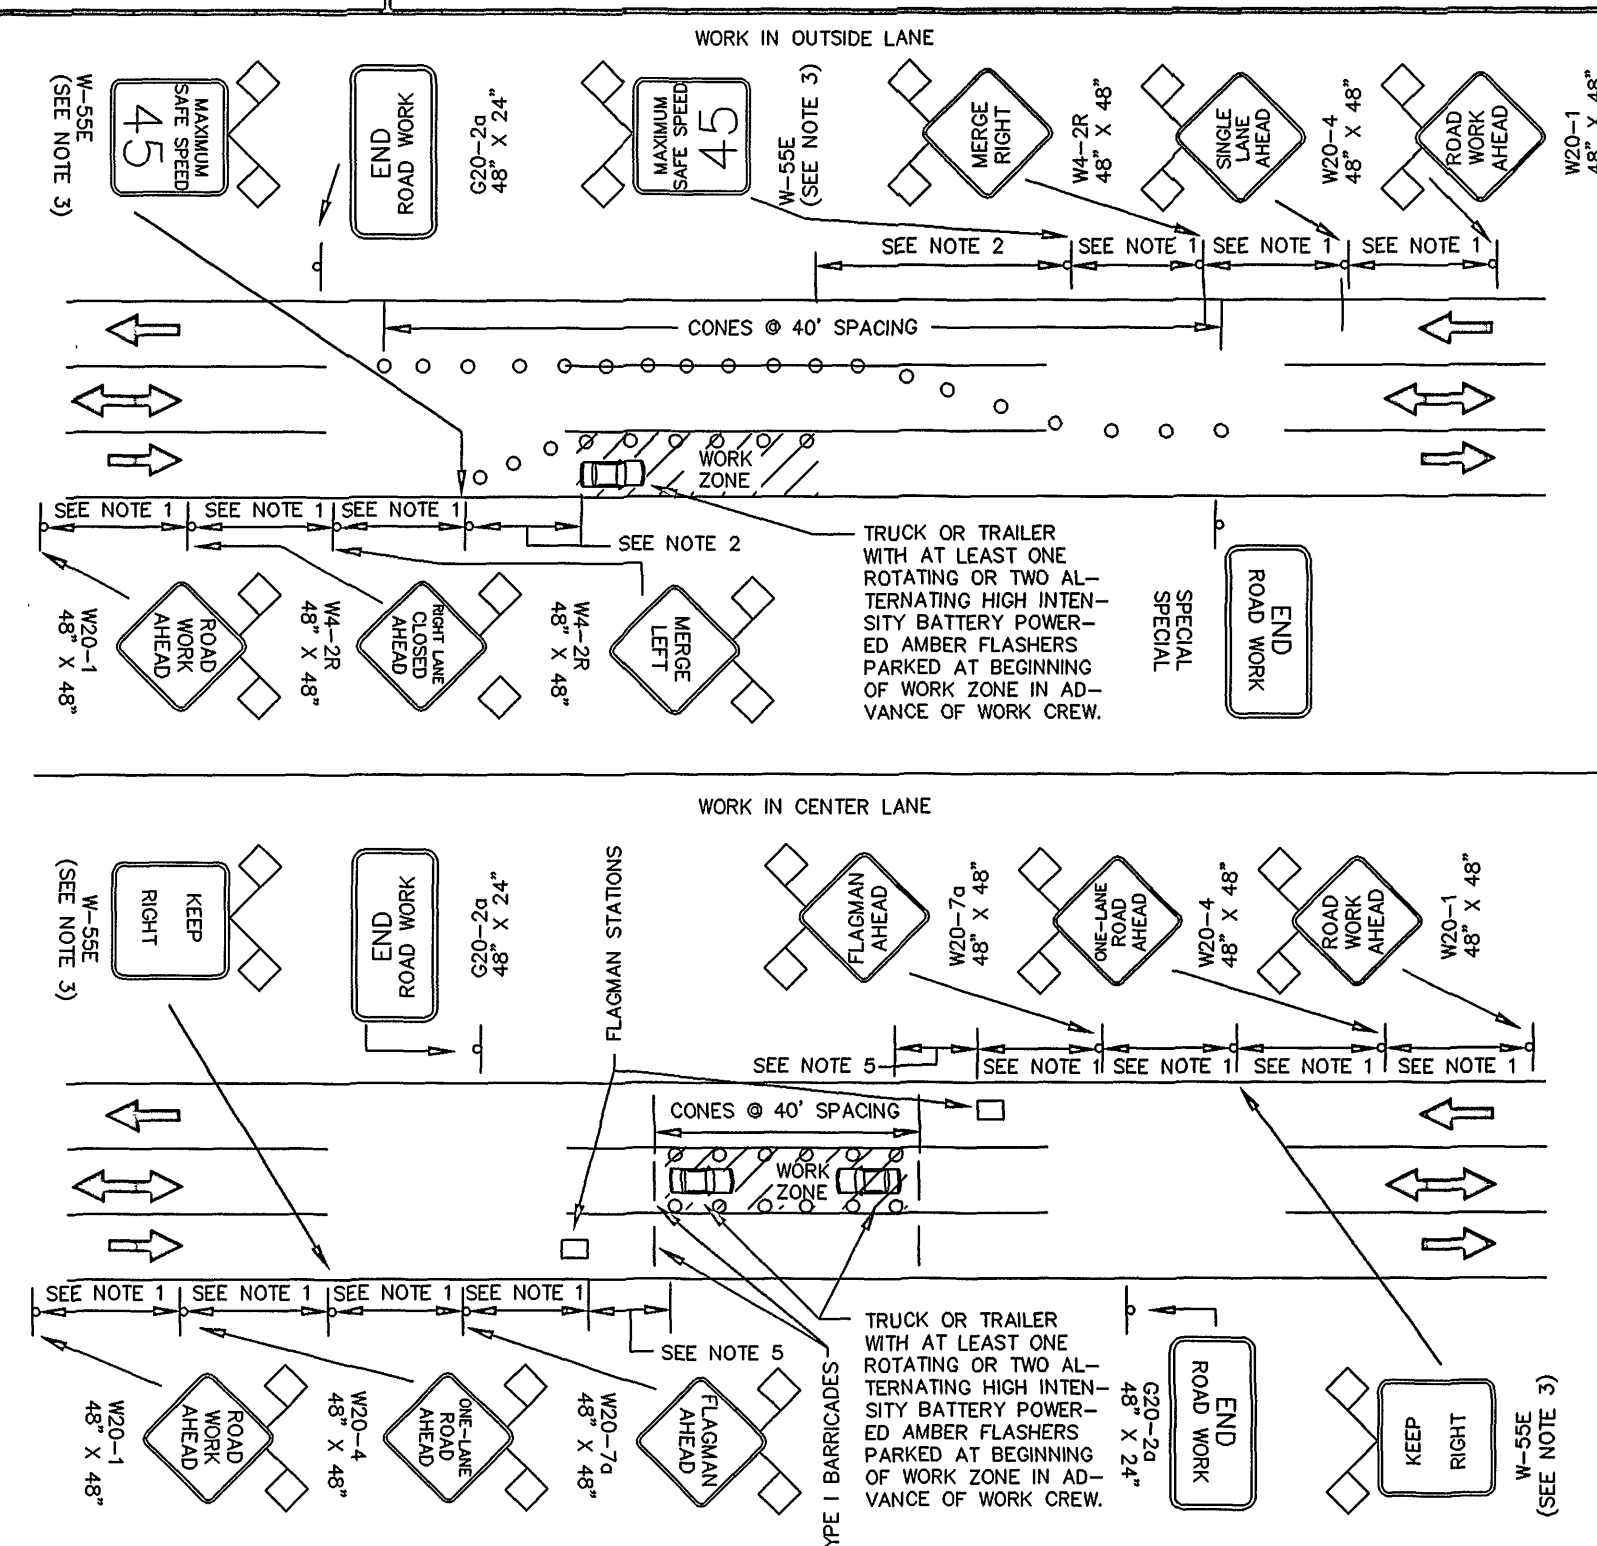


TYPICAL TRAFFIC CONTROL FOR REPAIRS TO PAVEMENT ON FOUR-LANE PRIMARY HIGHWAYS (NON-LIMITED ACCESS) RECORD DRAWINGS 5/27/99

LMW P.C.
ENGINEERING-ARCHITECTURE-SURVEYING
102 ALBEMARLE AVE., S.E.
ROANOKE, VIRGINIA 24013
(800) 640-0875
(540) 345-4456

FRANKLIN ROAD WATER MAIN
REPLACEMENT PROJECT
CITY OF ROANOKE, VIRGINIA

NO.	DATE	DESCRIPTION	BY

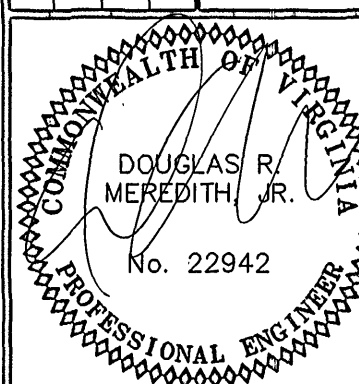

Designed By	DME
Drawn By	DME/JDC
Checked By	RCW
Approved By	DRM
Submitted By	DRM
Drawing	1497SH14.DWG
Date	4/2/98
Scale	NONE
Commission No.	1497
Sheet	14 of 16