

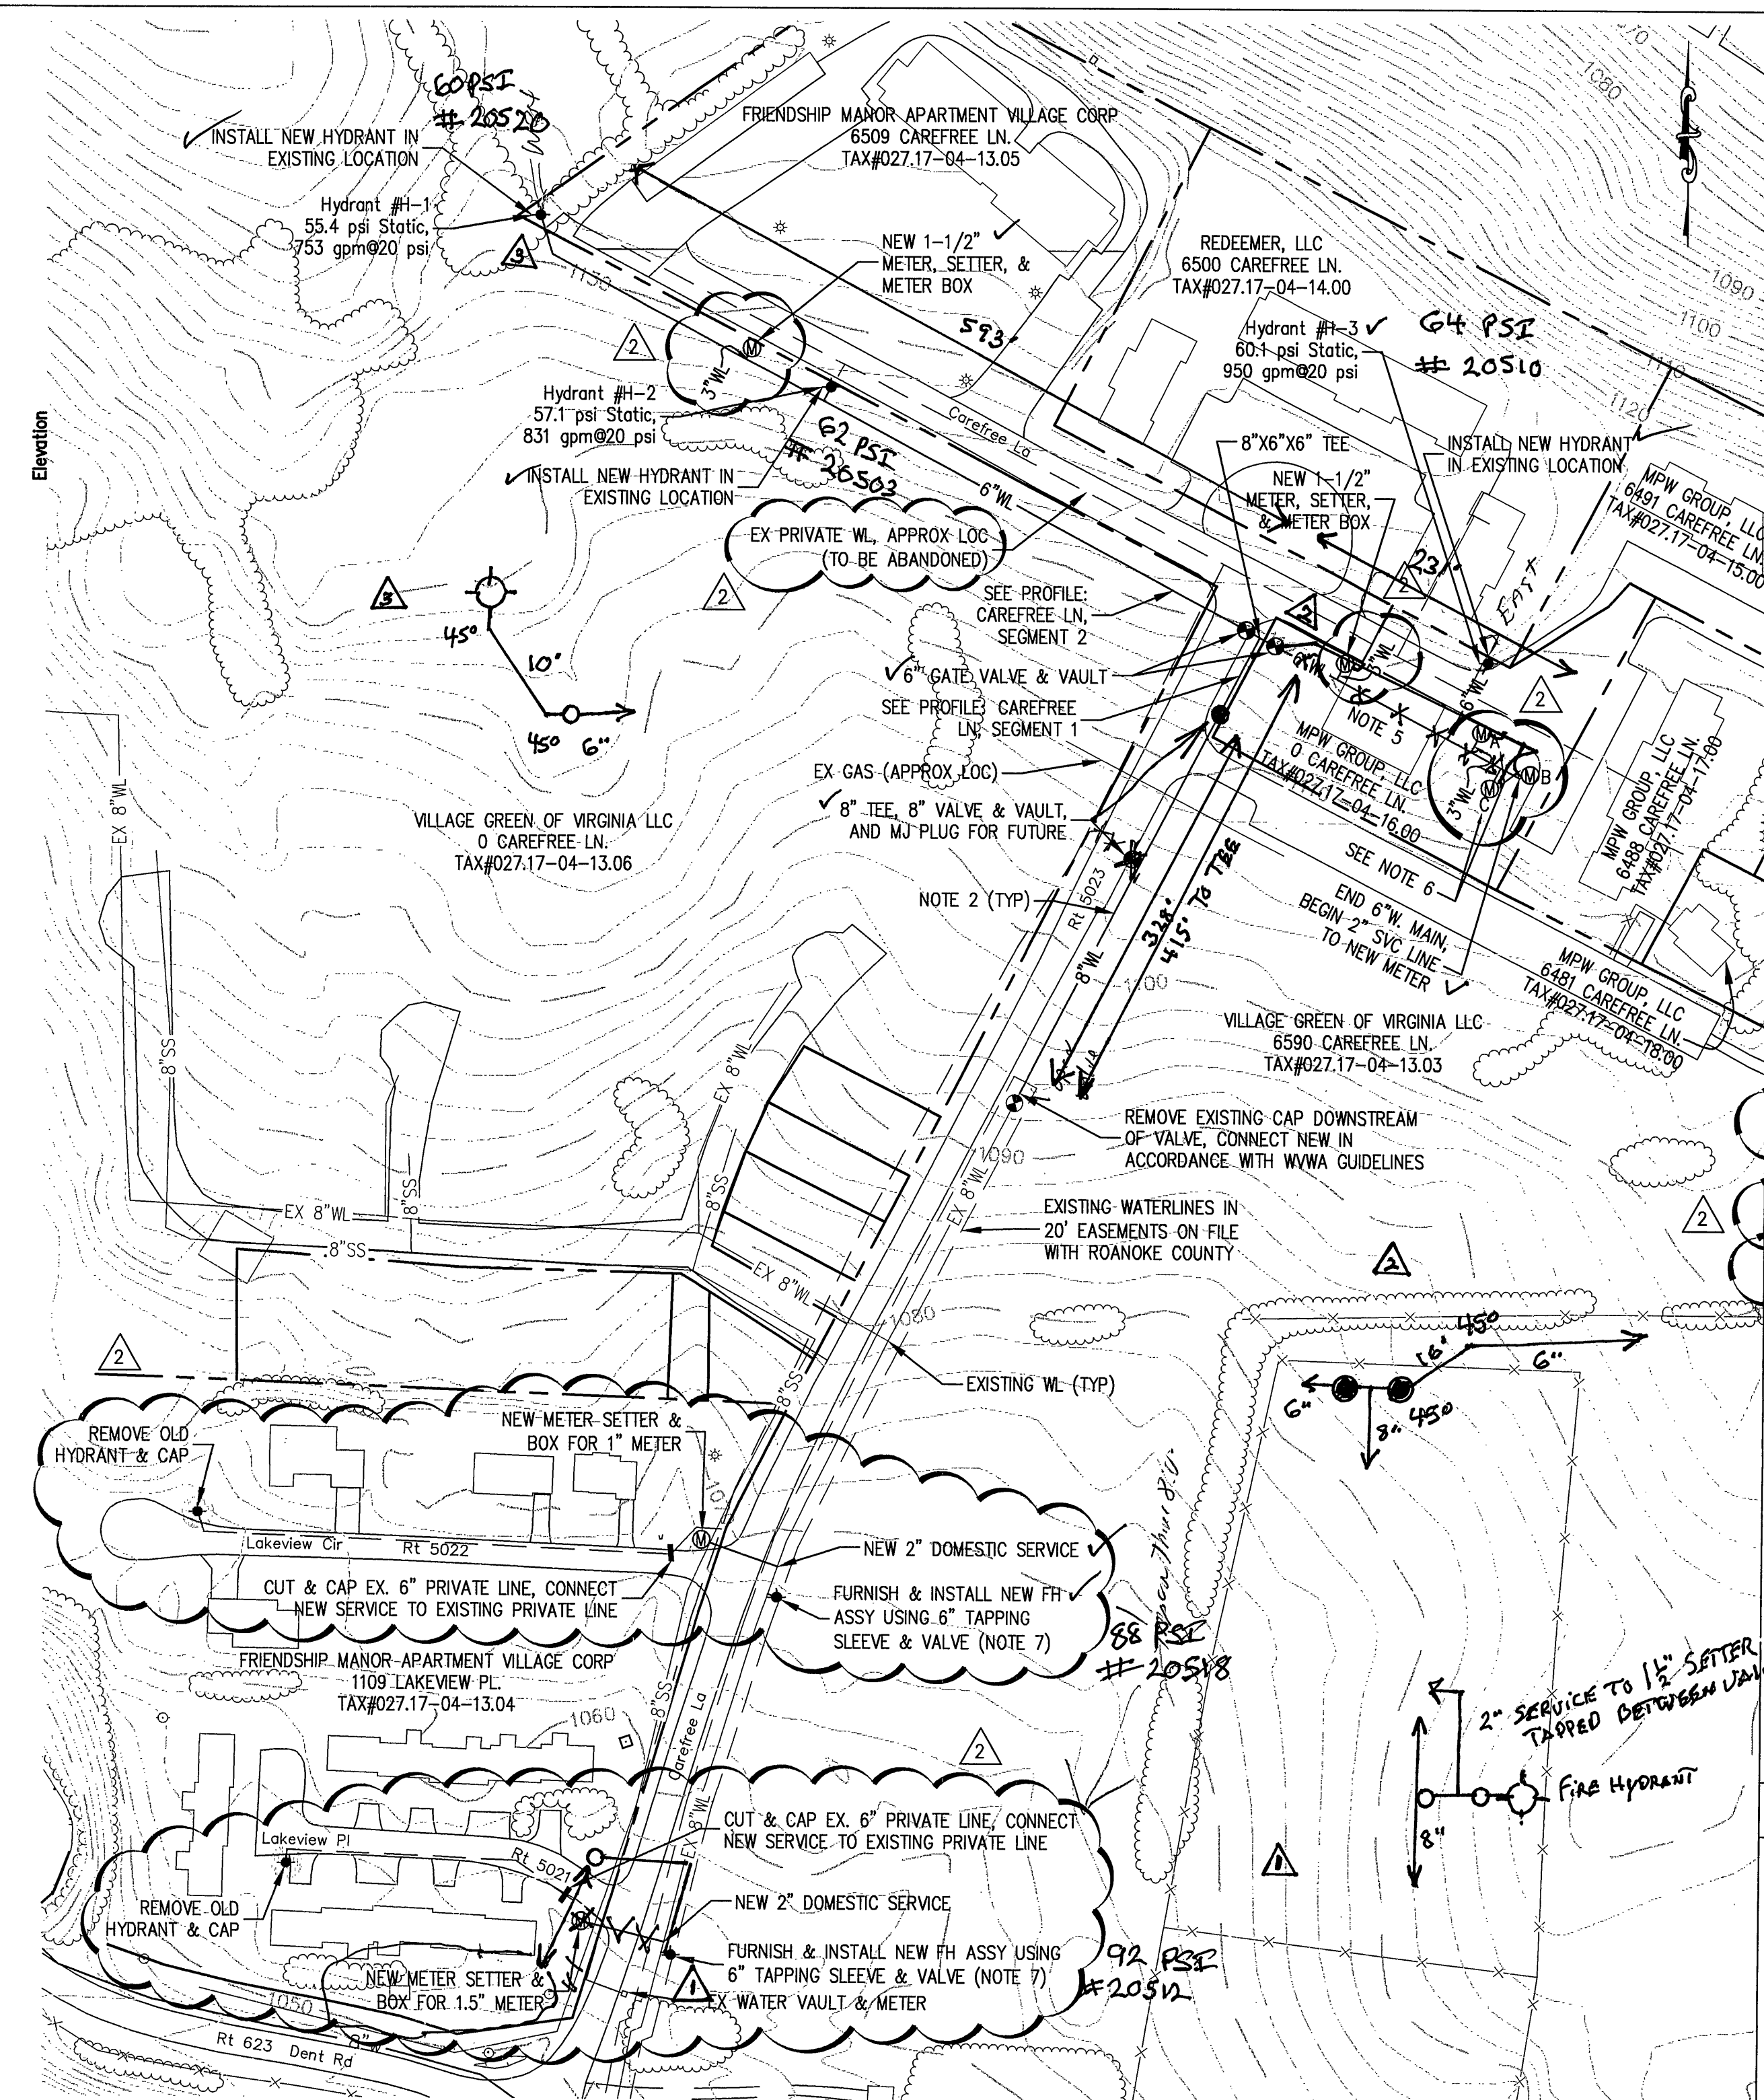


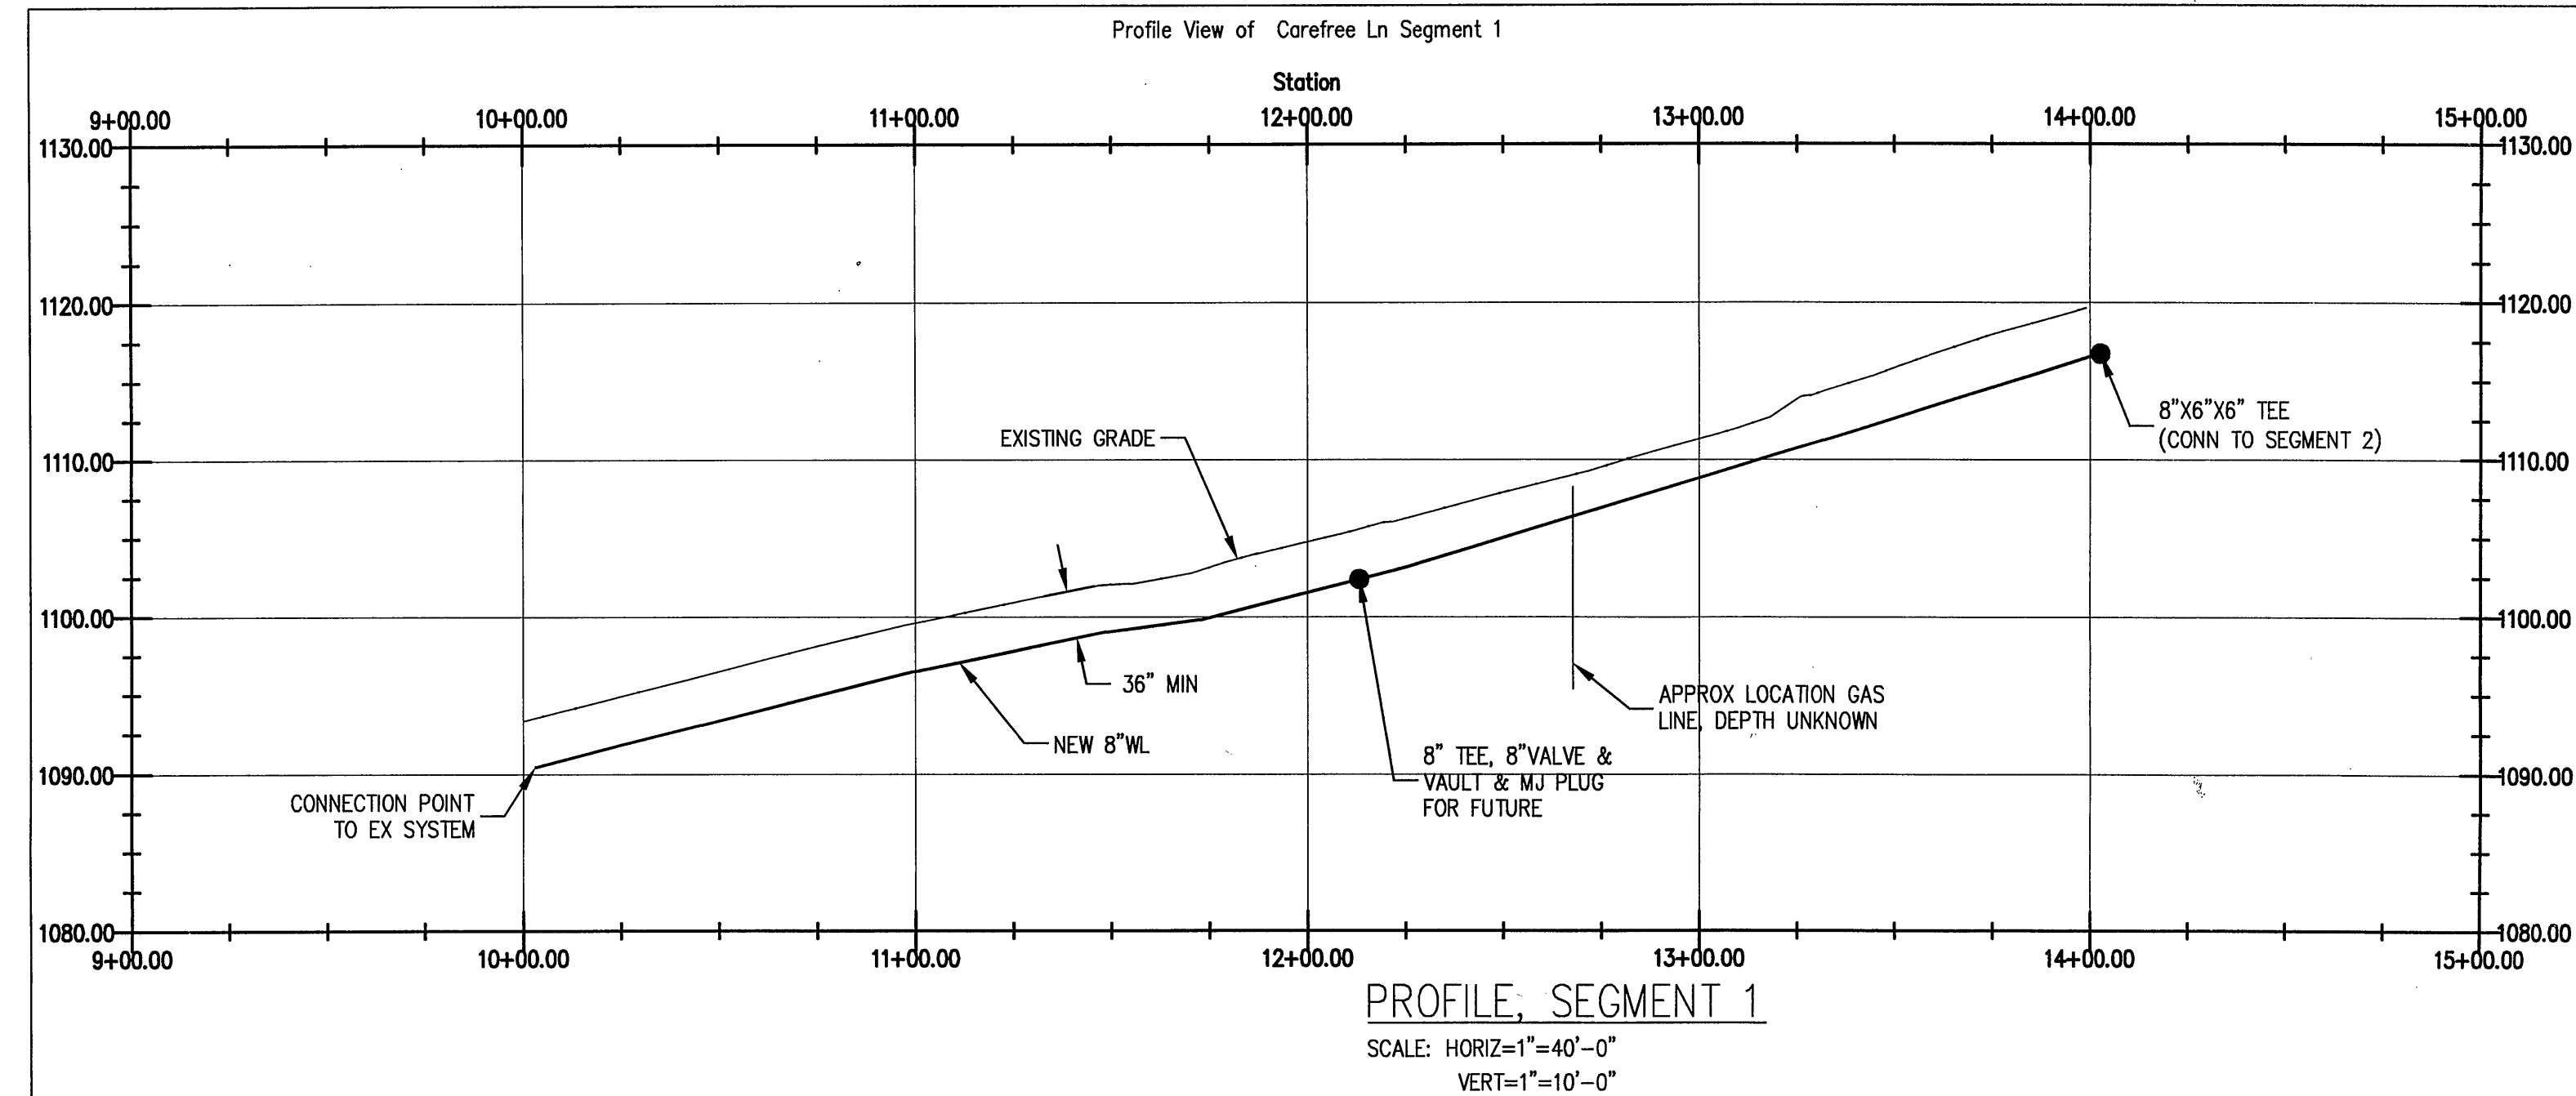

- KEY PLAN
- as Built
Call
4-26-12
- GENERAL NOTES
- NOT USED.
 - PERMANENT WATERLINE EASEMENTS IN ACCORDANCE WITH WYMA DESIGN AND CONSTRUCTION STANDARDS WILL BE REQUIRED FOR ALL PROPOSED PUBLIC WATERLINES SHOWN ON THIS PLAN. EASEMENTS MUST BE APPROVED BY WYMA AND RECORDED BEFORE DOMESTIC WATER SERVICE CAN BE PROVIDED BY PROPOSED PUBLIC WATERLINES.
 - SEE SHEET C102 FOR ESC MEASURES, ADDITIONAL NOTES, AND ADDITIONAL SERVICE LATERALS NOT SHOWN.
 - EXISTING PRIVATE WATER SYSTEM INFORMATION IS LIMITED. PIPING IS SHOWN APPROXIMATED. SEE SHEET C102 FOR VALVE LOCATIONS AND ADDITIONAL KNOWN INFORMATION.
 - EXISTING POOL AND SURROUNDING CONCRETE PAD, NEW 6" WATER MAIN WILL BE ROUTED CLEAR OF OBSTRUCTIONS. ANY DISTURBED CONCRETE TO BE REPLACED WITH SIMILAR.
 - NEW WATER METERS TO SERVE BUILDINGS AS NOTED:
A=6491 CAREFREE LN (1" METER, SETTER, & BOX);
B=6488 CAREFREE LN (1" METER, SETTER, & BOX); C=6481 CAREFREE LN (5/8" METER, SETTER, & BOX).
 - CONTRACTOR TO FURNISH AND INSTALL TAPPING SLEEVE AND VALVE, WYMA TO PERFORM WET TAP.
 - PROPOSED LOCATIONS FOR HYDRANTS, VALVES, METERS, WATERLINES, ETC. ARE SHOWN FOR DESIGN INTENT WITHOUT THE BENEFIT OF A SURVEY. EXISTING UTILITIES ARE APPROXIMATED AND MAY OR MAY NOT BE PRESENT. ALL UTILITIES ARE NOT SHOWN - POSSIBLE CONFLICTS MAY EXIST. FIELD VERIFY.

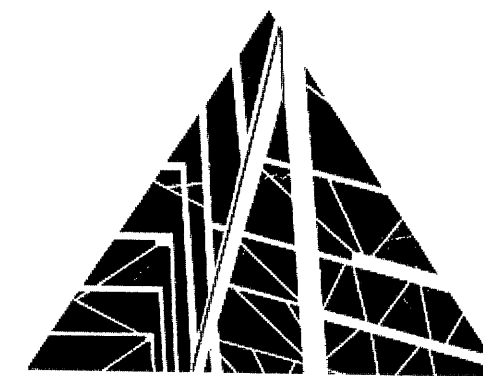

SPECTRUM DESIGN
architects | engineers

10 CHURCH AVE SE, PLAZA SUITE 1 ROANOKE, VIRGINIA 24011 540.342.8001
ROANOKE

FRIENDSHIP
MANOR

APPROVED

ESC PLAN

SPECTRUM DESIGN PROJECT NO. 11119

DATE
DESIGN ARCHITECT
PROJECT ARCHITECT
PROJECT ENGINEER
CHECKED BY
DRAWN BY

17 NOVEMBER, 2011
MAR
MF
NUMBER
1
2

DATE
12-22-11
1-23-12

SHEET TITLE

WATERLINE
PLAN & PROFILES

WWVA

