


X 10 30 Flag
TO BE FINISH BY PACE
To serve Innotech Site
2997 Frontage Rd, NW

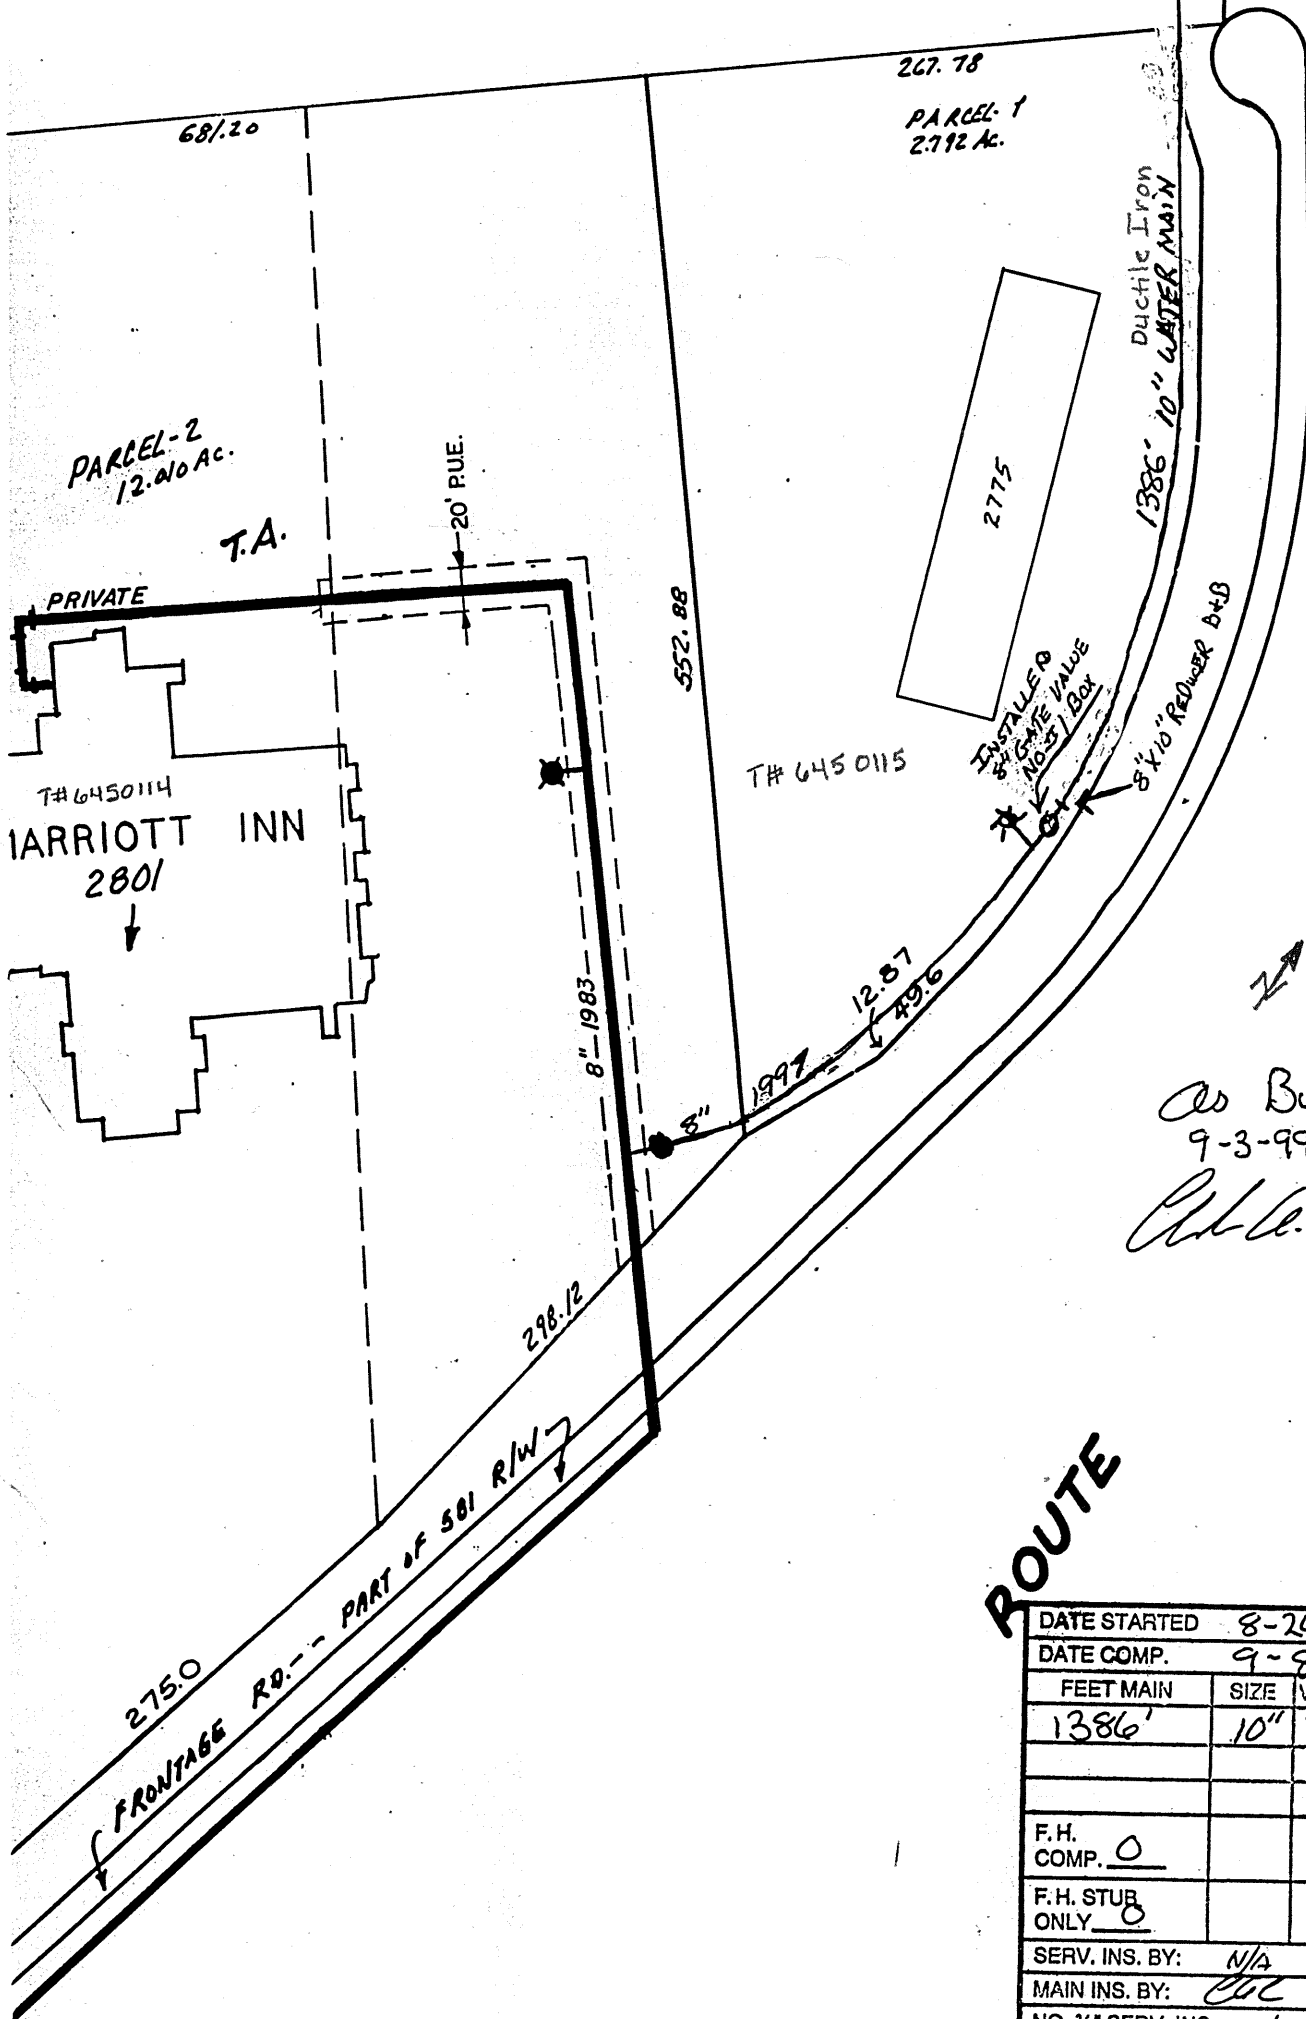

581

as Built
9-3-99
Chall

653

ROUTE

DATE STARTED 8-24-99				
DATE COMP. 9-8-99				
FEET MAIN	SIZE	VALVE	VAULT	BOX
1386'	10"	8"	NO	#1
F.H. COMP.				
F.H. STUB ONLY				
SERV. INS. BY: N/A				
MAIN INS. BY: CAC				
NO. 1/4" SERV. INS. N/A				
CITY OR CO. CITY				
DEPT. INSP. CAC				

NOTICE:

The location of features and utilities are shown on this map in so far as their existence and location were known at the time of the preparation of this map. Nothing on this map shall be construed as a guarantee that any feature or utility are in the location indicated or that they actually are.

CR STATE