

AsBuilt- 6/5/2022
Inspector- Brian
Whitenack


Contractor- SW
Excavating

NEW CONSTRUCTION

GRTC
TRANSIT STATION

CITY OF ROANOKE

Spectrum Design Project No.:

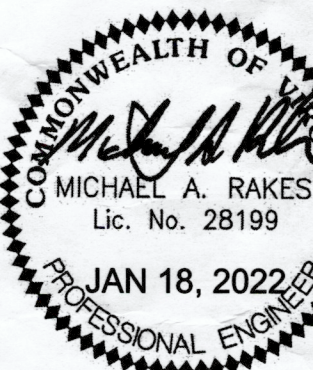

PROJ. MGR.: CHECKED BY: DRAWN BY:
JM MAR CDL

SHEET ISSUE DATE:
07.30.2021

PROJECT PHASE:
CONSTRUCTION DOCUMENTS

REVISION: CITY REVIEW COMMENTS HYDRANT RELOCATION
NUMBER: 1 2

KEY PLAN:

City of Roanoke
Planning, Building, & Development
COMPREHENSIVE DEVELOPMENT
APPROVED
by Aaron Cypher 01/1/2022

SHEET NAME:

UTILITY PLAN

SHEET NUMBER:

C201

