

N. T. S.


AS-BUILT DRAWING NOTE: AS-BUILT DRAWING FOR WATERLINE AND SANITARY SEWER
IMPROVEMENTS ARE FOR AS-BUILT
PURPOSES ONLY. NO
IMPROVEMENTS OTHER THAN
WATER STRUCTURES ANS SEWER STRUCTURES WERE AS-BUILT OR INDICATED AS SUCH ON THIS EXHIBIT. UNDERGROUND PIPING WAS NOT LOCATED. LOCATION SHOWN IS APPROXIMATE BASED ON SURFACE FEATURES AND INFORMATION PROVIDED BY THE CONTRACTOR.


THE INTENT OF THIS EXHIBIT IS TO SHOW THE LOCATION OF WATER STRUCTURES AND A SEWER STRUCTURES FOR AS-BUILT PURPOSES AND IS NOT INTENDED TO REPRESENT A PHYSICAL IMPROVEMENTS SURVEY. THIS EXHIBIT WAS PREPARED WITHOUT THE BENEFIT OF A TITLE REPORT AND IS SUBJECT TO INFORMATION WHICH MAY BE DISCLOSED BY SUCH. NOT ALL EASEMENTS OR IMPROVEMENTS MAY BE SHOWN.

LEGEND

- IRON PIN FOUND WATER METER VAULT LID
- SEWER M.H. SEWER CLEANOUT
- (VM) VALLEY METRO (GH) - GREY HOUND




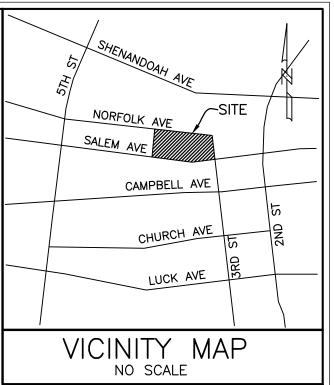

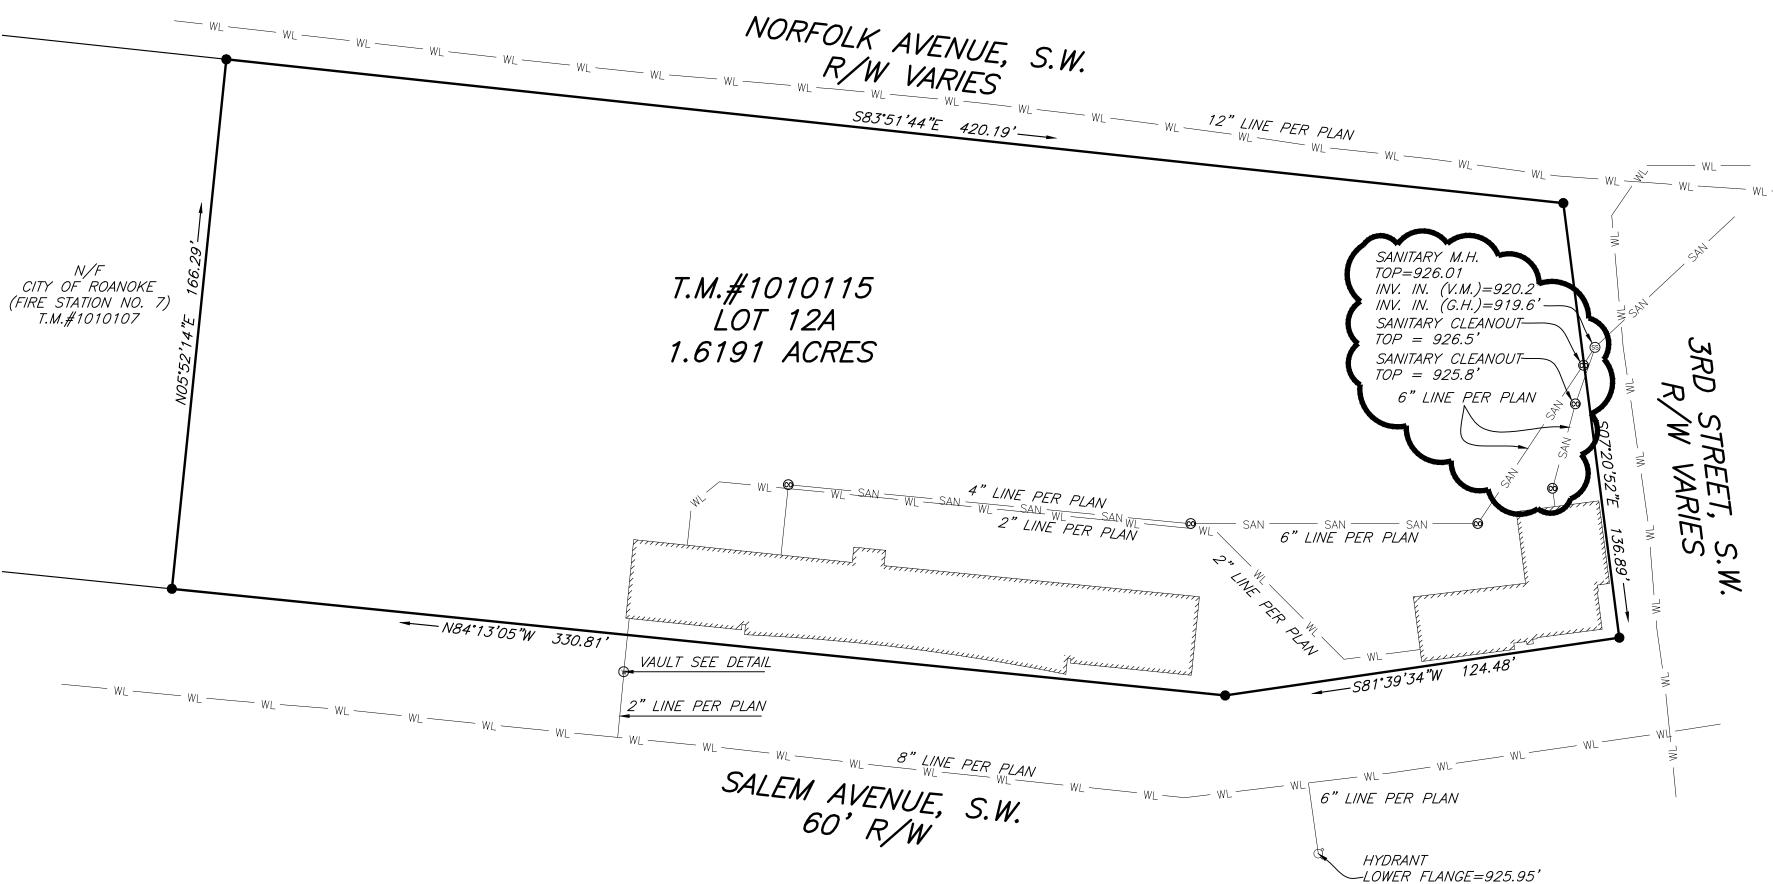

Lic. No. 3405 06/01/2023

REV.#1: SANITARY UPDATE (05/30/23) REV.#2: WATERLINE UPDATE (06/01/23)

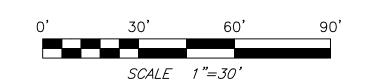

AS-BUILT WATERLINE & SEWER EXHIBIT FOR WESTERN VIRGINIA WATER AUTHORITY

TOP NUT=928.30'

325 SALEM AVENUE, S.W. - T.M.#1010115 CITY OF ROANOKE, VIRGINÏA DATED SEPTEMBER 21, 2022 JOB #05210015.00 WVWA SCALE: 1" = 30'

PLANNERS / ARCHITECTS / ENGINEERS / SURVEYORS ROANOKE / RICHMOND / NEW RIVER VALLEY / SHENANDOAH VALLEY 1208 Corporate Circle / Roanoke, Virginia 24018 / Phone (540) 772-9580 / www.balzer.cc



DRAWN BY: DSH CHECKED BY: JAP