

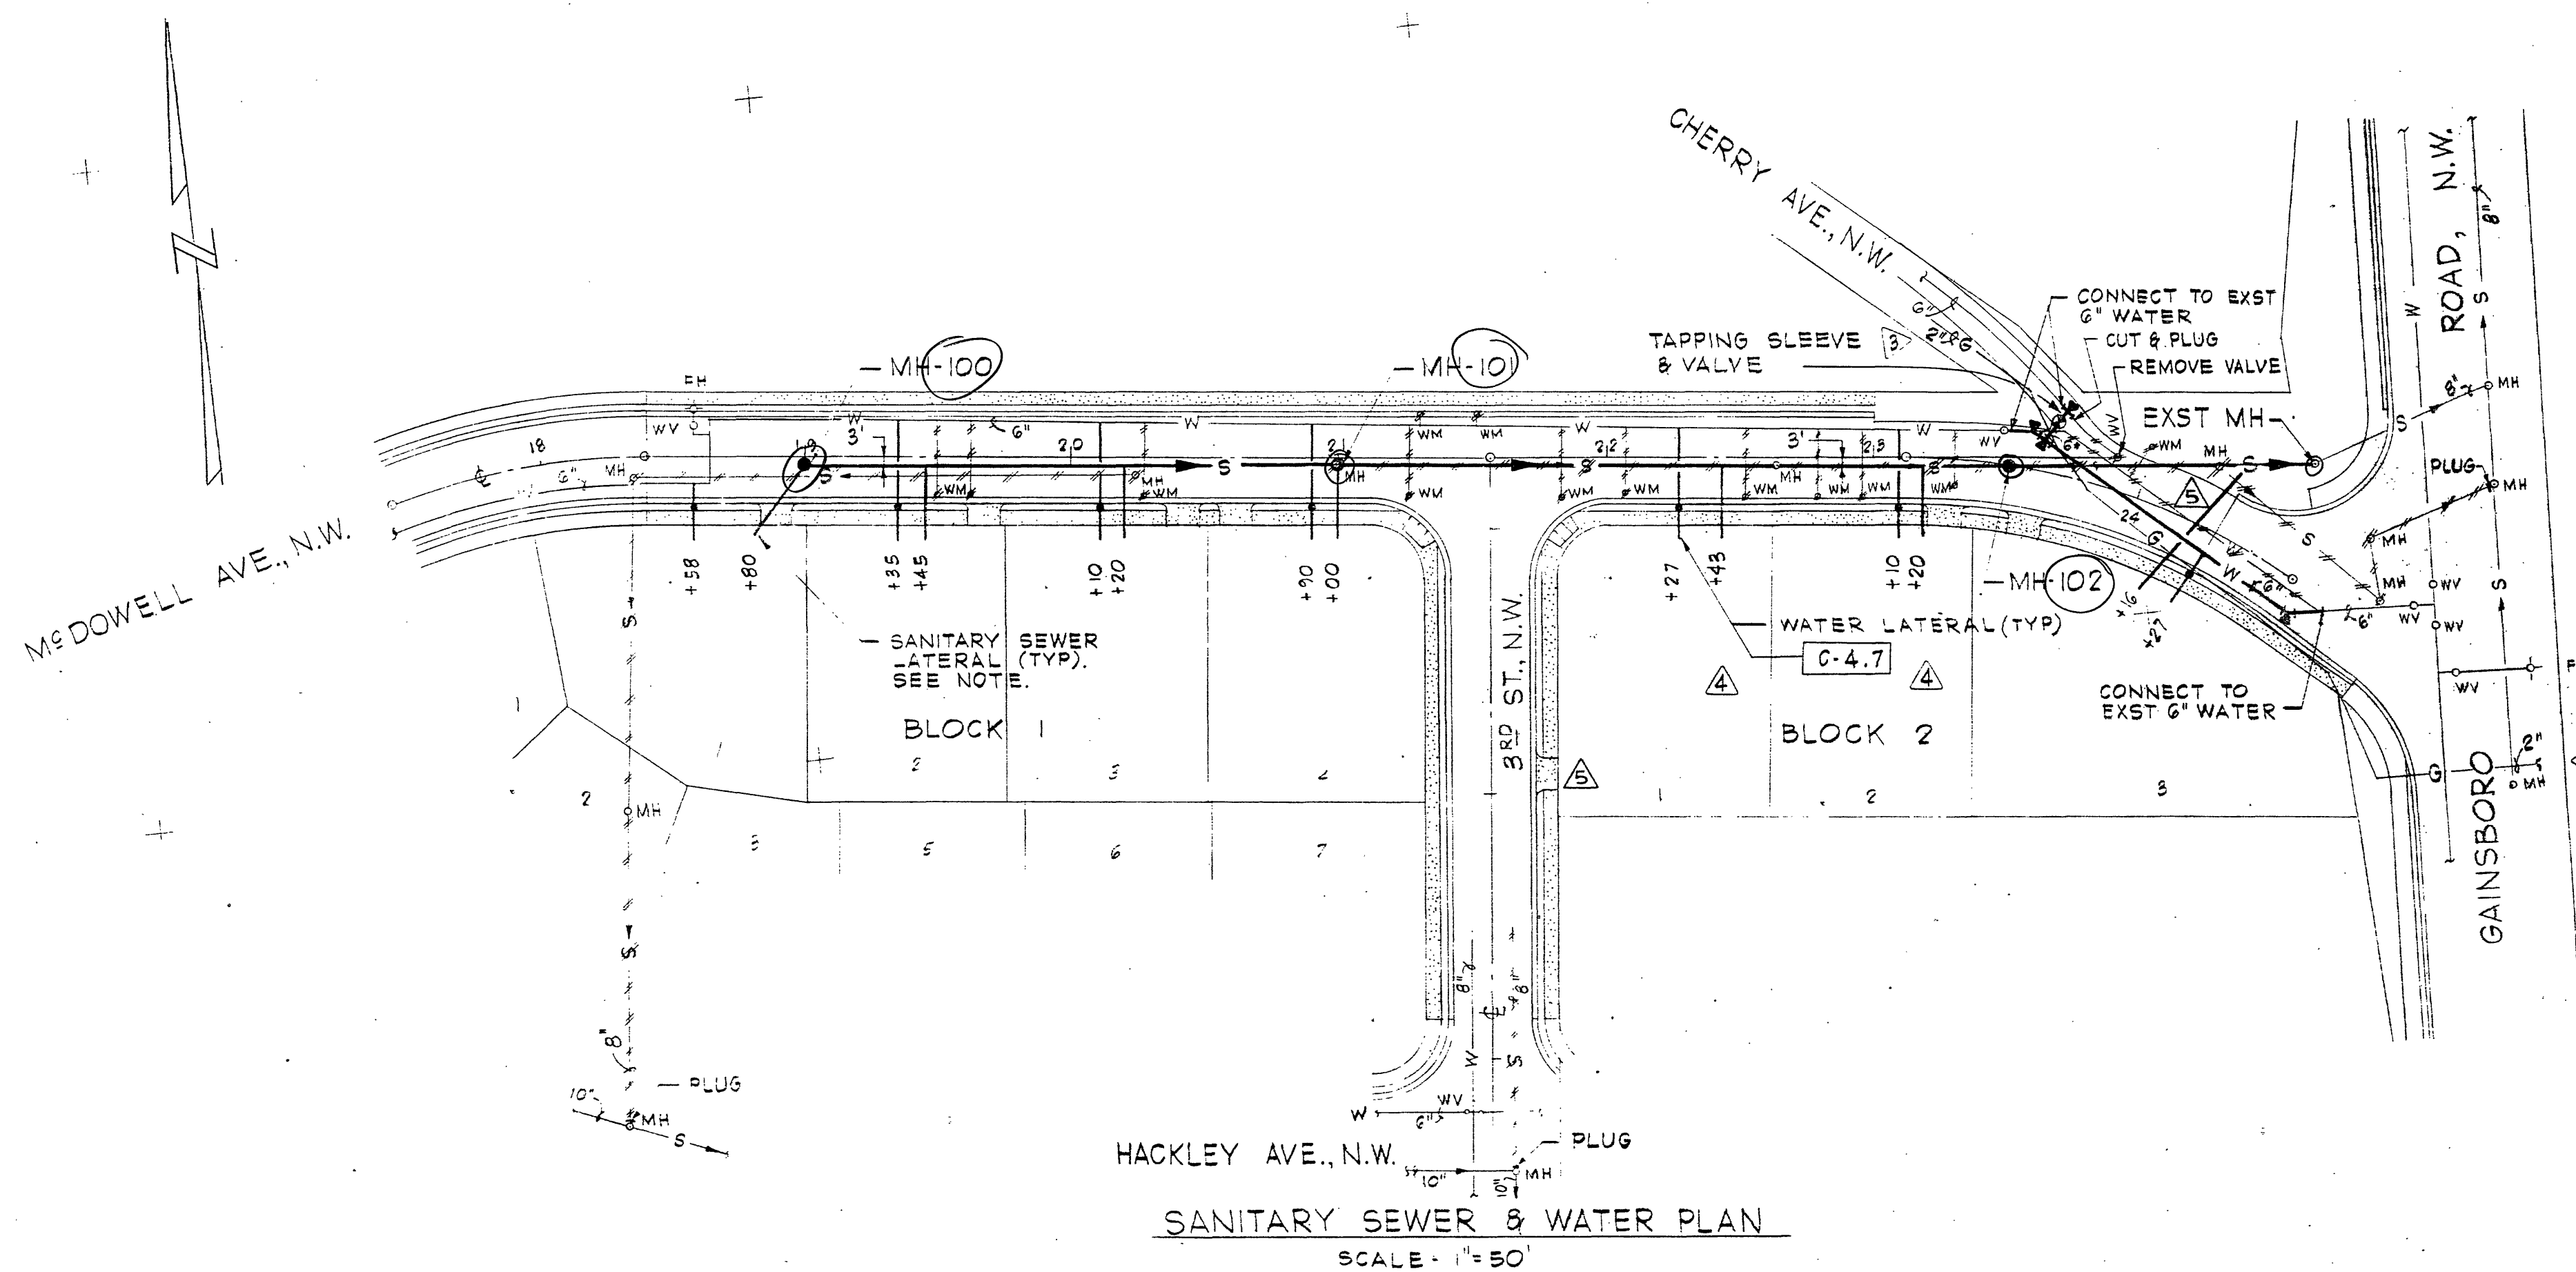
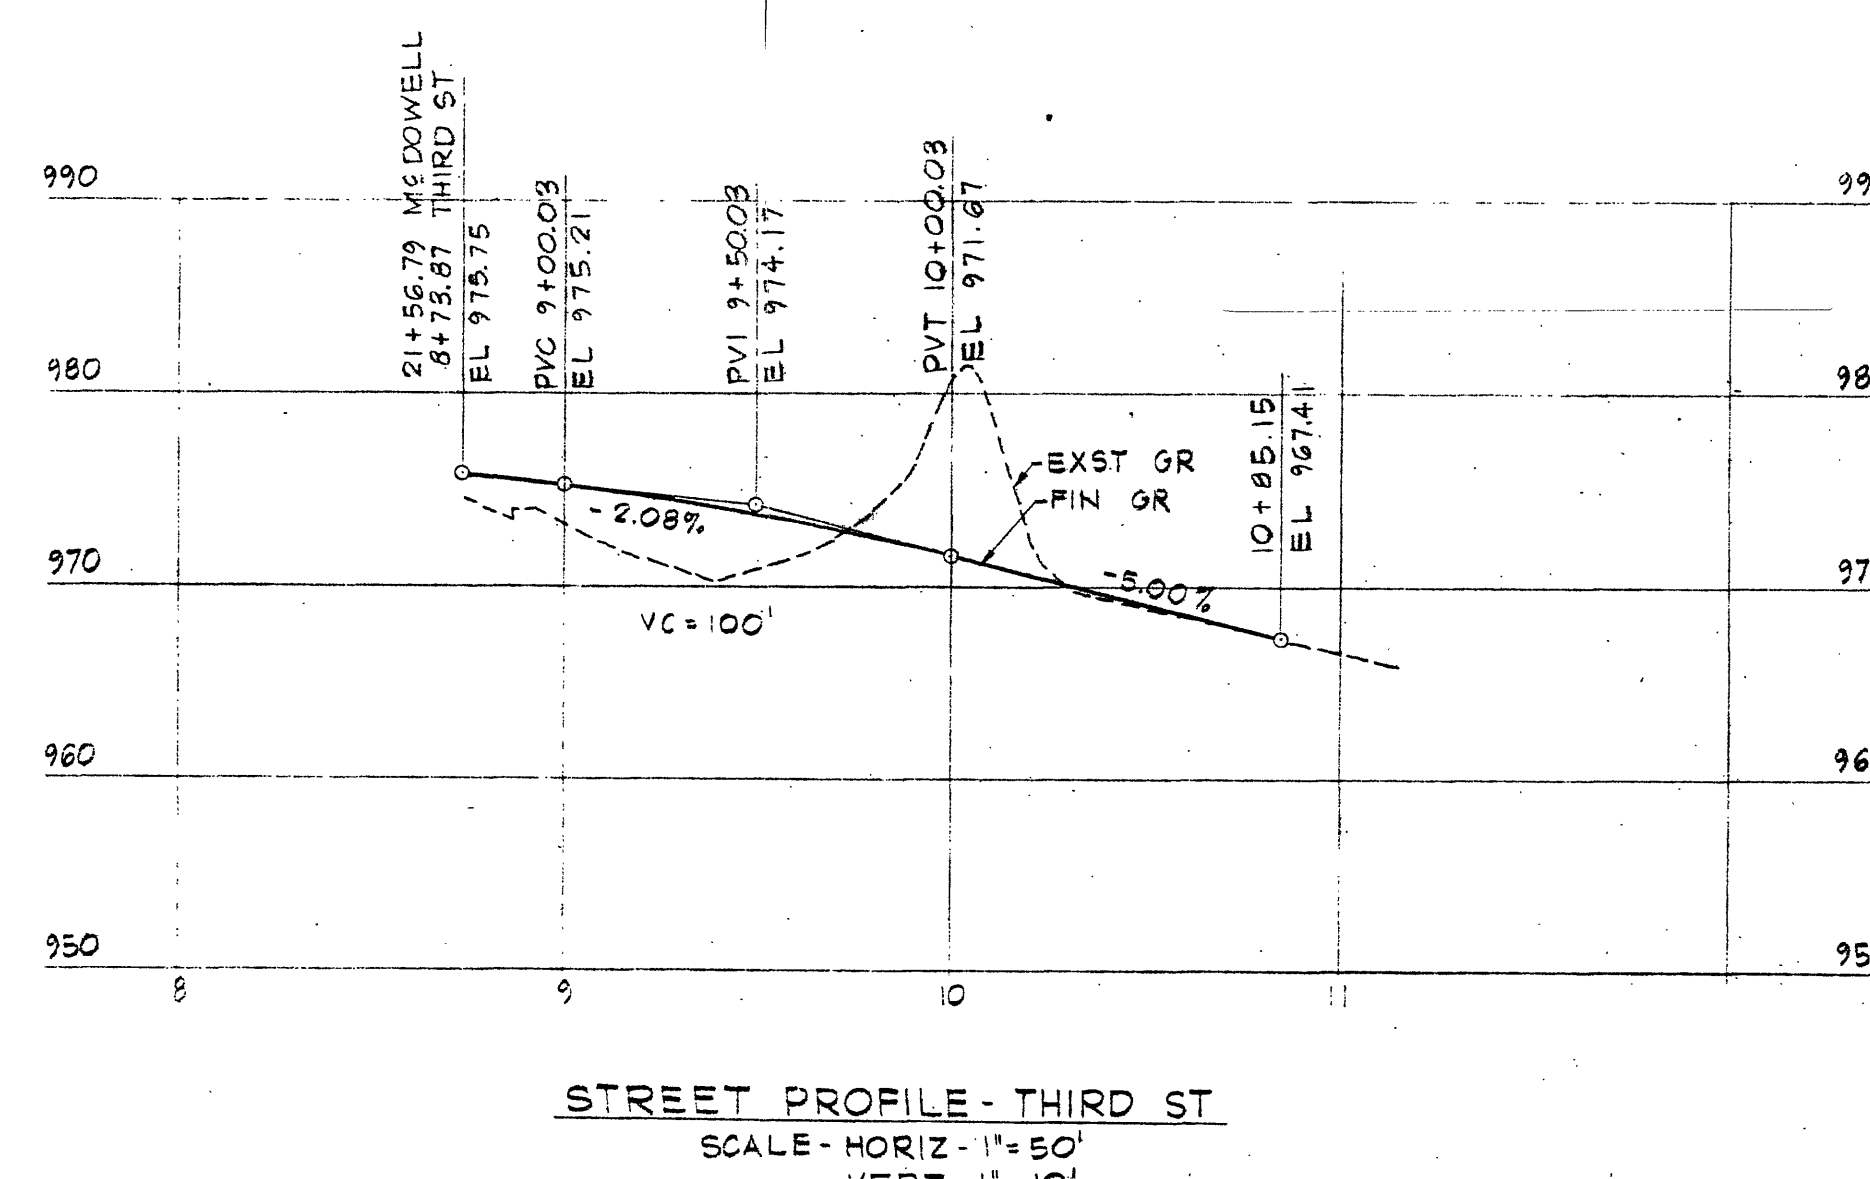
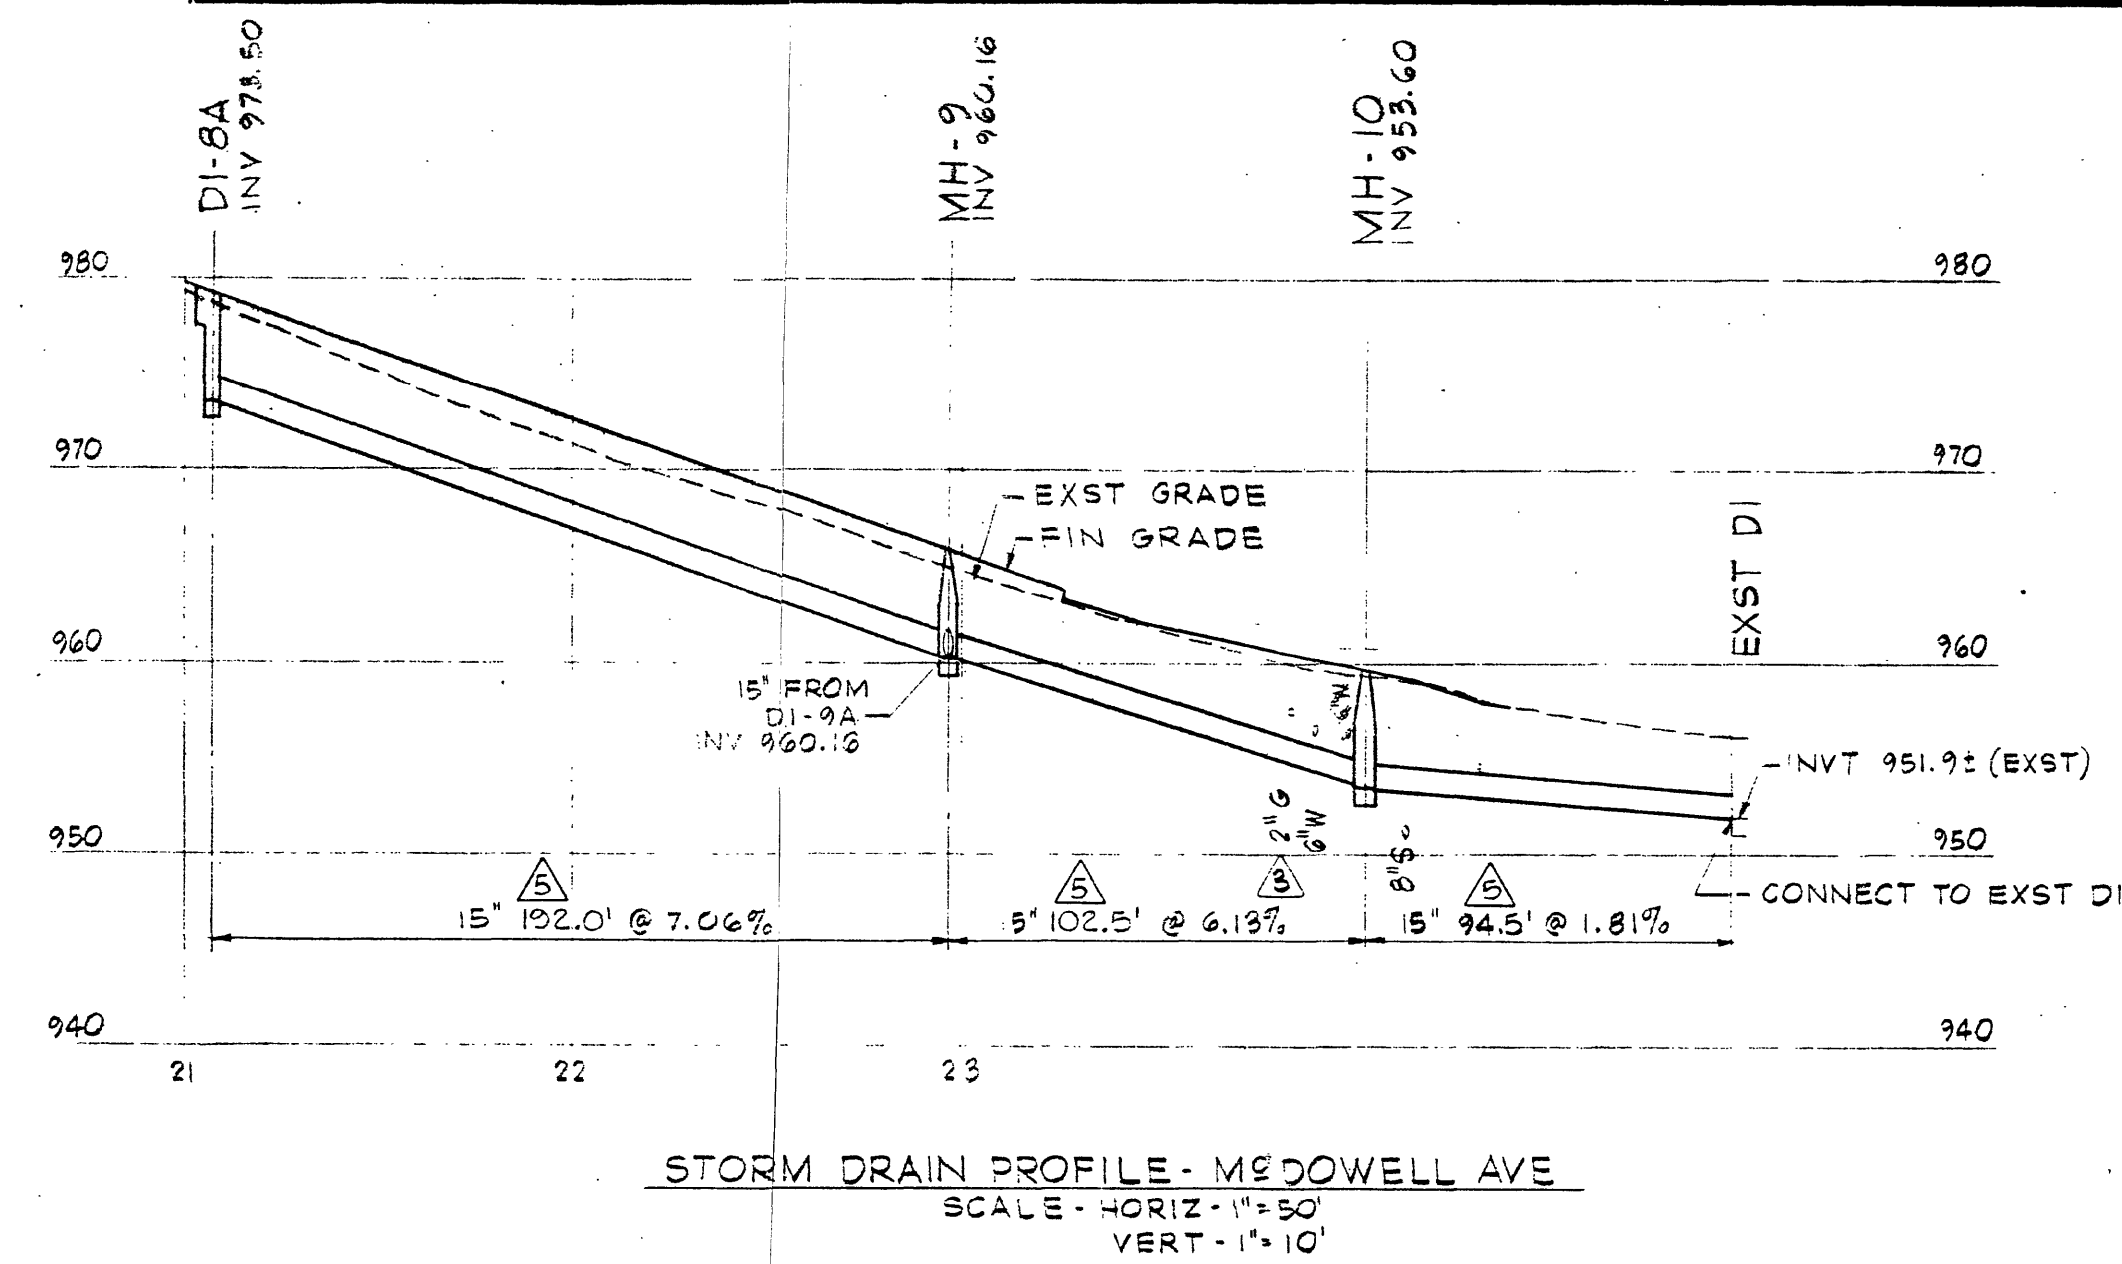



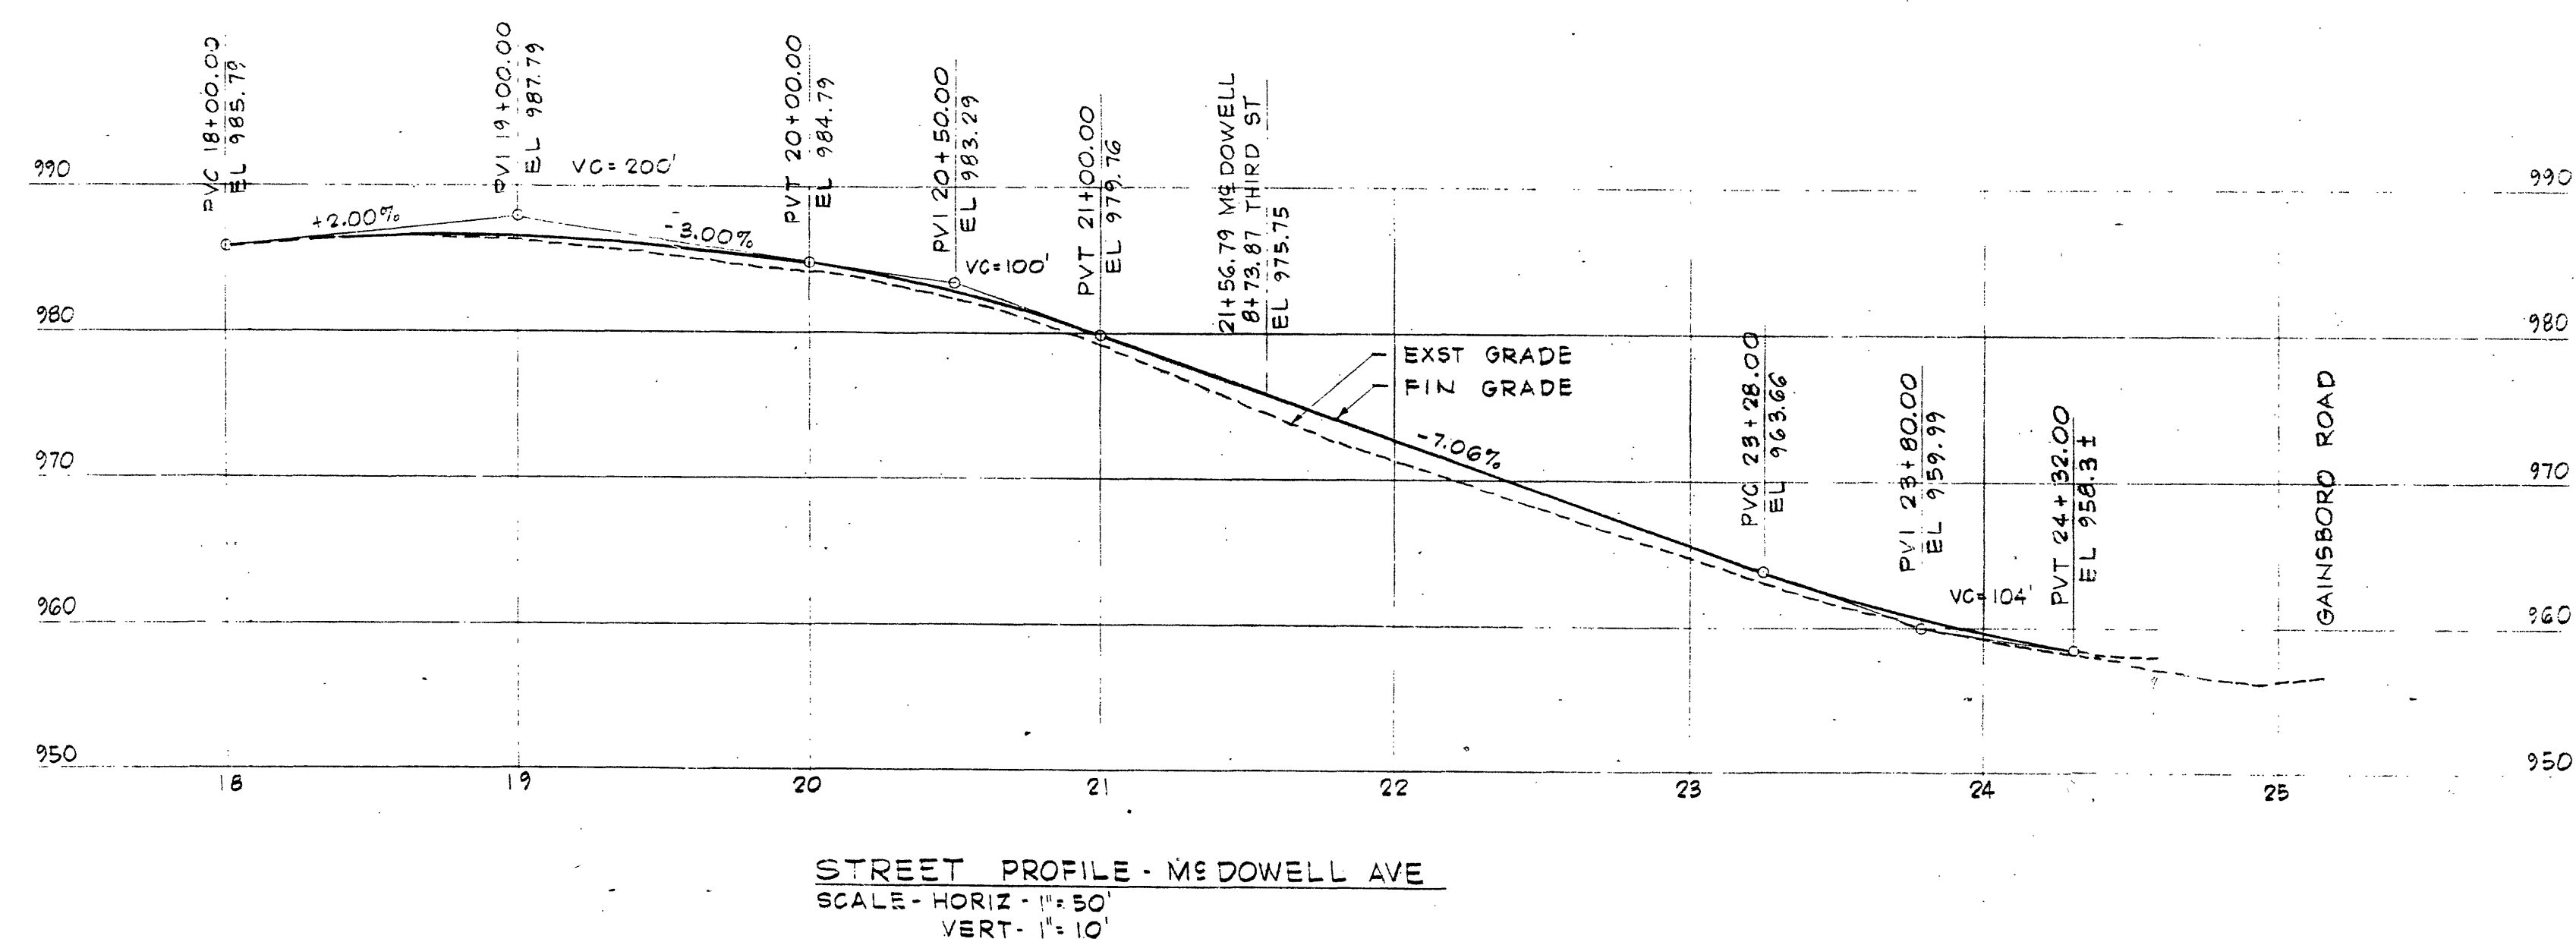


NOTES: 1. SANITARY SEWER SERVICE LATERALS SHALL BE 6" DIAMETER AND SHALL BE INSTALLED AT A UNIFORM GRADE OF 1/4" RISE PER FOOT FROM THE SEWER MAIN.
2. ALL SANITARY SEWER MANHOLES SHALL HAVE 4 FT DIAMETER BARRELS.
3. CONTRACTOR SHALL ESTABLISH SCHEDULE AND SEQUENCE OF WATER SYSTEM WORK WITH THE CITY OF ROANOKE PRIOR TO BEGINNING CONSTRUCTION.

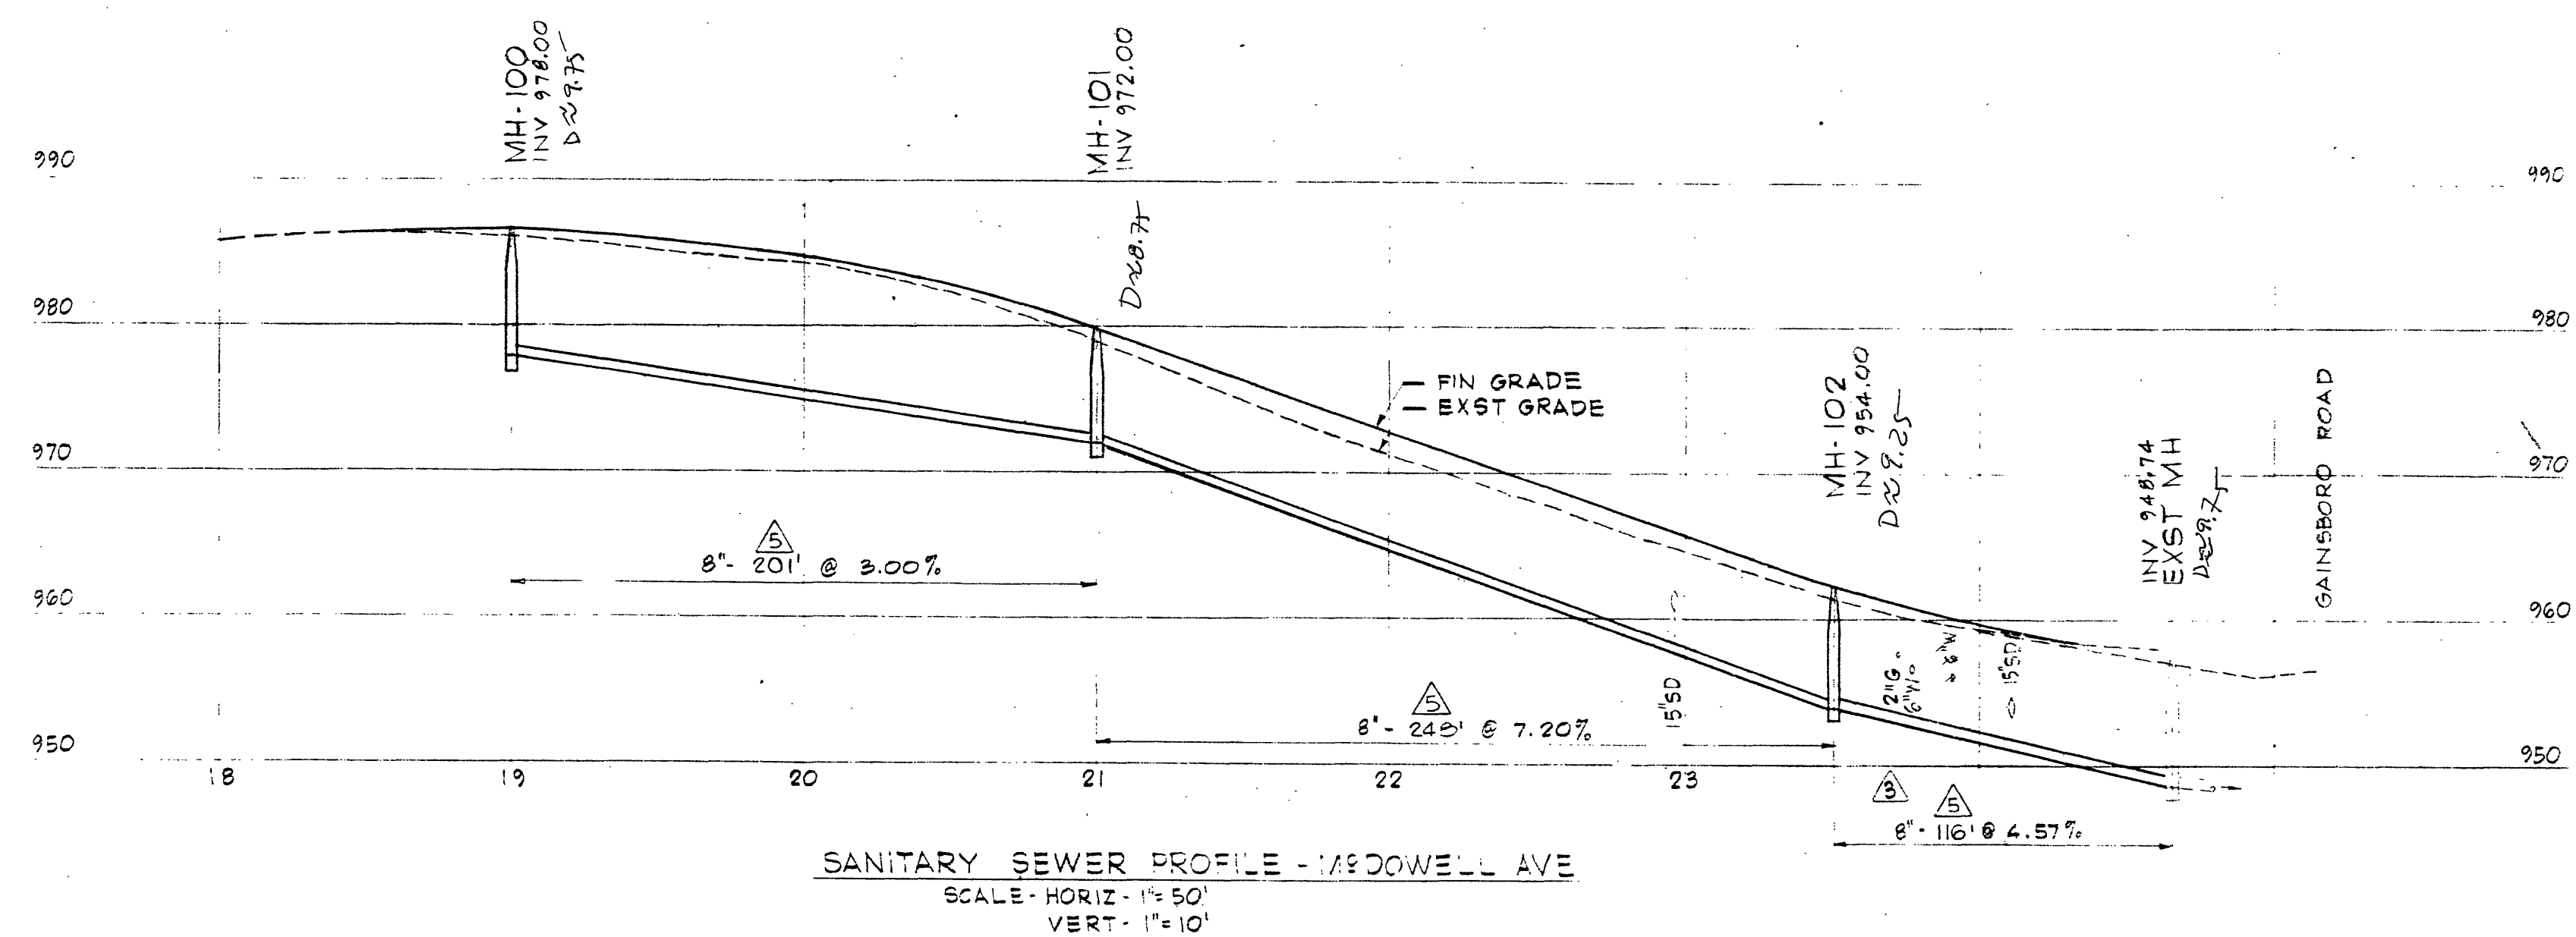

NOTES:
1. EXIST SANITARY SEWER LATERALS EXPOSED BY GRADING OPERATIONS SHALL BE CUT AND PLUGGED AT THE STREET LINE BY THE CONTRACTOR. THIS REQUIREMENT DOES NOT APPLY TO LATERALS CONNECTED TO SANITARY SEWER INDICATED TO BE ABANDONED.
2. UNDERCUT AND BACKFILL AREA SHALL BE EXCAVATED A MINIMUM OF 2 FEET BELOW FINISHED GRADE AND BACKFILLED TO FINISHED GRADE WITH MATERIAL APPROVED FOR SITE FILLS. COMPACTION OF BACKFILL SHALL BE AS SPECIFIED FOR SITE FILLS.
3. LIMIT OF WORK LINE IS RIGHT OF WAY LINE OF ABUTTING STREETS.

EXISTING ONE STORY BUILDING TO BE DEMOLISHED BY CONTRACTOR

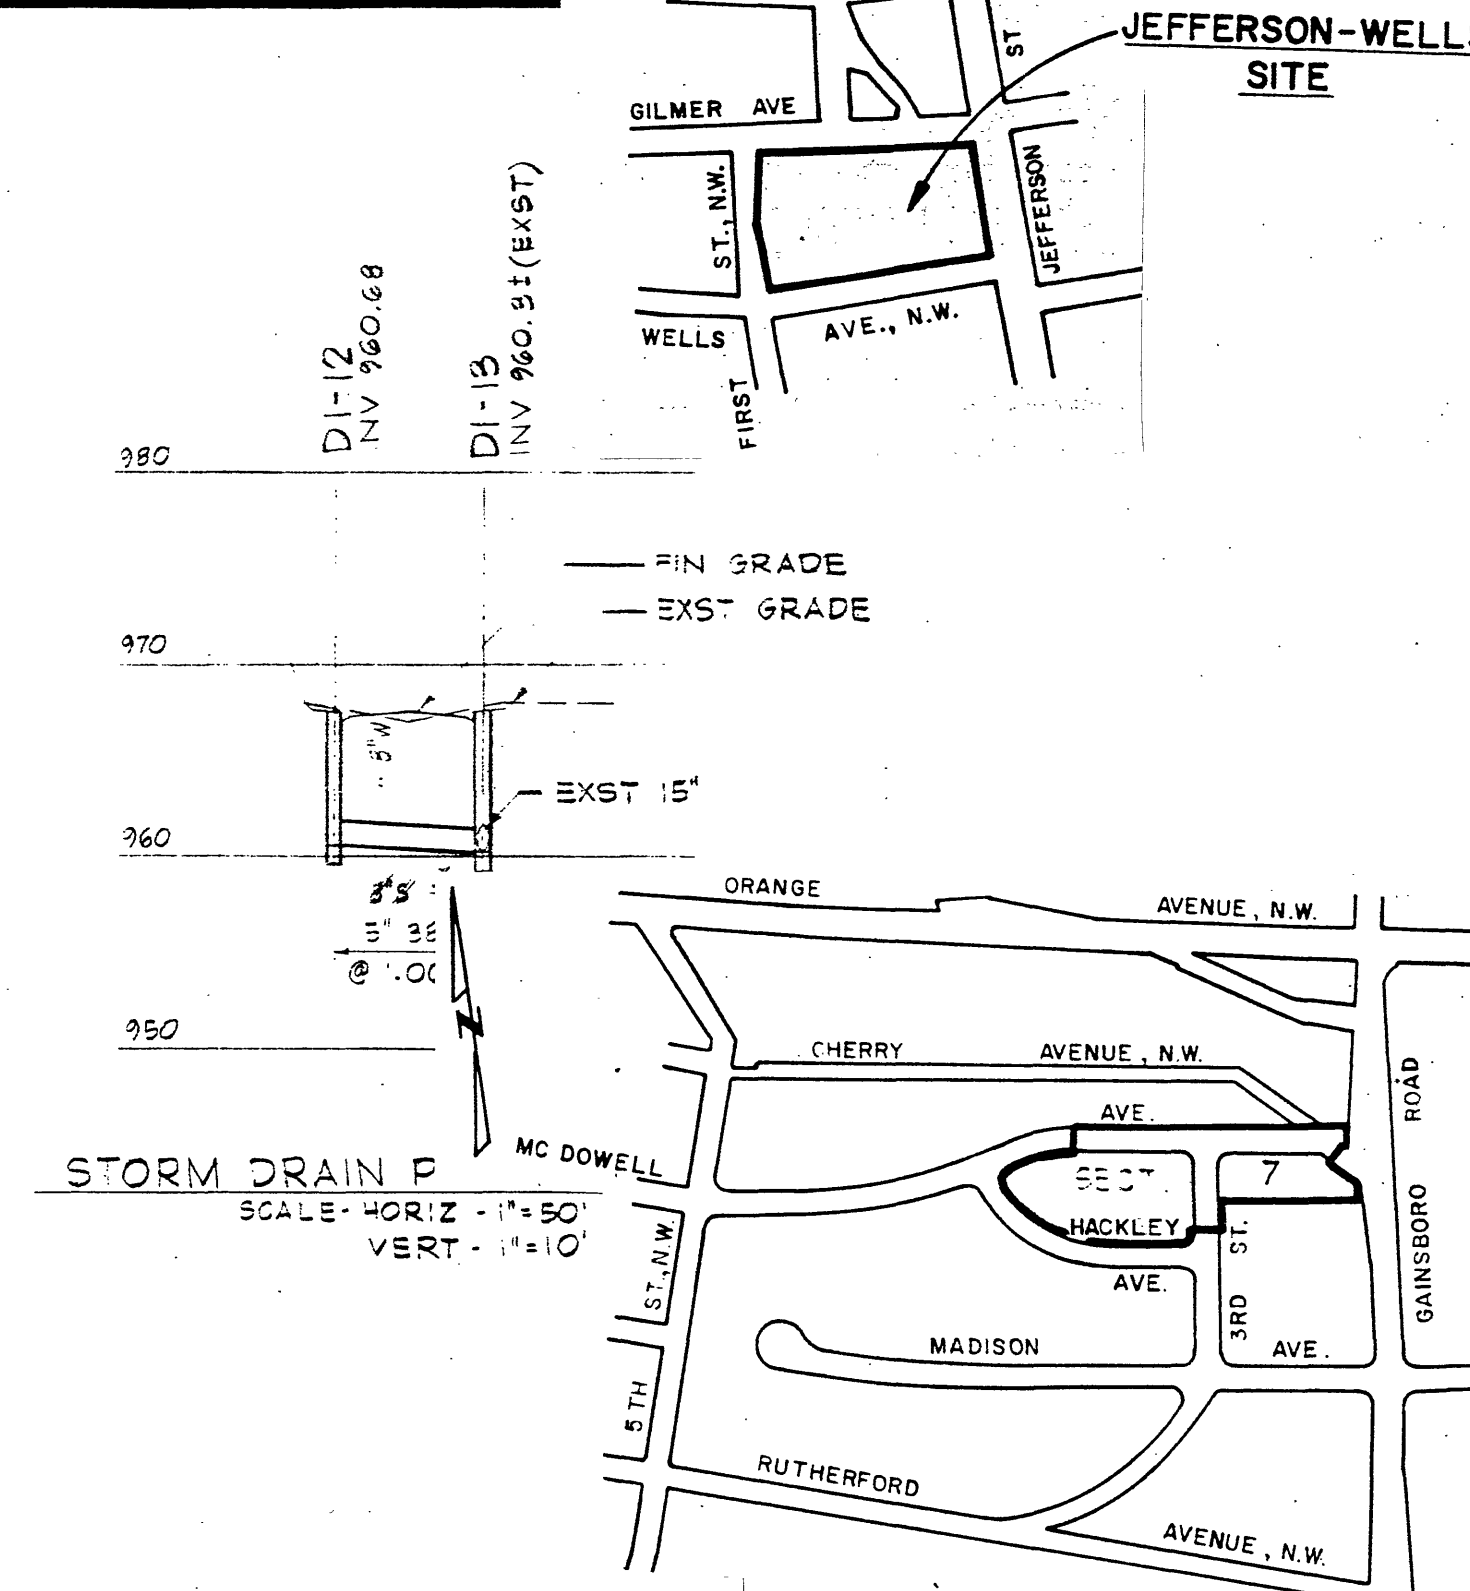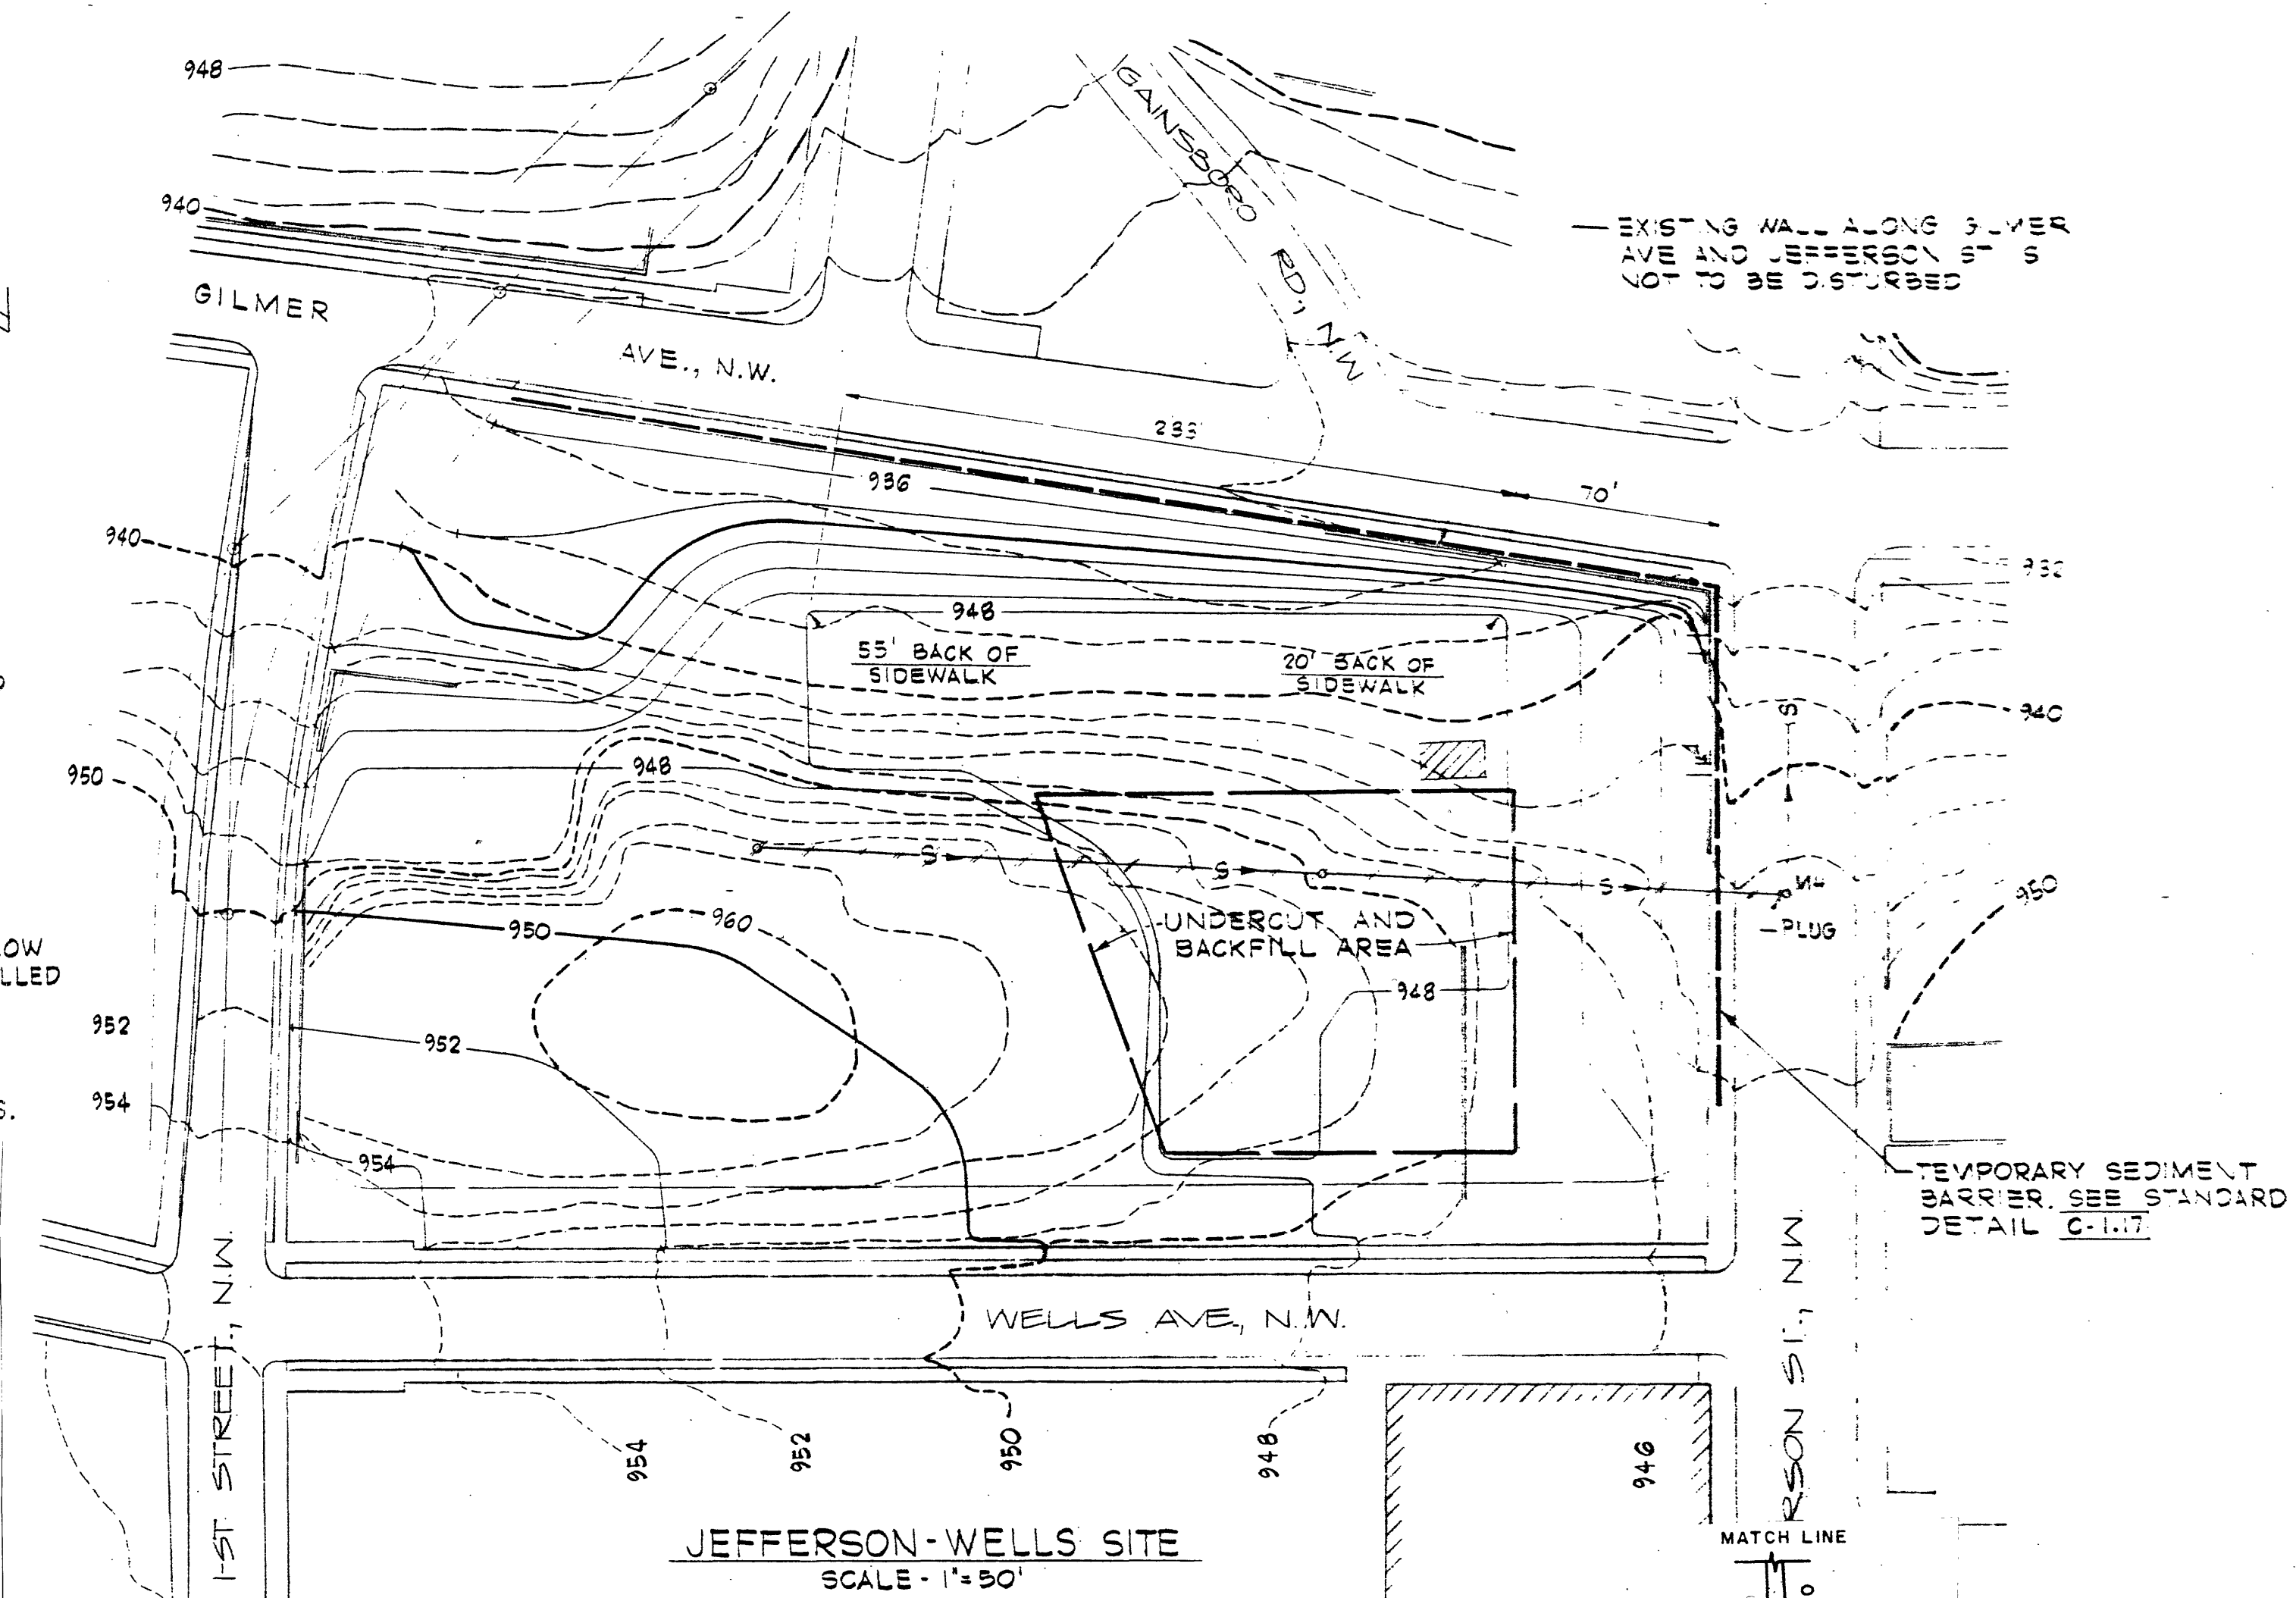

LOCATION MAP
NO SCALE
5409-7

AS BUILT DRAWINGS

REVISION	DATE	DESCRIPTION	BY	APP.
1	6-5-80	REVISE FOR AS BUILT	JWB	WMZ
2	8-7-80	ADJUSTED 3 SAN. SEWER LATERALS	JWB	WMZ
3	6-26-80	ADDED EXISTING 2" GAS LINE IN MCDOWELL AVE	JWB	WMZ
4	6-2-80	ADDED JEFFERSON-WELLS SITE	JWB	WMZ
5	6-2-80	ADJUSTED LOT GRADING & DRIVEWAYS IN SECT 7	JWB	WMZ
6				
7				
HAYES, SEAY, MATTERN & MATTERN
ARCHITECTS - ENGINEERS - PLANNERS
ROANOKE, VIRGINIA
RICHMOND, VIRGINIA
WASHINGTON, D.C.

5409-7