

ORANGE AVENUE INDUSTRIAL PARK

ECONOMIC DEVELOPMENT ADMINISTRATION

PROJECT NO. 01-01-01301

SOUTHWEST VIRGINIA COMMUNITY DEVELOPMENT FUND

SECTION FOUR


GAINSBORO NEIGHBORHOOD DEVELOPMENT PROGRAM
ROANOKE, VIRGINIA

HAYES, SEAY, MATTERN & MATTERN

ARCHITECTS - ENGINEERS - PLANNERS

ROANOKE, VA. ROCKVILLE, MD. RICHMOND, VA.
VIRGINIA BEACH, VA.

AS BUILT
DRAWING

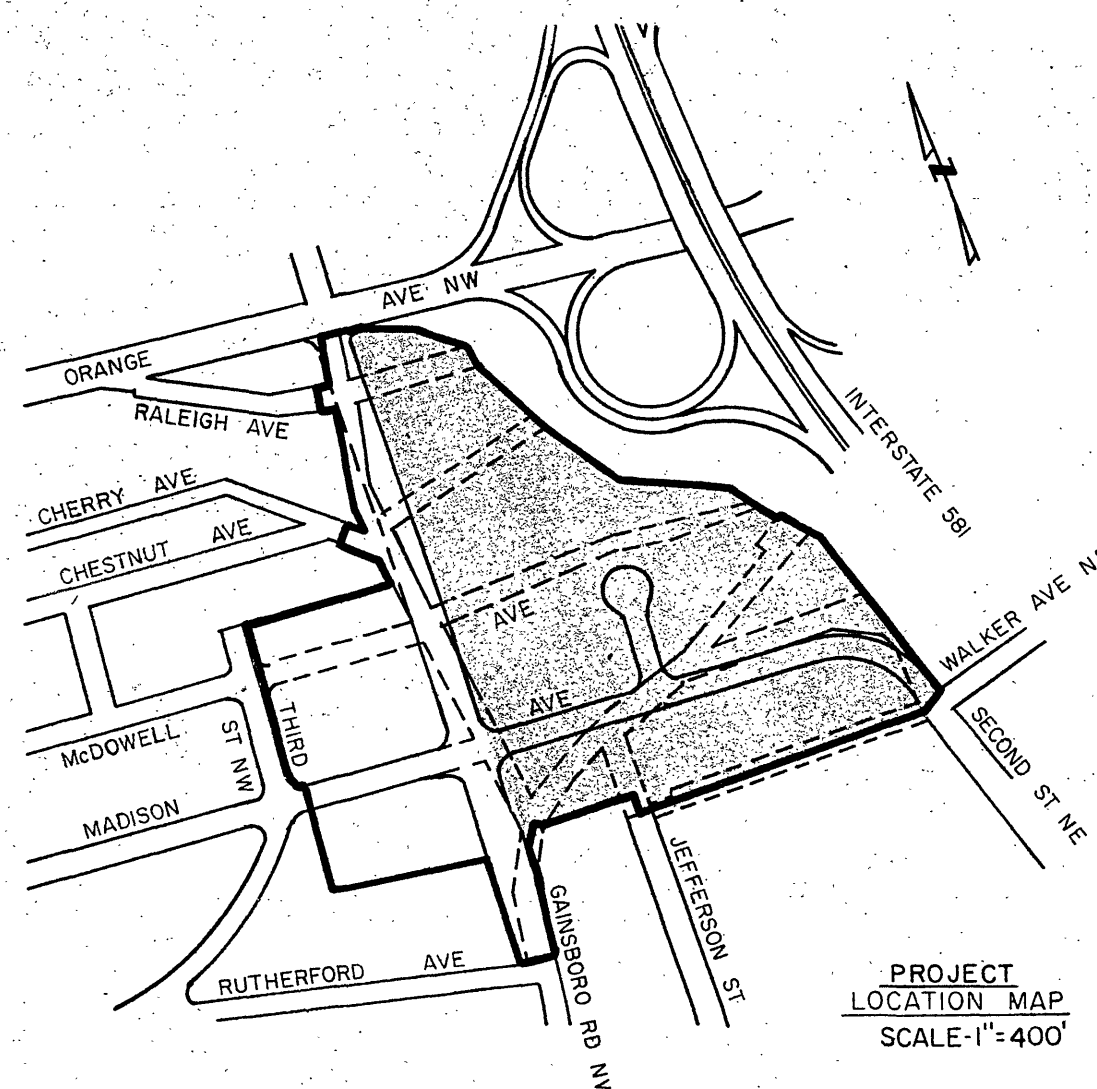

PROJECT
LOCATION MAP
SCALE 1"=400'


NOTE: SHADED AREA DENOTES
PORTION OF PROJECT IN ORANGE
AVENUE INDUSTRIAL PARK.

INDEX OF SHEETS

SHEET NO.	TITLE
0	TITLE SHEET & LOCATION PLAN
0-A	ABBREVIATIONS & LEGEND
1	DIMENSIONAL LAYOUT & TYPICAL STREET SECTIONS
2	GRADING & STORM DRAINAGE PLAN PART 1 & PART 2
3	SANITARY SEWER & WATER PLAN PART 1 & PART 2
4	STREET & WATER PROFILES PART 1 & PART 2
5	STORM DRAINAGE PROFILES PART 1 & PART 2
6	SANITARY SEWER PROFILES PART 1 & PART 2
7	GENERAL NOTES & MISCELLANEOUS DETAILS
8	PLANS & PROFILES PART 3
9	EROSION & SEDIMENT CONTROL PLAN

APPROVED

SIGNATURE	TITLE	AGENCY	DATE
<i>James L. Richmond, Jr.</i>	President	City of Roanoke	8-14-76
<i>Robert D. Hilly</i>	Executive Director	City of Roanoke	8-15-76

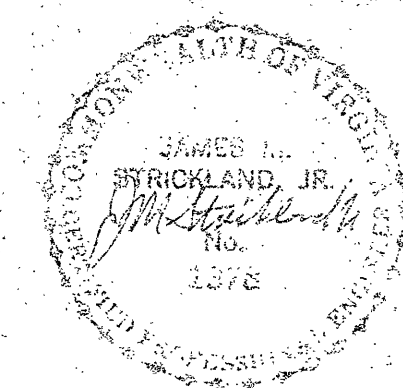

COMM. 3930

DATE - AUG. 16, 1976

SHEET 0

5409-4