



INTERSTATE ROUTE 581

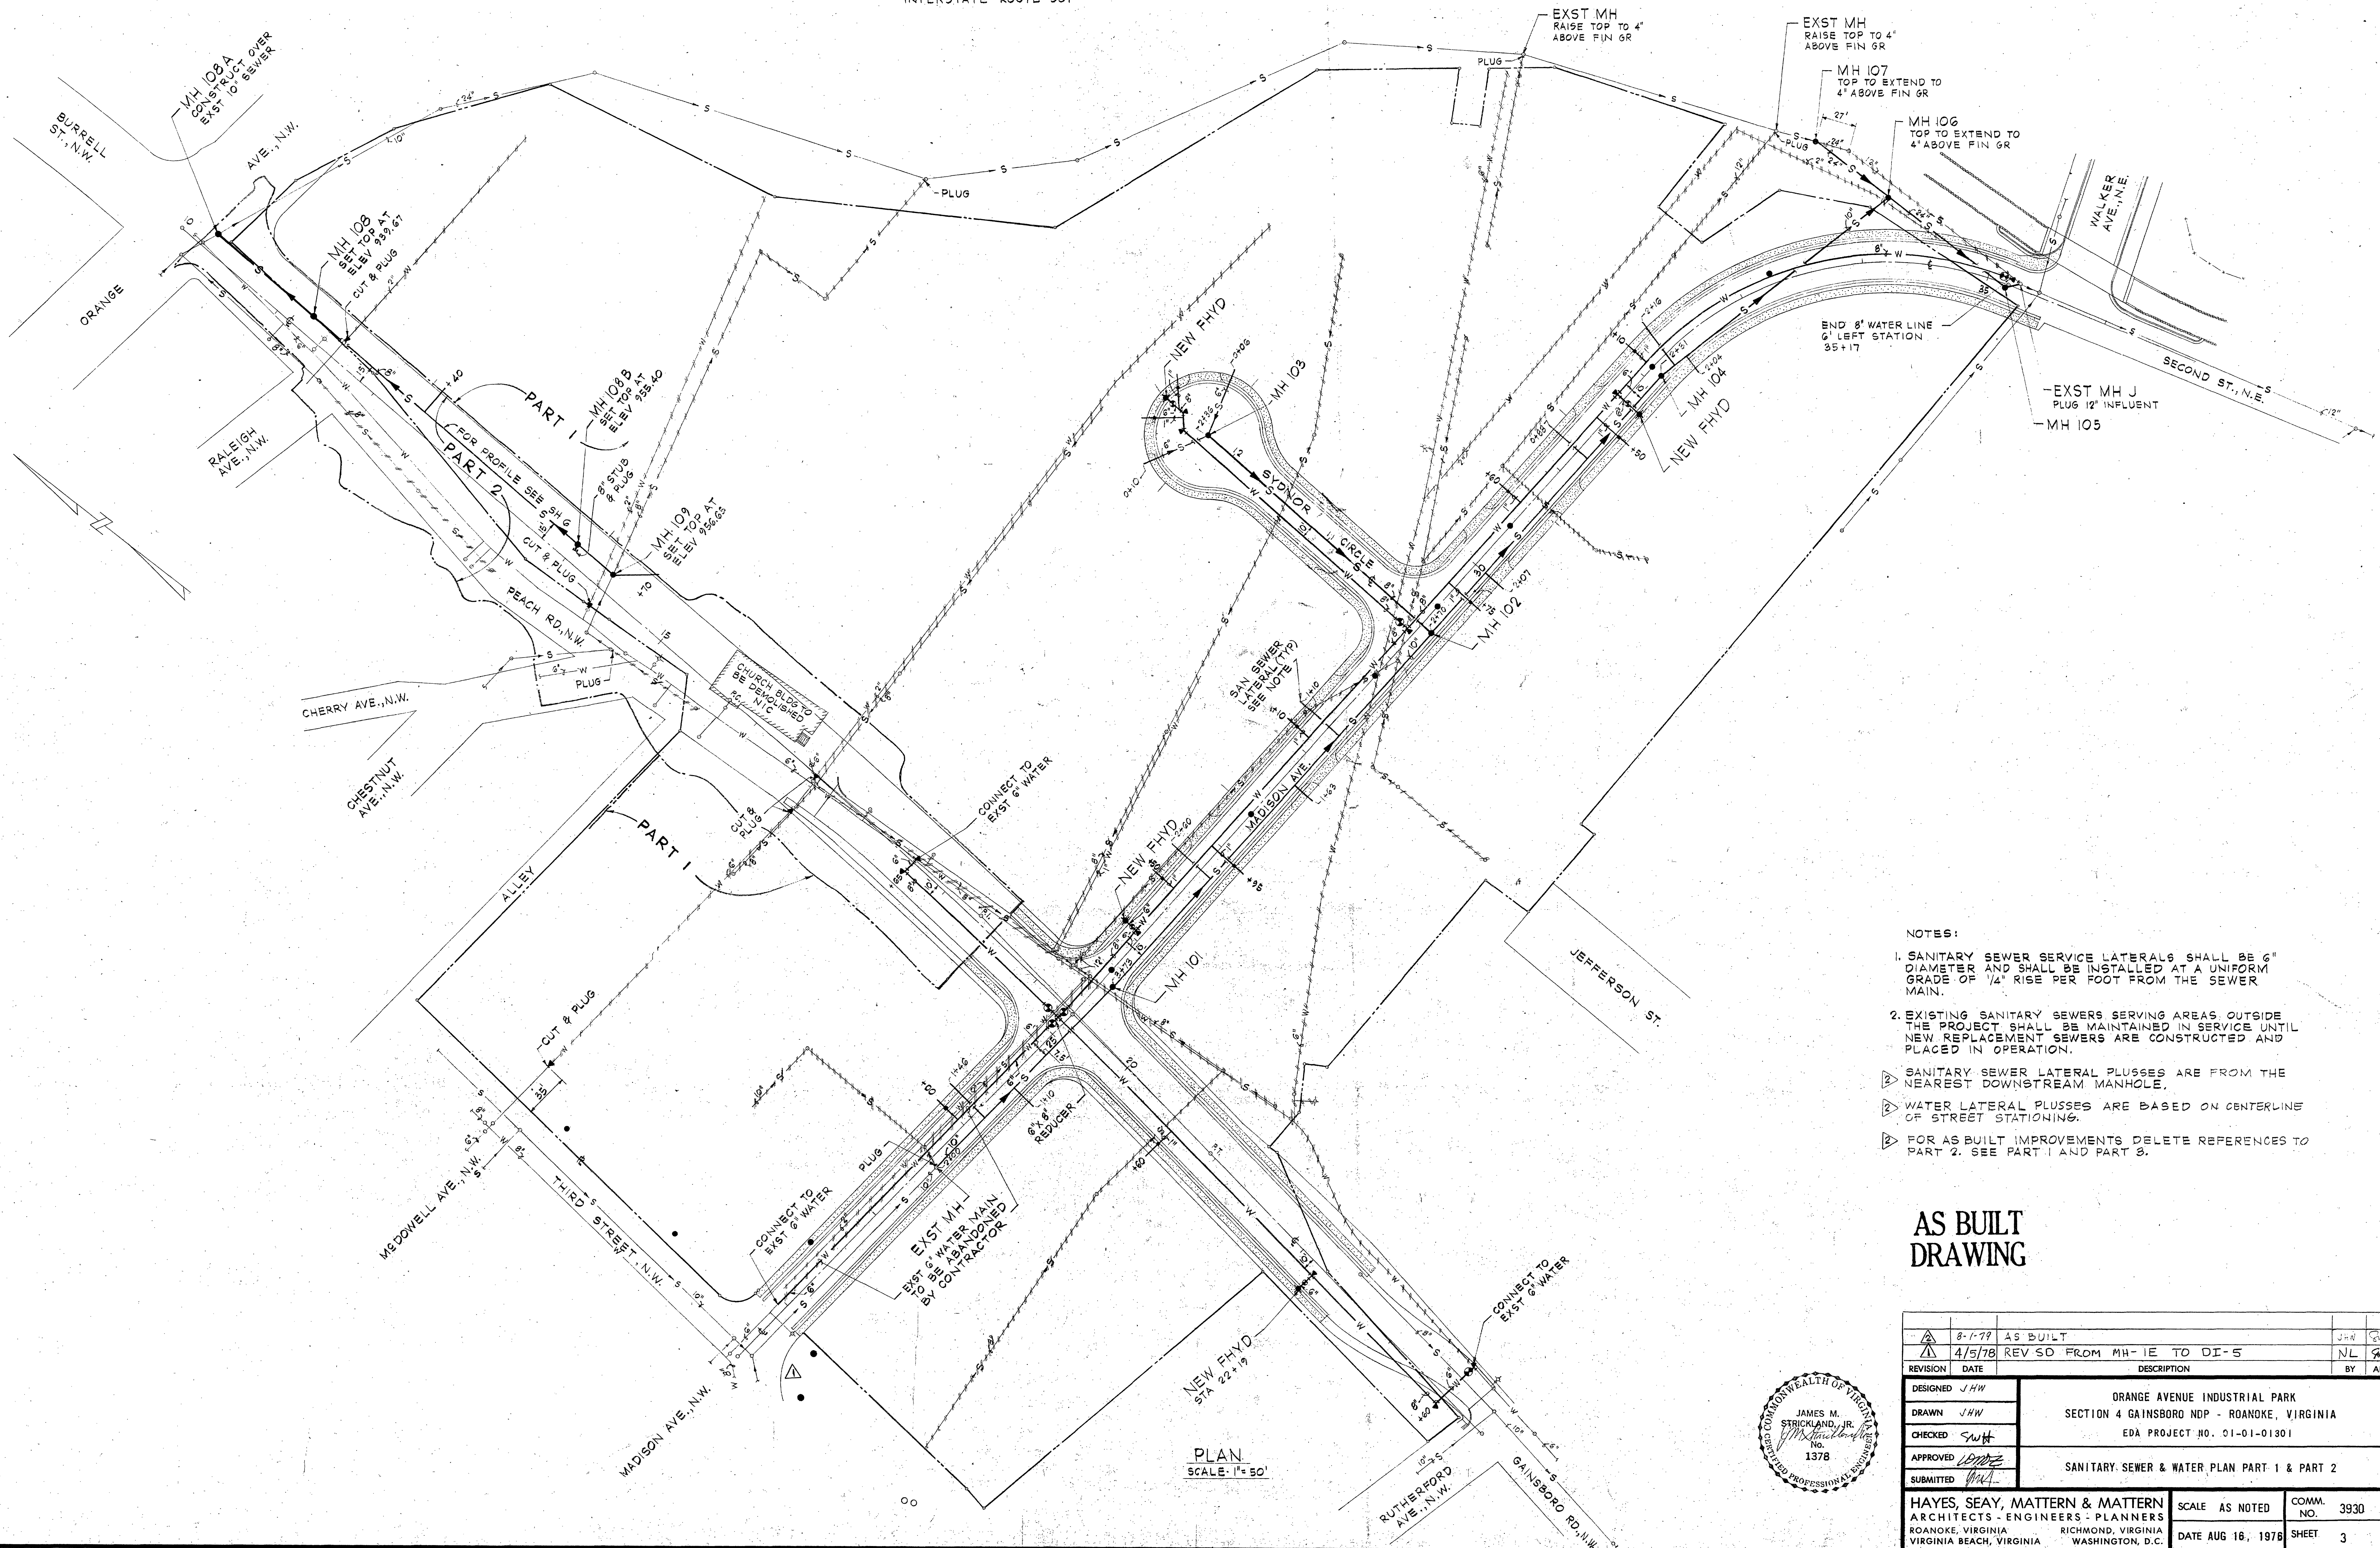

- NOTES:
1. SANITARY SEWER SERVICE LATERALS SHALL BE 6" DIAMETER AND SHALL BE INSTALLED AT A UNIFORM GRADE OF 1/4" RISE PER FOOT FROM THE SEWER MAIN.
 2. EXISTING SANITARY SEWERS SERVING AREAS OUTSIDE THE PROJECT SHALL BE MAINTAINED IN SERVICE UNTIL NEW REPLACEMENT SEWERS ARE CONSTRUCTED AND PLACED IN OPERATION.
 3. SANITARY SEWER LATERAL PLUGS ARE FROM THE NEAREST DOWNSTREAM MANHOLE.
 4. WATER LATERAL PLUGS ARE BASED ON CENTERLINE OF STREET STATIONING.
 5. FOR AS BUILT IMPROVEMENTS DELETE REFERENCES TO PART 2. SEE PART 1 AND PART 3.

AS BUILT
DRAWING

DESIGNED	JHW	DATE	8-1-79	DESCRIPTION	AS BUILT	BY	JHW	APP.	
DRAWN	JHW	DATE	4/5/78	DESCRIPTION	REV SO FROM MH-1E TO DI-5	BY	NL	APP.	
CHECKED	SWH	DATE		DESCRIPTION		BY		APP.	
APPROVED		DATE		DESCRIPTION		BY		APP.	
SUBMITTED		DATE		DESCRIPTION		BY		APP.	
ORANGE AVENUE INDUSTRIAL PARK SECTION 4 GAINSBORO NDP - ROANOKE, VIRGINIA EDA PROJECT NO. 01-01-01301									
SANITARY SEWER & WATER PLAN PART 1 & PART 2									
HAYES, SEAY, MATTERN & MATTERN ARCHITECTS - ENGINEERS - PLANNERS ROANOKE, VIRGINIA RICHMOND, VIRGINIA WASHINGTON, D.C.									
SCALE AS NOTED									
DATE AUG 16, 1978									
COMM. NO. 3930									
SHEET 3									

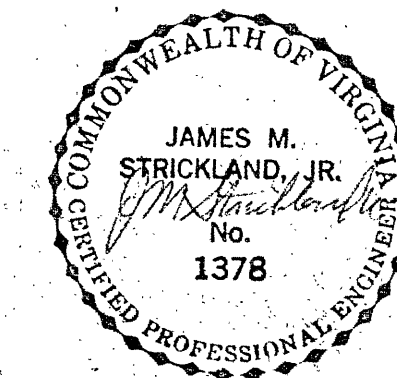

PLAN
SCALE: 1" = 50'