

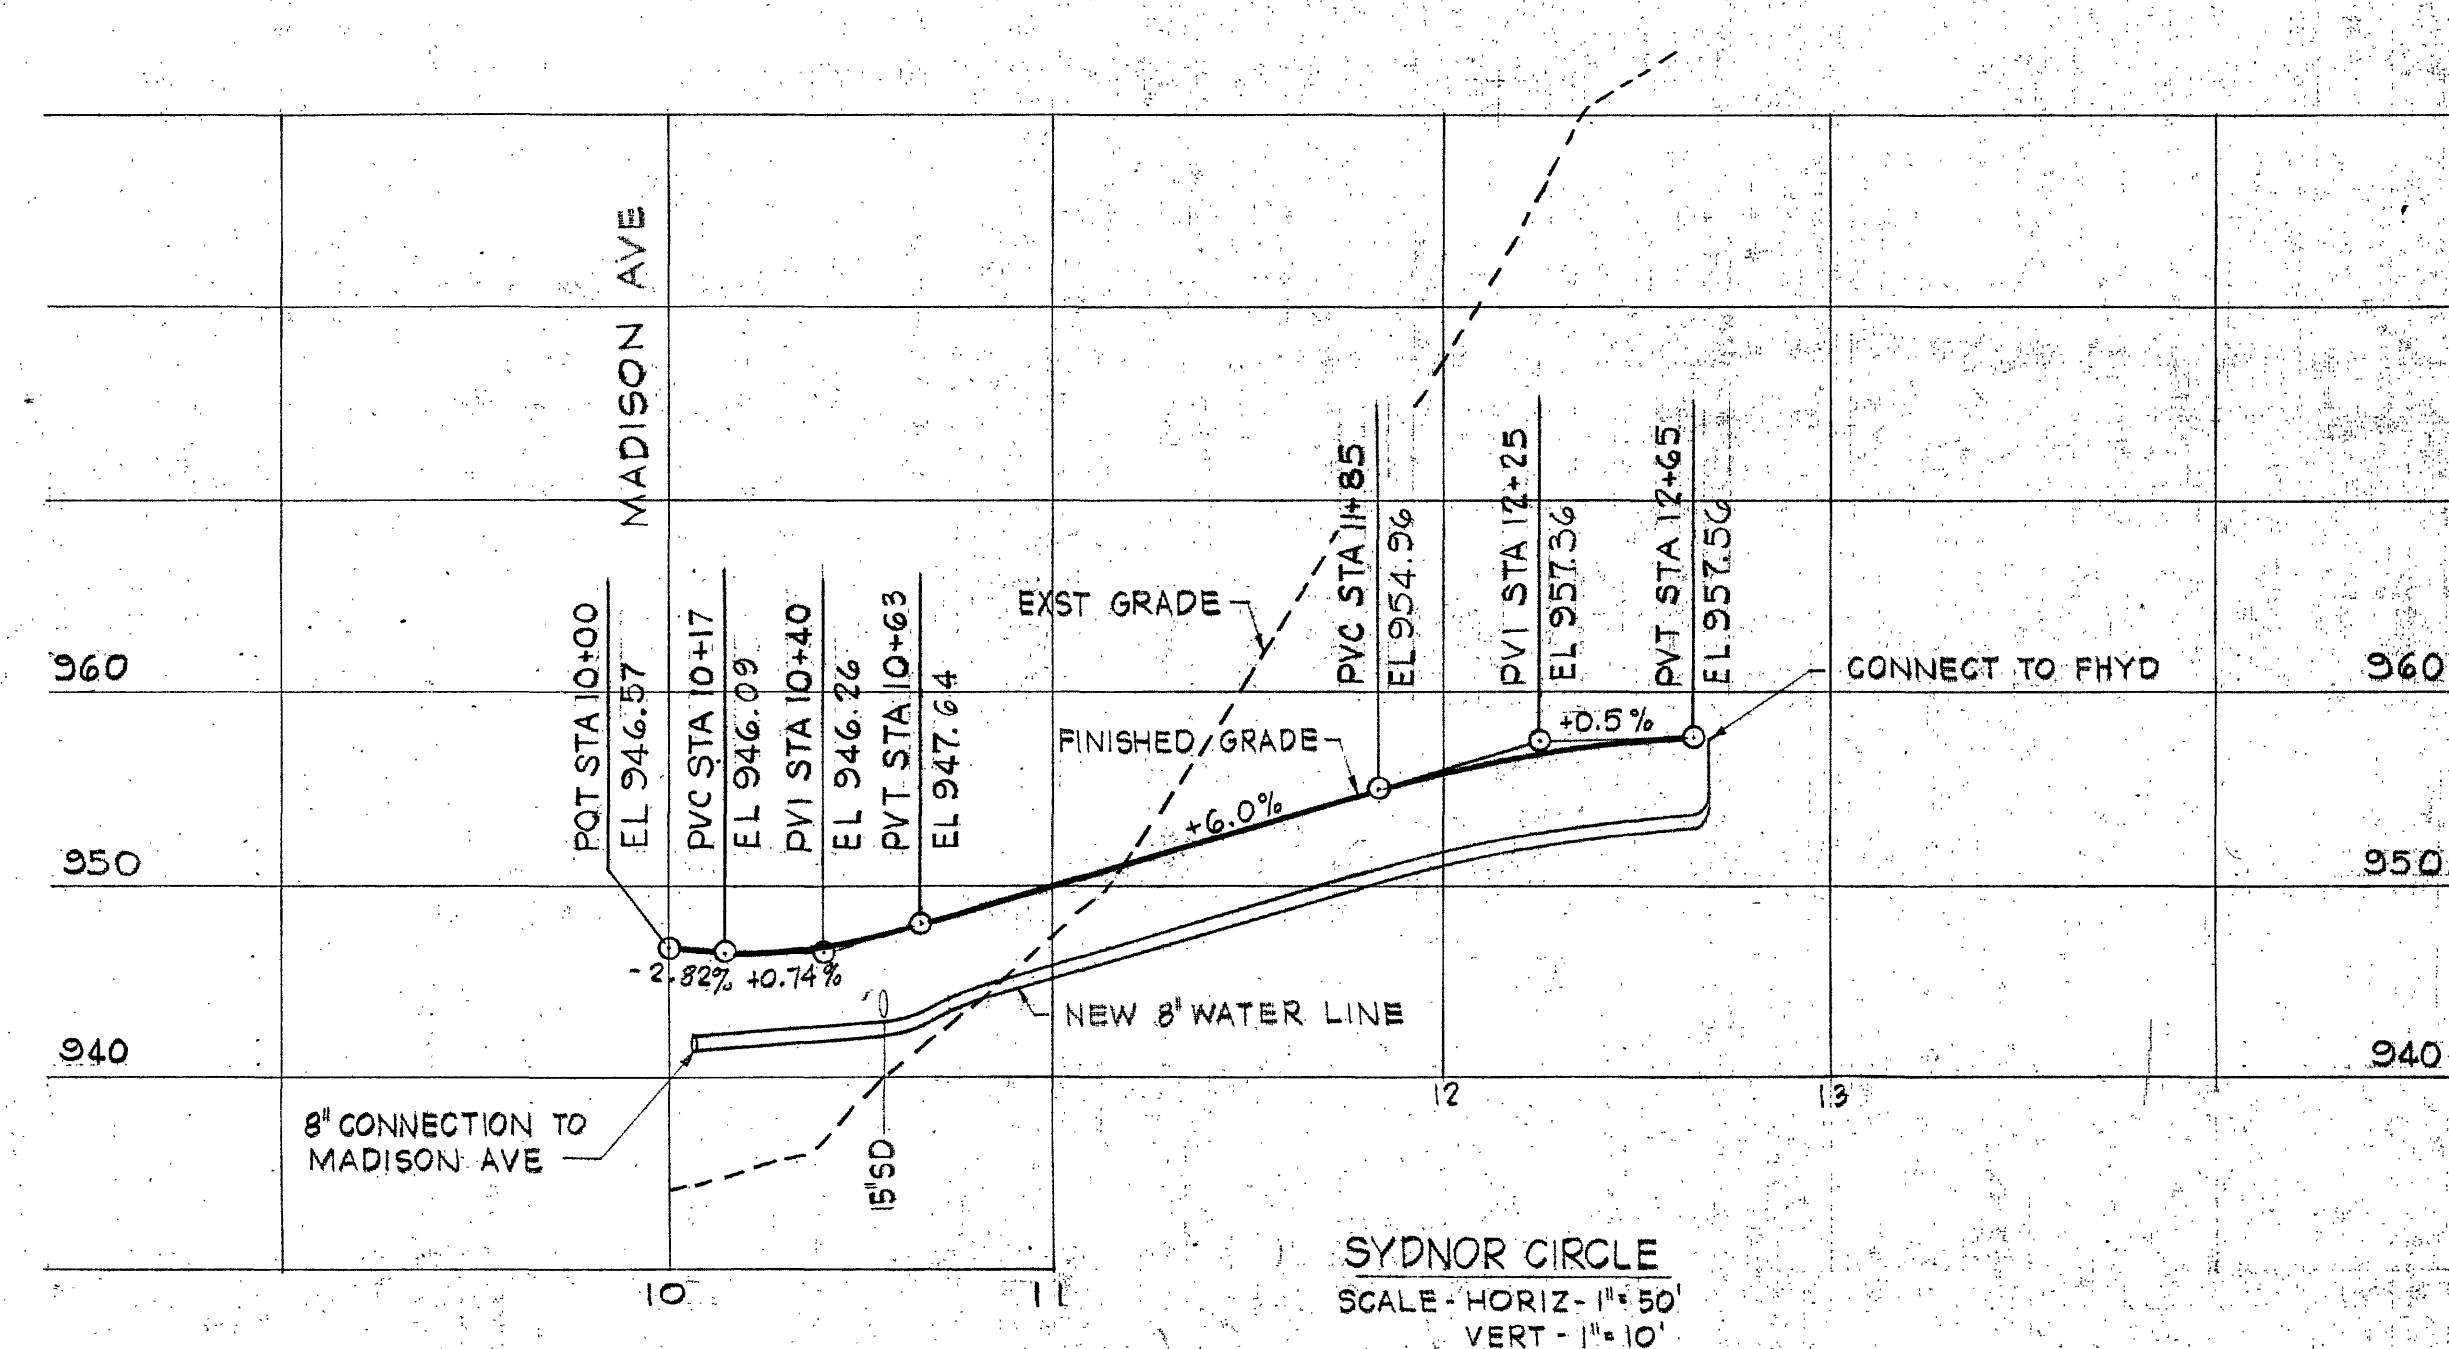
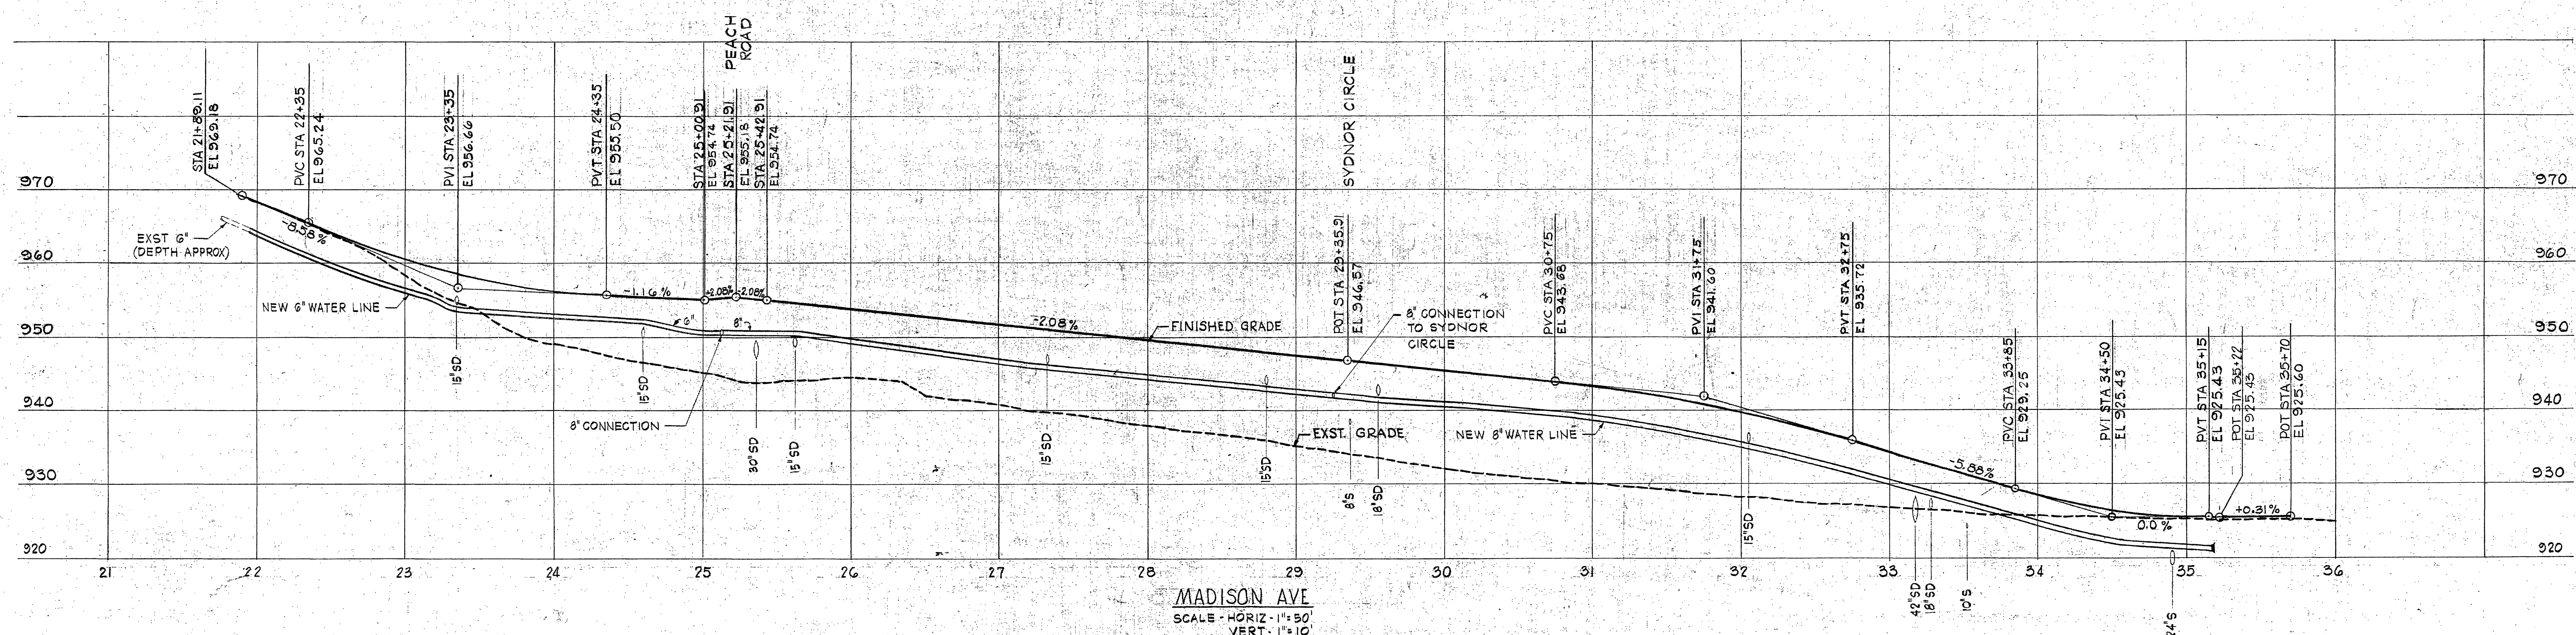


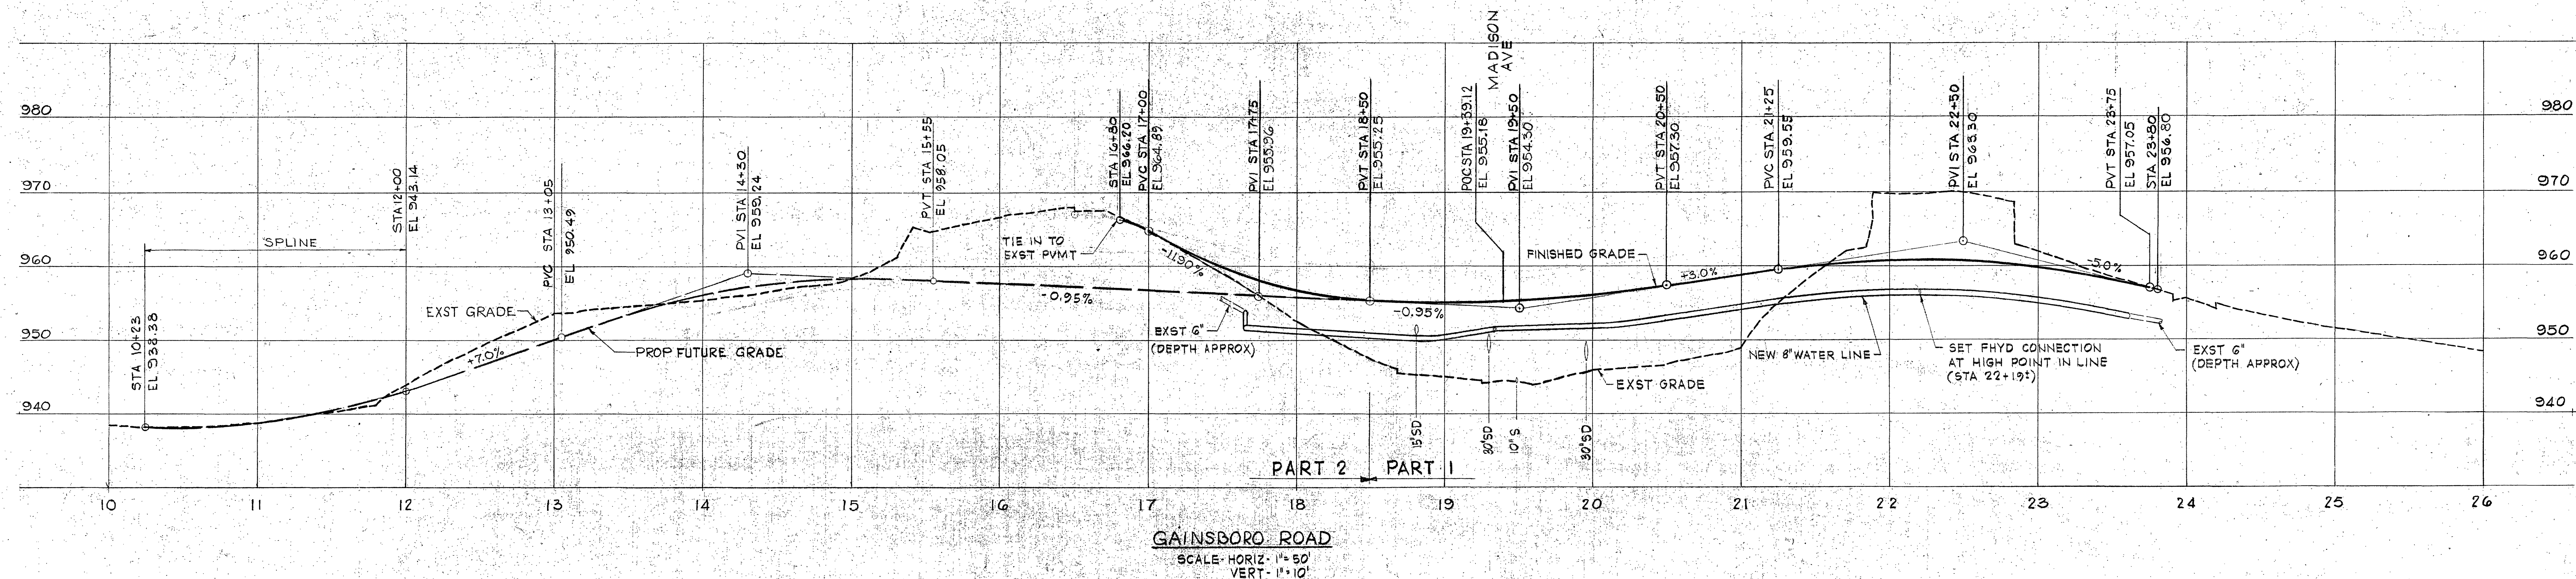

FOR AS BUILT IMPROVEMENTS DELETE REFERENCES TO PART 2.
SEE PART 1 AND PART 3.

**AS BUILT
DRAWING**

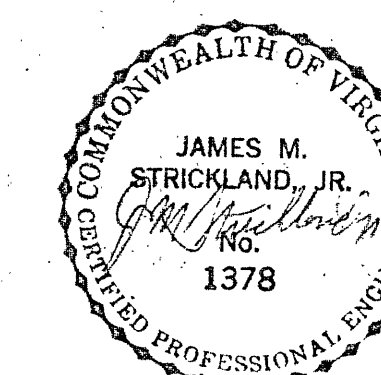

REVISION	DATE	DESCRIPTION	BY	APP.
1	8-1-79	AS BUILT	JHW	SWH
DESIGNED	LWB	ORANGE AVENUE INDUSTRIAL PARK SECTION 4 GAINSBORO NDP - ROANOKE, VIRGINIA EDA PROJECT NO. 01-01-01301		
DRAWN	LWB			
CHECKED	SWH			
APPROVED	SWH			
SUBMITTED			STREET & WATER PROFILES PART 1 & PART 2	
HAYES, SEAY, MATTERN & MATTERN ARCHITECTS - ENGINEERS - PLANNERS ROANOKE, VIRGINIA RICHMOND, VIRGINIA WASHINGTON, D.C.			SCALE AS NOTED	COMM. NO. 3930
			DATE AUG 16, 1976	SHEET 4